



VICTORIA
NICHOLAS CT. SEWERLINE

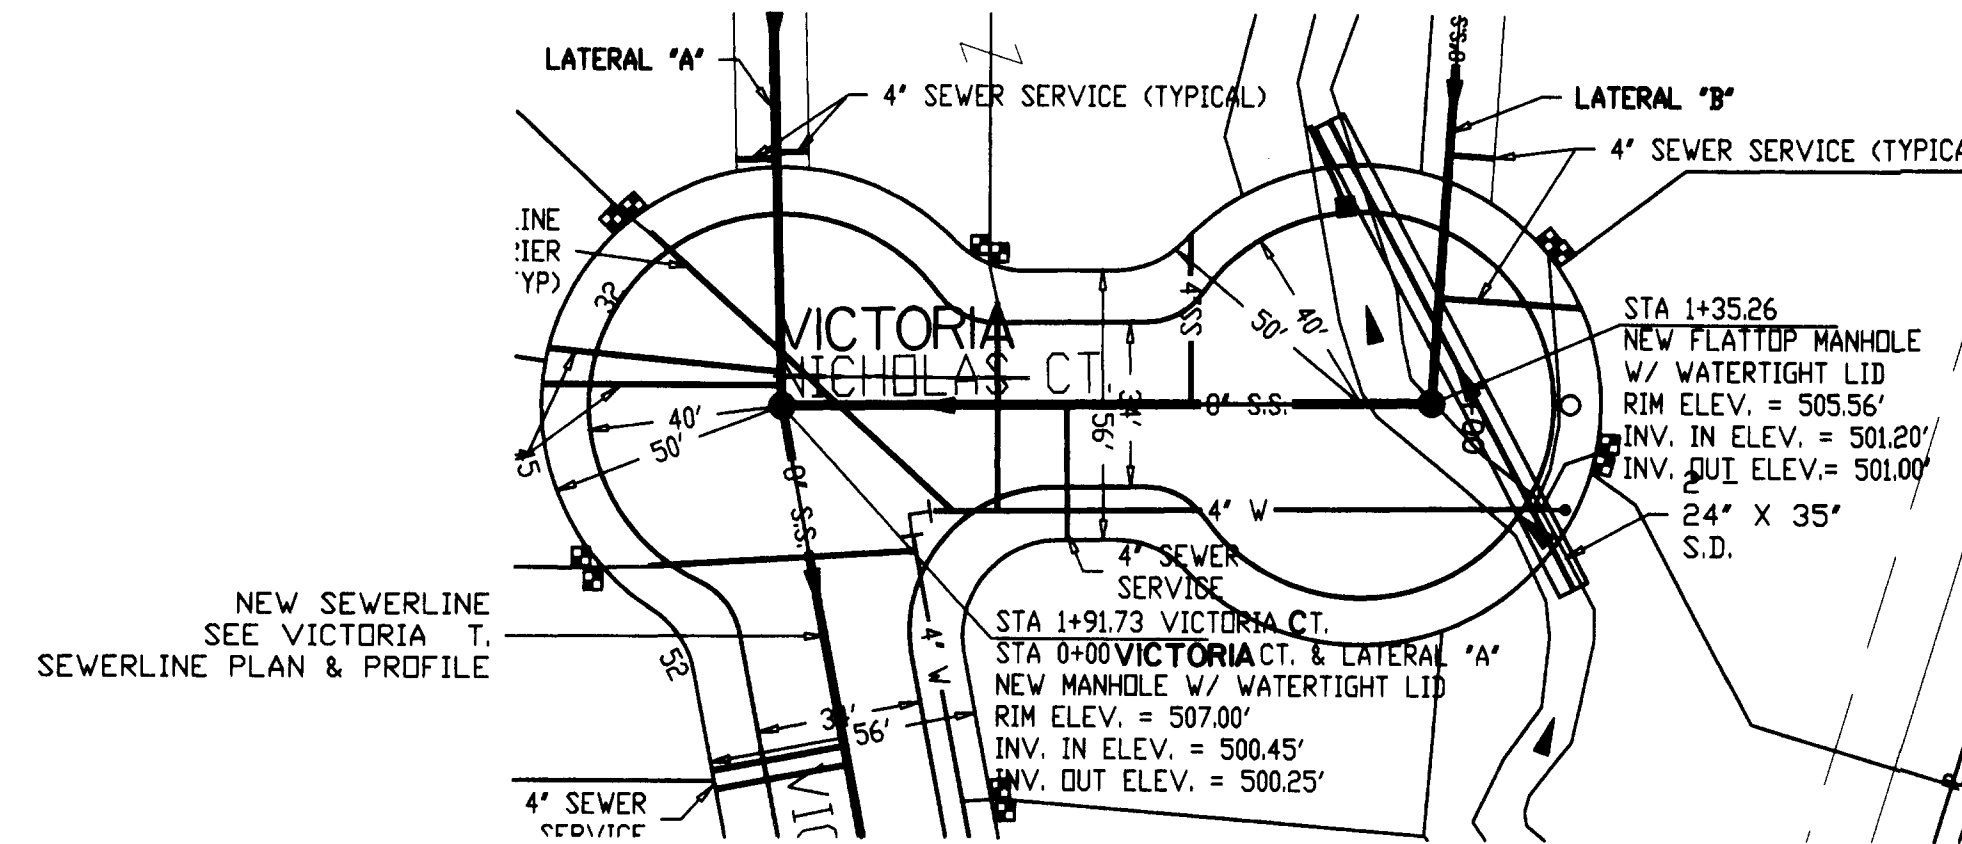


SCALES:
1" = 40' HOR
1" = 5' VER

LATERAL "A"

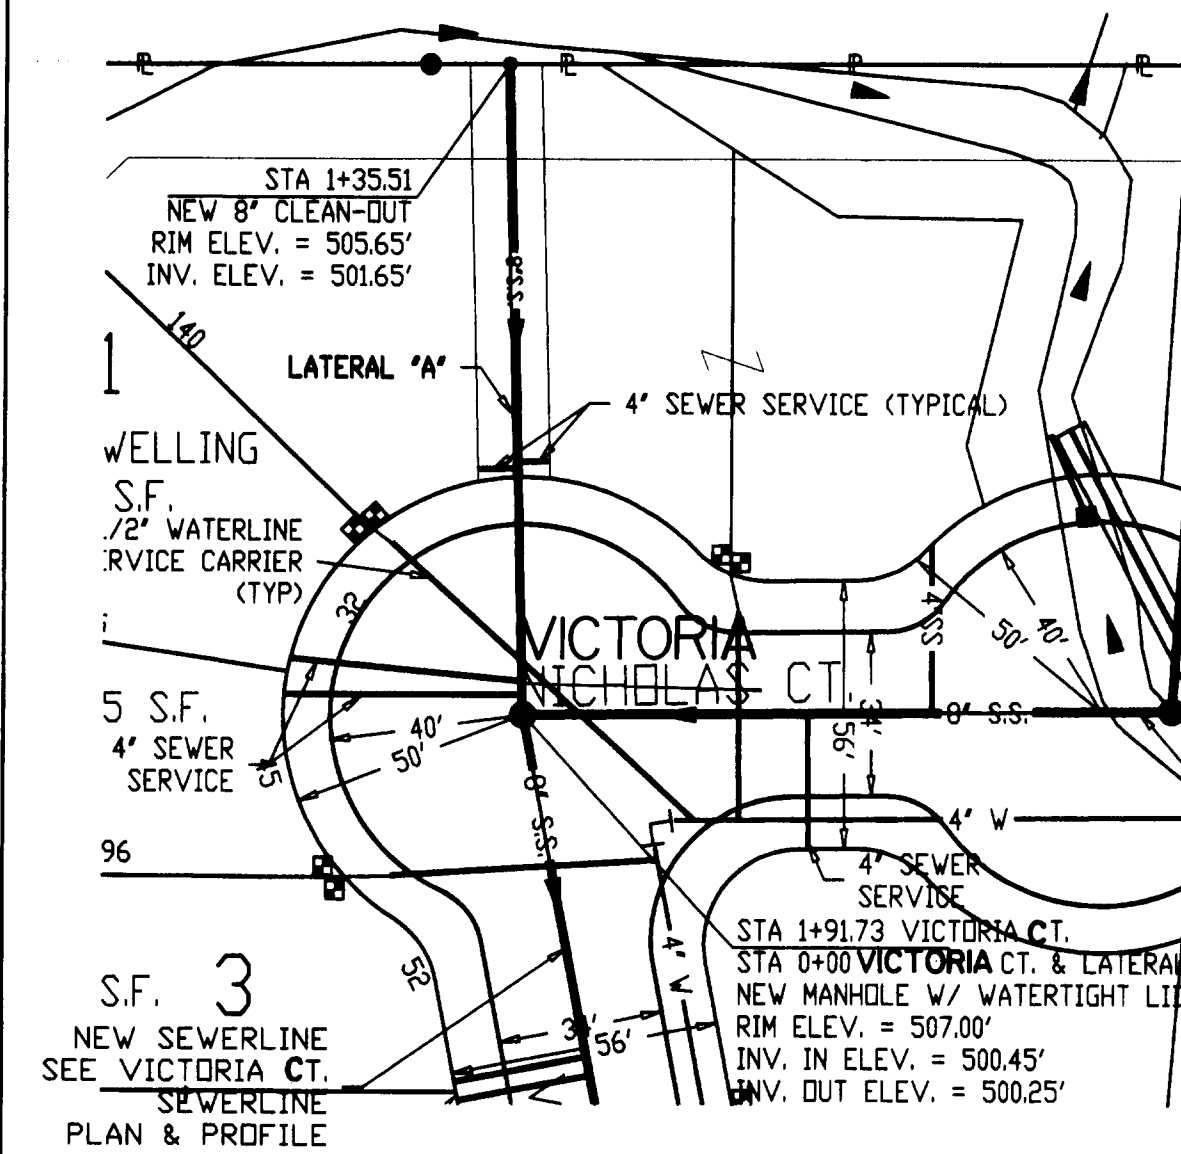


SCALES:
1" = 40' HOR
1" = 5' VER

LATERAL "B"

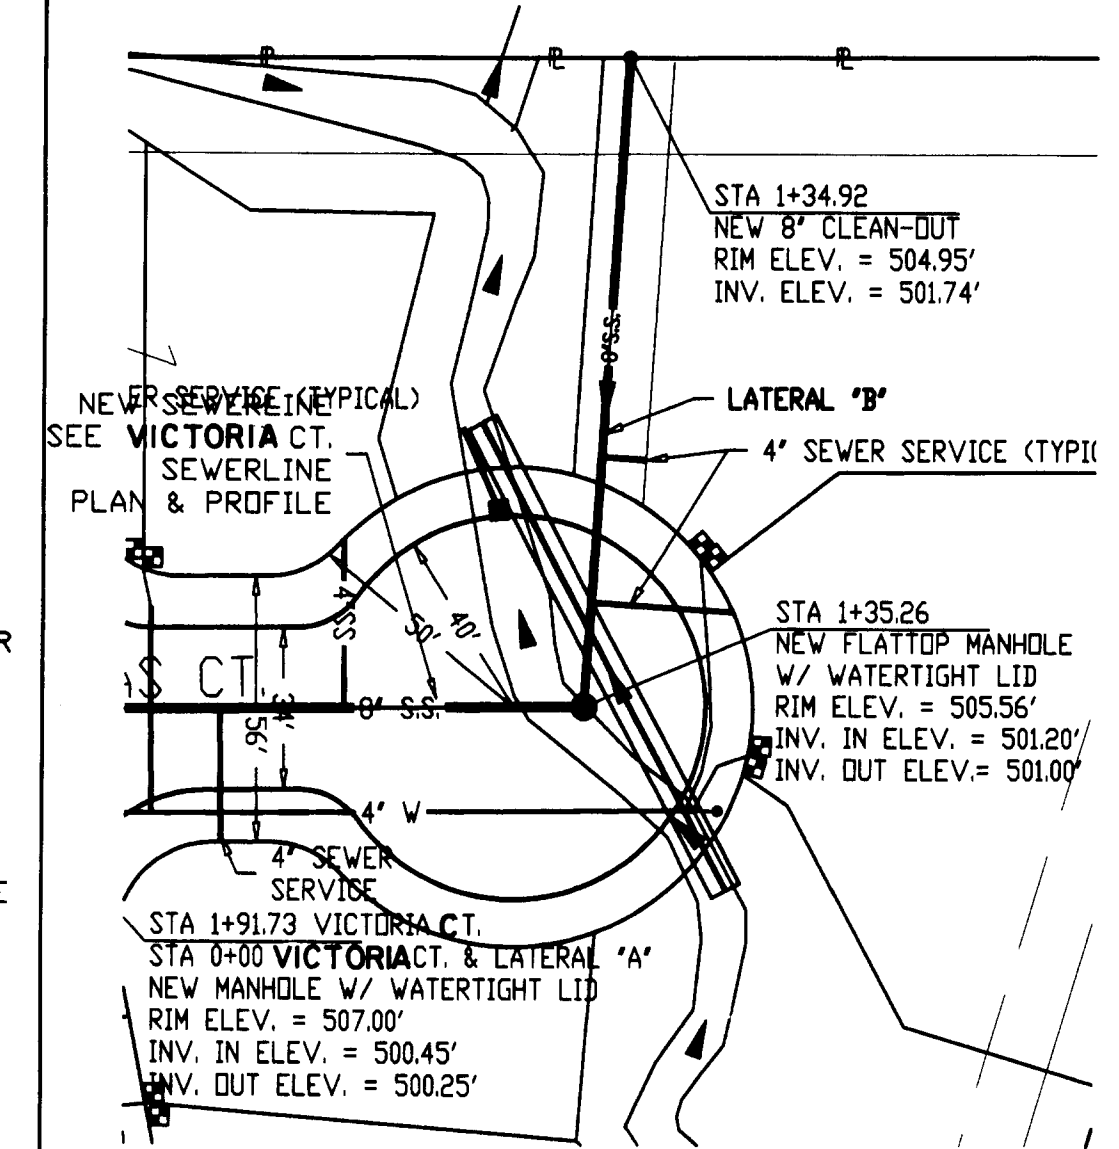


SCALES:
1" = 40' HOR
1" = 5' VER



VICTORIA
NICHOLAS CT. SEWERLINE

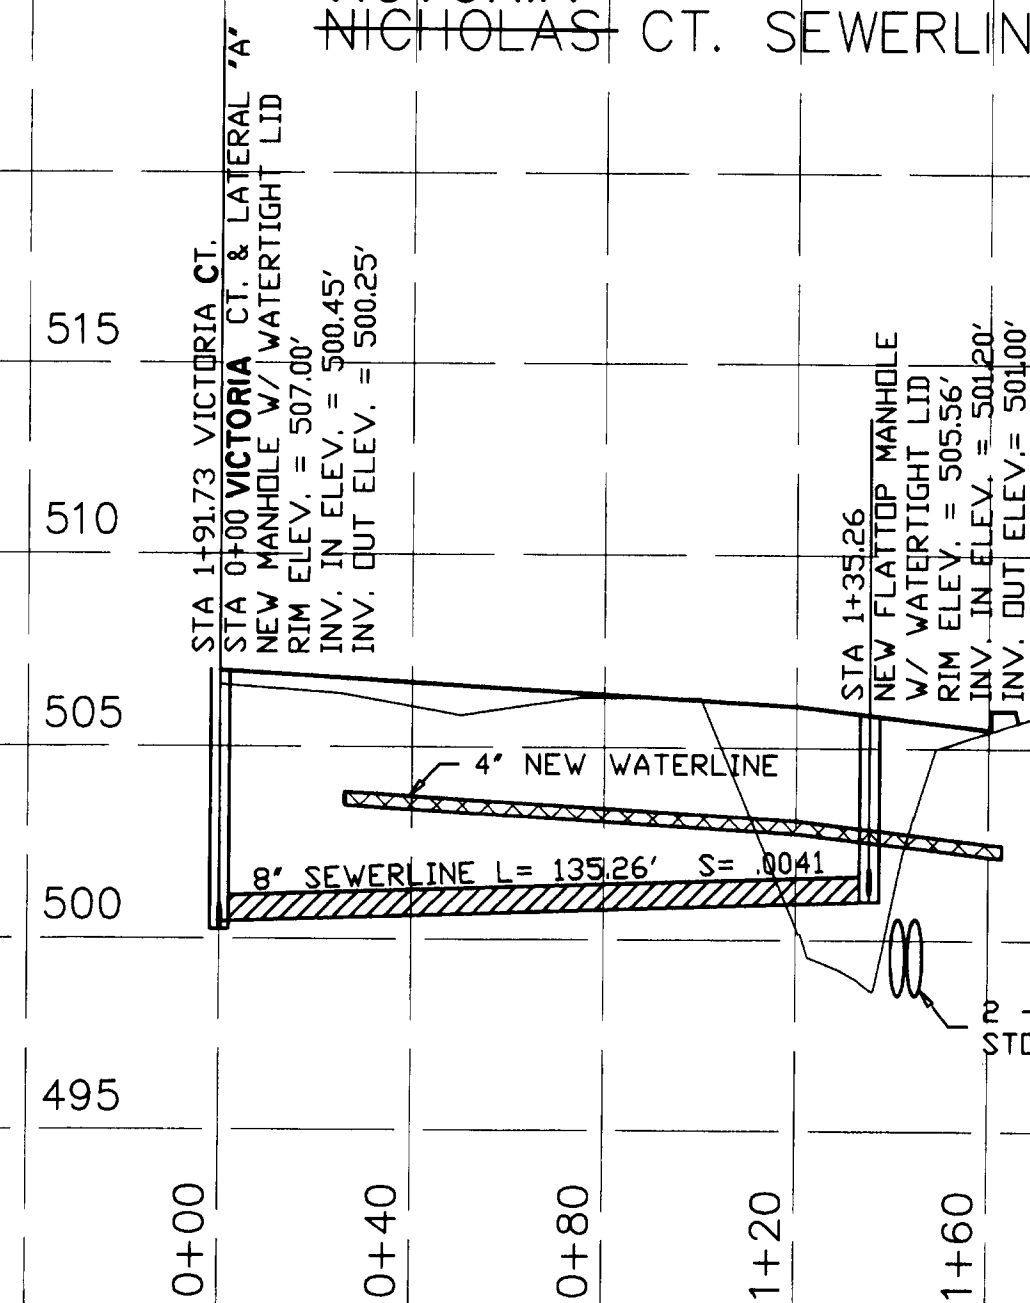

LATERAL "A"

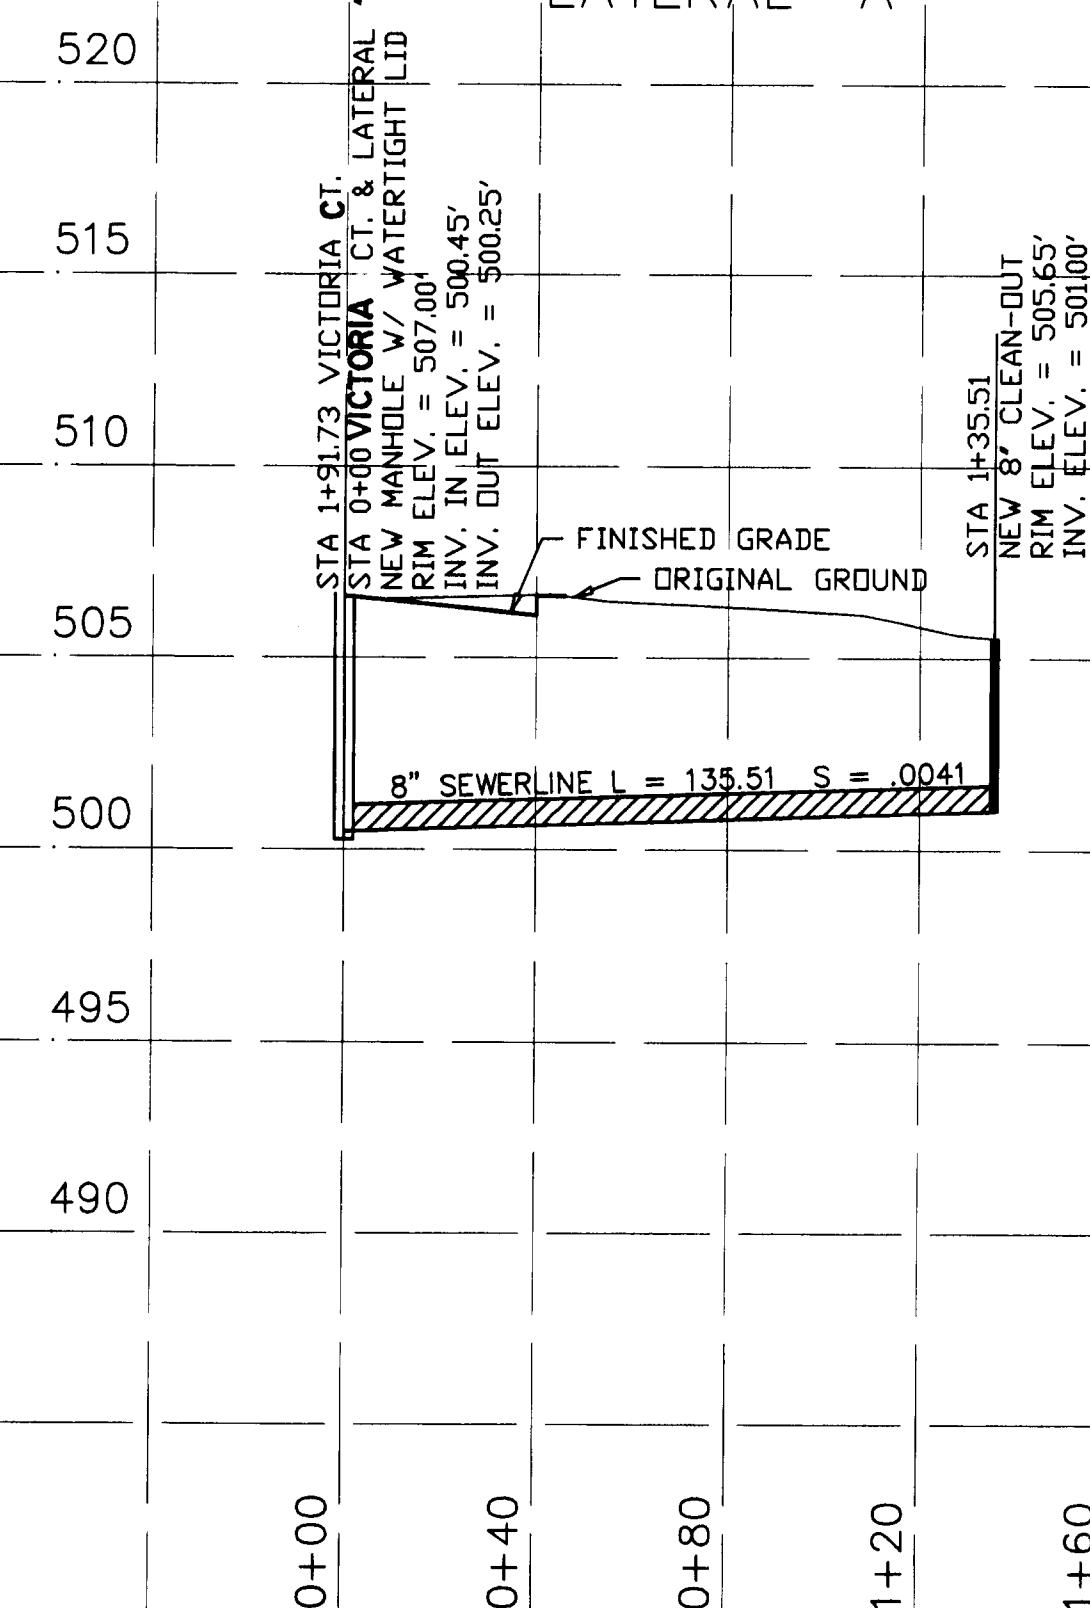

LATERAL "B"

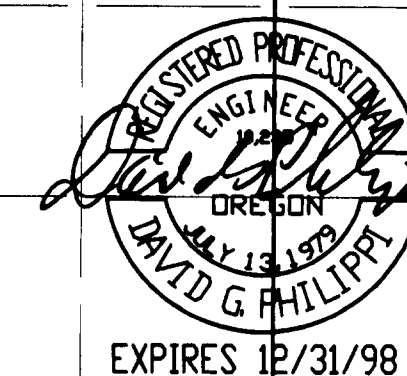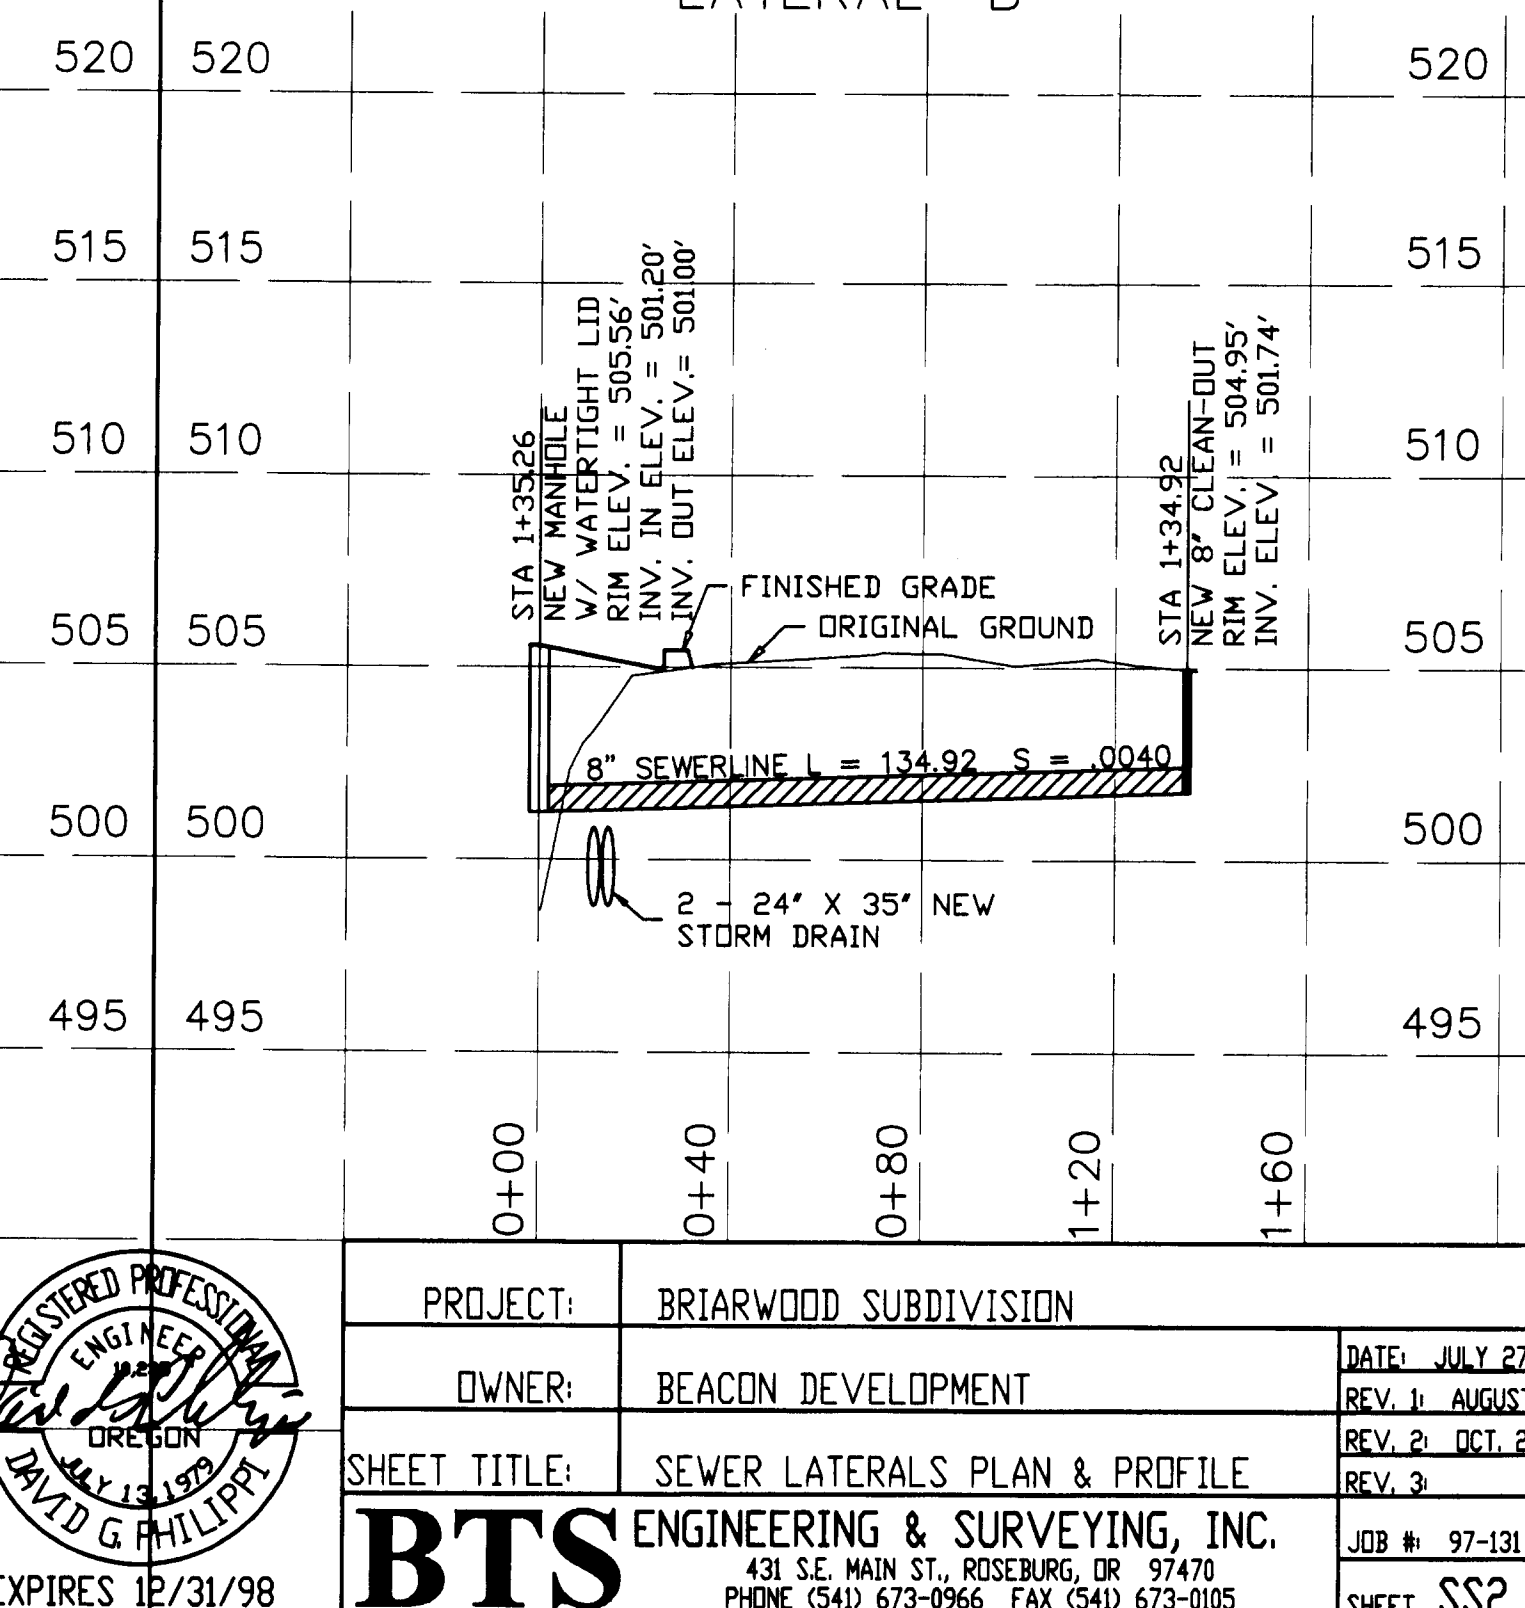

PROJECT:	BRIARWOOD SUBDIVISION	DATE:	JULY 27, 1998
OWNER:	BEACON DEVELOPMENT	REV. 1:	AUGUST 25, 1998
SHEET TITLE:	SEWER LATERALS PLAN & PROFILE	REV. 2:	OCT. 26, 1998
		REV. 3:	
		JOB #:	97-131
		SHEET	SS2 OF 3

BTS ENGINEERING & SURVEYING, INC.
431 S.E. MAIN ST., ROSEBURG, OR 97470
PHONE (541) 673-0966 FAX (541) 673-0105