


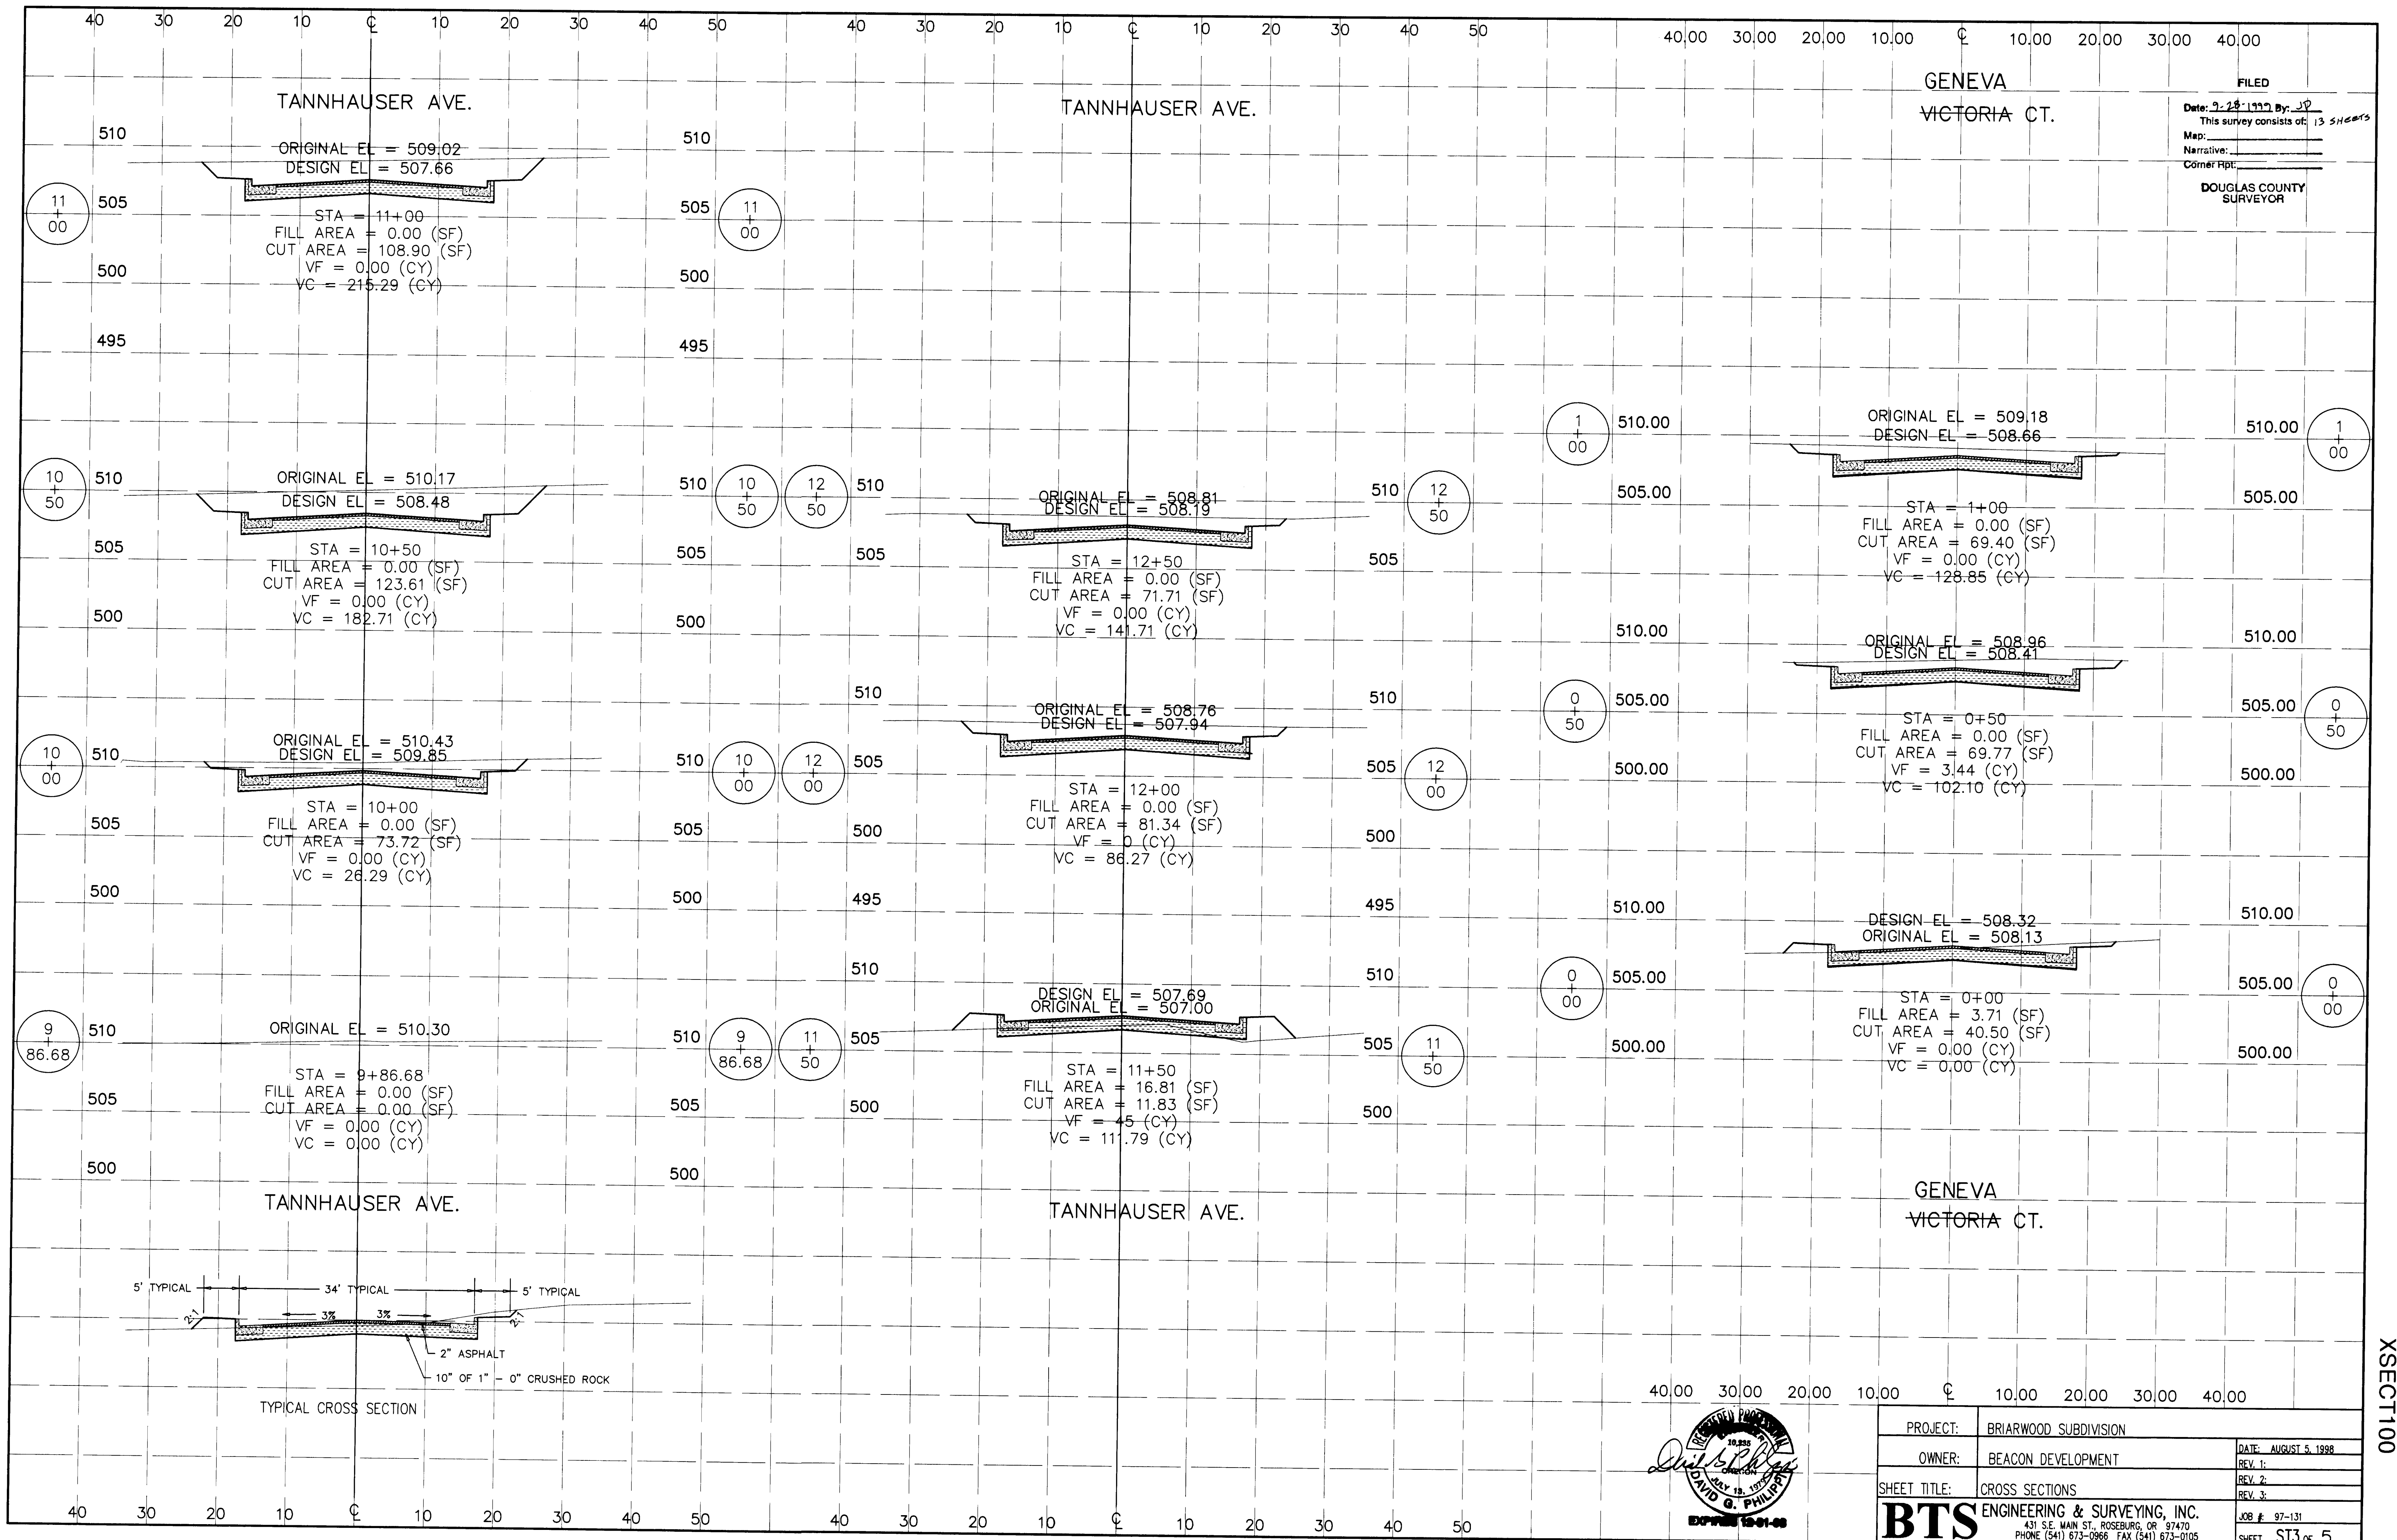

FILED

Date: 7-28-1997 By: JDP

This survey consists of: 13 SHEETS

Map: _____

Narrative: _____

Corner Rpt: _____

DOUGLAS COUNTY SURVEYOR

PROJECT:	BRIARWOOD SUBDIVISION	DATE:	AUGUST 5, 1998
OWNER:	BEACON DEVELOPMENT	REV. 1:	
SHEET TITLE:	CROSS SECTIONS	REV. 2:	
		REV. 3:	
		JOB #:	97-131
		SHEET	ST3 OF 5

BTS ENGINEERING & SURVEYING, INC.
431 S.E. MAIN ST. ROSEBURG, OR 97470
PHONE (541) 673-0966 FAX (541) 673-0105

XSECTION 100