
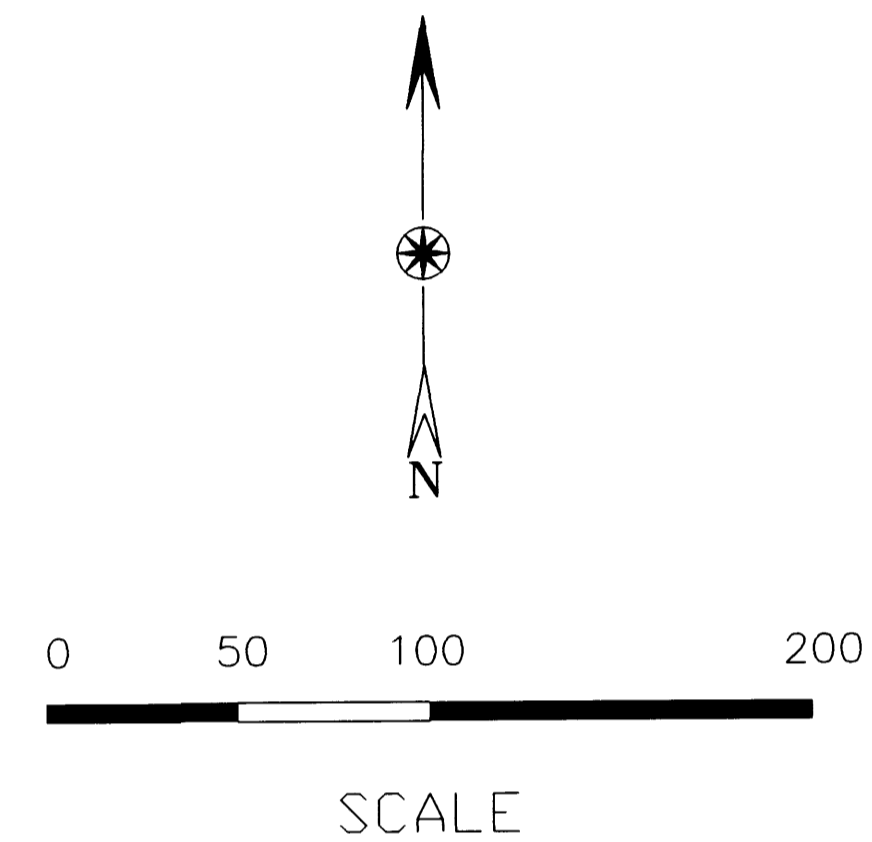


FILED
 Date: 7/1/2002 By: JP
 This survey consists of:
 Map: _____
 Narrative: _____
 Corner Rpt: _____
DOUGLAS COUNTY
SURVEYOR


THIS SHEET SHOWS DISTANCES FROM MAIN STREET CENTER LINE MONUMENTS TO BUILDING FRONTS/BACK OF WALKS AND TO BACK OF CURB. PROPERTY LINES MAY NOT BE CONSISTENT WITH MONUMENTED MAIN STREET CENTER LINE.

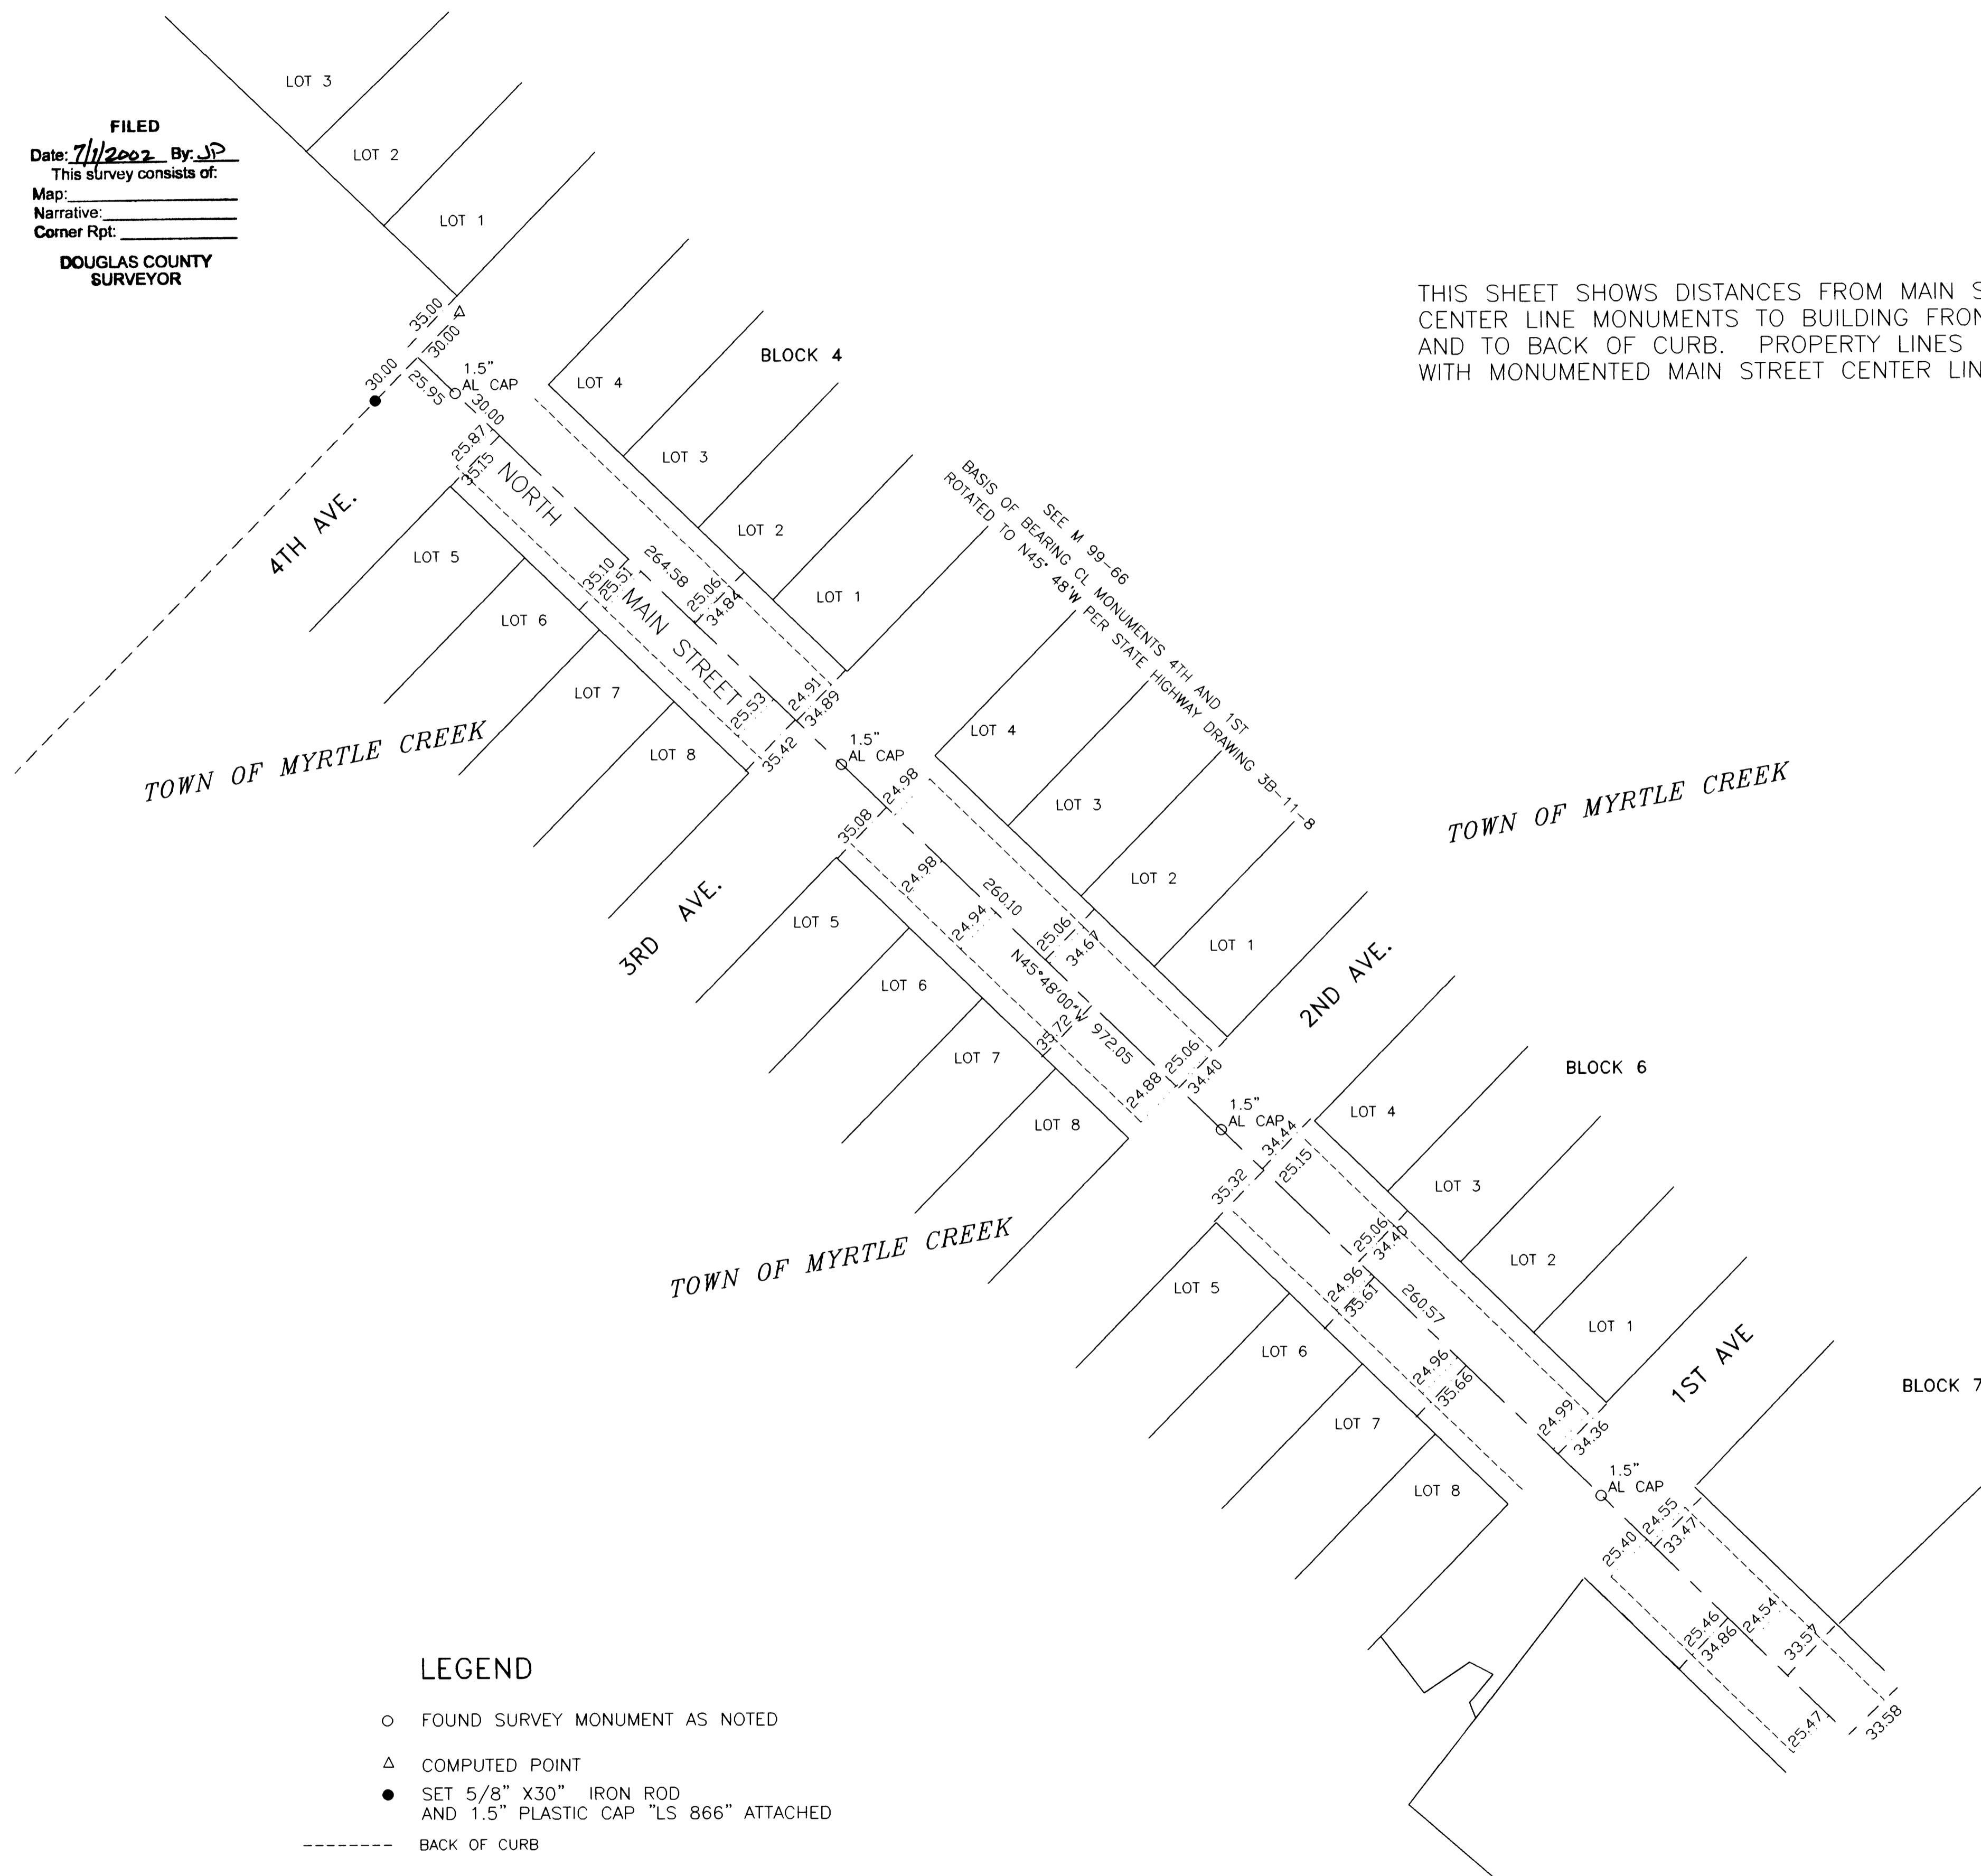

LEGEND

- FOUND SURVEY MONUMENT AS NOTED
- △ COMPUTED POINT
- SET 5/8" X30" IRON ROD AND 1.5" PLASTIC CAP "LS 866" ATTACHED
- BACK OF CURB

SEE SHEET 1 FOR SURVEY NARRATIVE

CENTER LINE SURVEY	
OF OLD PACIFIC HIGHWAY 99 NOW COUNTY ROAD 386	
IN THE NORTH 1/2 AND EAST 1/2 SECTION 28, AND THE NE 1/4 OF SECTION 33, T.29S., R.5W., W.M.	
REGISTERED OREGON LAND SURVEYOR  JULY 12, 1968 WILLIAM J. RUPPERT 866 MY REGISTRATION EXPIRES 12/31/2002	Surveyed by: CITY OF MYRTLE CREEK WILLIAM J. RUPPERT P.O. BOX 940 MYRTLE CREEK, OR 97457 SCALE 1"=50' JUNE 2002 SHEET 7 OF 7

00620079