

N.W. 1/4 SEC. 5, T. 30 S., R. 5 W., W.M.


FILED  
 Date: 2/28/2008 By: JP  
 This survey consists of:  
 Map:  
 Narrative:  
 Corner Rpt:  
**DOUGLAS COUNTY SURVEYOR**

TABLE OF SET MONUMENTS

Q STATION	OFFSET	SIDE	NORTHING	EASTING
365+65.59 PT	42'	LEFT	95,230.023	247,036.296
"	42'	RIGHT	95,180.802	247,104.364

TABLE OF FOUND MONUMENTS

NO.	NORTHING	EASTING	RECORD	DESCRIPTION
45	95,685.432	247,454.035	M12-10	1" I. Pipe
46	95,636.876	247,418.892	V13 P11	1" I. Pipe
47	95,592.339	247,386.659	M12-10	1" I. Pipe
48	95,447.716	247,281.999	M55-11	1" I. Pipe
49	95,409.165	247,180.921	M11-41	1 1/2" I. Pipe
50	95,203.563	247,035.487	M11-41	2" I. Pipe bent
51	95,279.091	247,160.027	M55-11	1" I. Pipe
52	95,126.522	247,049.607	M77-38	5/8" I.R.
53	95,119.295	247,044.296	M77-38	5/8" I.R.

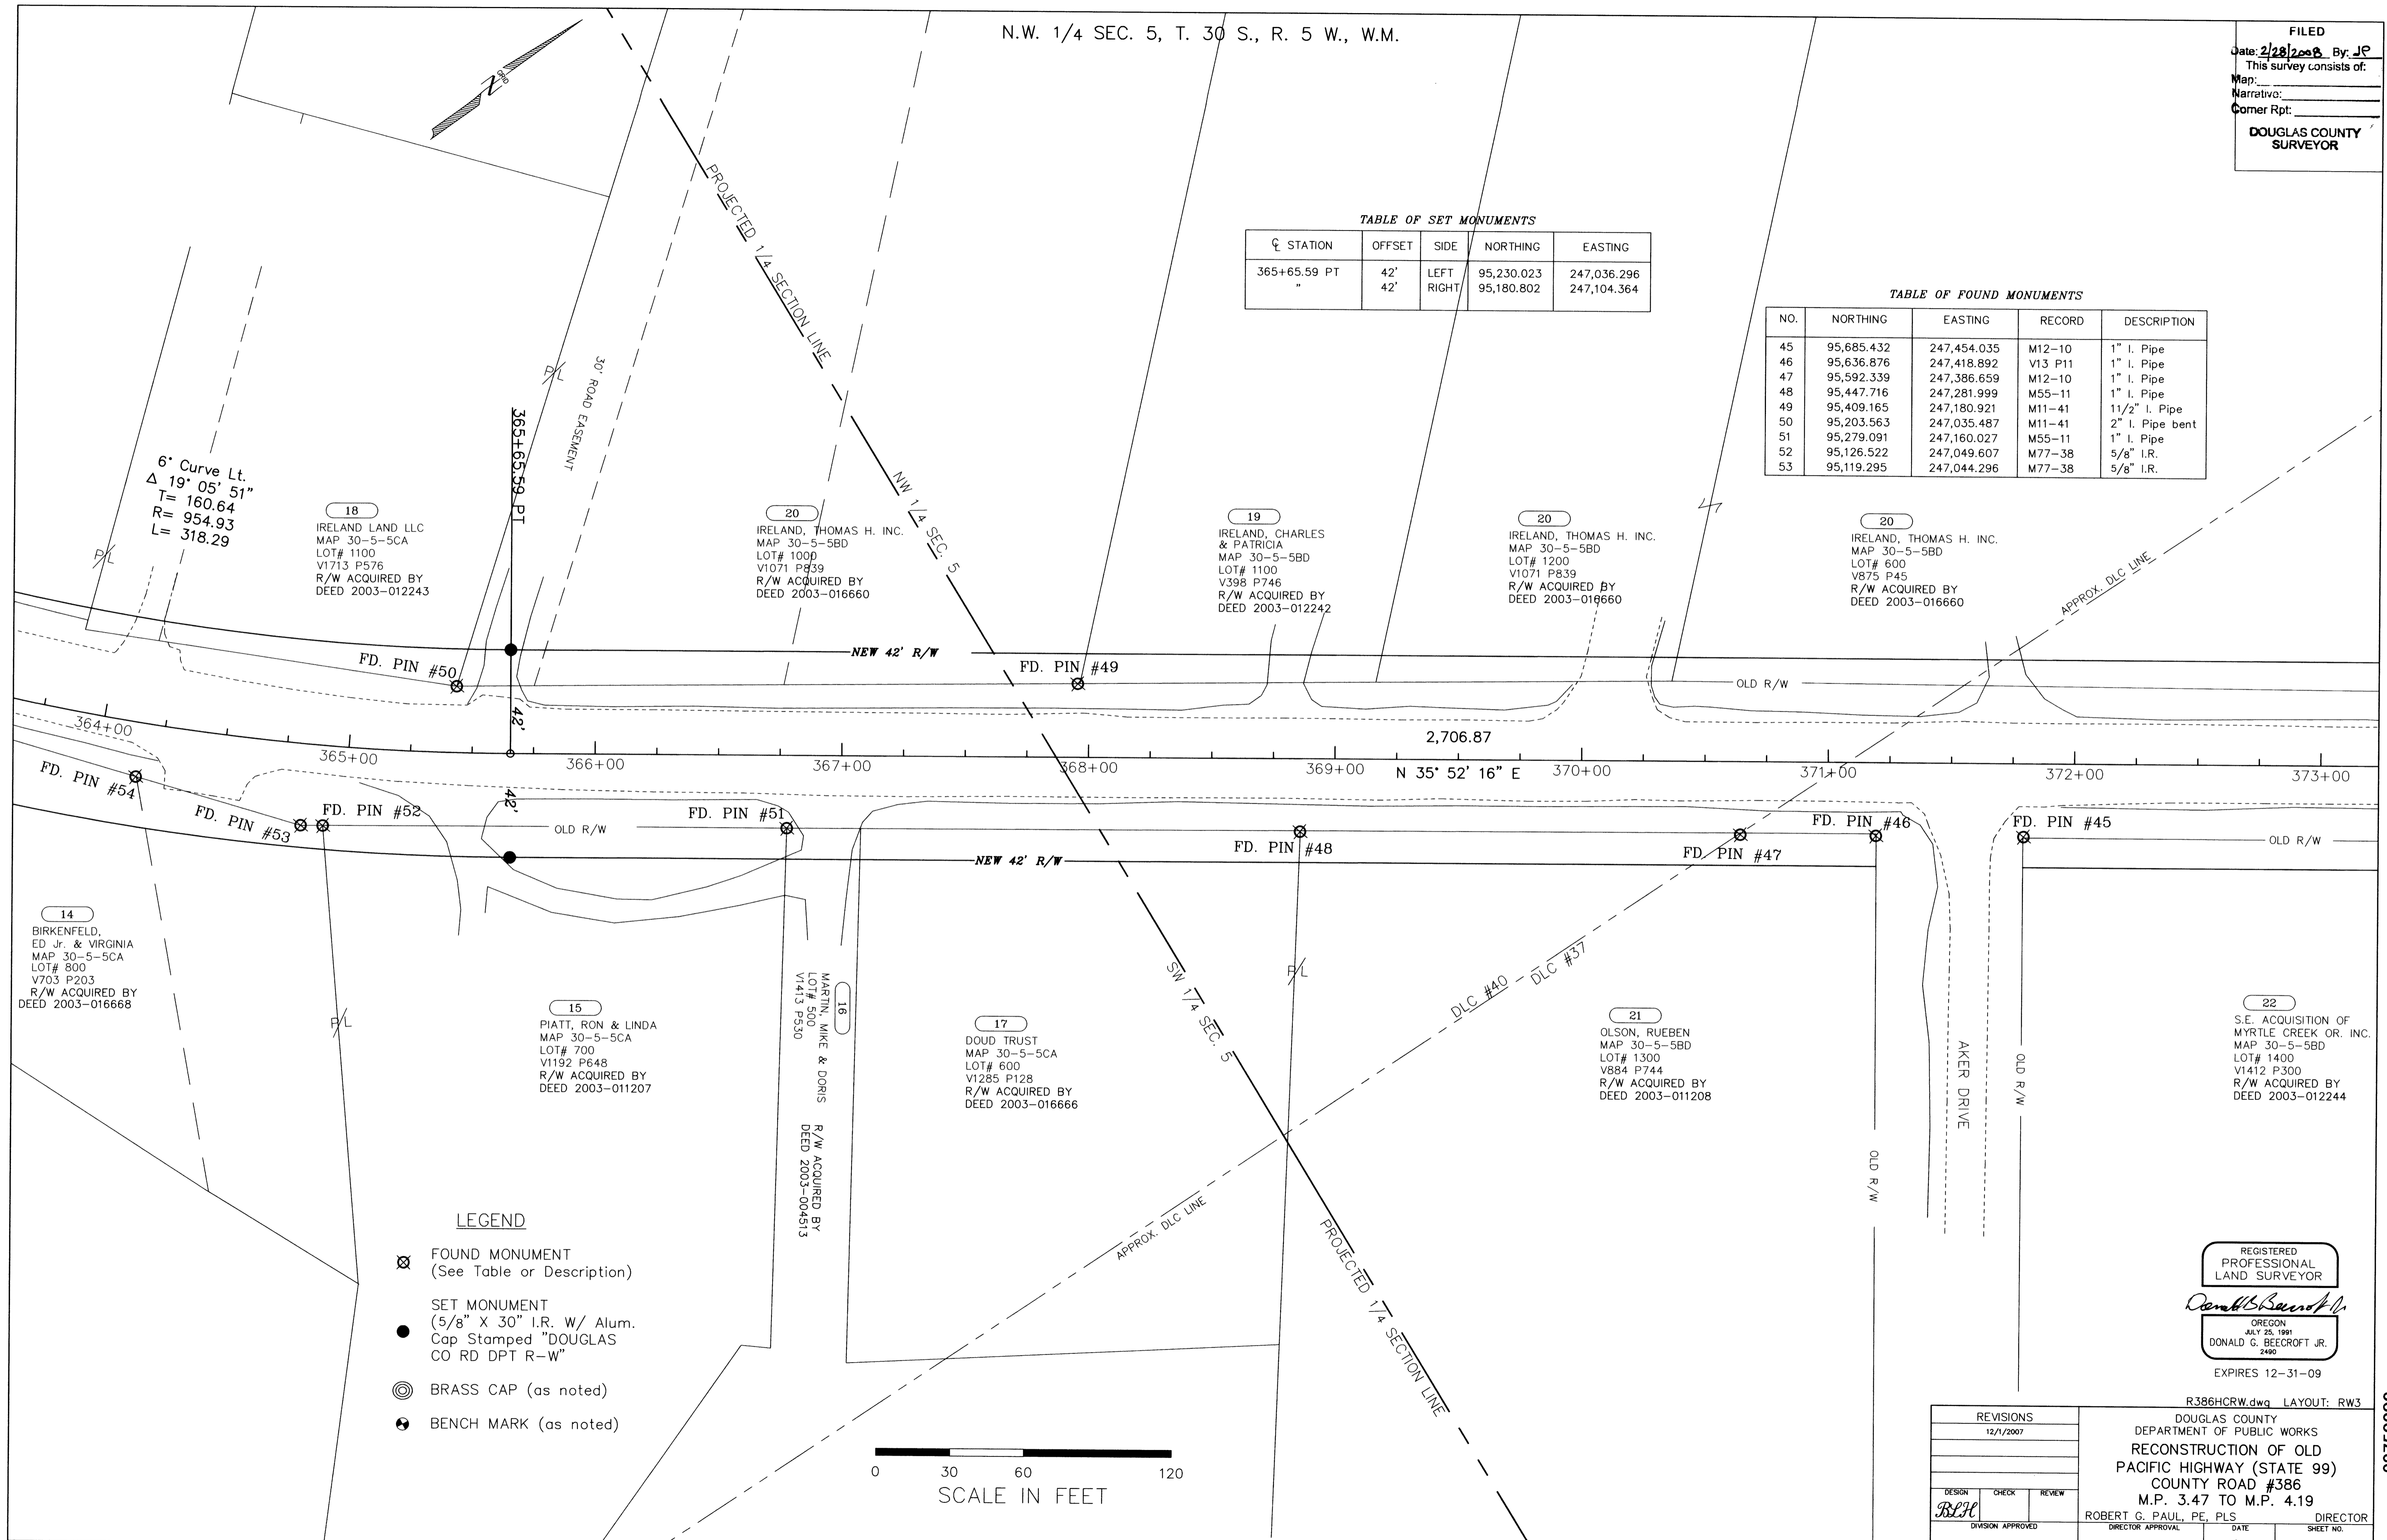

18  
 IRELAND LAND LLC  
 MAP 30-5-SCA  
 LOT# 1100  
 V1713 P576  
 R/W ACQUIRED BY  
 DEED 2003-012243

20  
 IRELAND, THOMAS H. INC.  
 MAP 30-5-5BD  
 LOT# 1000  
 V1071 P839  
 R/W ACQUIRED BY  
 DEED 2003-016660

19  
 IRELAND, CHARLES  
 & PATRICIA  
 MAP 30-5-5BD  
 LOT# 1100  
 V398 P746  
 R/W ACQUIRED BY  
 DEED 2003-012242

20  
 IRELAND, THOMAS H. INC.  
 MAP 30-5-5BD  
 LOT# 1200  
 V1071 P839  
 R/W ACQUIRED BY  
 DEED 2003-016660

20  
 IRELAND, THOMAS H. INC.  
 MAP 30-5-5BD  
 LOT# 600  
 V875 P45  
 R/W ACQUIRED BY  
 DEED 2003-016660

14  
 BIRKENFELD,  
 ED JR. & VIRGINIA  
 MAP 30-5-SCA  
 LOT# 800  
 V703 P203  
 R/W ACQUIRED BY  
 DEED 2003-016668

15  
 PIATT, RON & LINDA  
 MAP 30-5-SCA  
 LOT# 700  
 V1192 P648  
 R/W ACQUIRED BY  
 DEED 2003-011207

16  
 MARTIN, MIKE & DORIS  
 LOT# 500  
 V1413 P530  
 R/W ACQUIRED BY  
 DEED 2003-004513


17  
 DOUD TRUST  
 MAP 30-5-SCA  
 LOT# 600  
 V1285 P128  
 R/W ACQUIRED BY  
 DEED 2003-016666

21  
 OLSON, RUEBEN  
 MAP 30-5-5BD  
 LOT# 1300  
 V884 P744  
 R/W ACQUIRED BY  
 DEED 2003-011208

22  
 S.E. ACQUISITION OF  
 MYRTLE CREEK OR. INC.  
 MAP 30-5-5BD  
 LOT# 1400  
 V1412 P300  
 R/W ACQUIRED BY  
 DEED 2003-012244

LEGEND

- ⊗ FOUND MONUMENT  
(See Table or Description)
- SET MONUMENT  
(5/8" X 30" I.R. W/ Alum.  
Cap Stamped "DOUGLAS  
CO RD DPT R-W")
- ⊙ BRASS CAP (as noted)
- ⊕ BENCH MARK (as noted)

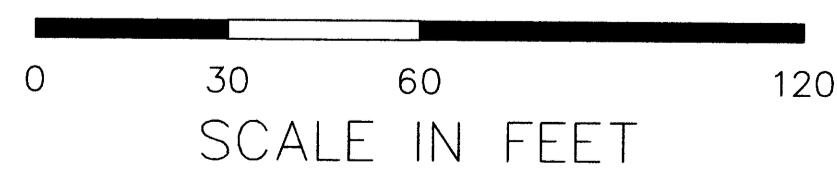

REGISTERED  
 PROFESSIONAL  
 LAND SURVEYOR

*Donald G. Beecroft Jr.*  
 OREGON  
 JULY 25, 1991  
 DONALD G. BEECROFT JR.  
 2490

EXPIRES 12-31-09

REVISIONS			R386HCRW.dwg LAYOUT: RW3	
12/1/2007			DOUGLAS COUNTY DEPARTMENT OF PUBLIC WORKS	
			RECONSTRUCTION OF OLD PACIFIC HIGHWAY (STATE 99) COUNTY ROAD #386 M.P. 3.47 TO M.P. 4.19	
DESIGN	CHECK	REVIEW	DIRECTOR APPROVAL	DIRECTOR
<i>RLH</i>			ROBERT G. PAUL, PE, PLS	
DIVISION APPROVED			DATE	SHEET NO.
			12/2007	SHEET 4 OF 6

03750390