

N.W. 1/4 SEC. 5, T. 30 S., R. 5 W., W.M.


FILED
 Date: 2/29/2008 By: JC
 This survey consists of:
 Map: _____
 Narrative: _____
 Corner Rpt: _____
 DOUGLAS COUNTY
 SURVEYOR

TABLE OF SET MONUMENTS

STATION	OFFSET	SIDE	NORTHING	EASTING
374+00.00 POT	42'	LEFT	95,906.175	247,525.227
"	42'	RIGHT	95,856.954	247,593.295

20
 IRELAND, THOMAS H. INC.
 MAP 30-5-5BD
 LOT# 600
 REF. 84-03076
 R/W ACQUIRED BY
 DEED 2003-016660

INITIAL POINT
 S. UMPQUA
 RIVER TRACTS
 FD. PIN #43

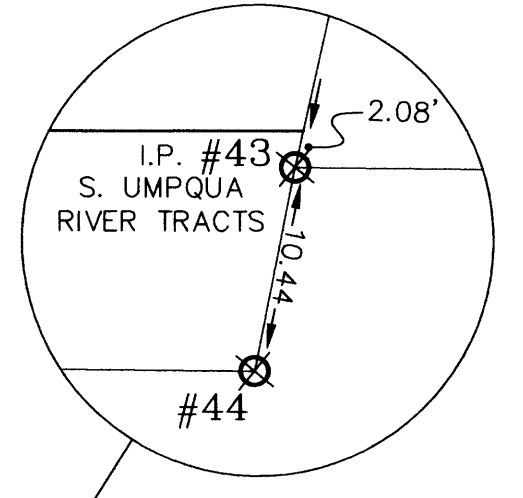

14
 OKONEK, DONALD &
 GAYLE
 MAP 30-5-5BD
 LOT# 500
 REF. 67-02738

13
 PETERSON, RICHARD
 MAP 30-5-5BD
 LOT# 400
 REF. 98-02189

12
 LOZANO, SHARON
 BUMGARDNER
 MAP 30-5-5BD
 LOT# 300
 REF. 335149

11
 WOOD, LARRY &
 KONSTANTINA
 MAP 30-5-5BD
 LOT# 200
 REF. 74-13225

10
 BOLTON, FREDRIC
 MAP 30-5-5BD
 LOT# 100
 REF. 89-11321

9
 BOLTON, FREDRIC
 MAP 30-5-5AB
 LOT# 4900
 REF. 89-11320

NEW 42' R/W
 OLD R/W

NO FURTHER R/W PURCHASES THIS SIDE

FD. PIN #2
 FD. PIN #3
 FD. PIN #6
 FD. PIN #9

2,706.87

373+00 374+00 375+00 376+00 377+00 378+00 379+00 380+00 381+00 382+00
 N 35° 52' 16" E

NEW 42' R/W
 OLD R/W

BENCH MARK
 DCSO Brass
 Cap "MORT"
 Destroyed

FD. PIN #4
 FD. PIN #7
 FD. PIN #8

22
 S.E. ACQUISITION OF
 MYRTLE CREEK OR. INC.
 MAP 30-5-5BD
 LOT# 1400
 V1412 P300
 R/W ACQUIRED BY
 DEED 2003-012244

LEGEND


- ⊗ FOUND MONUMENT
(See Table or Description)
- SET MONUMENT
(5/8" X 30" I.R. W/ Alum.
Cap Stamped "DOUGLAS
CO RD DPT R-W")
- ⊙ BRASS CAP (as noted)
- ⊕ BENCH MARK (as noted)

29
 ST. MATTHEWS LUTEHRAN CHURCH
 MAP 30-5-5AC
 LOT# 2000
 V867 P492
 R/W ACQUIRED BY
 DEED 2003-013722

29
 ST. MATTHEWS LUTEHRAN CHURCH
 MAP 30-5-5AC
 LOT# 1900
 V821 P61
 R/W ACQUIRED BY
 DEED 2003-013722

TABLE OF FOUND MONUMENTS

NO.	NORTHING	EASTING	RECORD	DESCRIPTION
43	95,953.580	247,561.957	V8 P45	2" I. Pipe
44	95,946.098	247,569.238	M11-41	5/8" I.R.
2	96,260.415	247,784.699	M116-6	5/8" I.R.
3	96,280.523	247,799.324	M116-6	5/8" I.R.
4	96,293.211	247,894.844	CS 51-81	1/2" I. Pipe
6	96,422.062	247,902.049	M116-6	5/8" I.R.
7	96,416.565	247,985.269	V13 P11	5/8" I.R.
8	96,465.255	248,020.295	V13 P11	1 1/2" I. Pipe
9	96,503.467	247,959.706	V8 P45	1 1/2" I. Pipe

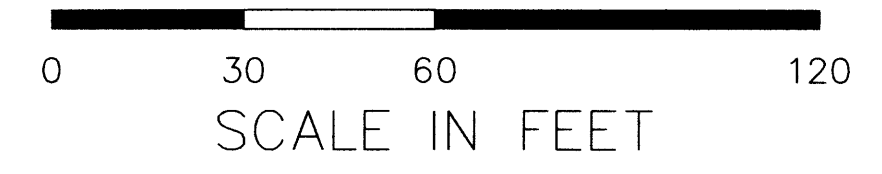

PROJECTED 1/4 SECTION LINE
 NW 1/4 SEC. 5

REGISTERED
 PROFESSIONAL
 LAND SURVEYOR
 Donald B. Beecroft
 OREGON
 JULY 25, 1991
 DONALD G. BEECROFT JR.
 2490
 EXPIRES 12-31-09

REVISIONS		
		12/1/2007
DESIGN	CHECK	REVIEW
DIVISION APPROVED	DIRECTOR APPROVAL	DATE
		12/2007
		SHEET NO.
		5 OF 6

R386HCRW.dwg LAYOUT: RW4
 DOUGLAS COUNTY
 DEPARTMENT OF PUBLIC WORKS
 RECONSTRUCTION OF OLD
 PACIFIC HIGHWAY (STATE 99)
 COUNTY ROAD #386
 M.P. 3.47 TO M.P. 4.19
 ROBERT G. PAUL, PE, PLS DIRECTOR