


VICINITY MAP

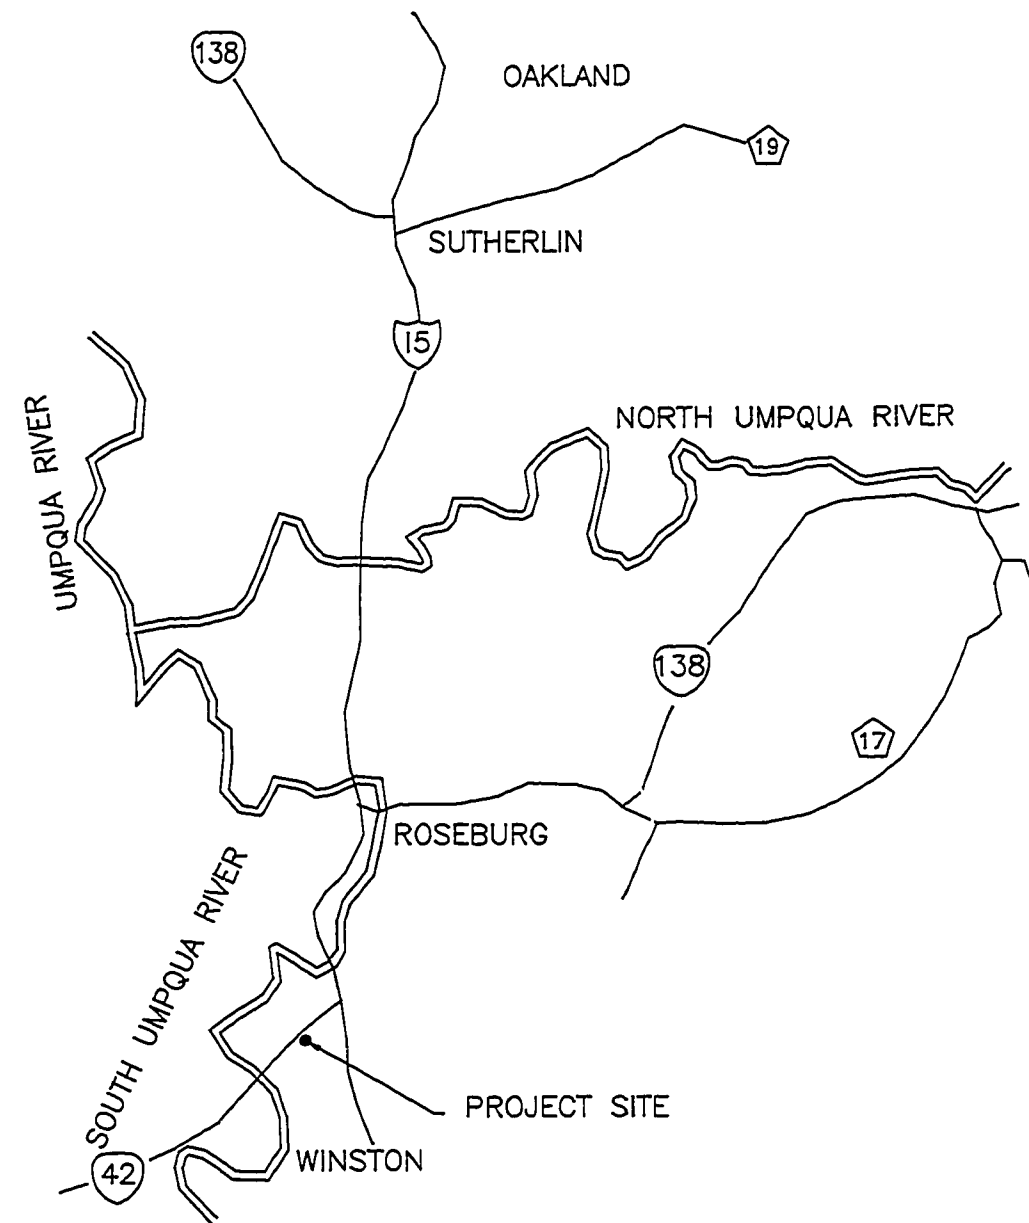

K.I.S.-GRANGE SUBDIVISION

AS-BUILT PLANS




SCALE: 1 IN = 50 FT

FILED

Date: 9-23-97 By: JP
 This survey consists of:
 Map: Co. Rd. # 401
 Narrative: _____
 Corner Rpt: _____


DOUGLAS COUNTY
SURVEYOR

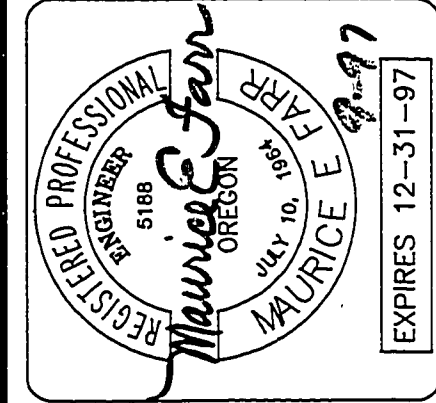

K.I.S.-GRANGE SUBDIVISION
GRANGE ROAD
ROSEBURG, OR

TITLE SHEET

SHEET
1 OF 6

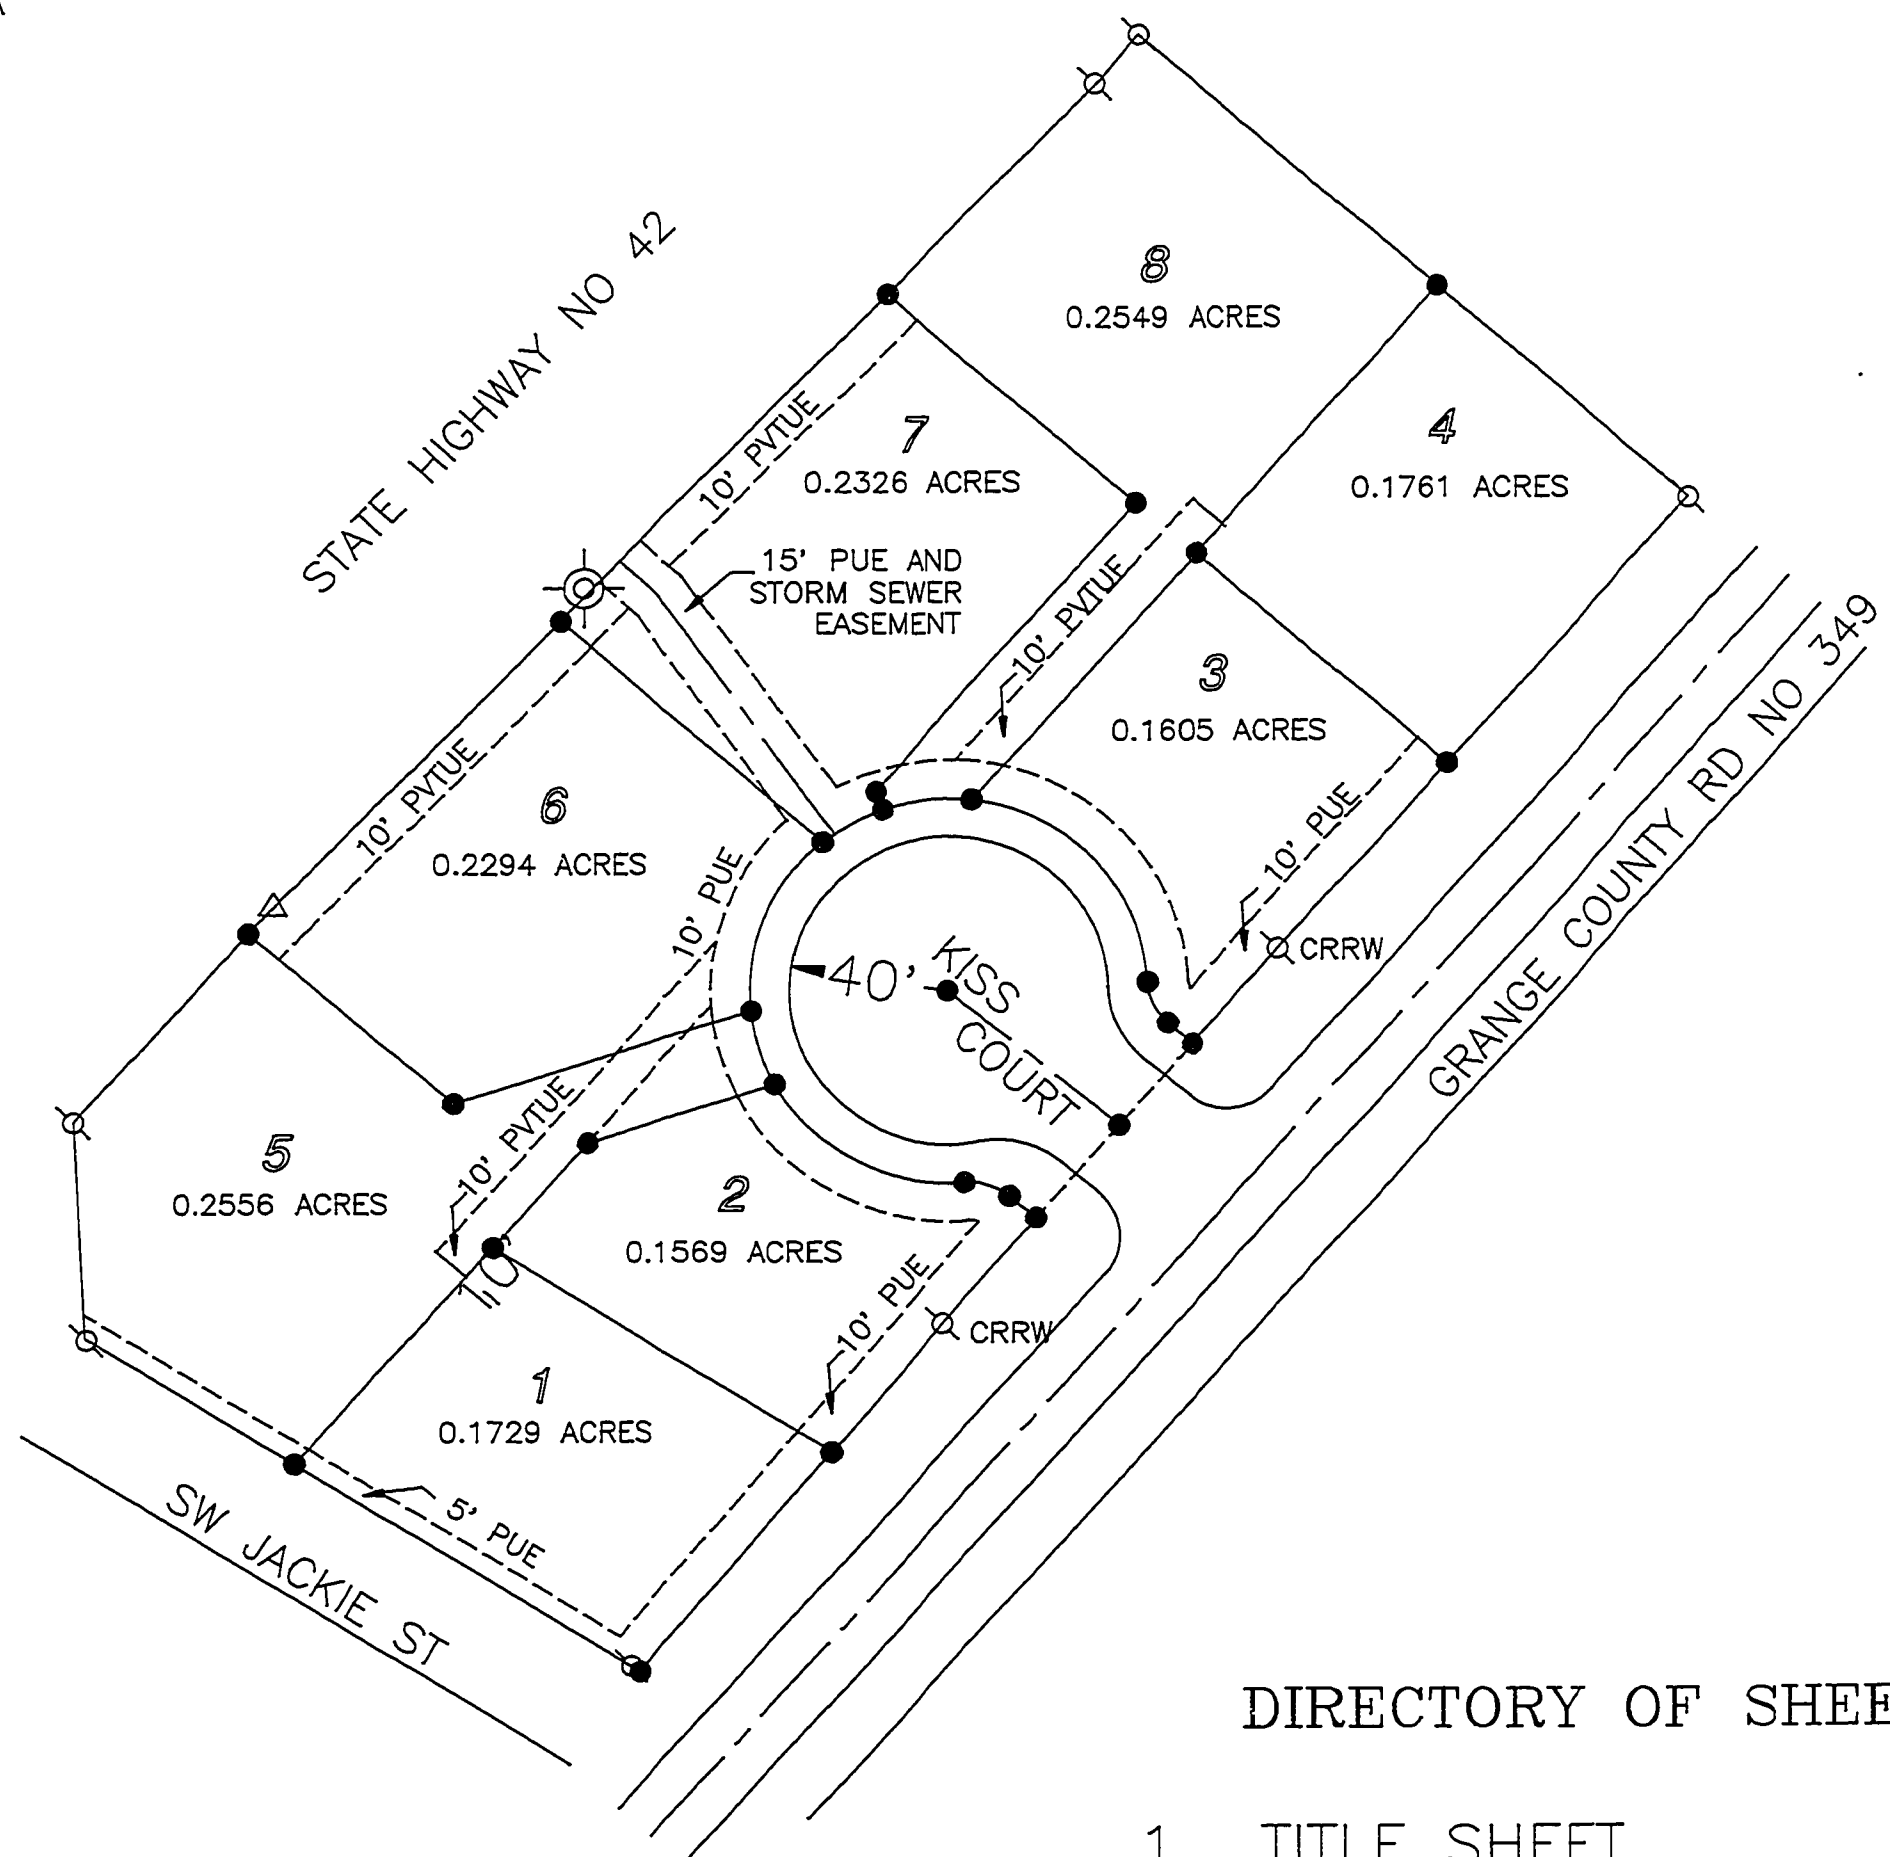

DIRECTORY OF SHEETS

- 1 TITLE SHEET
- 2 STREET PLANS
- 3 WATER SYSTEM DETAILS
- 4 SANITARY SEWER DETAILS
- 5 SANITARY SEWER SPECIFICATIONS
- 6 STORM SEWER DETAILS

OWNER-DEVELOPER
 RODNEY IMMING, ET AL
 850 SE SUMMIT DRIVE
 ROSEBURG, OR 97470
 PH (541) 672-0336

COMPREHENSIVE PLAN ZONING R-1
 MED DENSITY RESIDENTIAL
 GREEN SANITARY DISTRICT
 ROBERTS CREEK WATER DISTRICT
 #96-325

CO. RD. #401

RD401COV

CO. RD. #401 82