
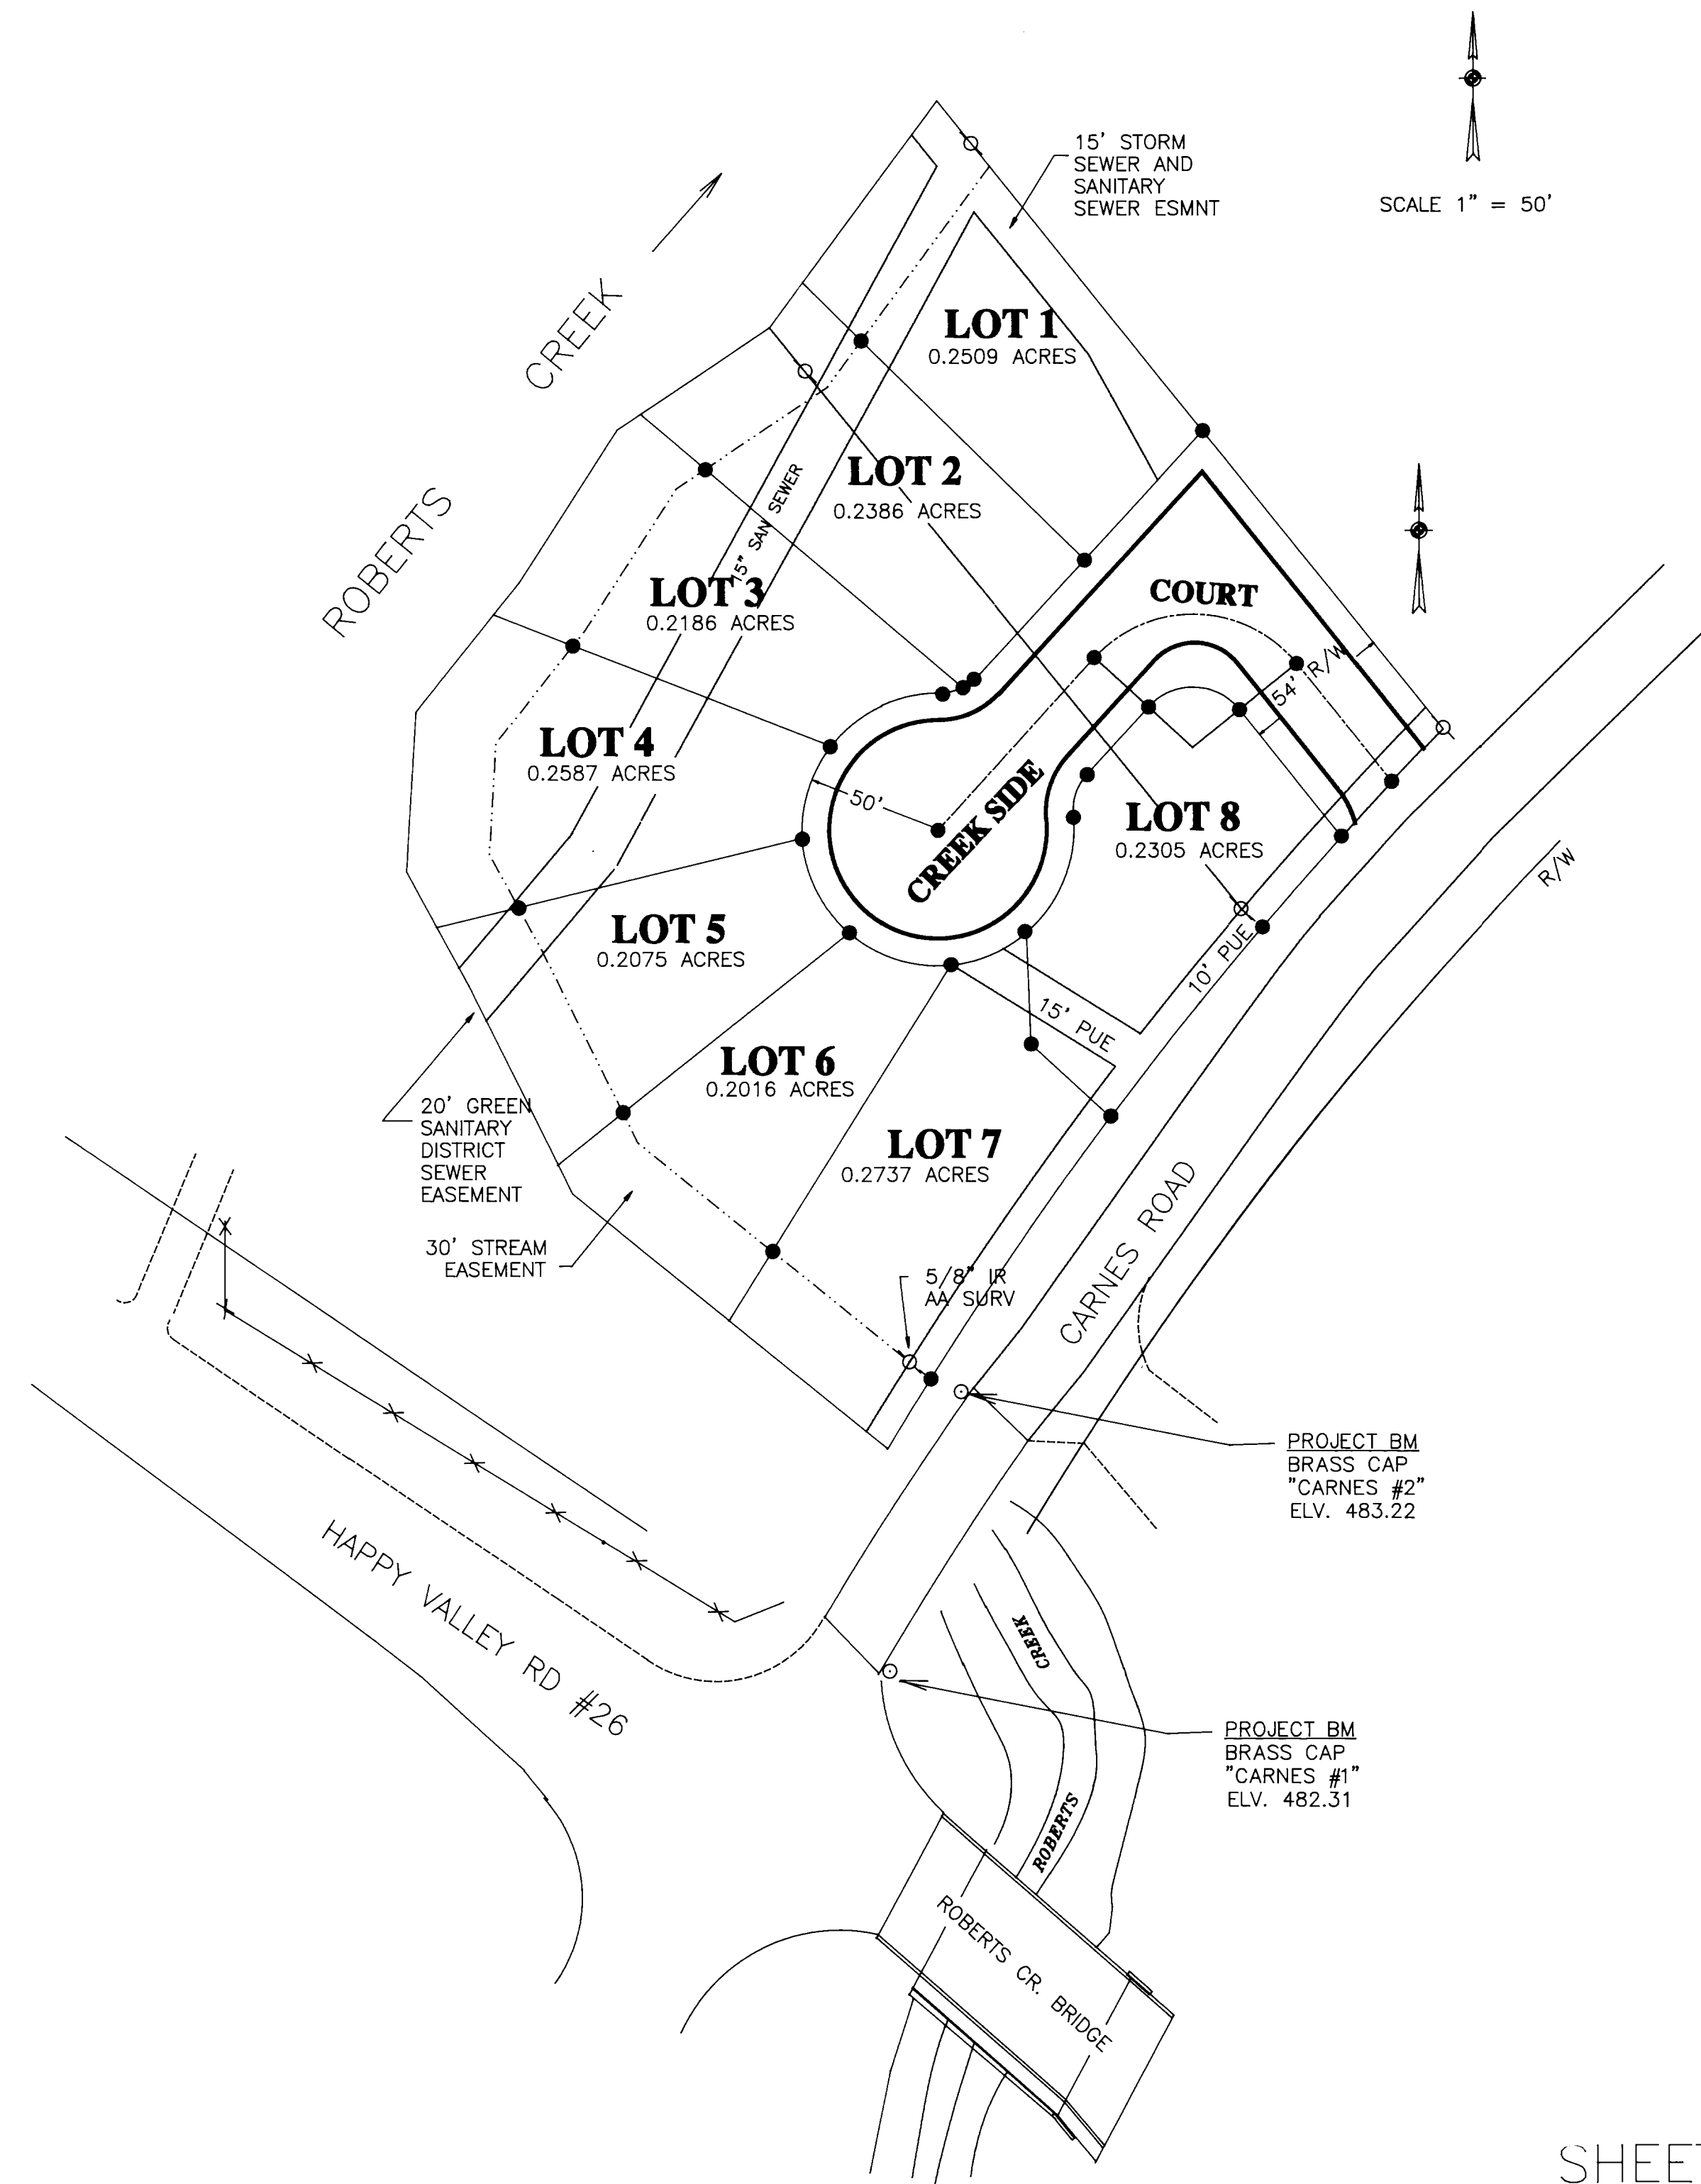
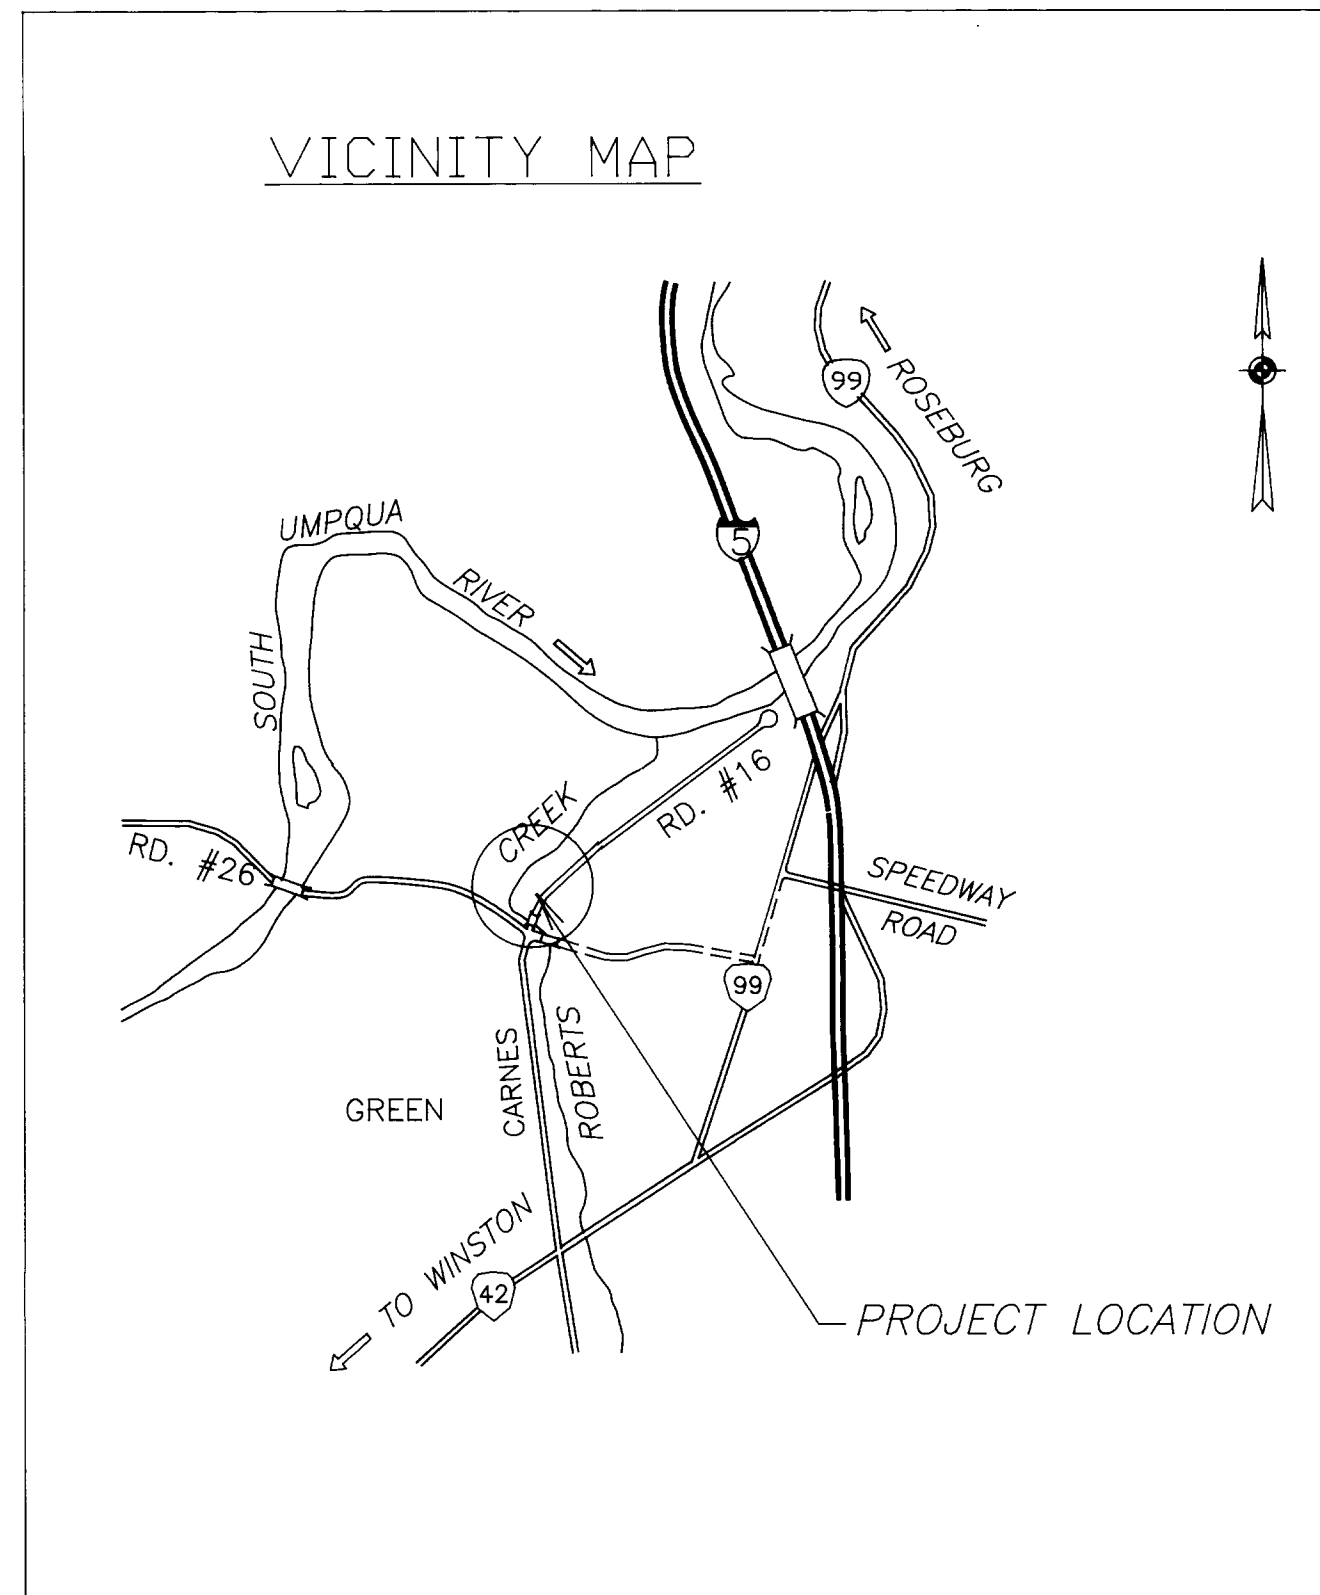


CREEK SIDE ESTATES

FILED
 Date: 9-11-1978 By: J.P.
 This survey consists of:
 Map: _____
 Narrative: _____
 Corner Ppt: _____
 DOUGLAS COUNTY
 SURVEYOR

PLANS PREPARED BY
 MAURICE E. FARR
 PROFESSIONAL ENGINEER
 ROSEBURG, OR 97470
 PH (541) 679-6598

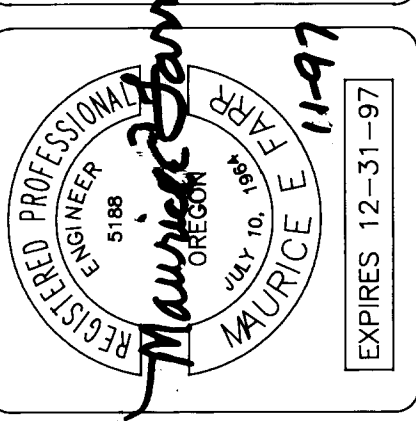

LEGAL - CBA SURVEY- M112 - 58
 T28 R06 S02 CB T.L. 604
 T.A. # 65112.14

PLANNING FILE # 95-299
 FLOOD PLAIN ELEV. - 478.00
 ZONING - R - 1
 COMP. PLAN - HIGH DENSITY - RESIDENTIAL
 SEWER - GREEN SANITARY DISTRICT
 WATER - ROBERTS CREEK WATER DISTRICT
 ELECTRIC - PACIFIC POWER
 TELEPHONE - U.S. WEST COMMUNICATIONS
 FIRE - DOUGLAS COUNTY FIRE DISTRICT #2
 CATV - JONES CABLE

AS-BUILT PLANS

SHEET INDEX

- 1 TITLE SHEET AND SHEET INDEX
- 2 STREET PLAN AND PROFILE AND STORM SEWER DETAILS
- 3 WATER MAIN PLAN AND DETAILS
- 4 SANITARY PLAN AND PROFILE AND DETAILS

CREEK SIDE ESTATES

R H CLEVELAND
 1449 NW MULHOLLAND
 ROSEBURG, OR 97470
 PH (541) 440-3046

TITLE SHEET

NOVEMBER 1997

SHEET

1 OF 4

RD402COV