


DATE	
BY	
REVISIONS	
NO.	
DESCRIPTION	
DATE	
BY	
REVISIONS	
NO.	
DESCRIPTION	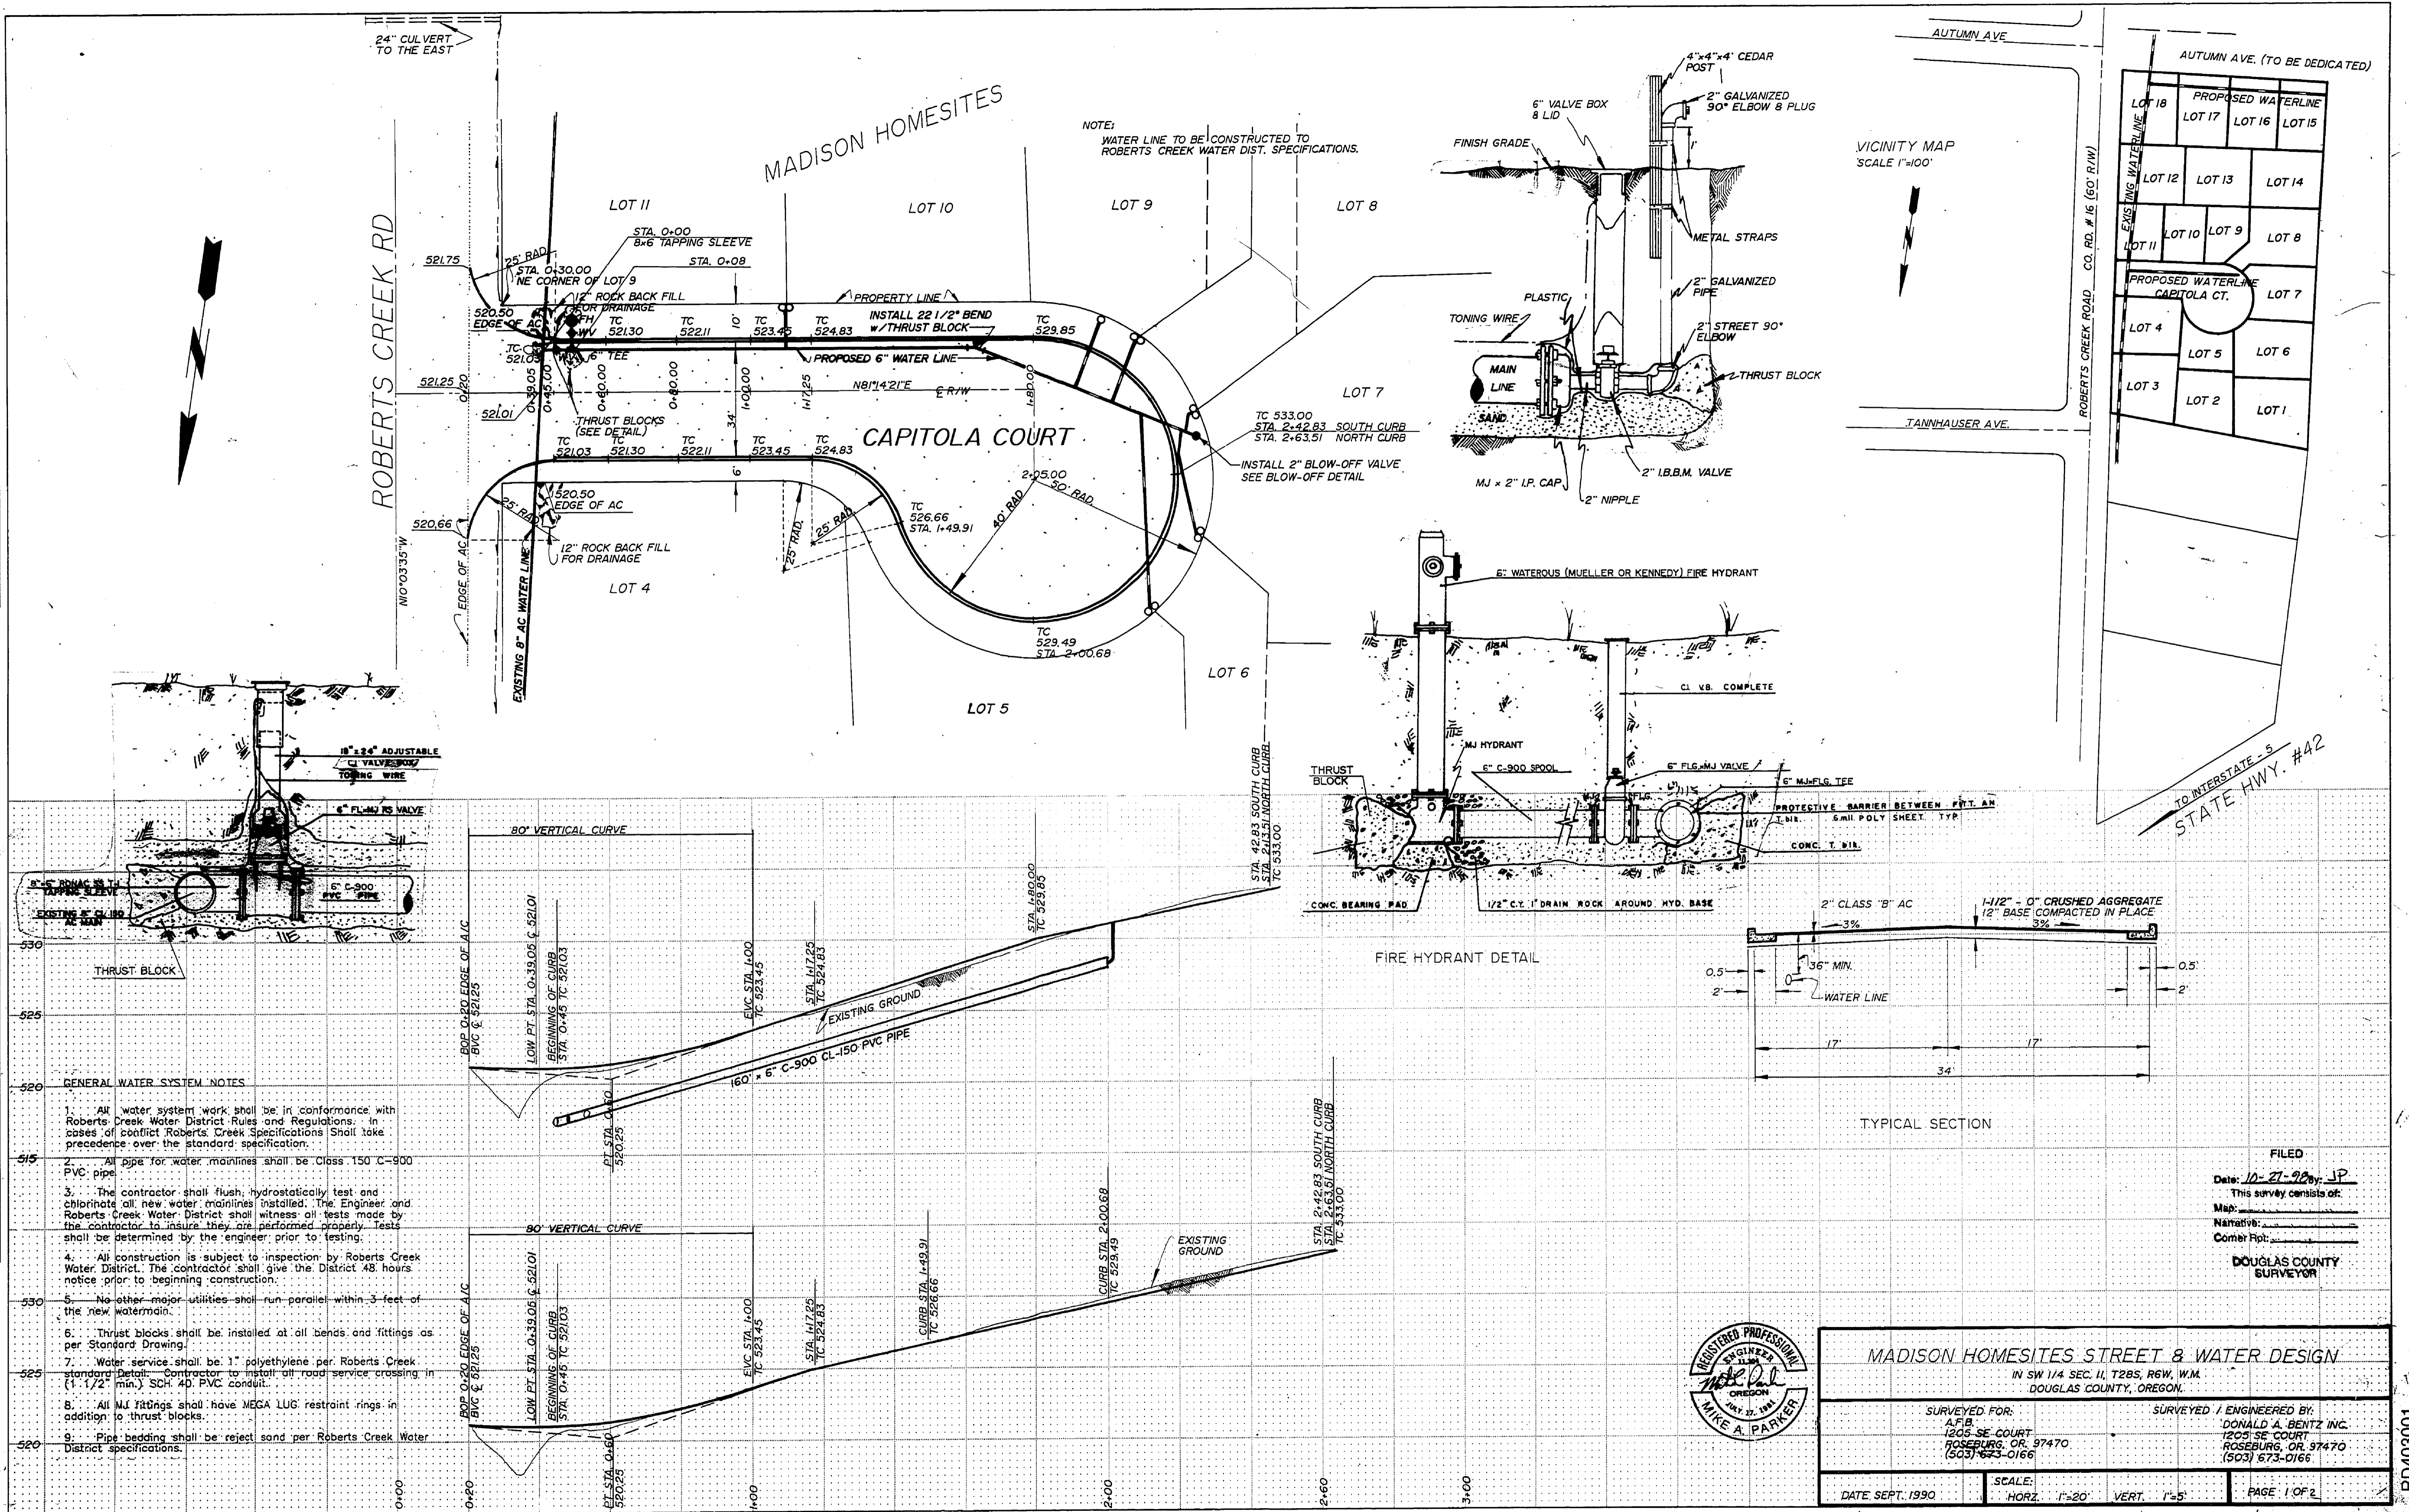
<b>MADISON HOMESITES STREET &amp; WATER DESIGN</b>	
IN SW 1/4 SEC. 11, T28S, R6W, W.M. DOUGLAS COUNTY, OREGON.	
SURVEYED FOR: A.F.B. 1205 SE COURT ROSEBURG, OR. 97470 (503) 673-0166	SURVEYED / ENGINEERED BY: DONALD A. BENTZ INC. 1205 SE COURT ROSEBURG, OR. 97470 (503) 673-0166
DATE SEPT. 1990	SCALE: HORZ. 1"=20' VERT. 1"=5'
PAGE 1 OF 2	

PLATE 4-SINGLE PLAN AND CROSS SECTION-FULL DOT  
PRINTED IN U.S.A.

REVISED WATERLINE 4-2-96  
AS-BUILTS 10/9/98

90-128

CO. RD. #403

RD403001