



FILED  
 Date: 3-3-2000 By: JP  
 This survey consists of:  
 Map: \_\_\_\_\_  
 Narrative: \_\_\_\_\_  
 Corner Rpt: \_\_\_\_\_  
 DOUGLAS COUNTY SURVEYOR

**DARK HORSE STREET PROFILE**

SCALE  
 HORIZONTAL 1" = 50'  
 VERTICAL 1" = 5'

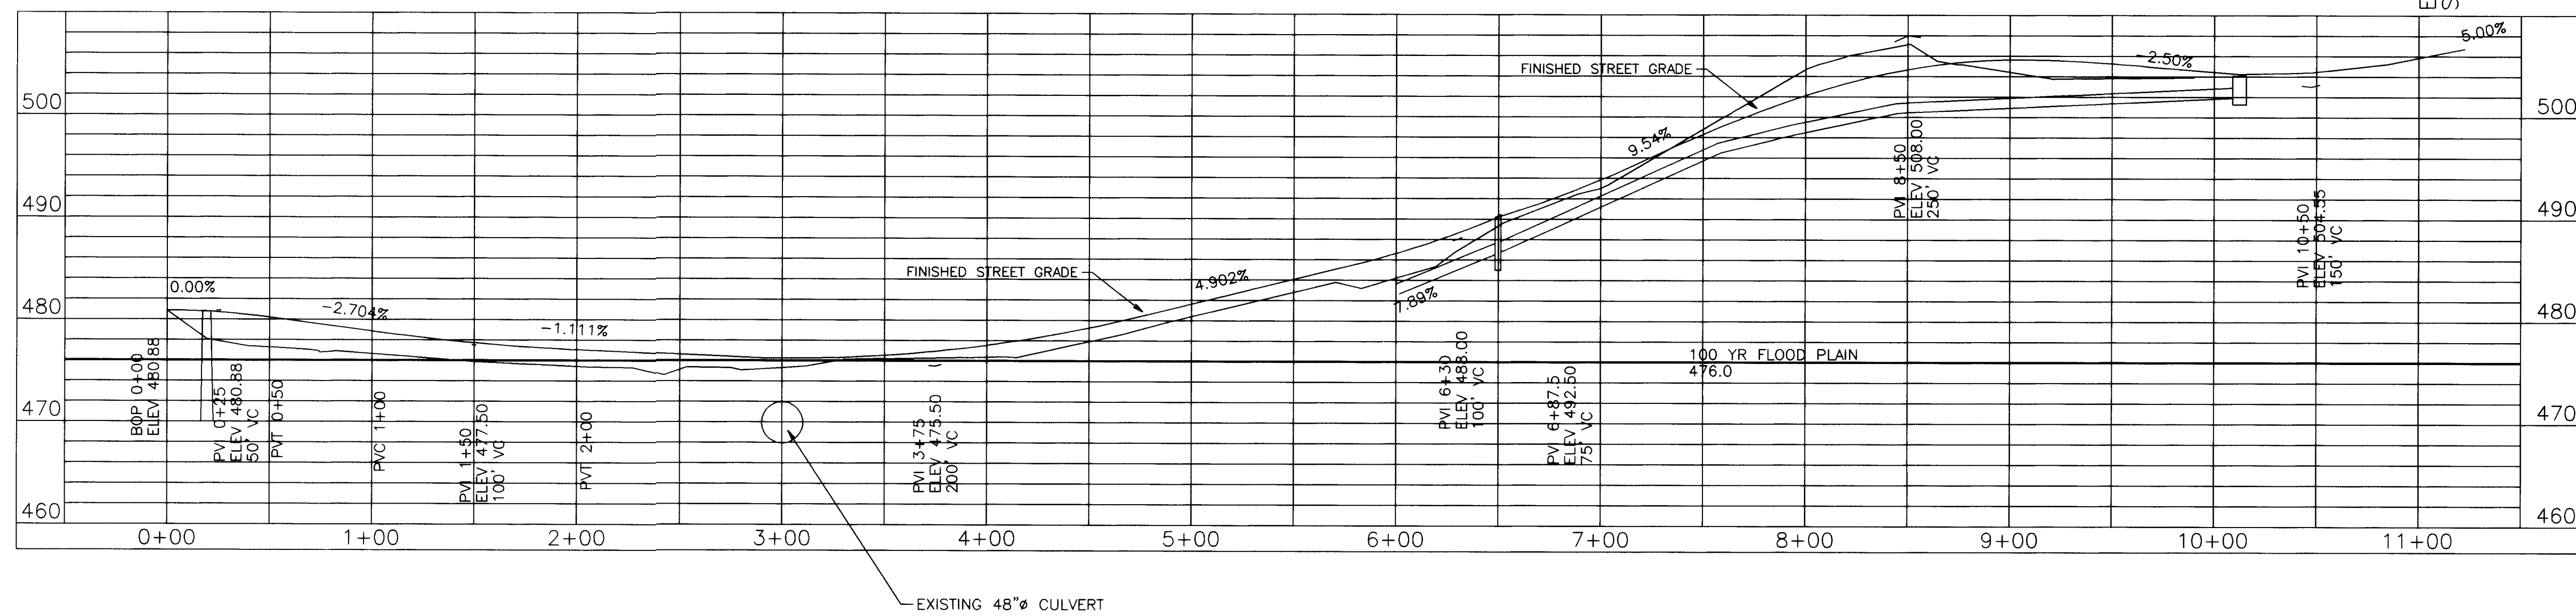

PLANS PREPARED BY  
 MAURICE E. FARR  
 PROFESSIONAL ENGINEER  
 395 NE KIRBY AVENUE  
 ROSEBURG, OR 97470  
 PH (541) 957-9442

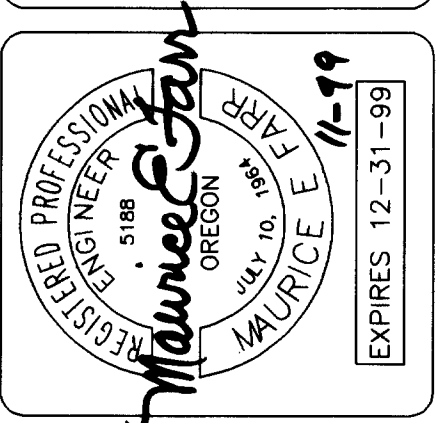

**KOOKEN ESTATES & 1ST ADDITION**  
 ROBERT KOOKEN  
 ROSEBURG, OR 97470  
 PH (541) 679-3477

AS-BUILT PLANS  
 STREET, WATER & SANITARY SEWER

**SHEET**  
**1 OF 1**

00000021