


AS-BUILT PLANS

SCALE 1" = 50'


CENTER LINE CURVE DATA
 $\Delta = 18^\circ 51' 58" L$
 $D = 28' 38' 52"$
 $R = 200'$
 $T = 33.23'$
 $L = 65.86'$

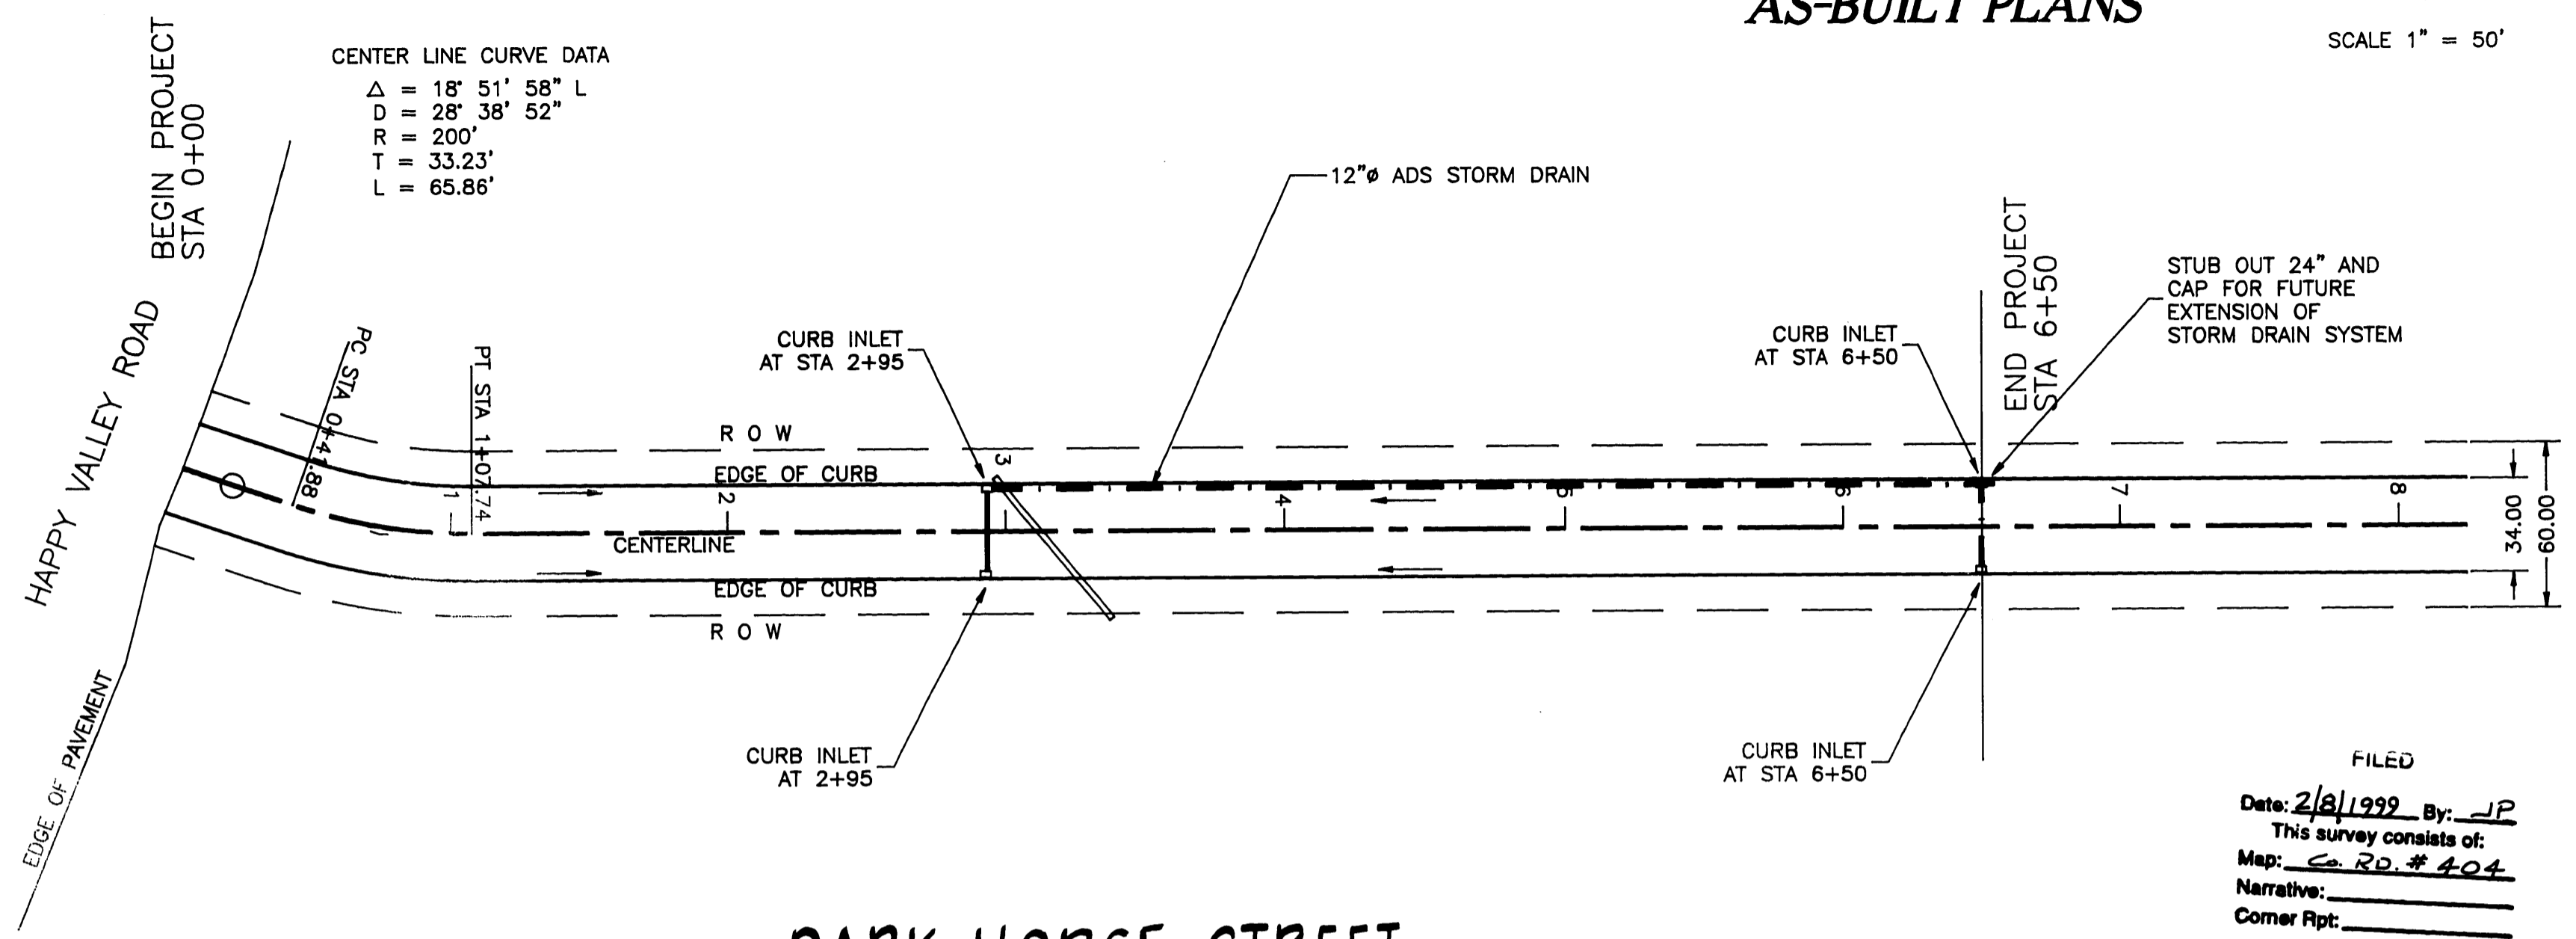


DARK HORSE STREET ~~KOOKEN DRIVE~~ PROFILE

FILED
 Date: 2/8/1999 By: JP
 This survey consists of:
 Map: Co. RD. # 404
 Narrative: _____
 Corner Rpt: _____
DOUGLAS COUNTY
SURVEYOR

SCALE
 HORIZONTAL 1" = 50'
 VERTICAL 1" = 5'

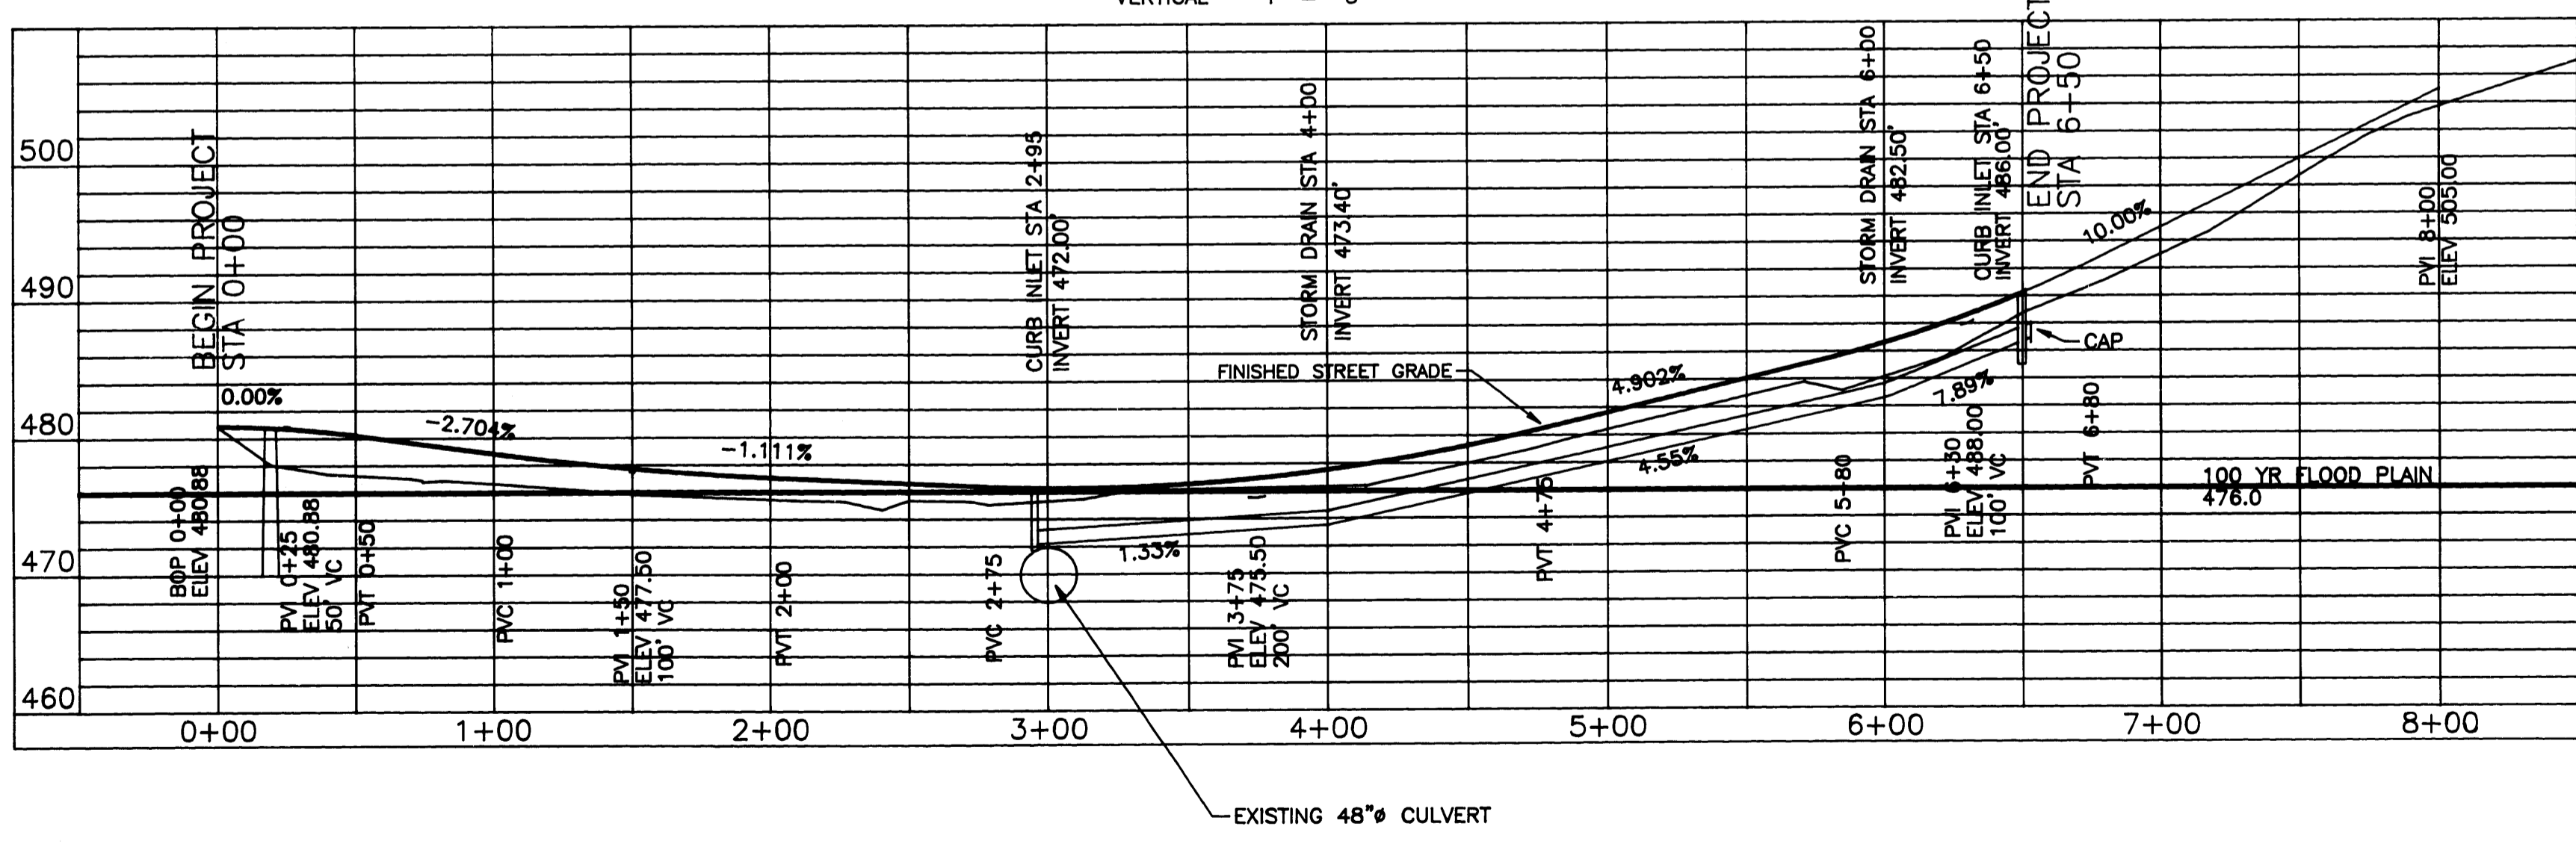

PLANS PREPARED BY
 MAURICE E FARR
 PROFESSIONAL ENGINEER
 395 NE KIRBY AVENUE
 ROSEBURG, OR 97470
 PH (541) 957-9442

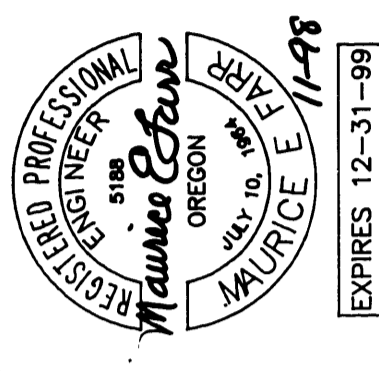

KOOKEN ESTATES
 ROBERT KOOKEN
 ROSEBURG, OR 97470
 PH (541) 679-3477

STREET PLAN
 AND PROFILE

NOVEMBER 1998

SHEET
 1 OF 2

m.p. 0.00 to 0.12

CO. RD. #404

RD404PLN