


NOTE: CLASS B BACKFILL TO BE USED ON ALL SEWERS SHOWN IN THIS PROFILE

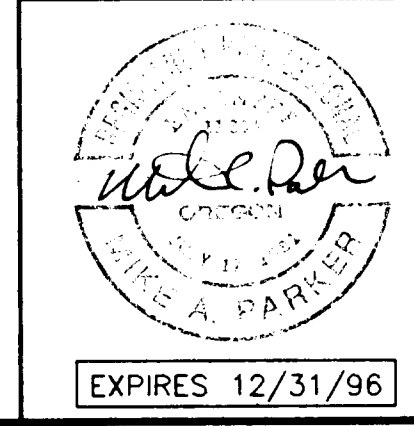

Rev.	Date	Dwg	Description
1	4/16/96	DAF	GREEN SANITARY DISTRICT REVIEW
2	4/16/96	DAF	DOUGLAS COUNTY REVIEW
3	4/25/96	DAF	ROBERTS CREEK WATER DIST. COMMENTS
4	5/8/96	DAF	DOUGLAS COUNTY COMMENTS
5	10/16/96	TAR	AS-BUILTS

i.e. ENGINEERING
 548 SE Jackson Street
 Roseburg, Oregon 97470
 PHONE (541) 673-0166
 FAX (541) 440-9392

Project Name: **QUAIL HOLLOW SUBDIVISION**

Title: **BOBWHITE STREET CENTERLINE PROFILE**

DES R/S PROJECT NO. 1155-01
 DWG DAF DATE: MARCH, 1996
 CHK CW SCALE: 1" = 30'
 APP MAP SHEET 3 OF 6