


FILED  
 Date: 5/10/2000 By: JP  
 This survey consists of:  
 Map:  
 Narrative:  
 Corner Rpt:  
 DOUGLAS COUNTY SURVEYOR

STRAW BALE SEDIMENT BARRIERS IN DITCHES OR SWALES

NOTES:  
 1. EMBED BALES 4 TO 6 INCHES  
 2. DRIVE STAKES MINIMUM 12" INTO GROUND SURFACE  
 3. DRIVE STAKES FLUSH TO TOP OF BALES

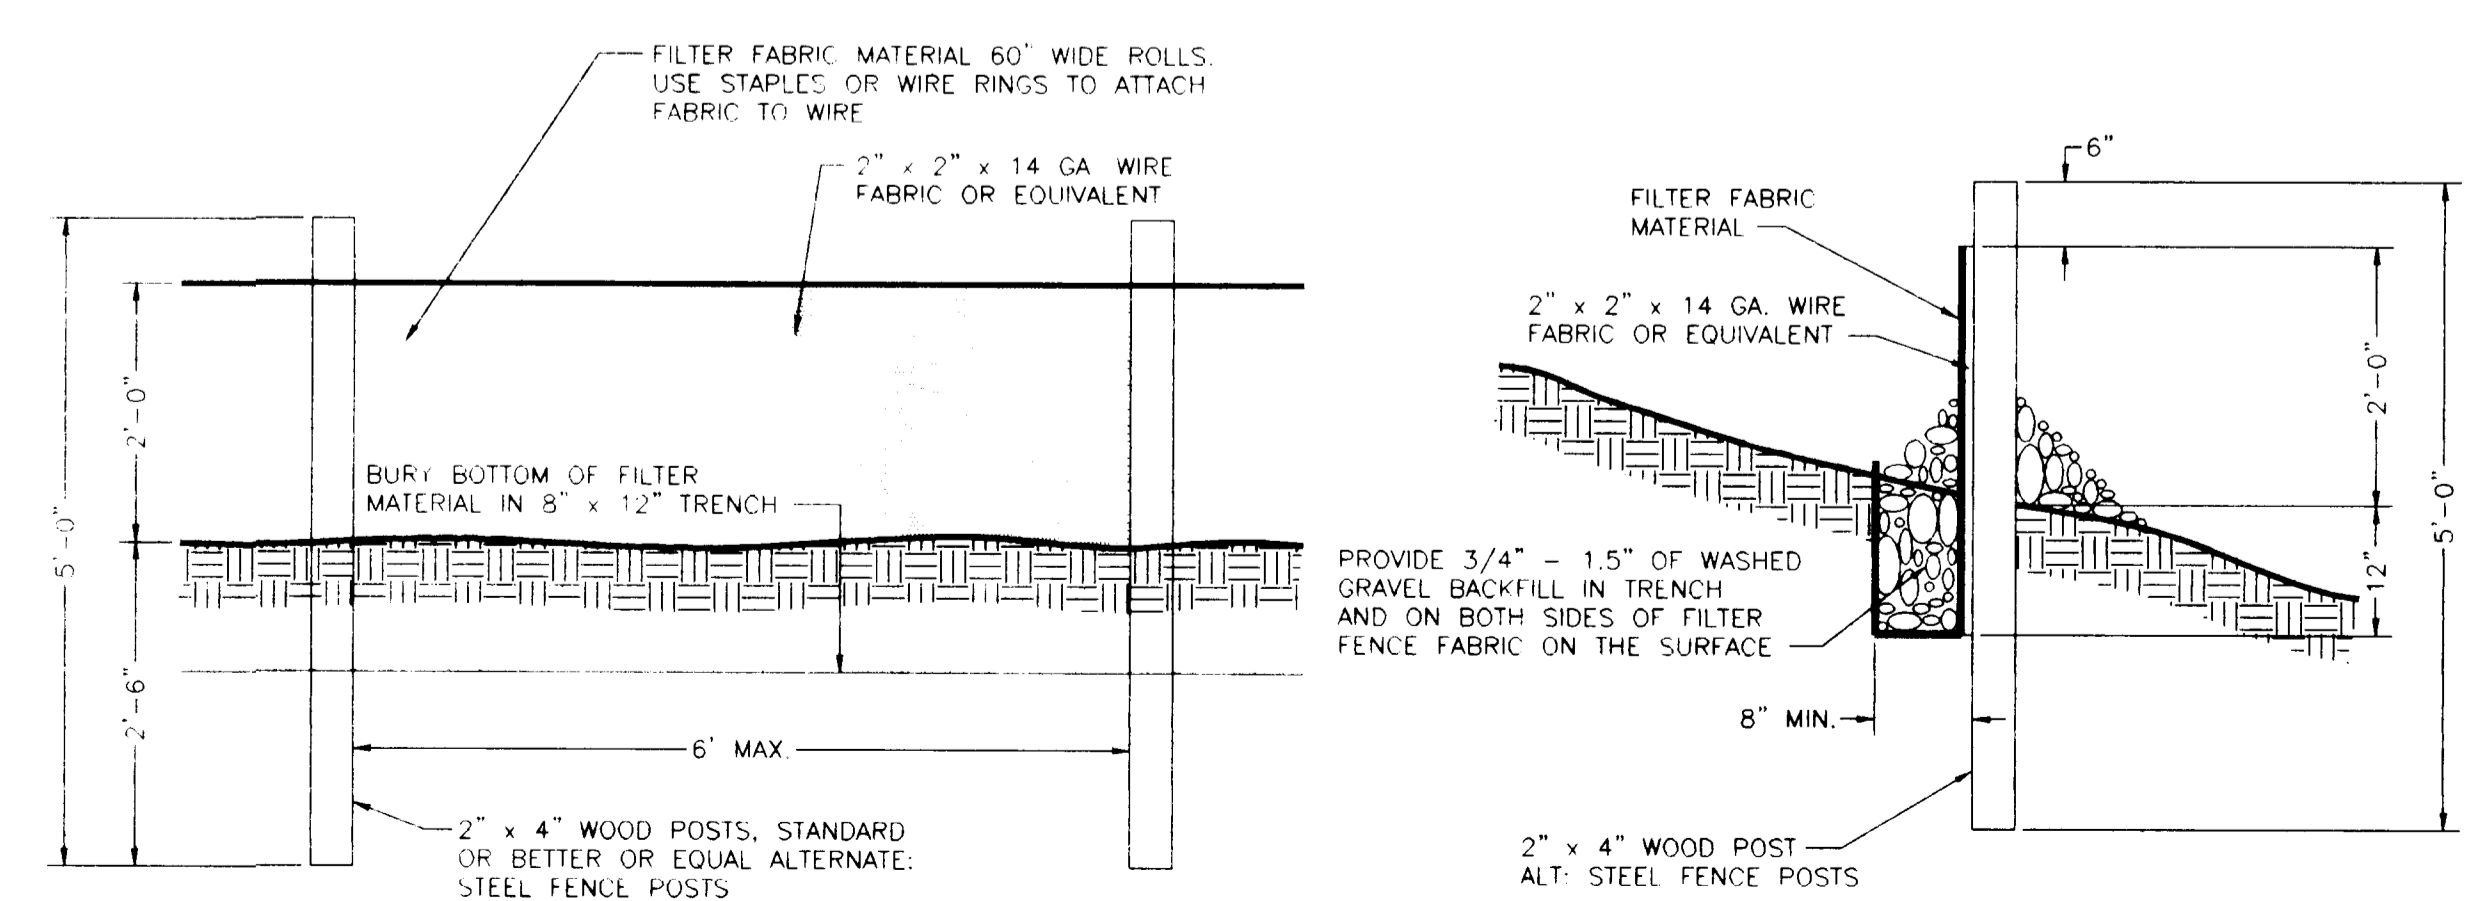

**i.e.**  
 ENGINEERING  
 548 SE Jackson Street  
 Roseburg, Oregon 97470  
 PHONE (541) 673-0166  
 FAX (541) 440-9392

Project Name: QUAIL HOLLOW SUBDIVISION

Title: EROSION CONTROL PLAN

DES	RJS	PROJECT NO.	1155-01
DAWG	DAF	DATE:	MARCH, 1996
CHK	CW	SCALE:	AS SHOWN
APP	MAP	SHEET	5 OF 6

Rev.	Date	Dwg	Description
△	4/16/96	DAF	GREEN SANITARY DISTRICT REVIEW
△	4/16/96	DAF	DOUGLAS COUNTY REVIEW
△	4/25/96	DAF	ROBERTS CREEK WATER DIST. COMMENTS
△	5/8/96	DAF	DOUGLAS COUNTY COMMENTS
△	10/16/98	TAR	AS-BUILTS

*W. L. F. Co.*  
 EXPIRES 12/31/96