

FILED
 Date: 6/27/2005 By: JP
 This survey consists of:
 Map:
 Narrative:
 Corner Rpt:
 DOUGLAS COUNTY SURVEYOR



DATE	BY	REVISIONS

ROSEWOOD ESTATES PHASE VI
 OVERALL SITE PLAN - AS BUILT
 LITTLE VALLEY RD.



3328 NE STEPHENS
 ROSELING, OR 97470
 PH: (541) 440-4871
 FX: (541) 672-0677

DESIGN BY: ICB

DRAWN BY: ICB
 DATE: 11-12-04

SURVEYED BY:
 DATE:

CHECKED BY:
 DATE:


SCALE:
 1"=40'

PROJECT NO.
 20626.6

SHEET NO.
 2 OF 8

RELEASED FOR FINAL RECORD DOCUMENTS
 DATE: _____ SIG: _____

CALL BEFORE YOU DIG !
 ONE CALL: (800) 332-2344
 OAR 952-001-0010 THROUGH
 OAR 952-001-0090

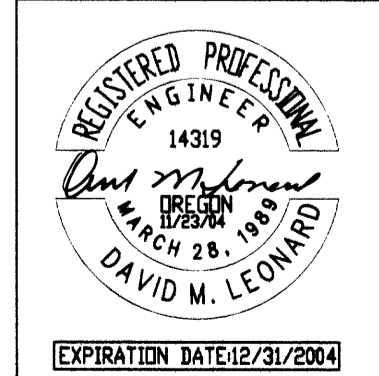

COPYRIGHT © 2004 PINNACLE ENGINEERING. ALL RIGHTS RESERVED. THIS DRAWING MAY BE UTILIZED ONLY FOR THE PURPOSE OF CONSTRUCTING OR INSTALLING THE WORK SHOWN HEREON AT THE SITE OR THE WORK SPECIFIED. ANY OTHER USE OF THIS DRAWING INCLUDING WITHOUT LIMITATION ANY REPRODUCTION OR ALTERING OF THIS DRAWING WITHOUT THE PRIOR WRITTEN APPROVAL OF PINNACLE ENGINEERING, INC. IS PROHIBITED.

Co.Rd. # 406, 406B, 406C M.P. 0.00 - 0.14 Co.Rd. # 406B

CO. RD. #406, 406B, 406C
 OVERALL SITE PLAN-AS BUILT

R406B014