


MAP Engineering, Inc.
 740 MAIN STREET
 ROSEBURG, OREGON 97470
 PHONE: (541) 229-0365 FAX: (541) 229-0363
 EMAIL: info@mapengineeringinc.com

PROJECT NAME: **ROSEWOOD ESTATES PHASE VIII
 LITTLE VALLEY RD. - AS BUILT**
 DRAWING TITLE: **CONSTRUCTION PLANS
 OVERALL SITE**
 PROJECT NO.: 2032-01 DWG SCALE: 1" = 40' DATE: 06-16-05 DESIGNER: JCB DRAFTER: JCB APPROVAL: MAP

| REVISION # | DATE | BY |
|------------|------|----|
| | | |
| | | |
| | | |

SHEET: 2 OF 9

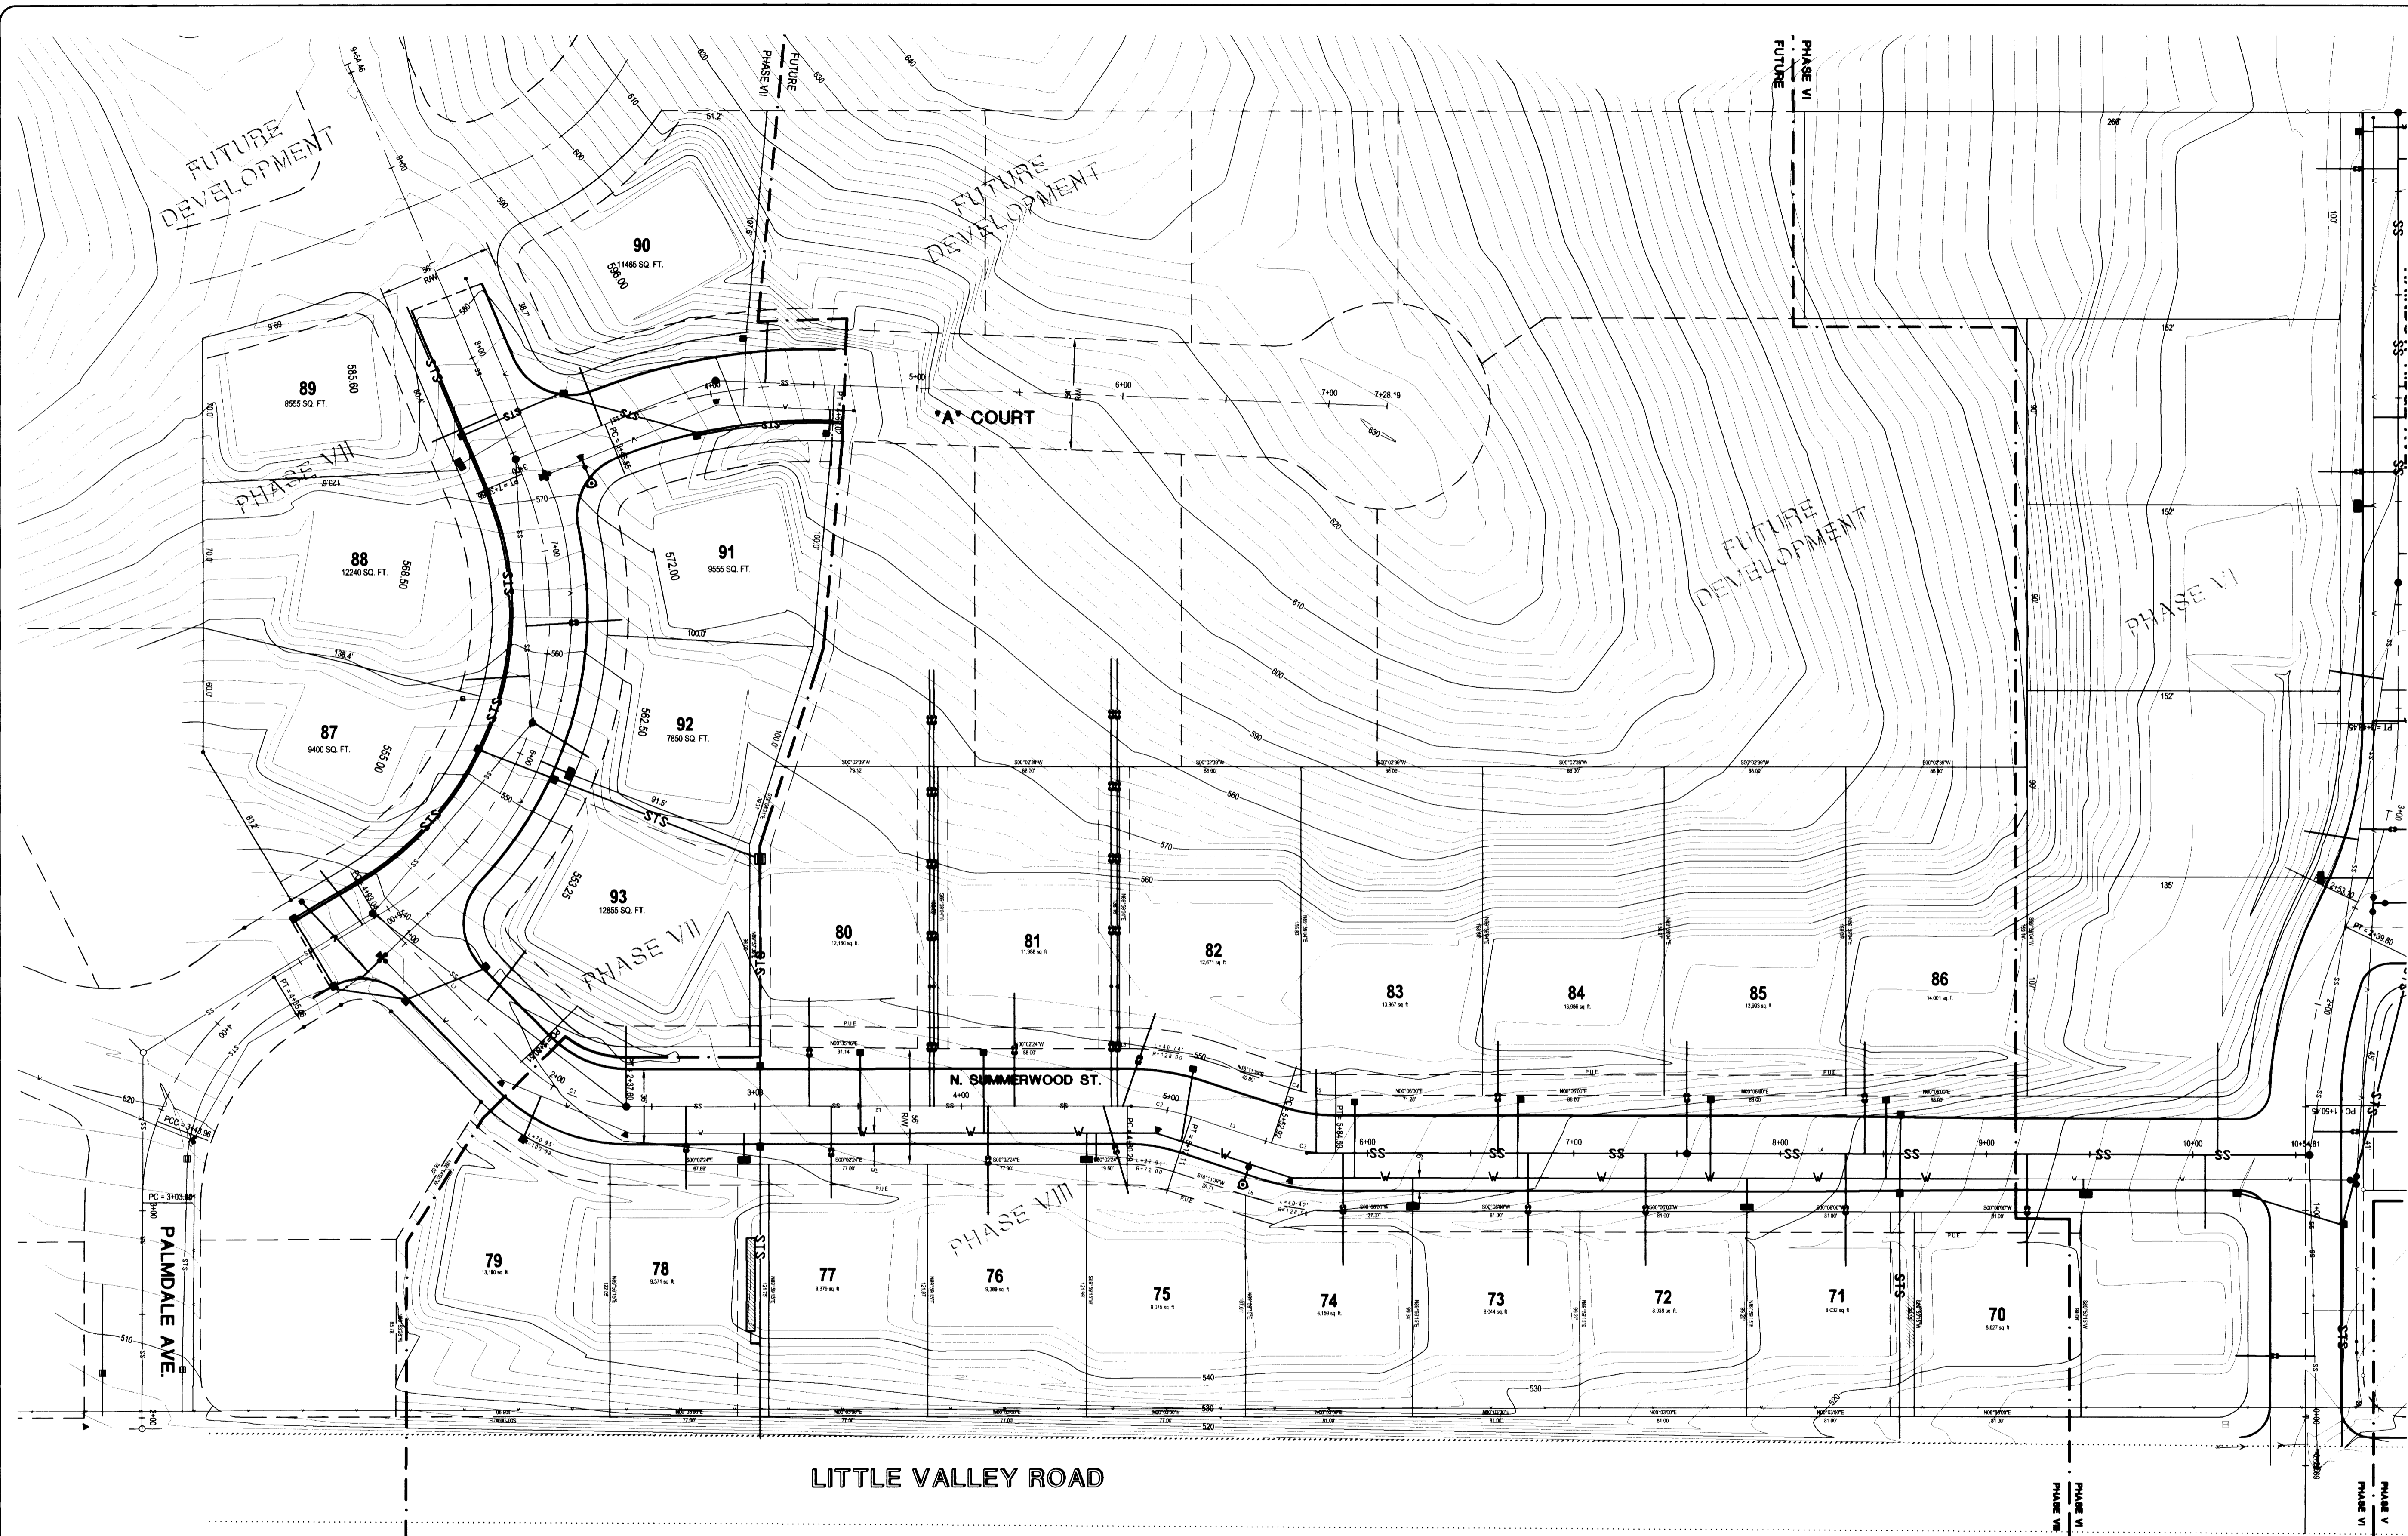


LINE TABLE

| LINE | LENGTH | BEARING |
|------|--------|-------------|
| L1 | 100.35 | N45°23'28"E |
| L2 | 241.28 | N00°02'24"W |
| L3 | 40.80 | N18°11'39"E |
| L4 | 470.32 | N00°06'00"E |
| L5 | 3.55 | N00°02'24"W |
| L6 | 4.09 | S18°11'39"W |

CURVE TABLE

| CURVE | LENGTH | RADIUS |
|-------|--------|--------|
| C1 | 57.09 | 72.00 |
| C2 | 31.82 | 100.00 |
| C3 | 31.58 | 100.00 |
| C4 | 5.86 | 72.00 |
| C5 | 16.87 | 72.00 |
| C6 | 9.33 | 100.00 |

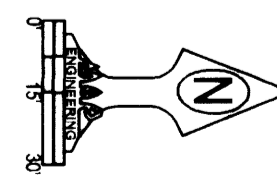

CALL BEFORE YOU DIG 1
 ONE CALL (800) 332-2344
 OAR 952-001-0010 THROUGH
 OAR 952-001-0090

Co. Rd. # 406 MP 0.20 - 0.38

CO RD #406

R406OVER