



FILED
 Date: 2-2-2000 By: JP
 This survey consists of:
 Map:
 Narrative:
 Corner Rpt:
 DOUGLAS COUNTY SURVEYOR
 LOT 8

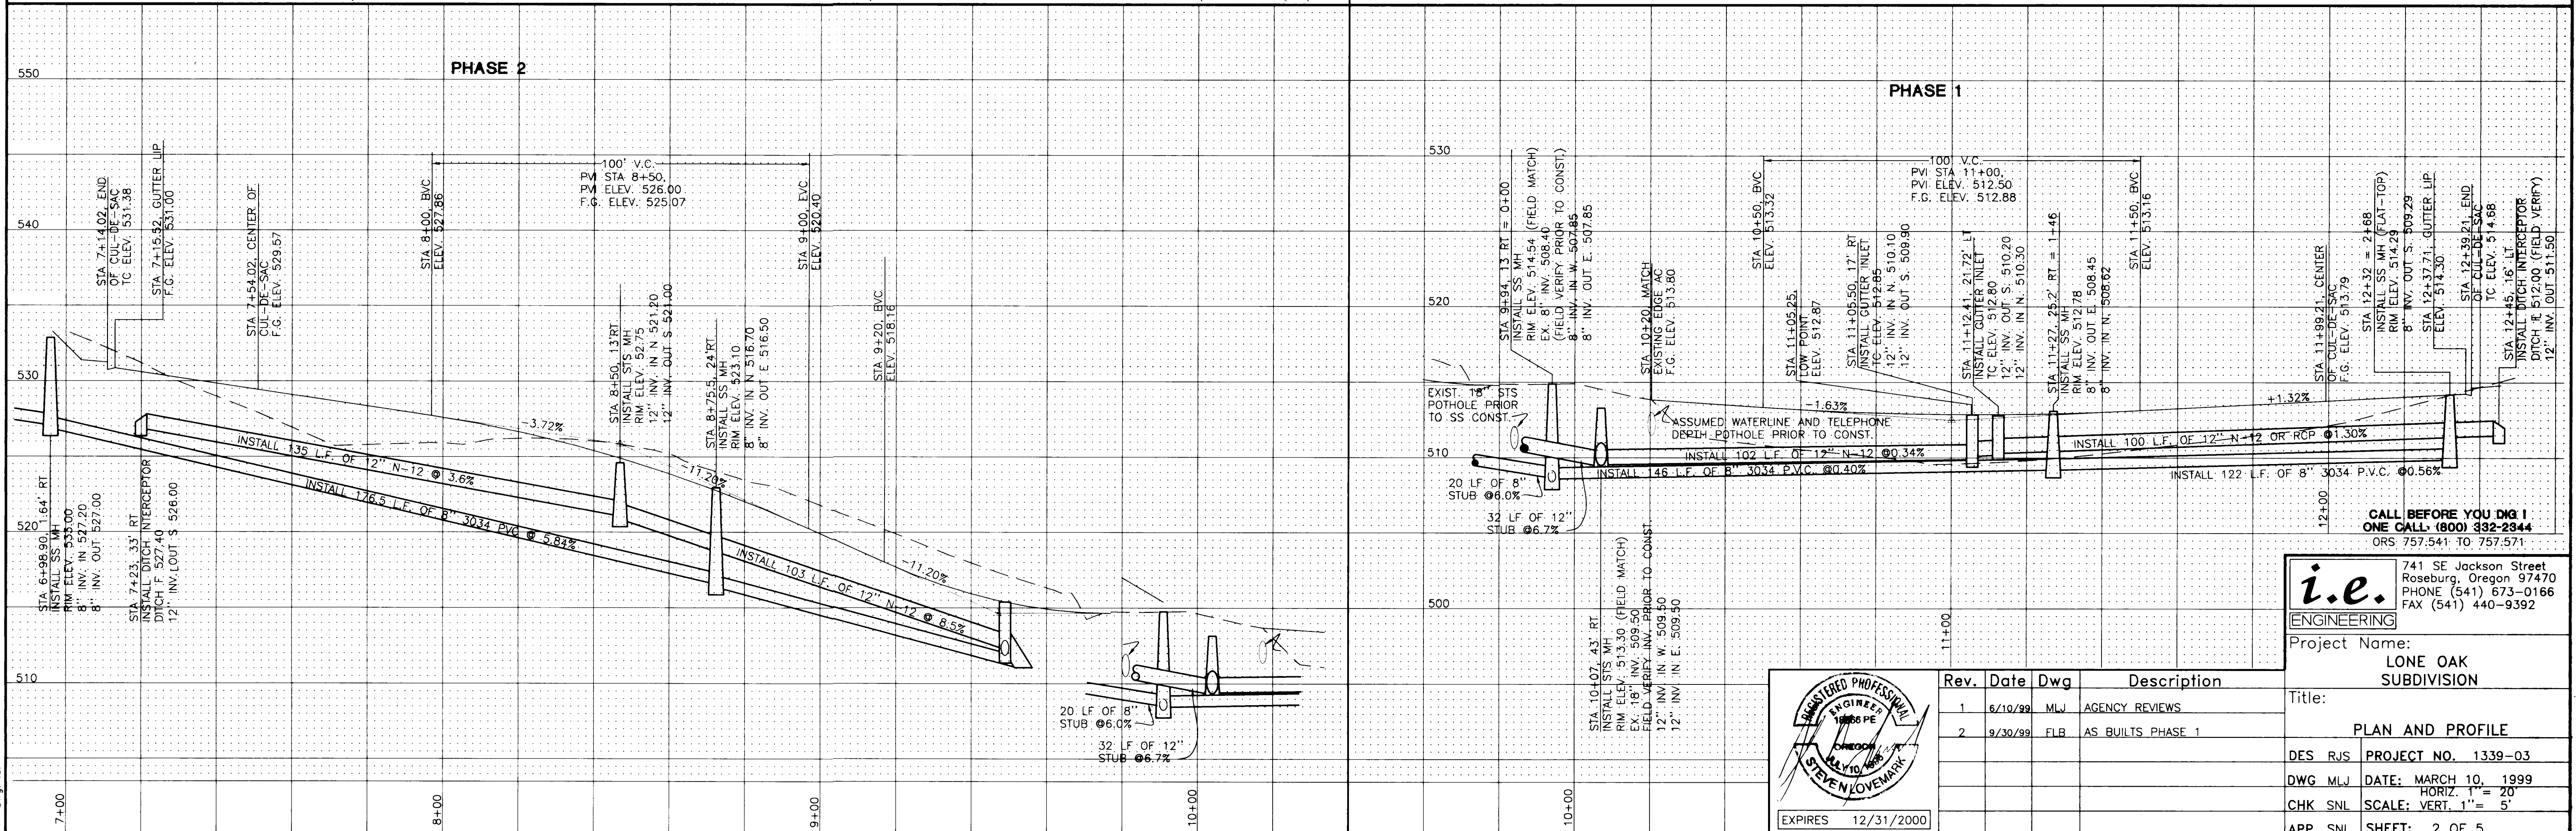

i.e.
 ENGINEERING
 Project Name:
 LONE OAK
 SUBDIVISION

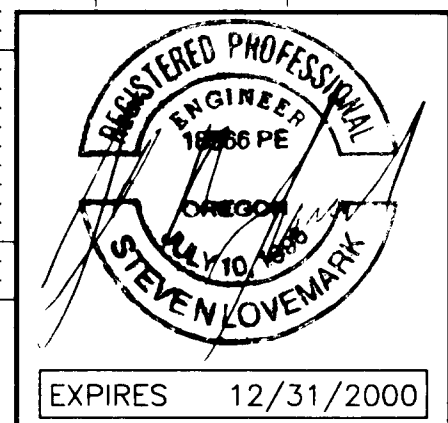

Rev.	Date	Dwg	Description
1	6/10/99	MLJ	AGENCY REVIEWS
2	9/30/99	FLB	AS BUILTS PHASE 1

CALL BEFORE YOU DIG!
 ONE CALL: (800) 332-2344
 ORS 757.541.T0.757.571

741 SE Jackson Street
 Roseburg, Oregon 97470
 PHONE (541) 673-0166
 FAX (541) 440-9392

DES RJS PROJECT NO. 1339-03
 DWG MLJ DATE: MARCH 10, 1999
 CHK SNL HORIZ. 1" = 20'
 APP SNL SCALE: VERT. 1" = 5'

SHEET: 2 OF 5