
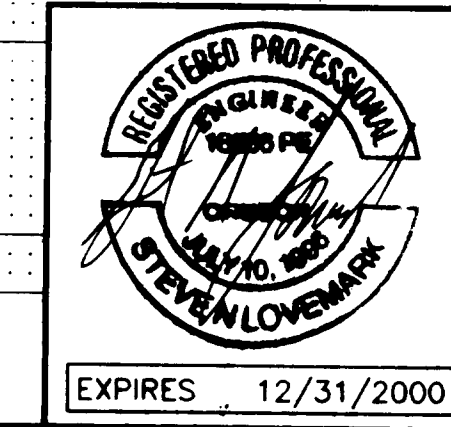


FILED
 Date: 1-6-2000 By: JP
 This survey consists of:
 Map:
 Narrative:
 Corner Ppt:
 DOUGLAS COUNTY
 SURVEYOR

CALL BEFORE YOU DIG!
 ONE CALL (800) 332-2344
 ORS 757.541 TO 757.571

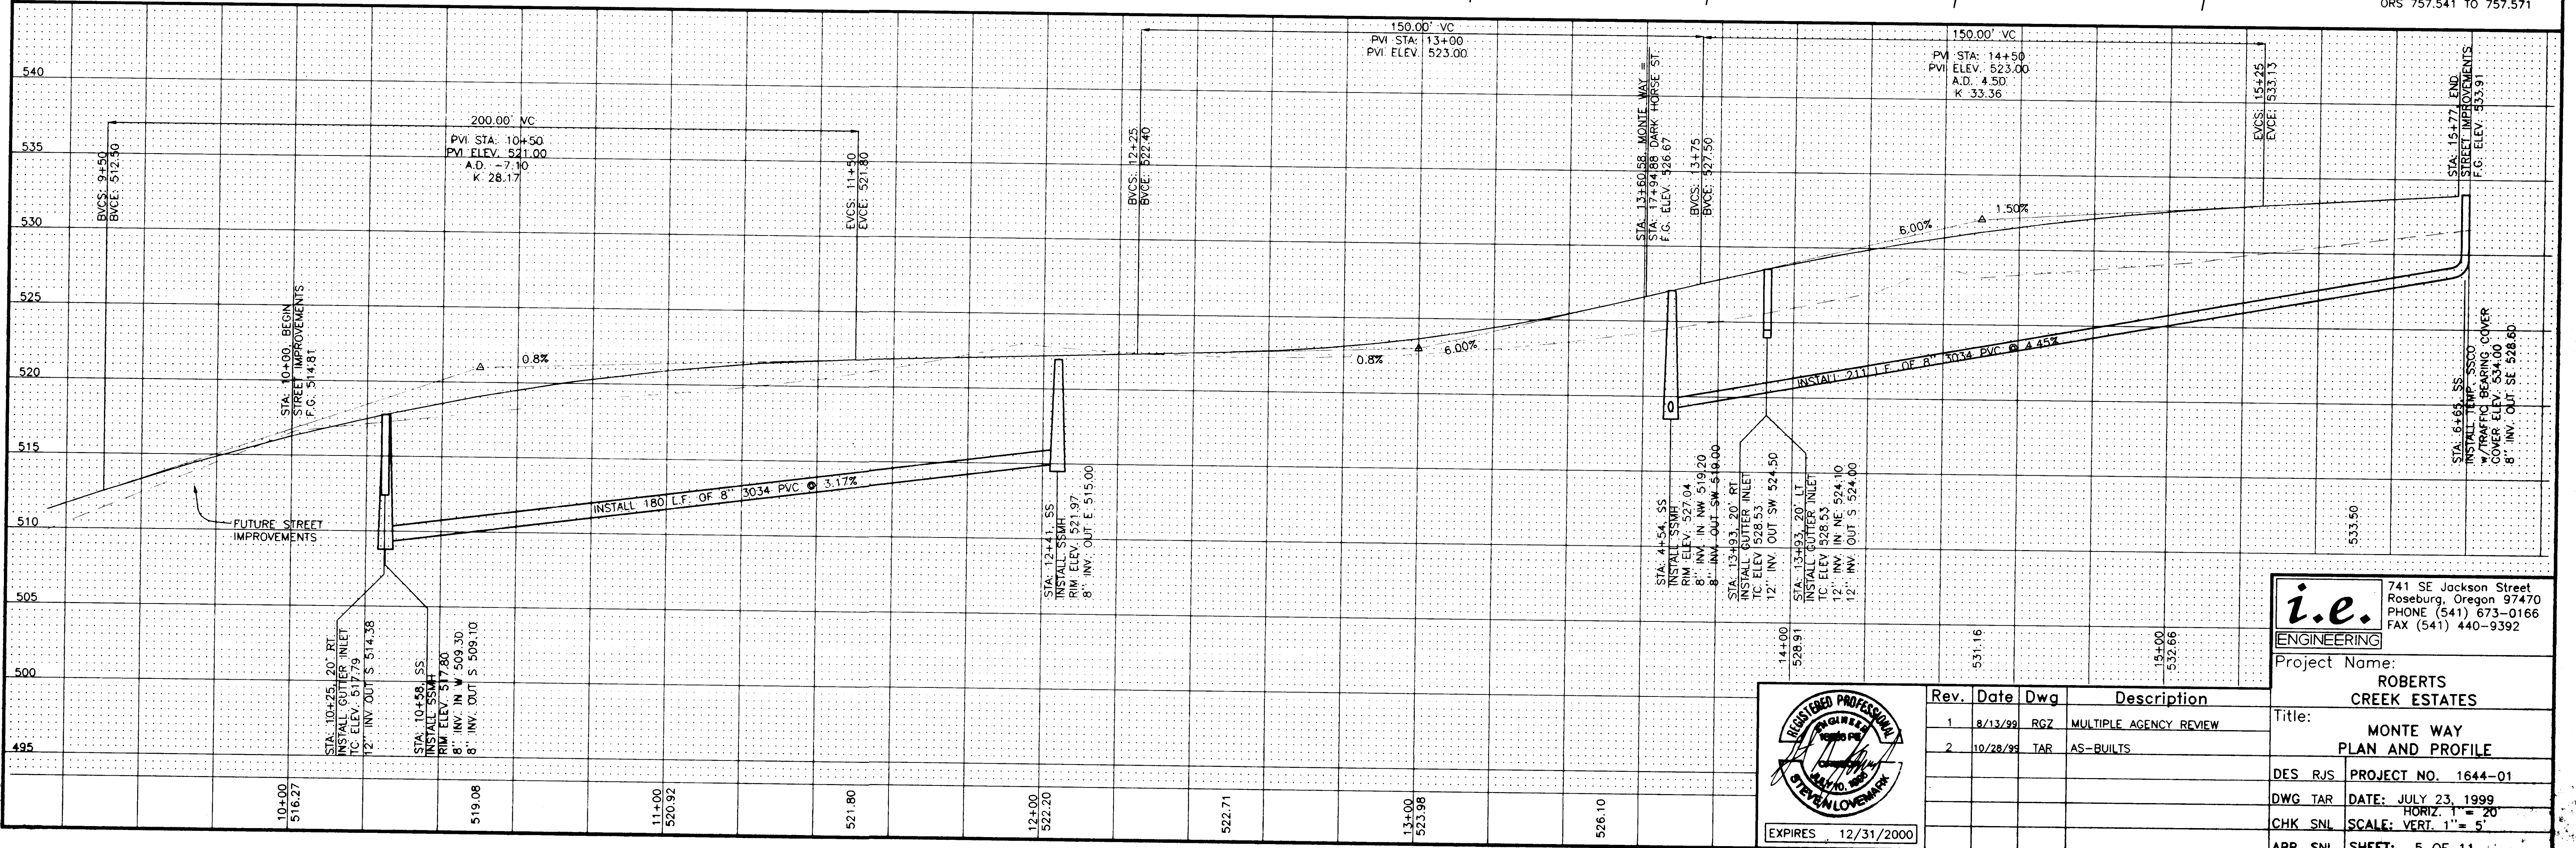

Rev.	Date	Dwg	Description
1	8/13/99	RGZ	MULTIPLE AGENCY REVIEW
2	10/28/99	TAR	AS-BUILTS

i.e.
 ENGINEERING
 741 SE Jackson Street
 Roseburg, Oregon 97470
 PHONE (541) 673-0166
 FAX (541) 440-9392

Project Name:
**ROBERTS
 CREEK ESTATES**

Title:
**MONTE WAY
 PLAN AND PROFILE**

DES RJS PROJECT NO. 1644-01
 DWG TAR DATE: JULY 23, 1999
 CHK SNL HORIZ. 1" = 20'
 APP SNL SCALE: VERT. 1" = 5'
 SHEET: 5 OF 11