
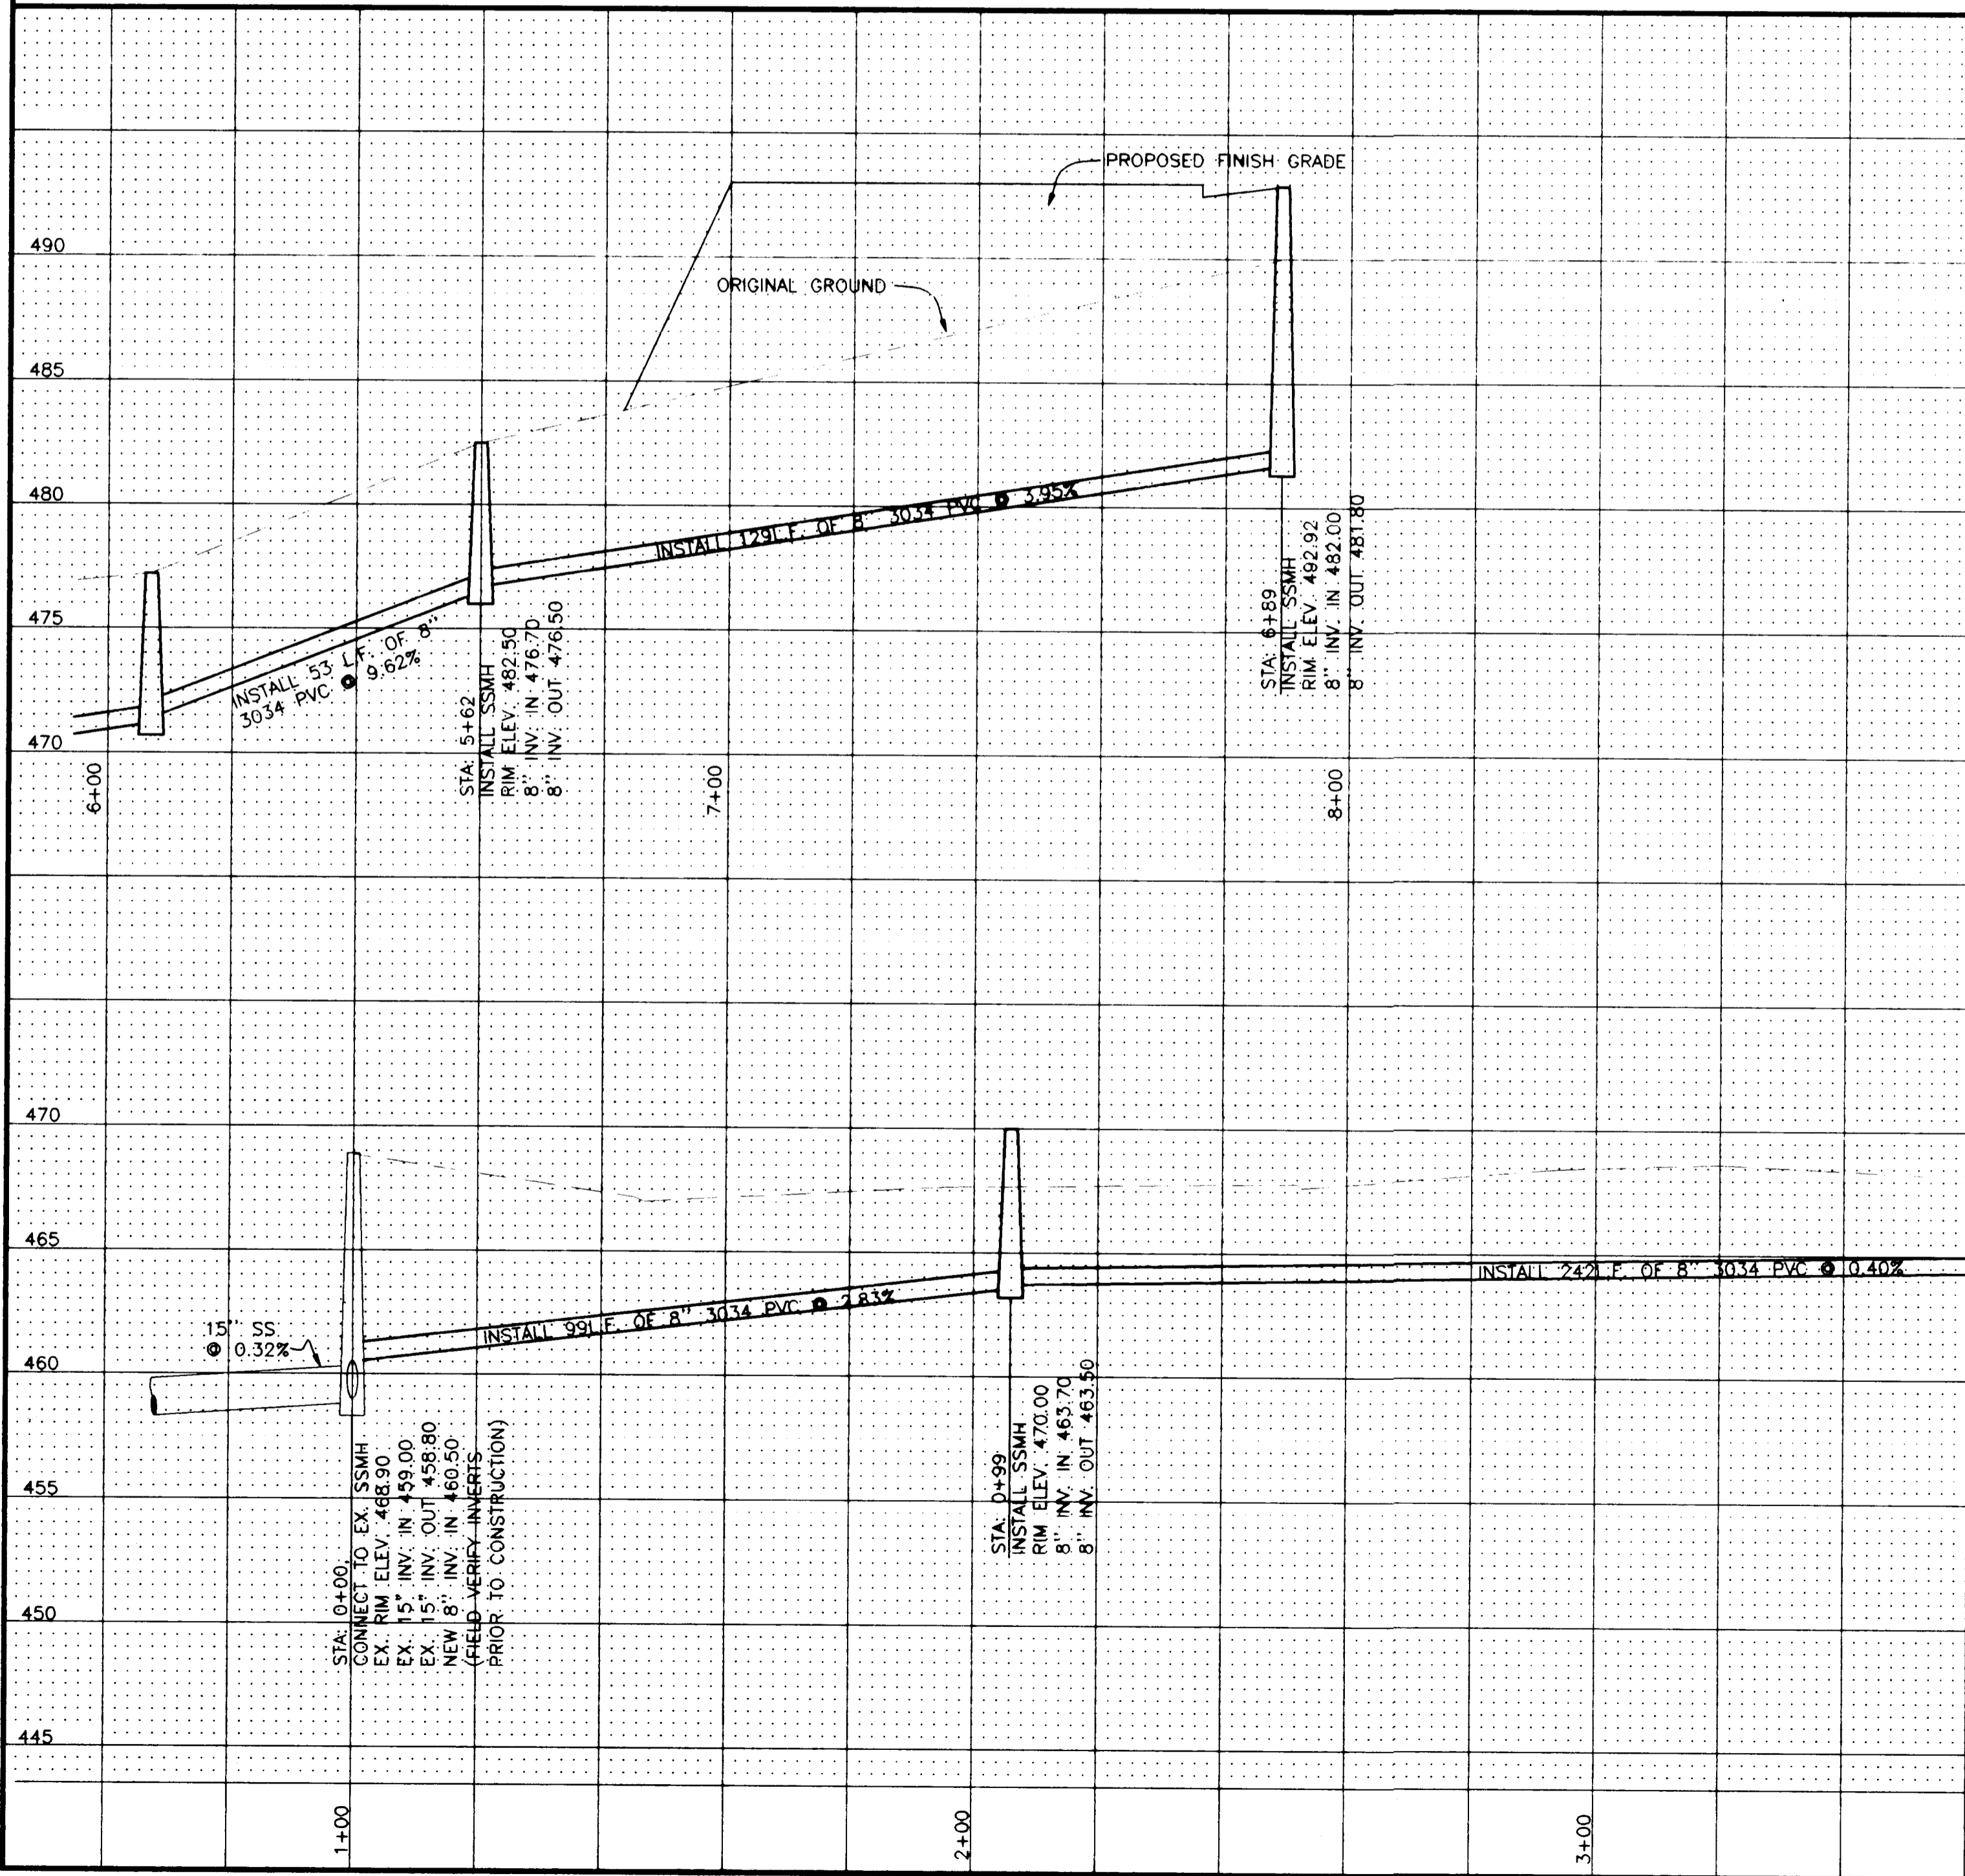


FILED
 Date: 1-6-2000 By: J.P.
 This survey consists of:
 Map:
 Narrative:
 Corner Ppt:
 DOUGLAS COUNTY
 SURVEYOR

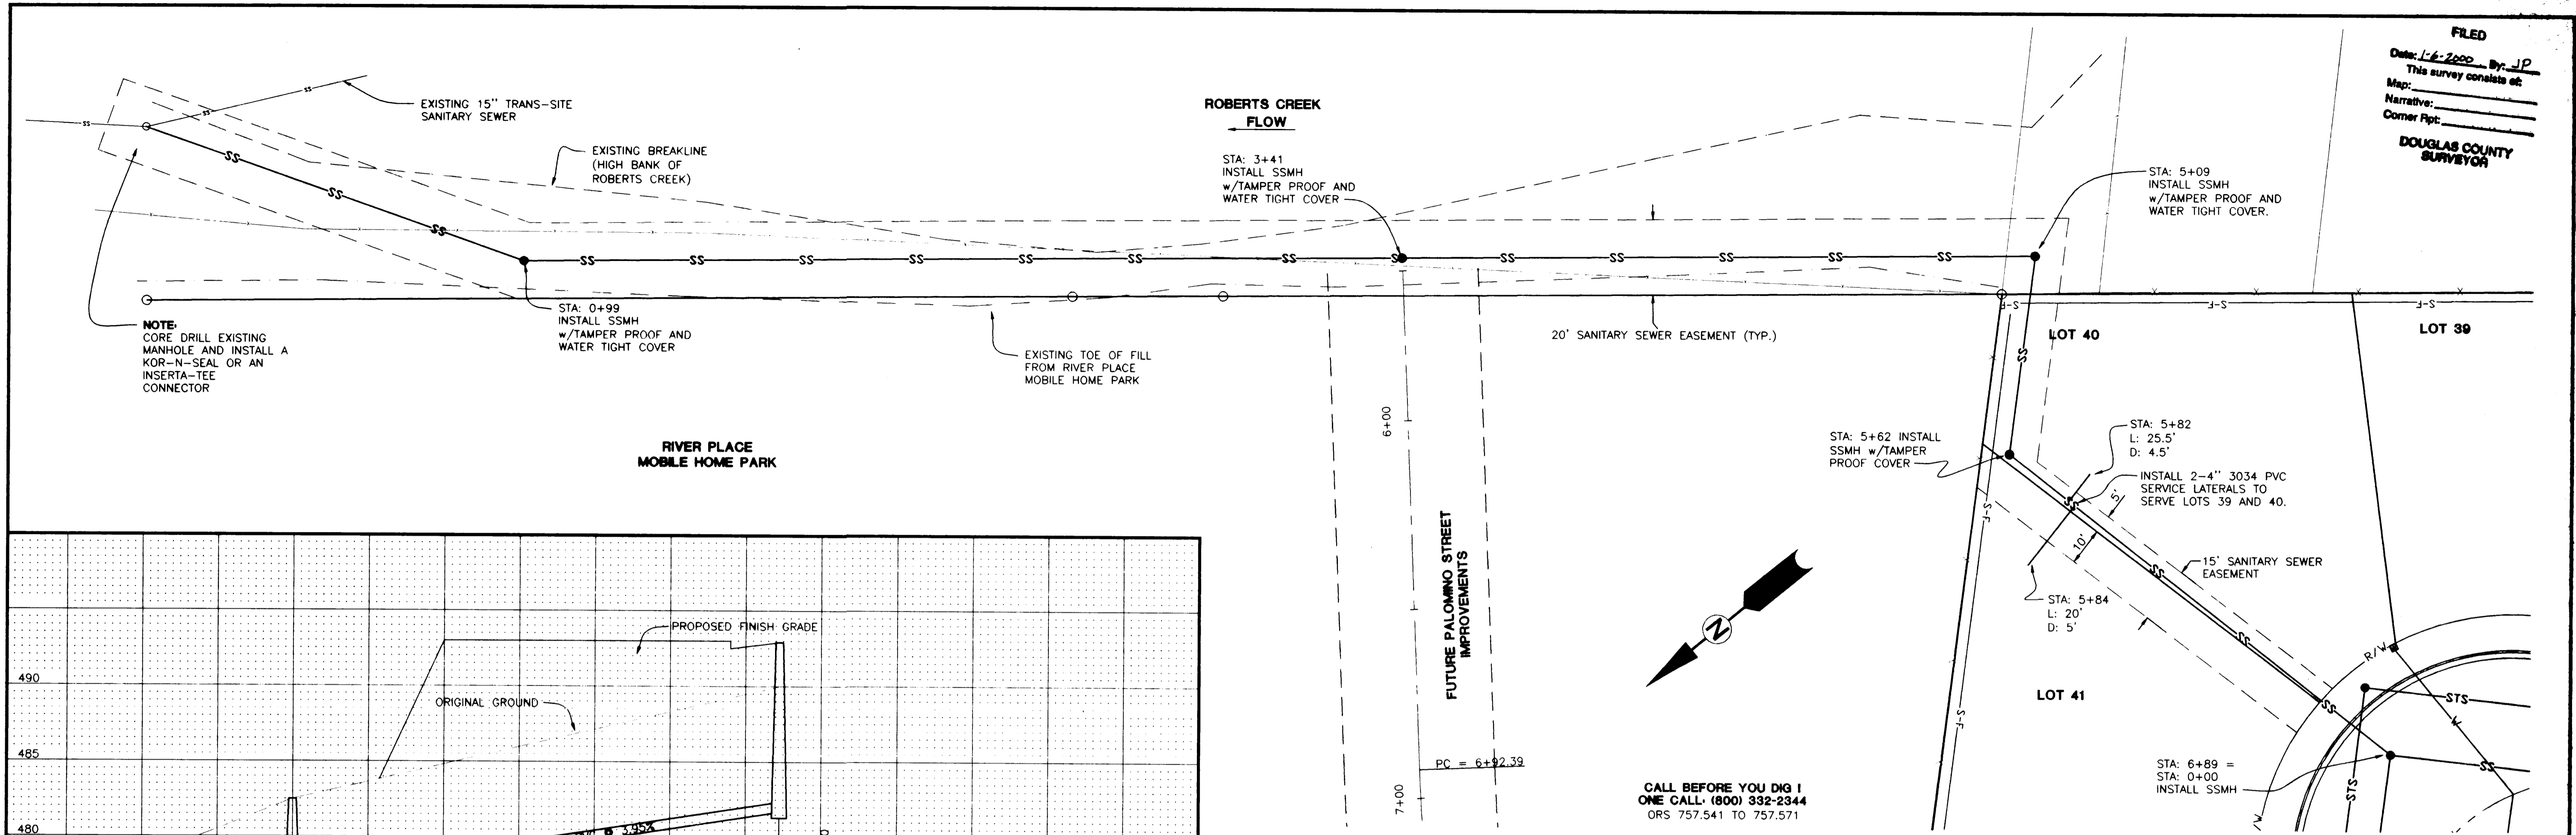

i.e. ENGINEERING
 741 SE Jackson Street
 Roseburg, Oregon 97470
 PHONE (541) 673-0166
 FAX (541) 440-9392

Project Name: ROBERTS CREEK ESTATES


Title: OFFSITE SANITARY SEWER PLAN AND PROFILE

DES RJS PROJECT NO. 1644-01

DWG RAT DATE: JULY 23, 1999

CHK SNL SCALE: VERT. 1" = 5'

APP SNL SHEET: 6 OF 11

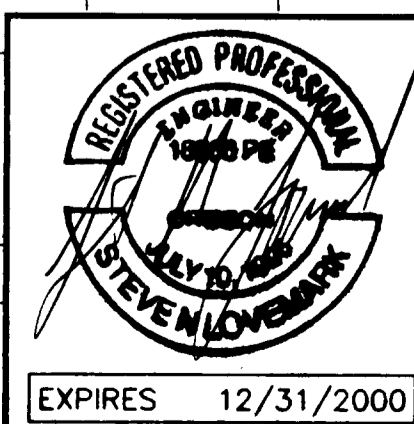

Rev.	Date	Dwg	Description
1	8/13/99	RGZ	MULTIPLE AGENCY REVIEW
2	10/28/99	TAR	AS-BUILTS

CO. RD. # 404A SEWER

404ASEWR

DO NOT DUPLICATE