



S.E.1/4 of S.E.1/4 SEC. 3, T. 28 S., R. 6 W., W.M.

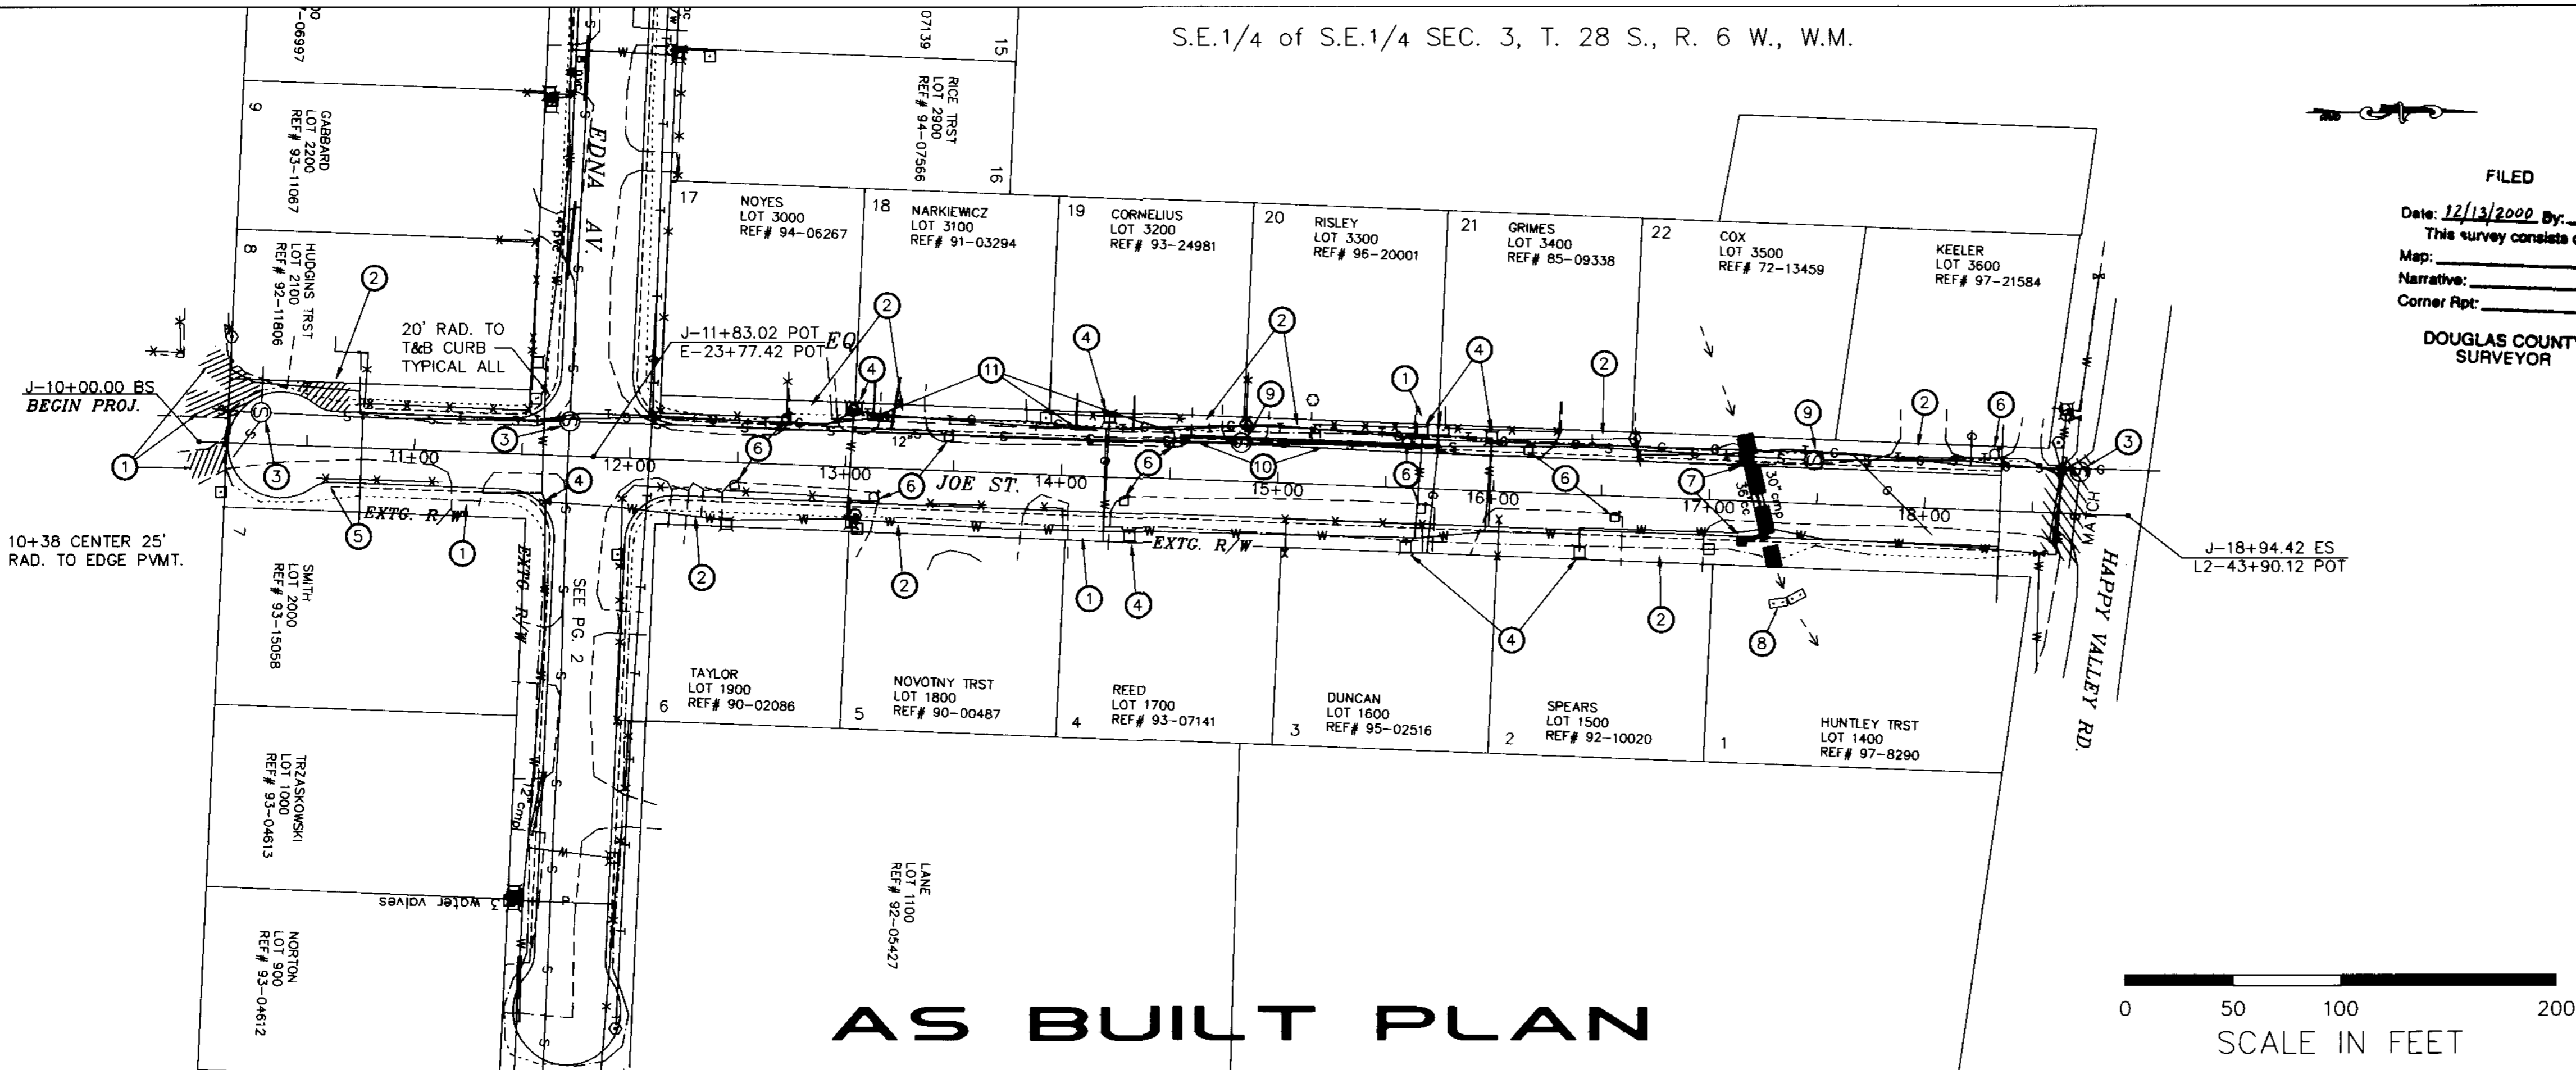

AS BUILT PLAN

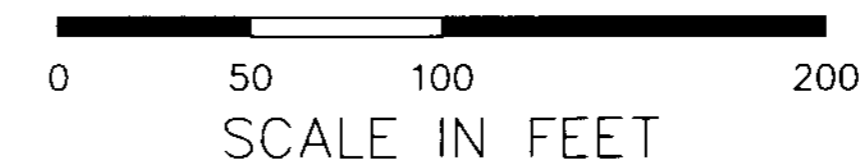


FILED
 Date: 12/13/2000 By: JP
 This survey consists of:
 Map: _____
 Narrative: _____
 Corner Rpt: _____
DOUGLAS COUNTY SURVEYOR

NOTES

- ① CONSTRUCT SINGLE DRIVEWAY, PAVE TO R/W LINE IN CURB SECTIONS
- ② CONSTRUCT DOUBLE DRIVEWAY, PAVE TO R/W LINE IN CURB SECTIONS
- ③ ADJUST MANHOLES
- ④ ADJUST BOXES
- ⑤ CONSTRUCT TYPE A CURBS J-10+75 TO 18+35 LT & 10+62 TO 18+35 RT SEE DWG. RD700
- ⑥ INSTALL SINGLE MAILBOX SUPPORT W/ CONCRETE COLLAR SEE DWG. RD100
- ⑦ REMOVE EXTG. CULVERTS; INSTALL 2 35" X 24" ARCH PIPES SLOPE ENDS TO CONFORM TO BANK, CONSTRUCT 2 TYPE CG-3 INLETS & CONNECT TO ARCH PIPES W/ 12" TAPPING SADDLES SEE DWG. RD342, VERIFY LENGTHS & LOCATIONS FROM FIELD STAKING
- ⑧ INSTALL STRAW BALE SEDIMENT BARRIERS
- ⑨ RECONSTRUCT MANHOLES W/ OFFSET CONES, SEE DWG. RD327 14+83 TOWARDS C/L; 17+50 AWAY FROM C/L
- ⑩ 14+25 BEGIN DEFLECTING CURB LINE TO 19.5' @ STA 14+82, RETURN TO STANDARD WIDTH (18.5) BY STA 15+50
- ⑪ INSTALL 180' OF SCHEDULE 80 PVC DRAIN PIPE AND CONNECT THRU CURB FACE MAKE 4 ROOF DRAIN CONNECTIONS

GENERAL NOTES
 REMOVE ALL EXISTING DRIVEWAY CULVERTS. CONSTRUCT DRIVEWAY CURB CUTS AT LOCATIONS AND WIDTHS AS DIRECTED. INSTALL WEEP HOLES IN CURB AT LOCATIONS PERPENDICULAR TO EXTG. ROOF DRAINS & AT ADDITIONAL LOCATIONS AS DIRECTED

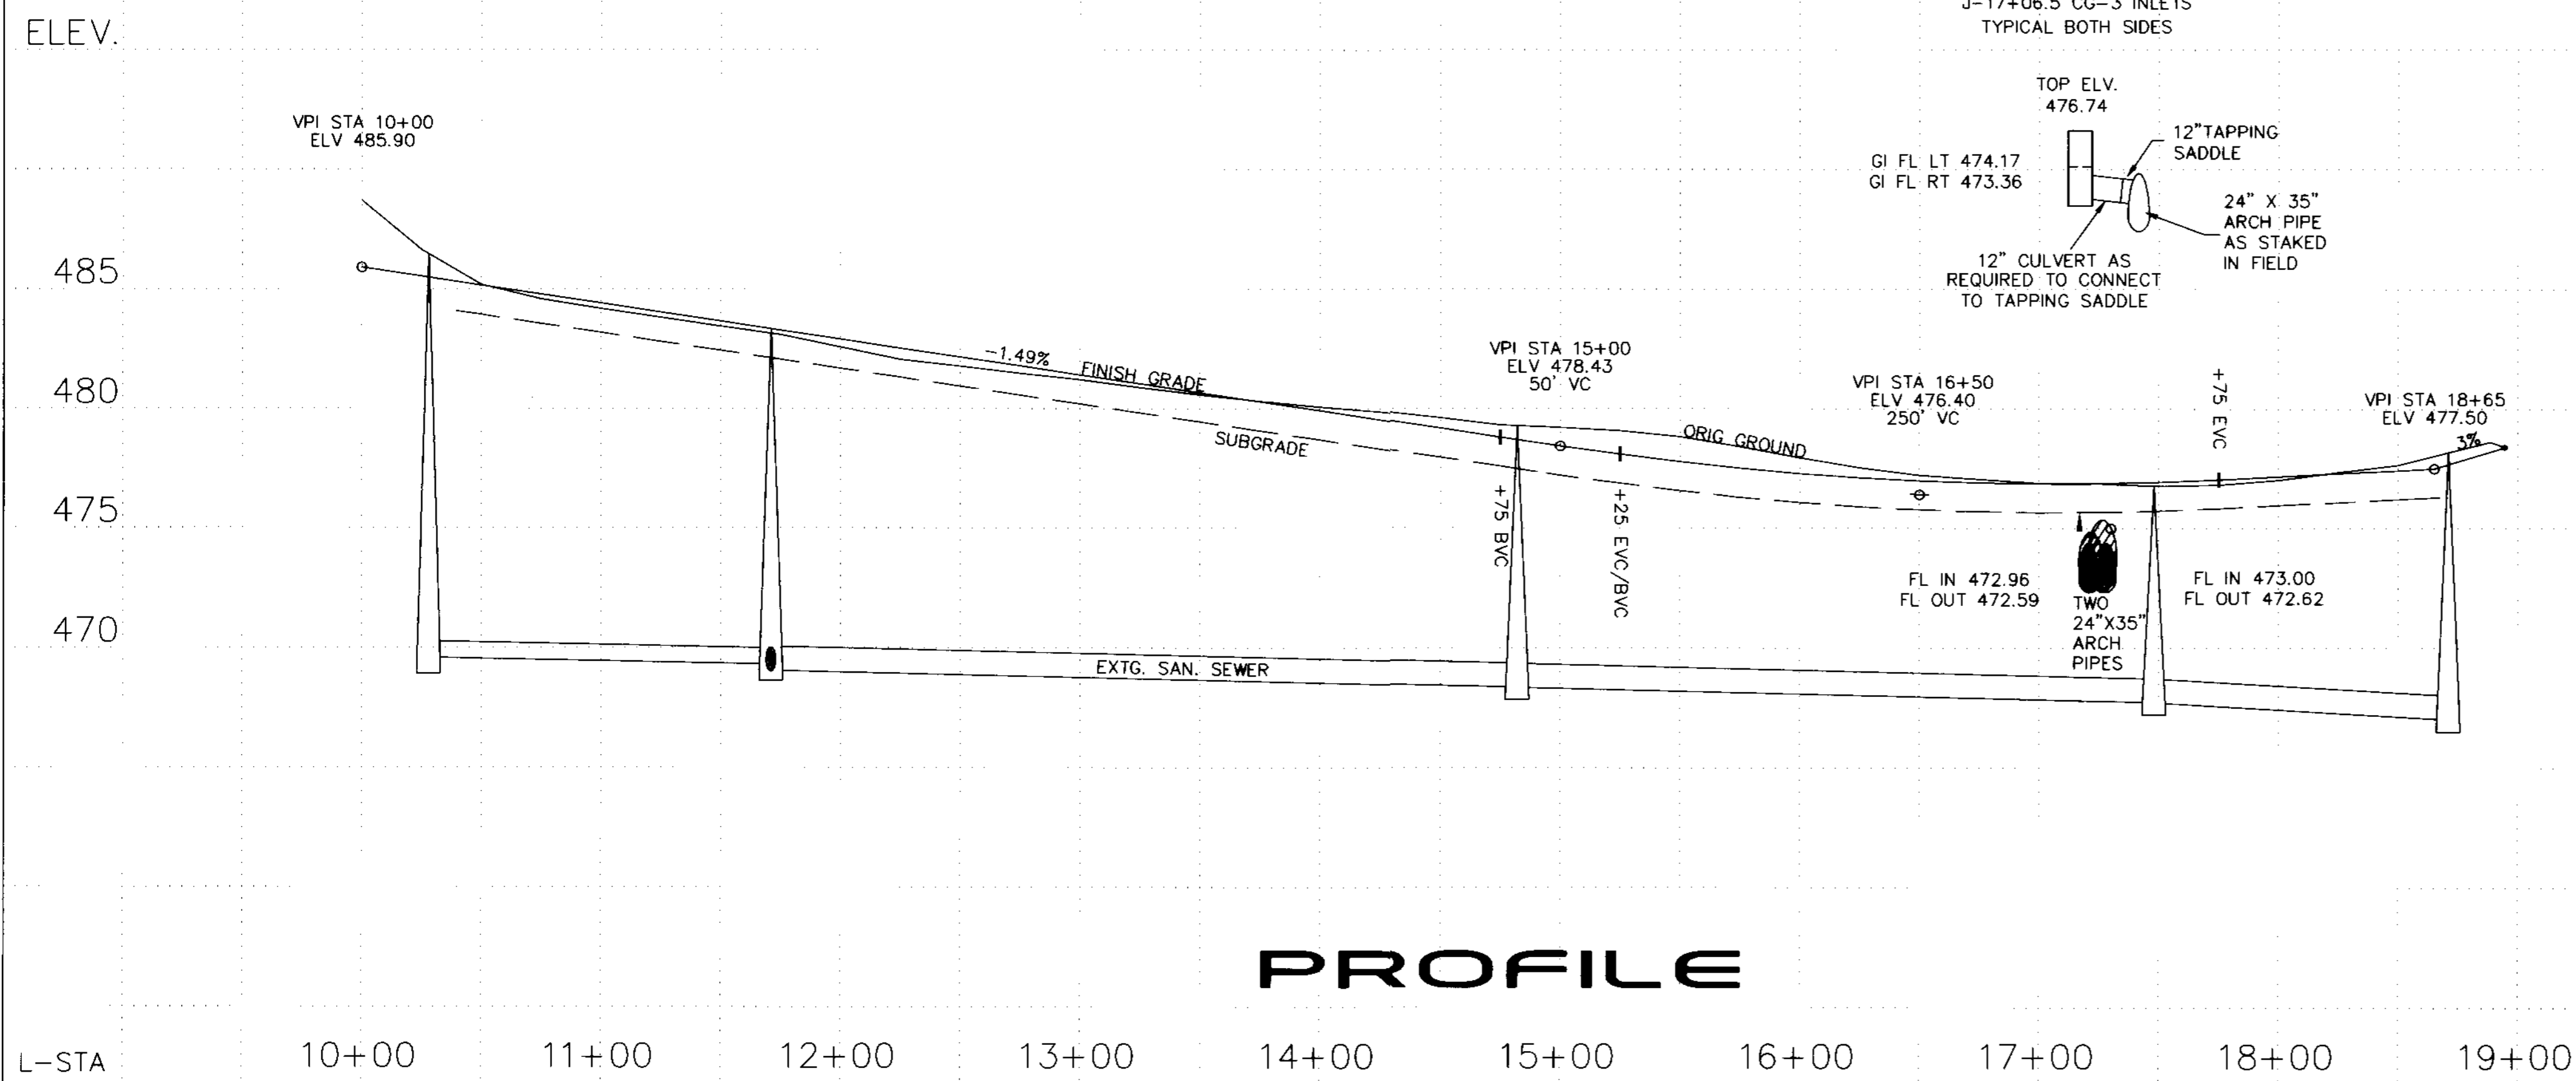

PROFILE



REVISIONS			DOUGLAS COUNTY PUBLIC WORKS DEPARTMENT		
			RECONSTRUCTION OF JOE & EDNA STREETS IN THE GREEN AREA		
DESIGN	DRAWN	CHECKED	DATE	SCALE	DIRECTOR
BLH	BLH		02/1999	AS SHOWN	JIM ERWIN
APPROVED			DATE	SCALE	DIRECTOR
			02/1999	AS SHOWN	JIM ERWIN

Co. Rd # 411A M.P. 0.00-0.17 Joe St 1 of 2

CO. RD. # 411A PLAN & PROFILE

411A0017