

**AS BUILT PLAN**


S.E.1/4 of S.E.1/4 SEC. 3, T. 28 S., R. 6 W., W.M.

FILED  
 Date: 12/13/2002 By: JP  
 This survey consists of:  
 Map:  
 Narrative:  
 Corner Rpt:  
 DOUGLAS COUNTY SURVEYOR

**NOTES**

- ① CONSTRUCT SINGLE DRIVEWAY, PAVE TO R/W LINE IN CURB SECTIONS
- ② CONSTRUCT DOUBLE DRIVEWAY, PAVE TO R/W LINE IN CURB SECTIONS
- ③ ADJUST MANHOLE
- ④ ADJUST BOXES
- ⑤ CONSTRUCT TYPE A CURBS E-20+00 TO 26+10 SEE DWG. RD700
- ⑥ REMOVE CONCRETE PLANTER BOX
- ⑦ CONSTRUCT SPECIAL DITCH & CONNECT TO EXTG. DRAINAGE DITCH E-19+88 LT 14±; E-26+50 LT 100±
- ⑧ REMOVE EXTG. FENCE TO FACILITATE CURB CONSTRUCTION, CONSTRUCT 60' OF TYPE 2 FENCE & INSTALL 16' GATE SEE DWG. RD810
- ⑨ INSTALL TWO 8' TYPE III BARRICADES SEE DWG. RD935
- ⑩ CONSTRUCT DRAINAGE SWALE THRU DRIVEWAY APPROACH
- ⑪ INSTALL 132' OF SCHEDULE 80 PVC DRAIN PIPE AND CONNECT THRU CURB FACE MAKE 4 ROOF DRAIN CONNECTIONS

**GENERAL NOTES**  
 REMOVE ALL EXISTING DRIVEWAY CULVERTS. CONSTRUCT DRIVEWAY CURB CUTS AT LOCATIONS AND WIDTHS AS DIRECTED. INSTALL WEEP HOLES IN CURB AT LOCATIONS PERPENDICULAR TO EXTG. ROOF DRAINS & AT ADDITIONAL LOCATIONS AS DIRECTED

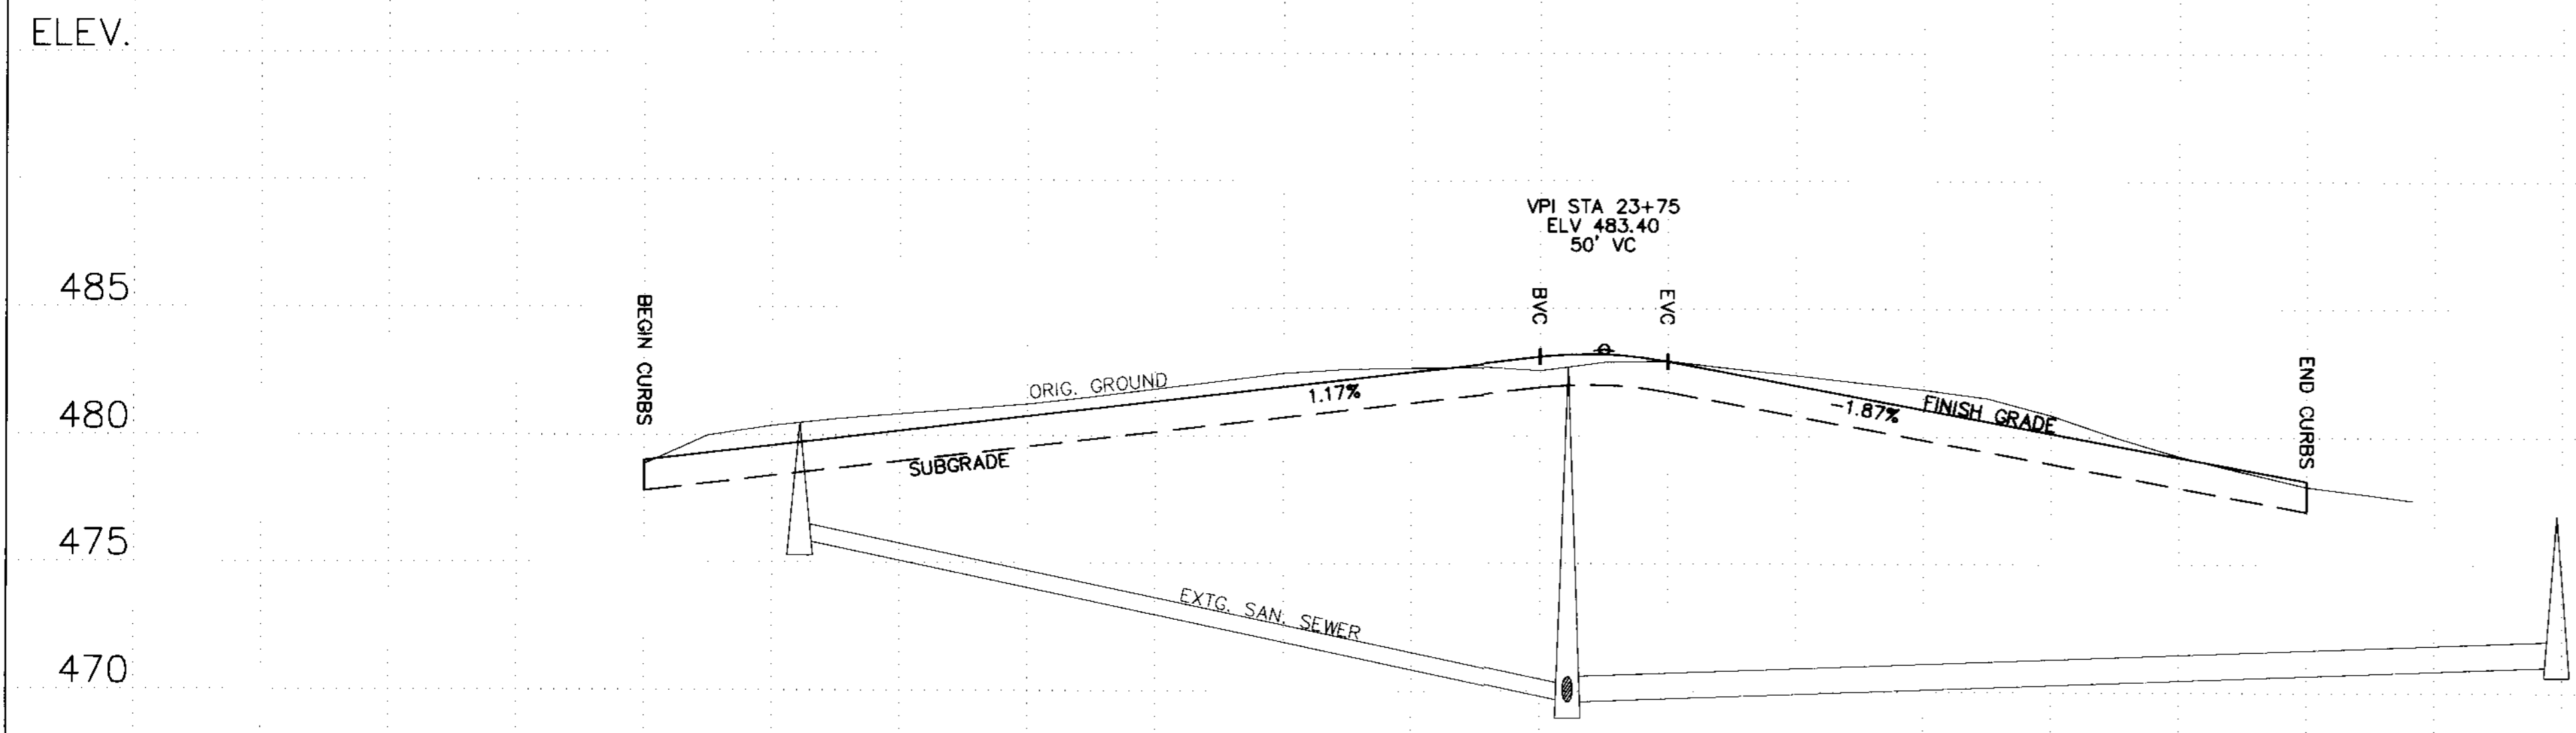

**PROFILE**

L-STA 20+00 21+00 22+00 23+00 24+00 25+00 26+00 27+00

REVISIONS			DOUGLAS COUNTY PUBLIC WORKS DEPARTMENT		
			RECONSTRUCTION OF JOE & EDNA STREETS IN THE GREEN AREA		
DESIGN	DRAWN	CHECKED	DATE	SCALE	DIRECTOR
BLH	BLH		02/1999	AS SHOWN	JIM ERWIN
APPROVED					DRWG. NO.
					SHEET 3 OF 5

Co. Rd. # 411B MP 0.00-0.13 E04A 2 of 2

411B0013