




FILED
 Date: 1/2/2003 By: JP
 This survey consists of:
 Map:
 No. 77:
 Corner Pjt:
 DOUGLAS COUNTY
 SURVEYOR

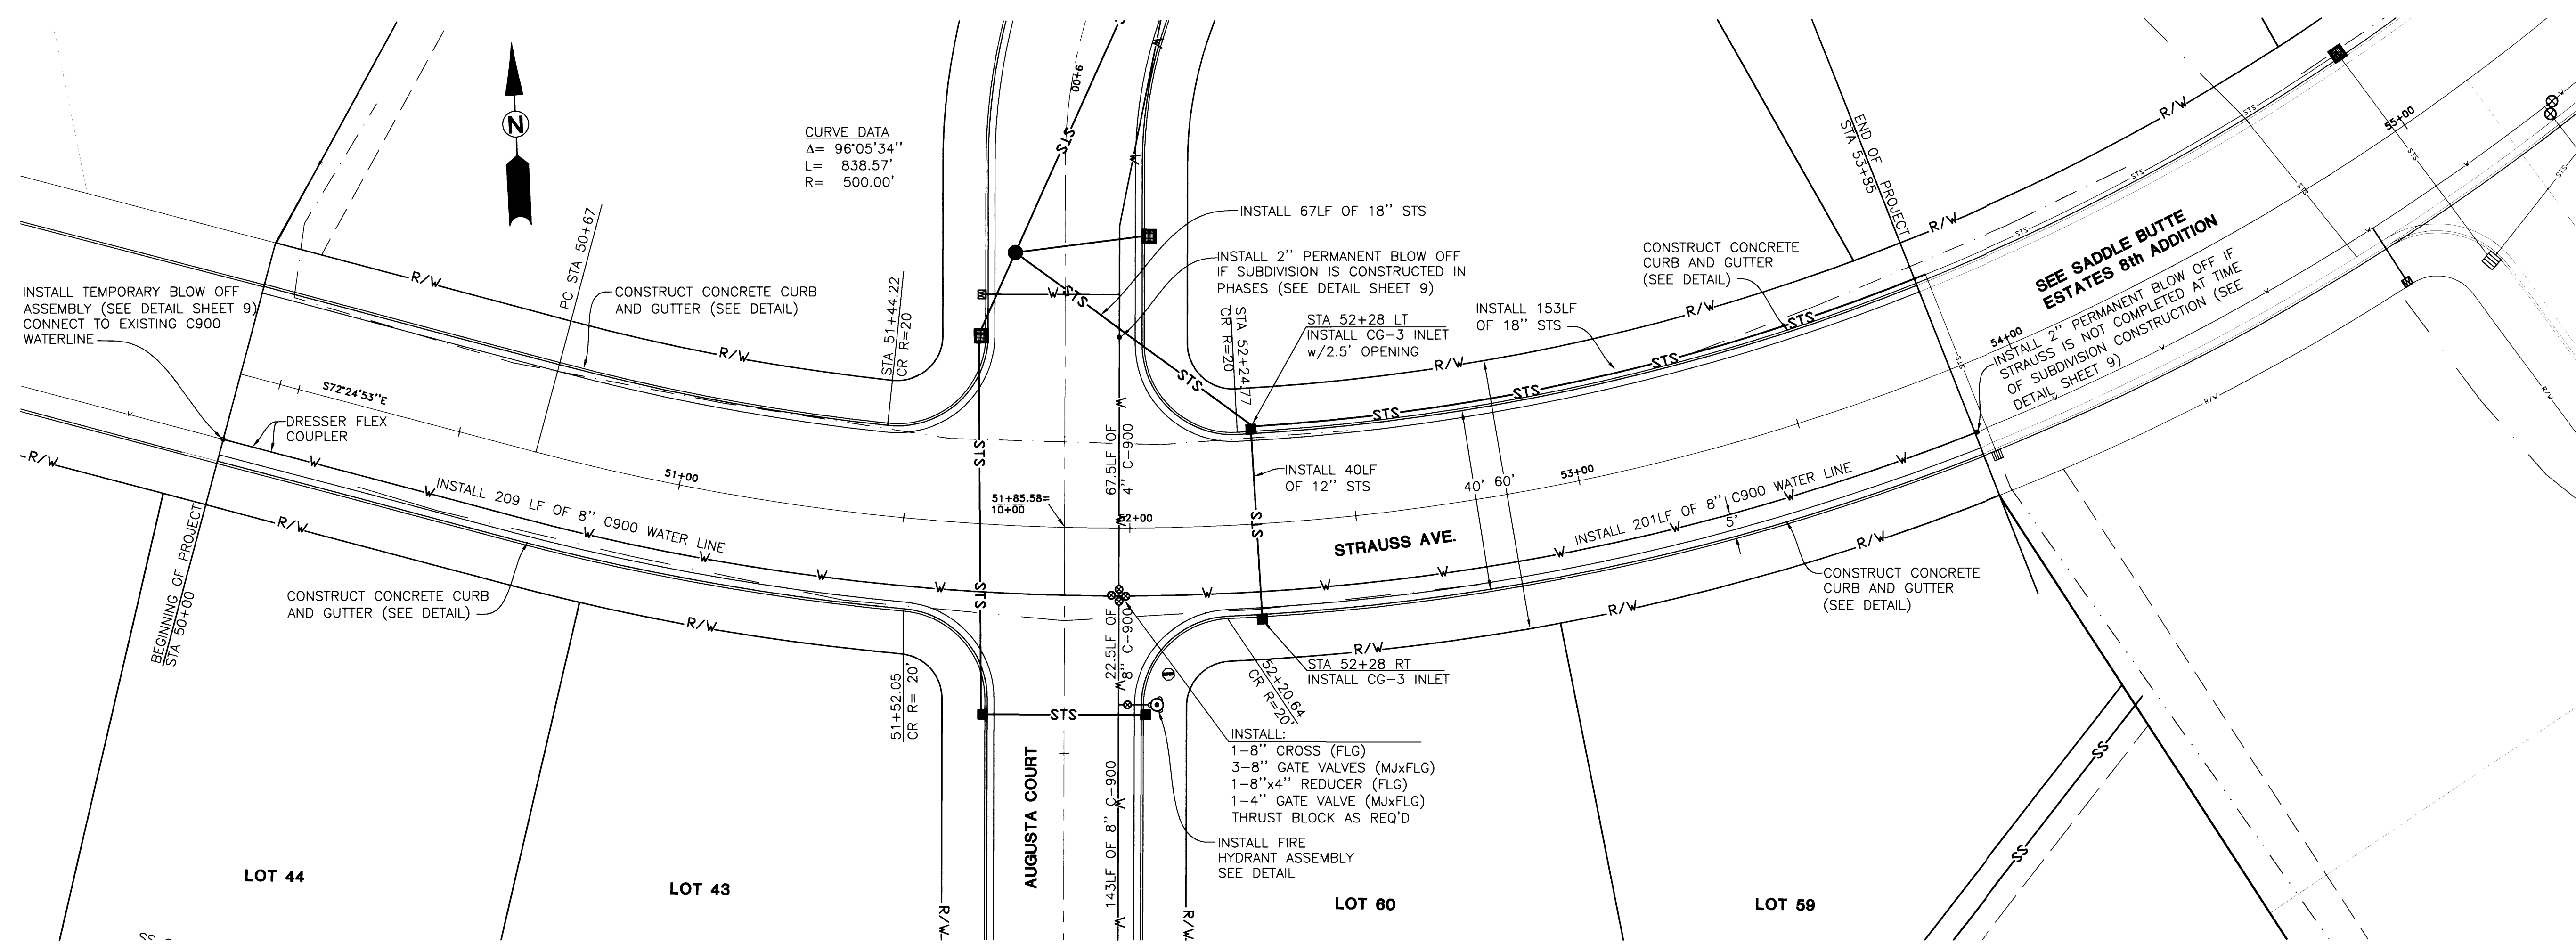

CURVE DATA
 Δ = 96°05'34"
 L = 838.57'
 R = 500.00'

SEE SADDLE BUTTE
 ESTATES 8th ADDITION
 INSTALL 2" PERMANENT BLOW OFF IF
 STRAUSS IS NOT COMPLETED AT TIME
 OF SUBDIVISION CONSTRUCTION (SEE
 DETAIL SHEET 9)

CALL BEFORE YOU DIG I
 ONE CALL: (800) 332-2344
 OAR 952-001-0010 THROUGH
 OAR 952-001-0090

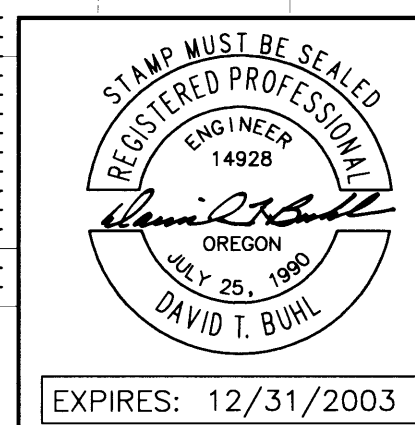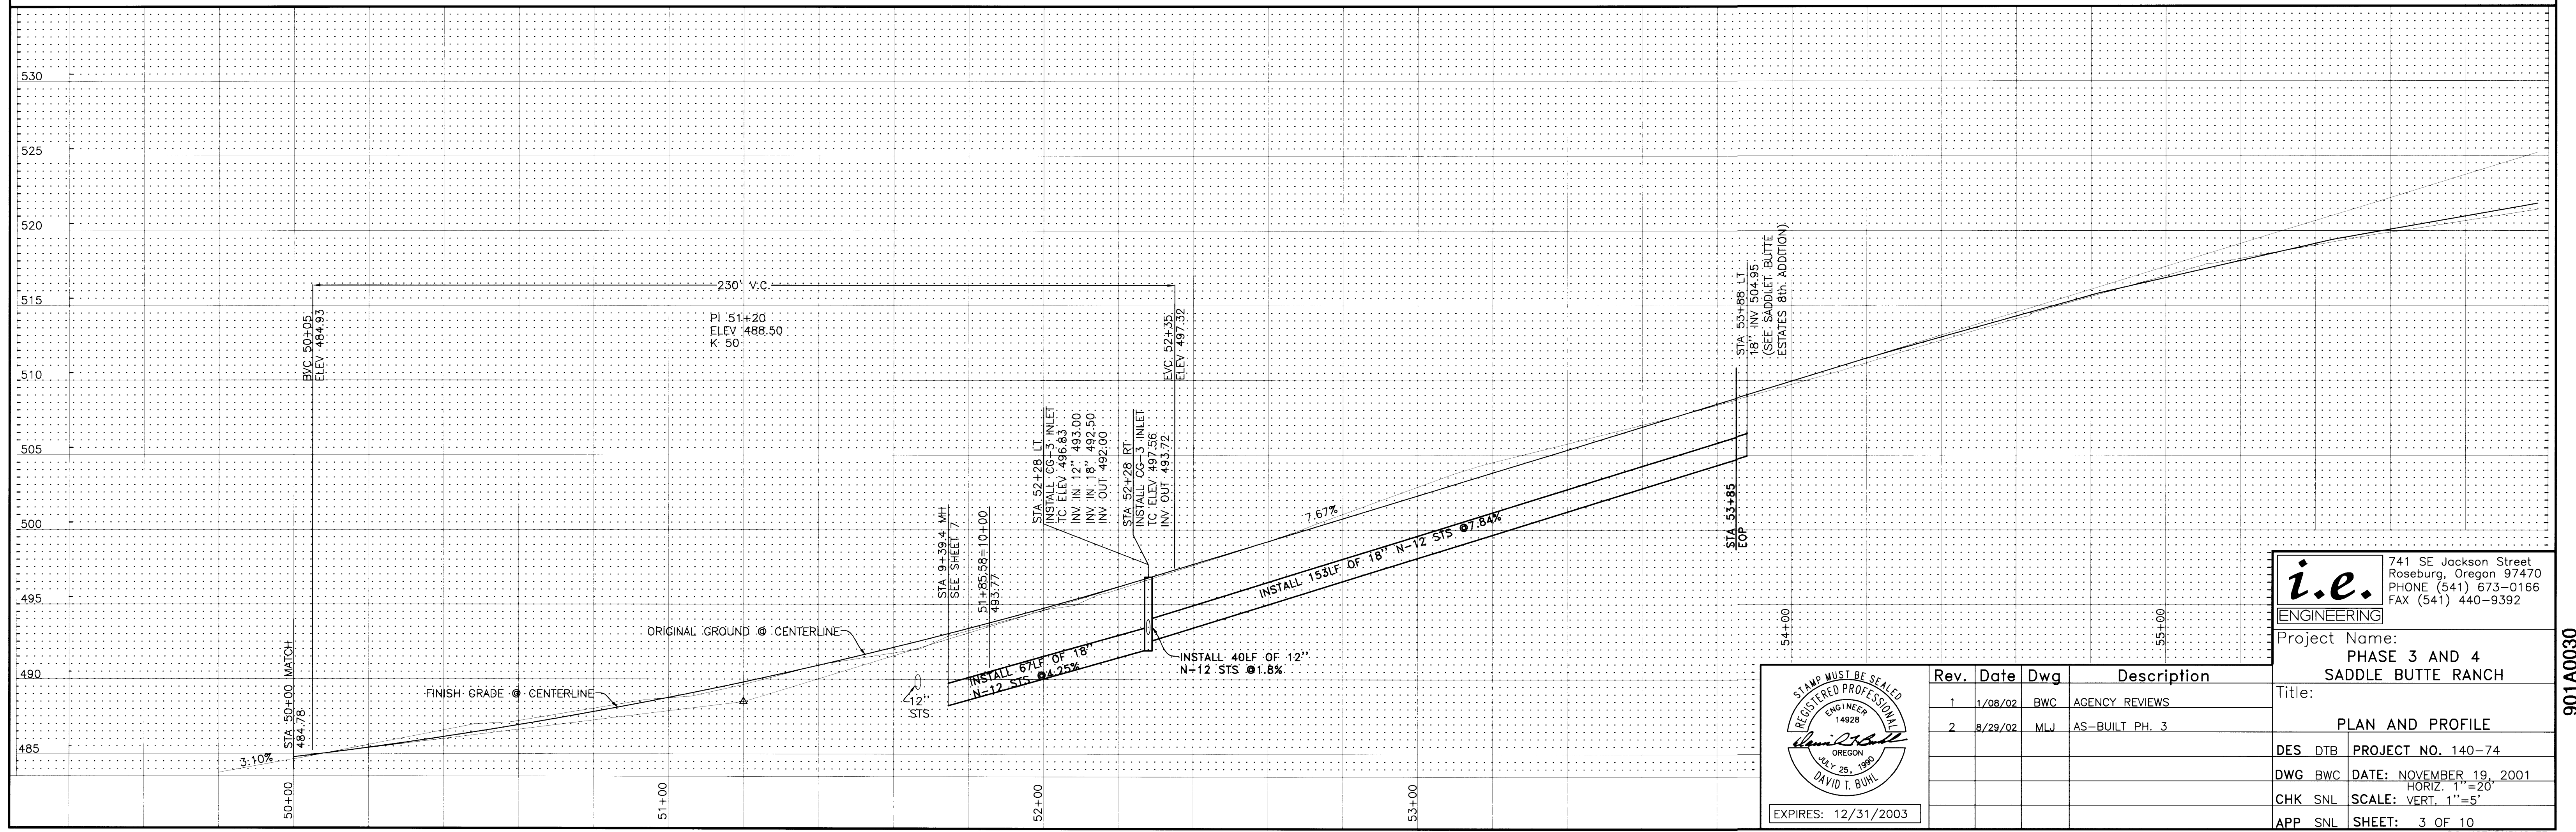

Rev.	Date	Dwg	Description
1	1/08/02	BWC	AGENCY REVIEWS
2	8/28/02	MLJ	AS-BUILT PH. 3

i.e. ENGINEERING
 741 SE Jackson Street
 Roseburg, Oregon 97470
 PHONE (541) 673-0166
 FAX (541) 440-9392

Project Name:
 PHASE 3 AND 4
 SADDLE BUTTE RANCH

Title:
 PLAN AND PROFILE

DES DTB PROJECT NO. 140-74
 DWG BWC DATE: NOVEMBER 19, 2001
 HORIZ. 1"=20'
 CHK SNL SCALE: VERT. 1"=5'
 APP SNL SHEET: 3 OF 10

Cs. Rd. # 901A M.P. 0.30 - 0.40 DO NOT DUPLICATE

CO. RD. # 901A, PLAN & PROFILE

901A0030