

FILED
 Date: 5/15/2002 By: JP
 This survey consists of:
 Map: _____
 Narrative: _____
 Corner Rpt: _____

DOUGLAS COUNTY
 SURVEYOR

SURVEYING SERVICE, INC.
 ENGINEERING • SURVEYING • PLANNING
 3076 NE DIAMOND LAKE BLVD.
 ROSEBURG, OREGON 97470
 TEL (541)672-2096
 FAX (541)672-0611

Revision	12/96
Date	
Revision	
Date	



Drawn	RDM
Design	
Checked	
Reviewed	

TITLE: PROJECT OVERALL
 CONSTRUCTION PLAN VIEW
 PROJECT NAME: SADDLE BUTTE RANCH PHASE II
 AS-BUILTS

SHT. 2
 OF 7

901A901G

1822-962\1822-962.DWG

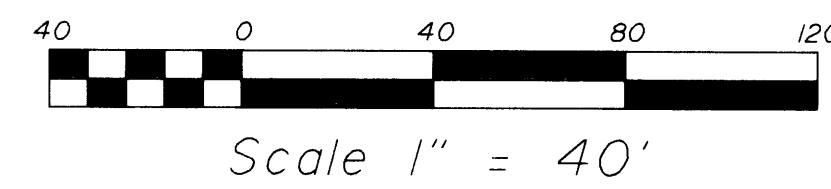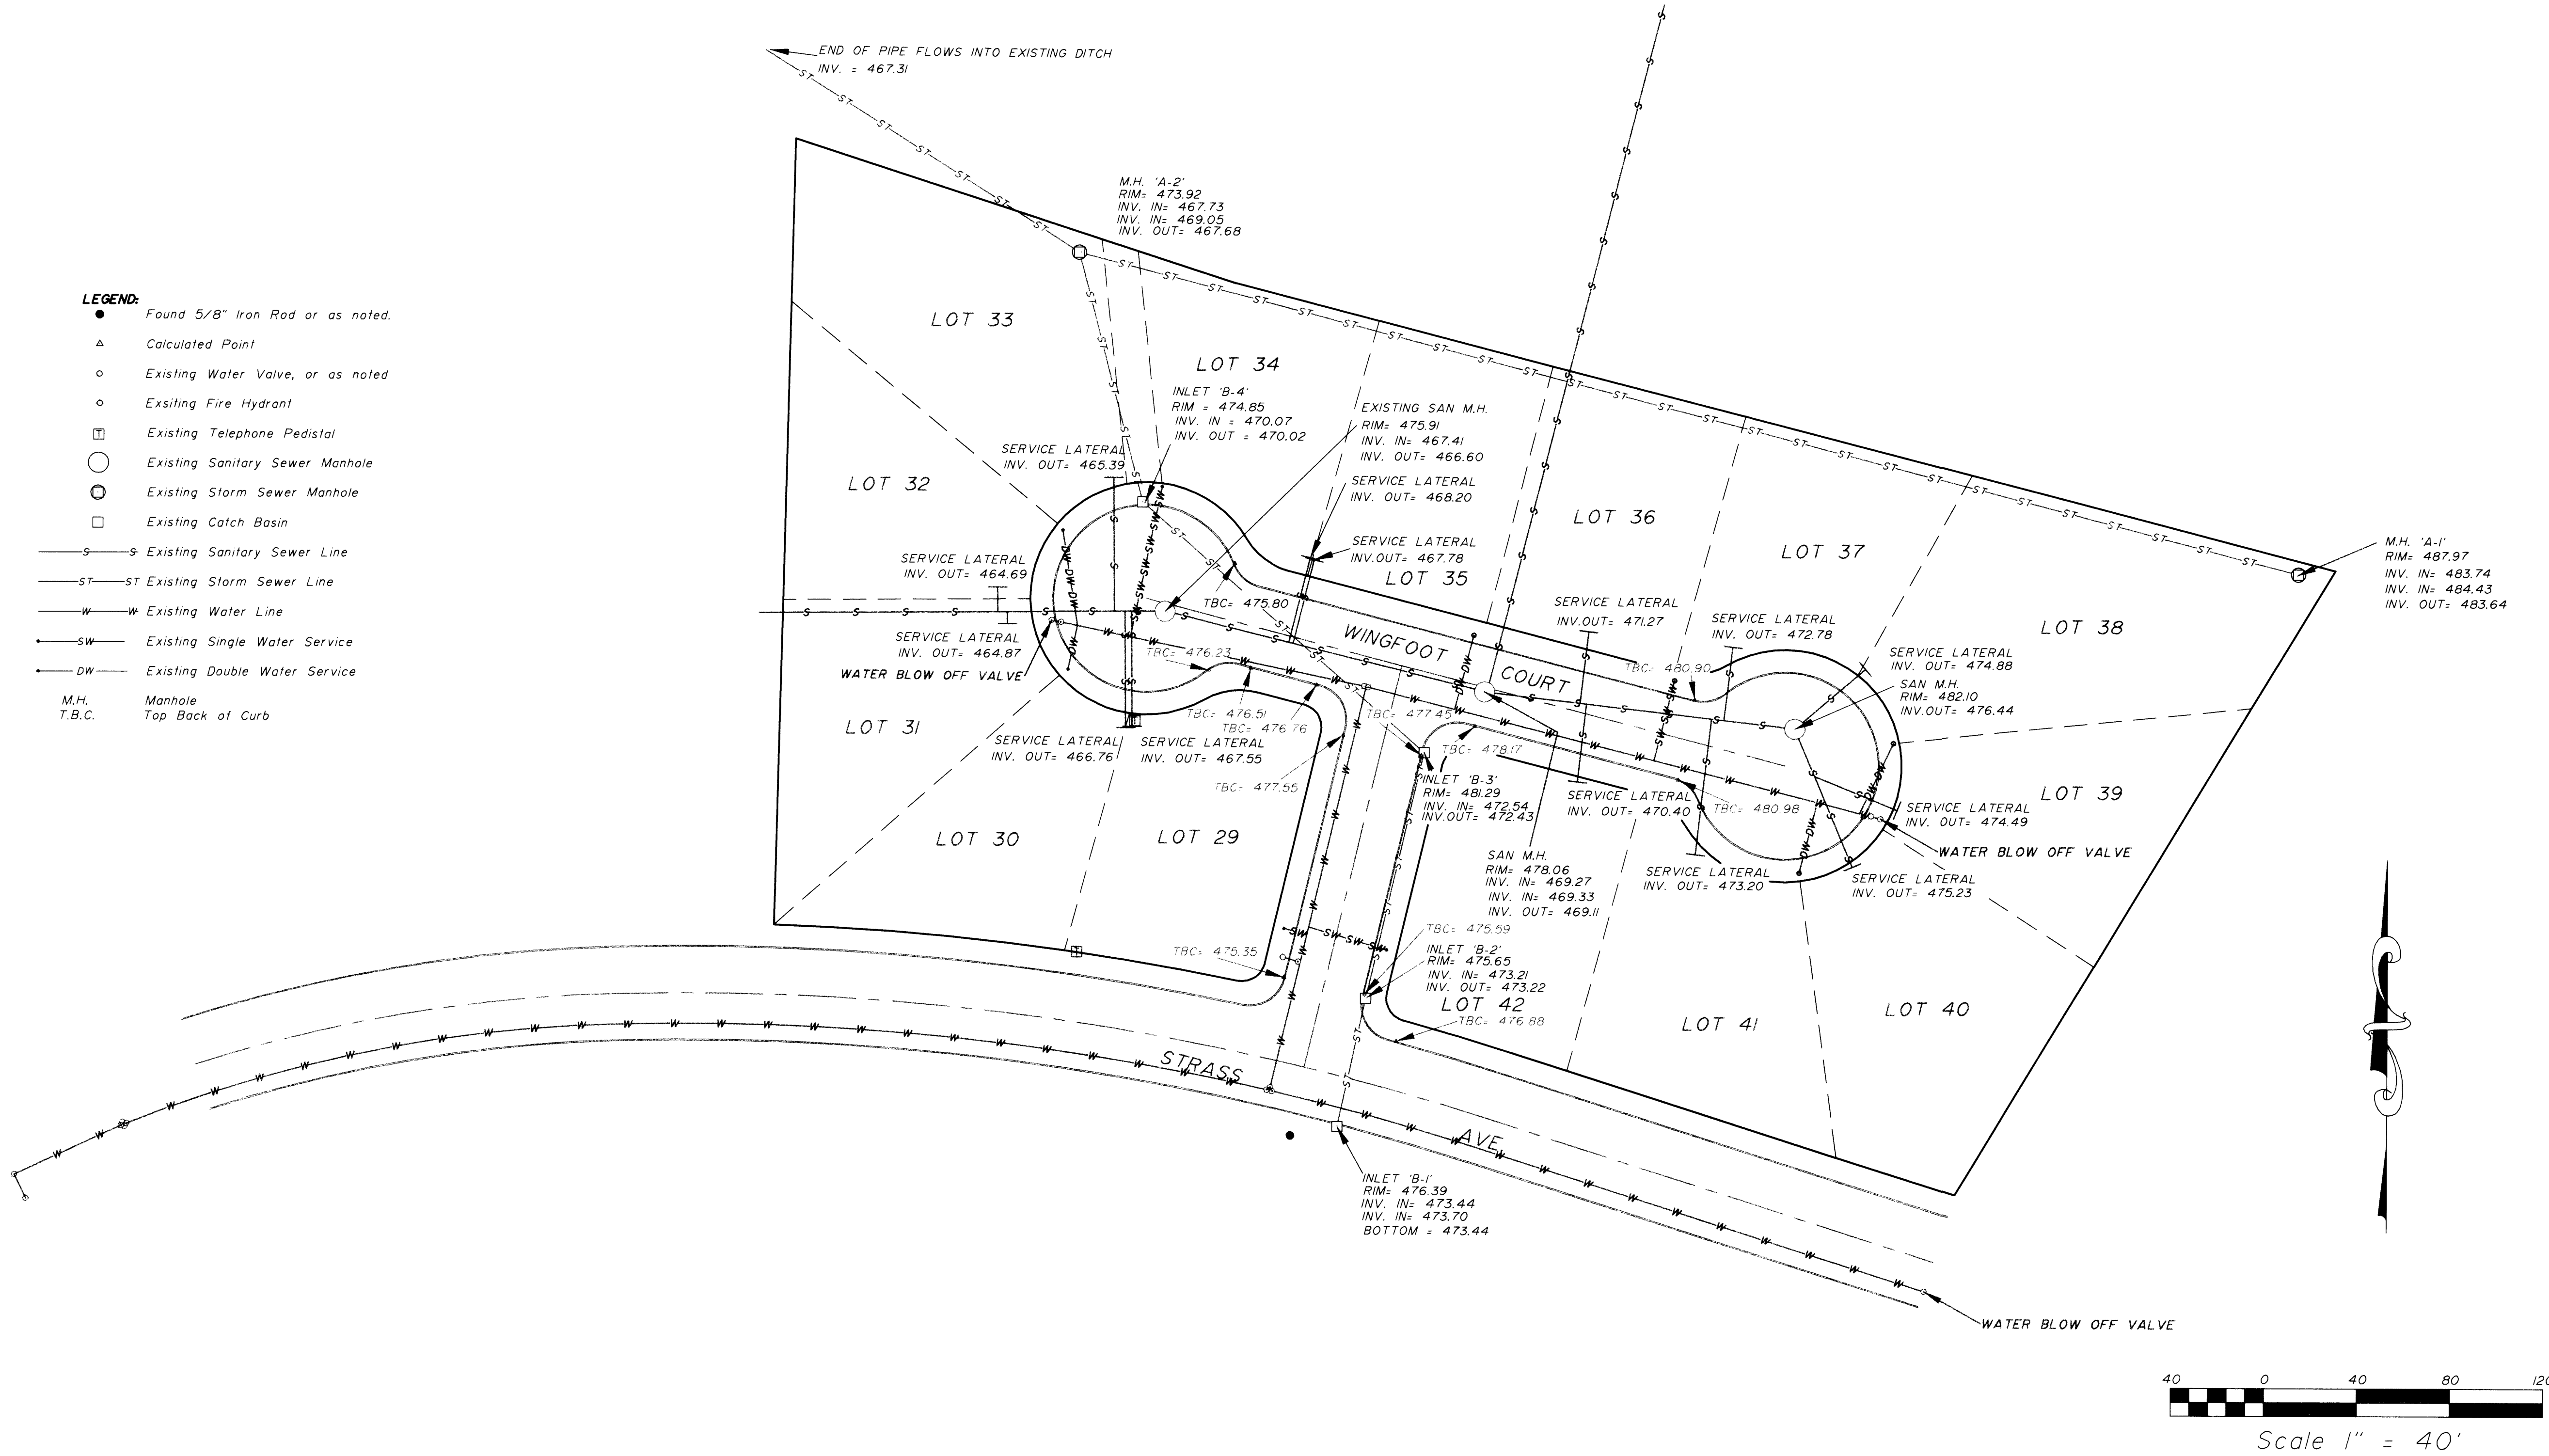

- LEGEND:**
- Found 5/8" Iron Rod or as noted.
 - ▲ Calculated Point
 - Existing Water Valve, or as noted
 - Existing Fire Hydrant
 - Existing Telephone Pedestal
 - Existing Sanitary Sewer Manhole
 - Existing Storm Sewer Manhole
 - Existing Catch Basin
 - S— Existing Sanitary Sewer Line
 - ST— Existing Storm Sewer Line
 - W— Existing Water Line
 - SW— Existing Single Water Service
 - DW— Existing Double Water Service
 - M.H. Manhole
 - T.B.C. Top Back of Curb