



TYPICAL FIRE HYDRANT INSTALLATION
 (THRUST BLOCKED)

NOTES:
 ALL PIPE AND FITTINGS FOR TIE-IN TO BE CLEAN AND WIPED w/CHLORINE PRIOR TO INSTALLATION

CONTRACTOR TO ALIGN NEW MAINLINE IN BOTH ALIGNMENT AND GRADE w/EXISTING 8" WATERLINE. CONNECTION TO EXISTING WATERLINE CAN ONLY BE MADE AFTER INSTALLATION, TESTING & DISINFECTION OF NEW WATERLINE HAS BEEN COMPLETED.

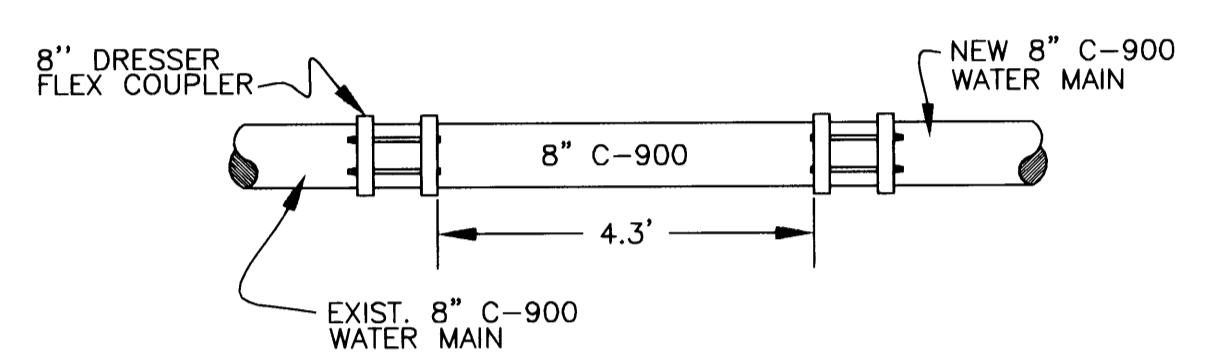

WATER TIE-IN DETAIL
 50+09 STRAUS AVE.

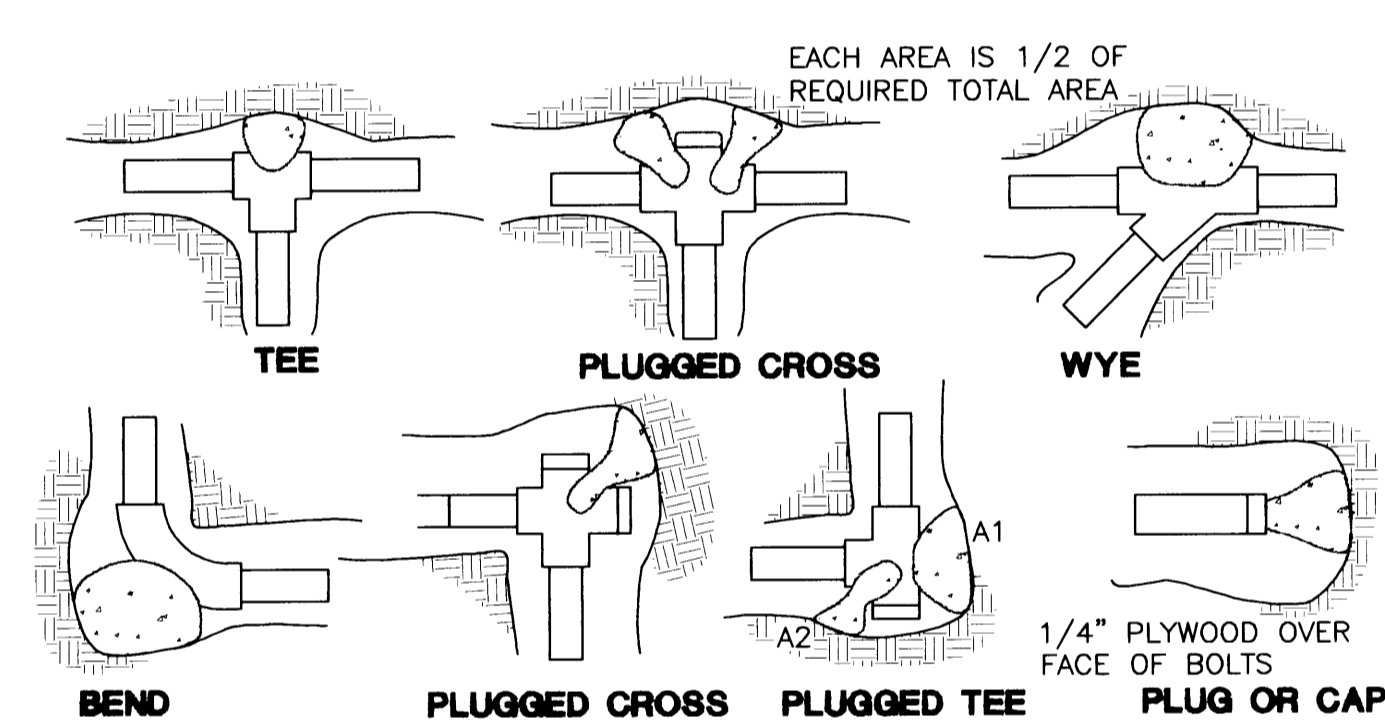


FITTING SIZE	TEE, WYE, PLUG, OR CROSS	90° BEND PLUGGED CROSS	TEE PLUGGED A1	A2	45° BEND	22 1/2° BEND	11 1/4° BEND
2	0.5	1.1	1.6	1.1	0.5	--	--
3	1.3	2.1	3.2	2.1	1.3	0.5	--
4	2.7	3.7	5.1	3.7	2.7	1.1	0.5
6	5.6	8.0	11.5	8.0	4.3	2.7	1.3
8	10.1	14.2	20.3	14.4	7.7	4.0	1.7
10	15.8	22.4	31.5	22.4	12.3	6.4	3.2
12	22.7	32.0	45.4	32.0	17.6	9.1	4.5
14	30.7	43.5	61.4	43.5	23.8	12.3	6.1
16	40.1	56.9	80.1	56.9	31.0	16.0	8.0
18	50.7	72.1	101.5	72.1	39.0	20.3	10.1
20	62.7	88.9	125.5	88.9	48.3	25.1	12.5
24	90.8	128.2	181.6	128.2	70.0	36.3	18.2



NOTE: ABOVE BEARING AREAS BASED ON TEST PRESSURE OF 200 p.s.i. AND AN ALLOWABLE SOIL BEARING STRESS OF 1,000 lbs. PER SQUARE FOOT. TO COMPUTE BEARING AREAS FOR DIFFERENT TEST PRESSURES AND SOIL BEARING STRESSES, USE THE FOLLOWING EQUATION: BEARING AREA = (TEST PRESSURE/200) x (1000/SOIL BEARING STRESS) x (TABLE VALUE)

NOTES:
 1. CONCRETE THRUST BLOCKING TO BE POURED AGAINST UNDISTURBED EARTH.
 2. KEEP CONCRETE CLEAR OF JOINT AND ACCESSORIES.
 3. THE REQUIRED THRUST BEARING AREAS FOR SPECIAL CONNECTIONS ARE SHOWN ENCIRCLED ON THE PLANS, e.g. (5) INDICATES 15 SQUARE FEET BEARING AREA REQUIRED.
 4. IF NOT SHOWN ON PLANS REQUIRED BEARING AREAS AT FITTING SHALL BE AS INDICATED ABOVE, ADJUSTED IF NECESSARY, TO CONFORM TO THE TEST PRESSURE(S) AND ALLOWABLE SOIL BEARING STRESS(ES) STATED IN THE SPECIAL SPECIFICATIONS.
 5. BEARING AREAS AND SPECIAL BLOCKING DETAILS SHOWN ON PLANS. TAKE PRECEDENCE OVER BEARING AREAS AND BLOCKING DETAILS SHOWN ON THIS STANDARD DETAIL.



THRUST BLOCK DETAILS AND INFORMATION
 NO SCALE

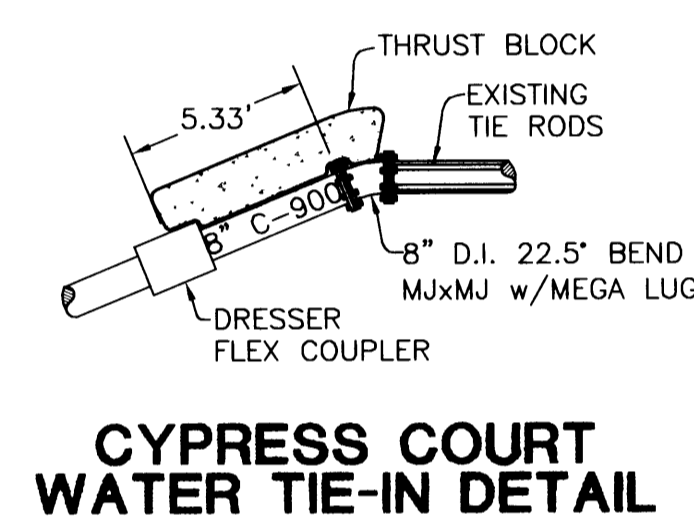

CYPRESS COURT WATER TIE-IN DETAIL

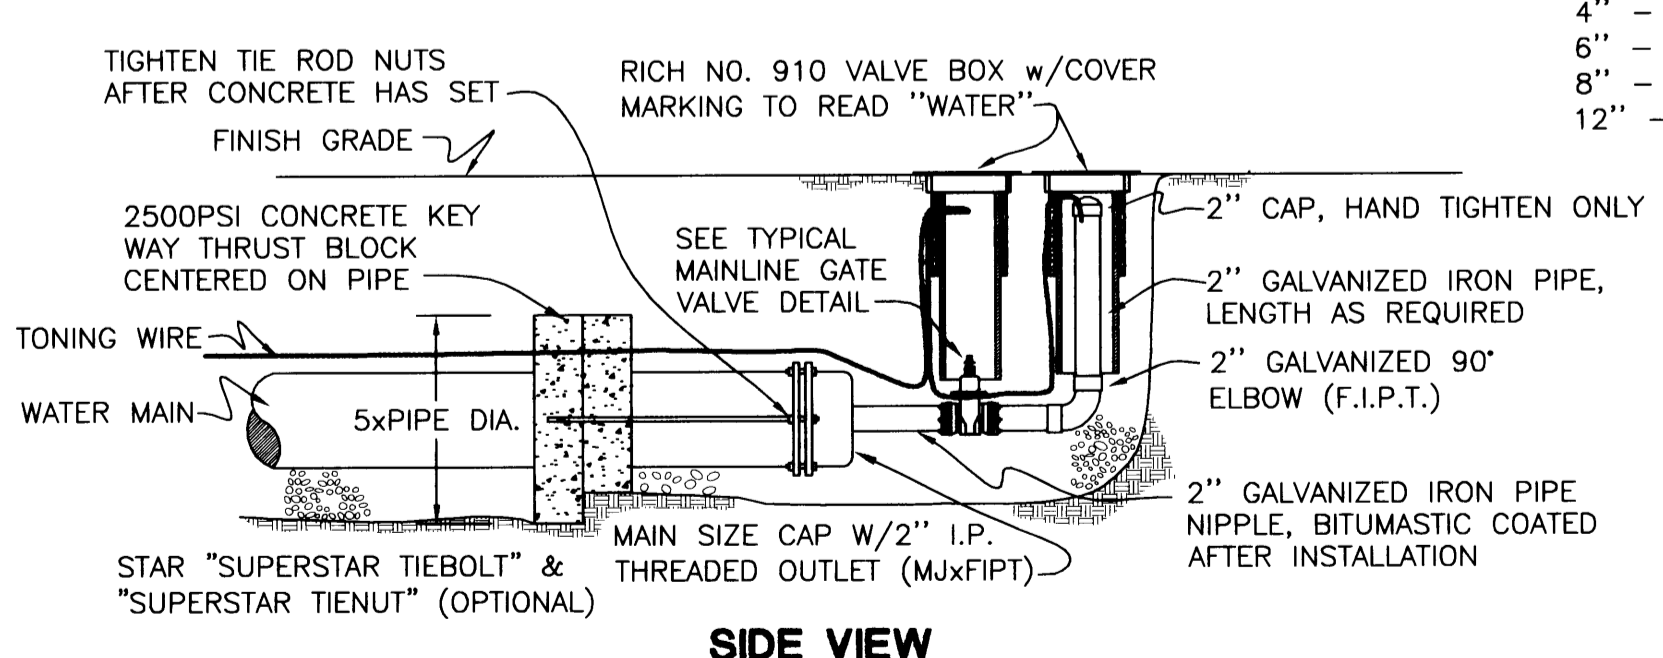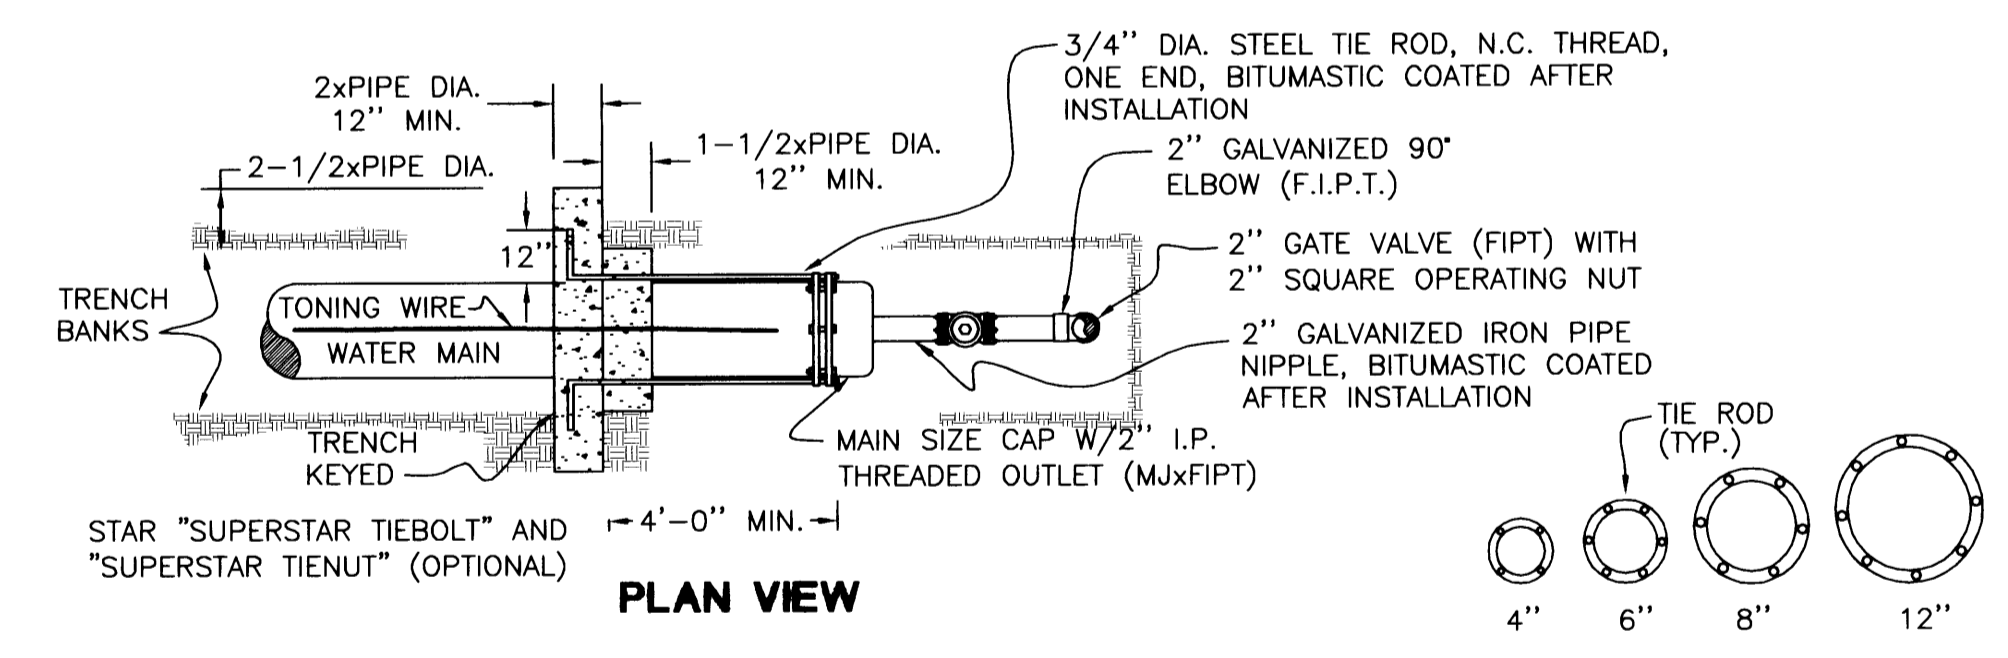


TYPICAL 2" BLOWOFF ASSEMBLY DETAIL

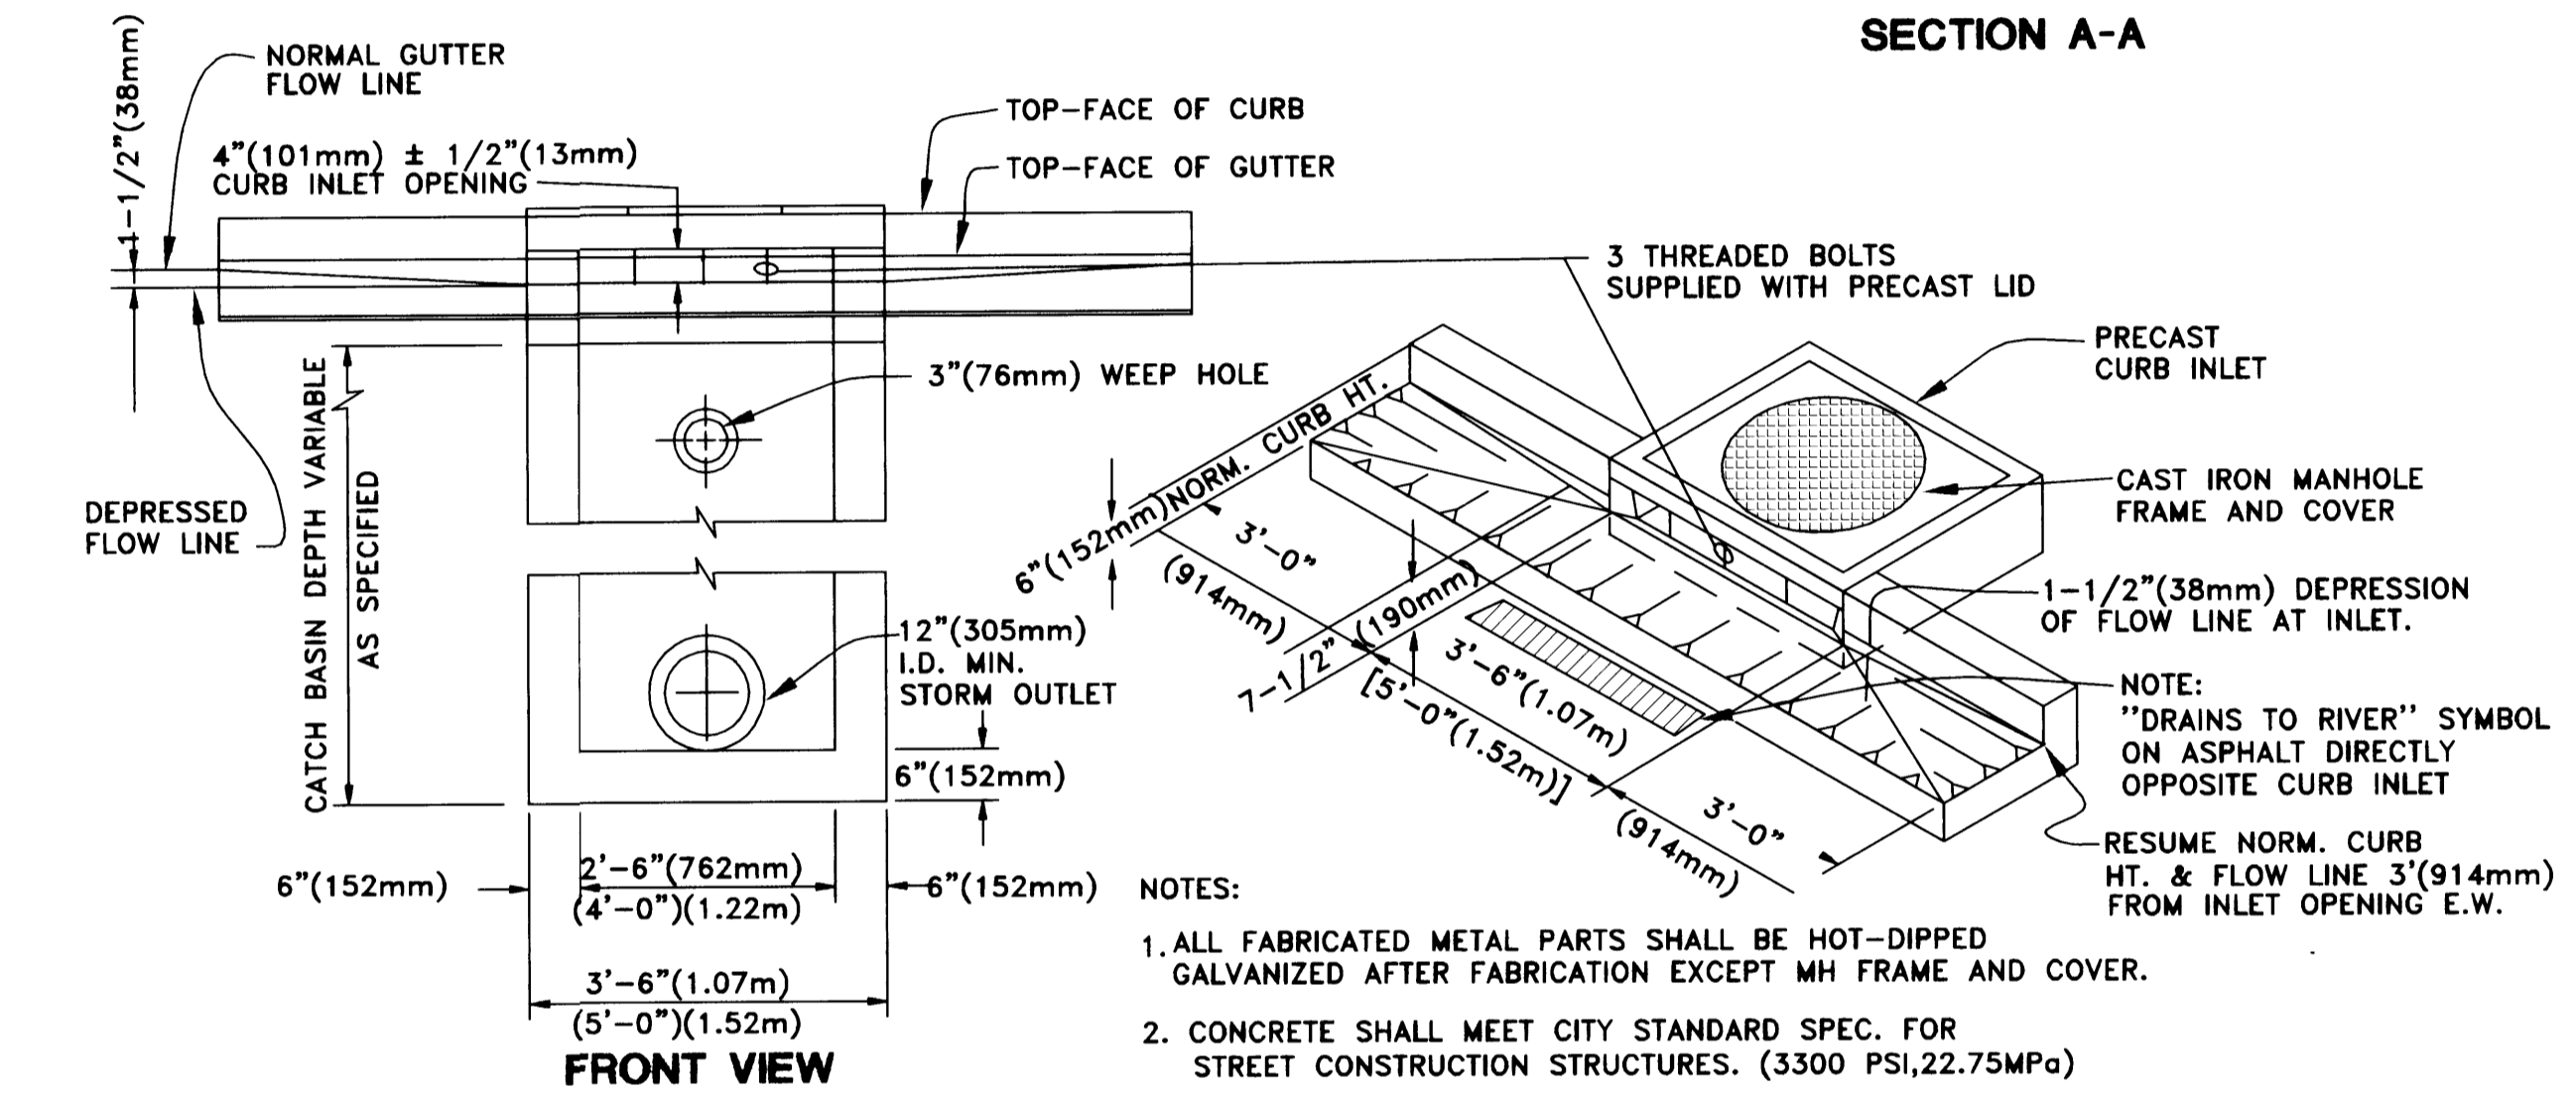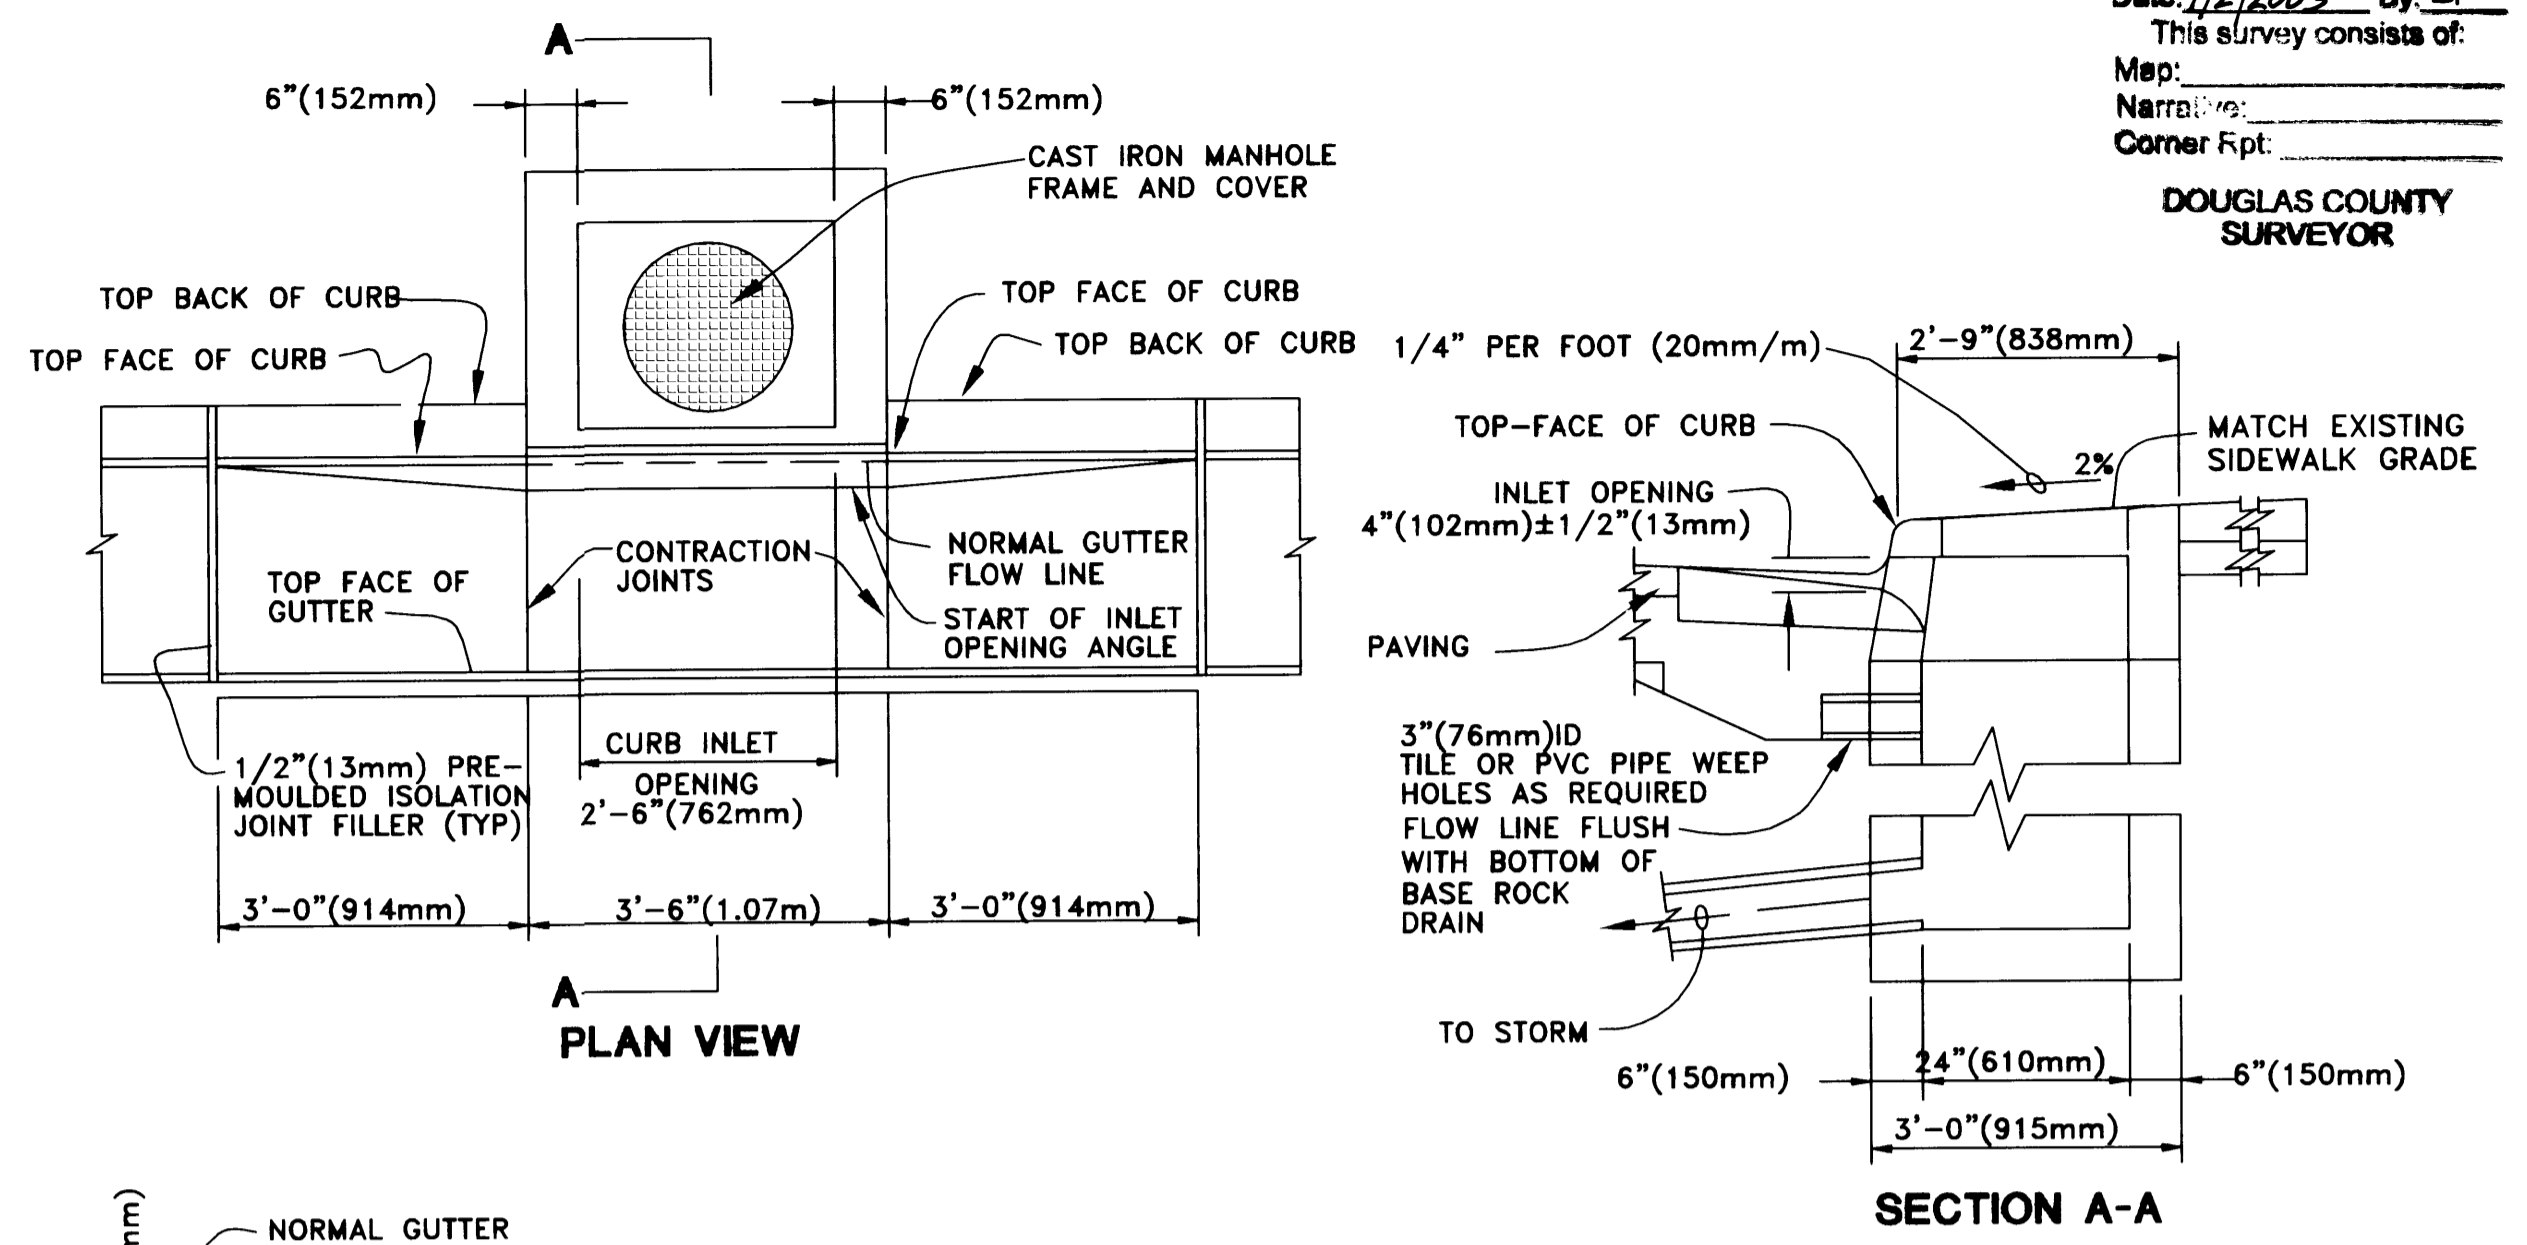

NOTES:
 1. ALL FABRICATED METAL PARTS SHALL BE HOT-DIPPED GALVANIZED AFTER FABRICATION EXCEPT MH FRAME AND COVER.
 2. CONCRETE SHALL MEET CITY STANDARD SPEC. FOR STREET CONSTRUCTION STRUCTURES. (3300 PSI, 22.75MPa)
 3. FOR STEEP GRADES USE STD. PRECAST INLET WITH 4'-0"(102mm) OPENING OR TWO 2'-6"(762mm) OPENING INLETS.
 4. CURB INLET BASE MAY BE PRECAST OR CAST-IN-PLACE.

TYPICAL CG-3 INLET DETAIL

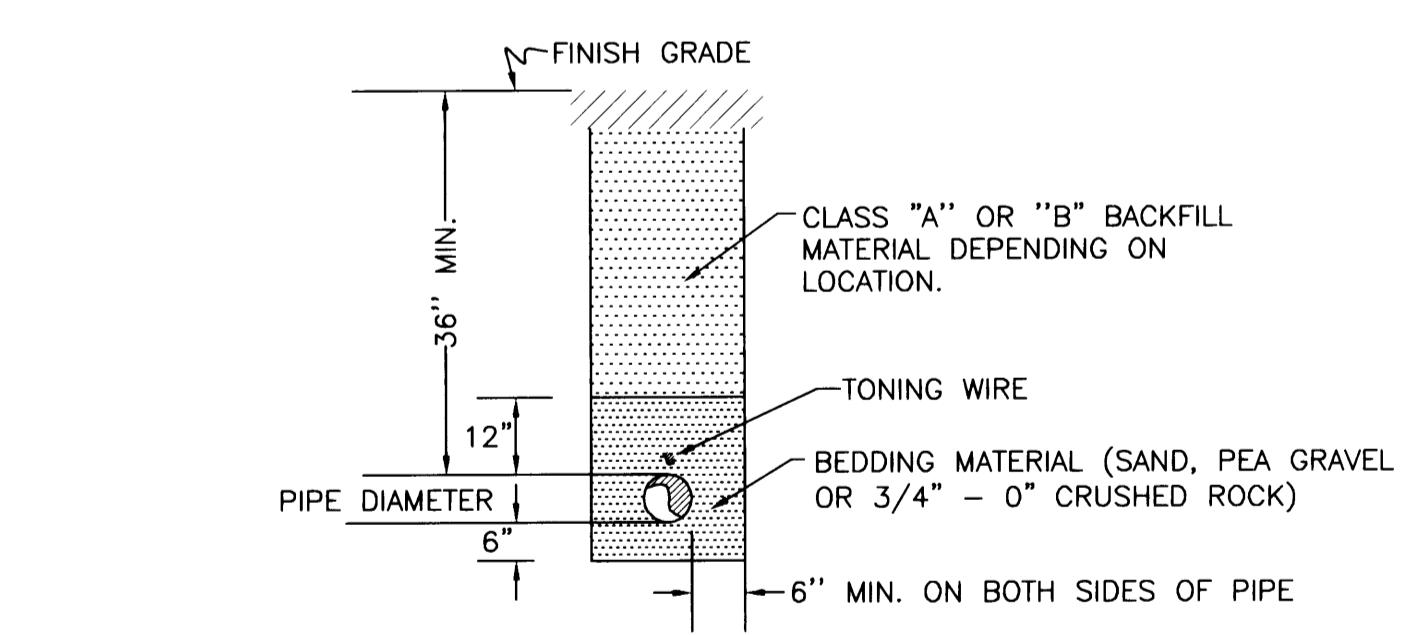


TYPICAL WATER MAINLINE TRENCH DETAIL

CALL BEFORE YOU DIG I
 ONE CALL: (800) 332-2344
 OAR 952-001-0010 THROUGH
 OAR 952-001-0090

i.e. ENGINEERING
 741 SE Jackson Street
 Roseburg, Oregon 97470
 PHONE (541) 673-0166
 FAX (541) 440-9392

Project Name:
 PHASE 3 AND 4
 SADDLE BUTTE RANCH

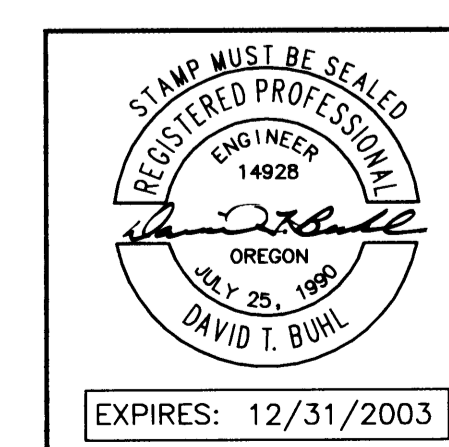

Rev.	Date	Dwg	Description	Title:
1	1/08/02	BWC	AGENCY REVIEWS	DETAILS
2	8/29/02	MLJ	AS-BUILTS PH. 3	
				DES DTB PROJECT NO. 140-74
				DWG BWC DATE: NOVEMBER 19, 2001
				CHK SNL SCALE: AS SHOWN
				APP SNL SHEET: 9 OF 10

Co. Rd. # 901A