


FILED
 Date: 10/21/2003 By: J.P.
 This survey consists of:
 Map:
 Narr: _____
 Corner Rpt: _____
 DOUGLAS COUNTY
 SURVEYOR

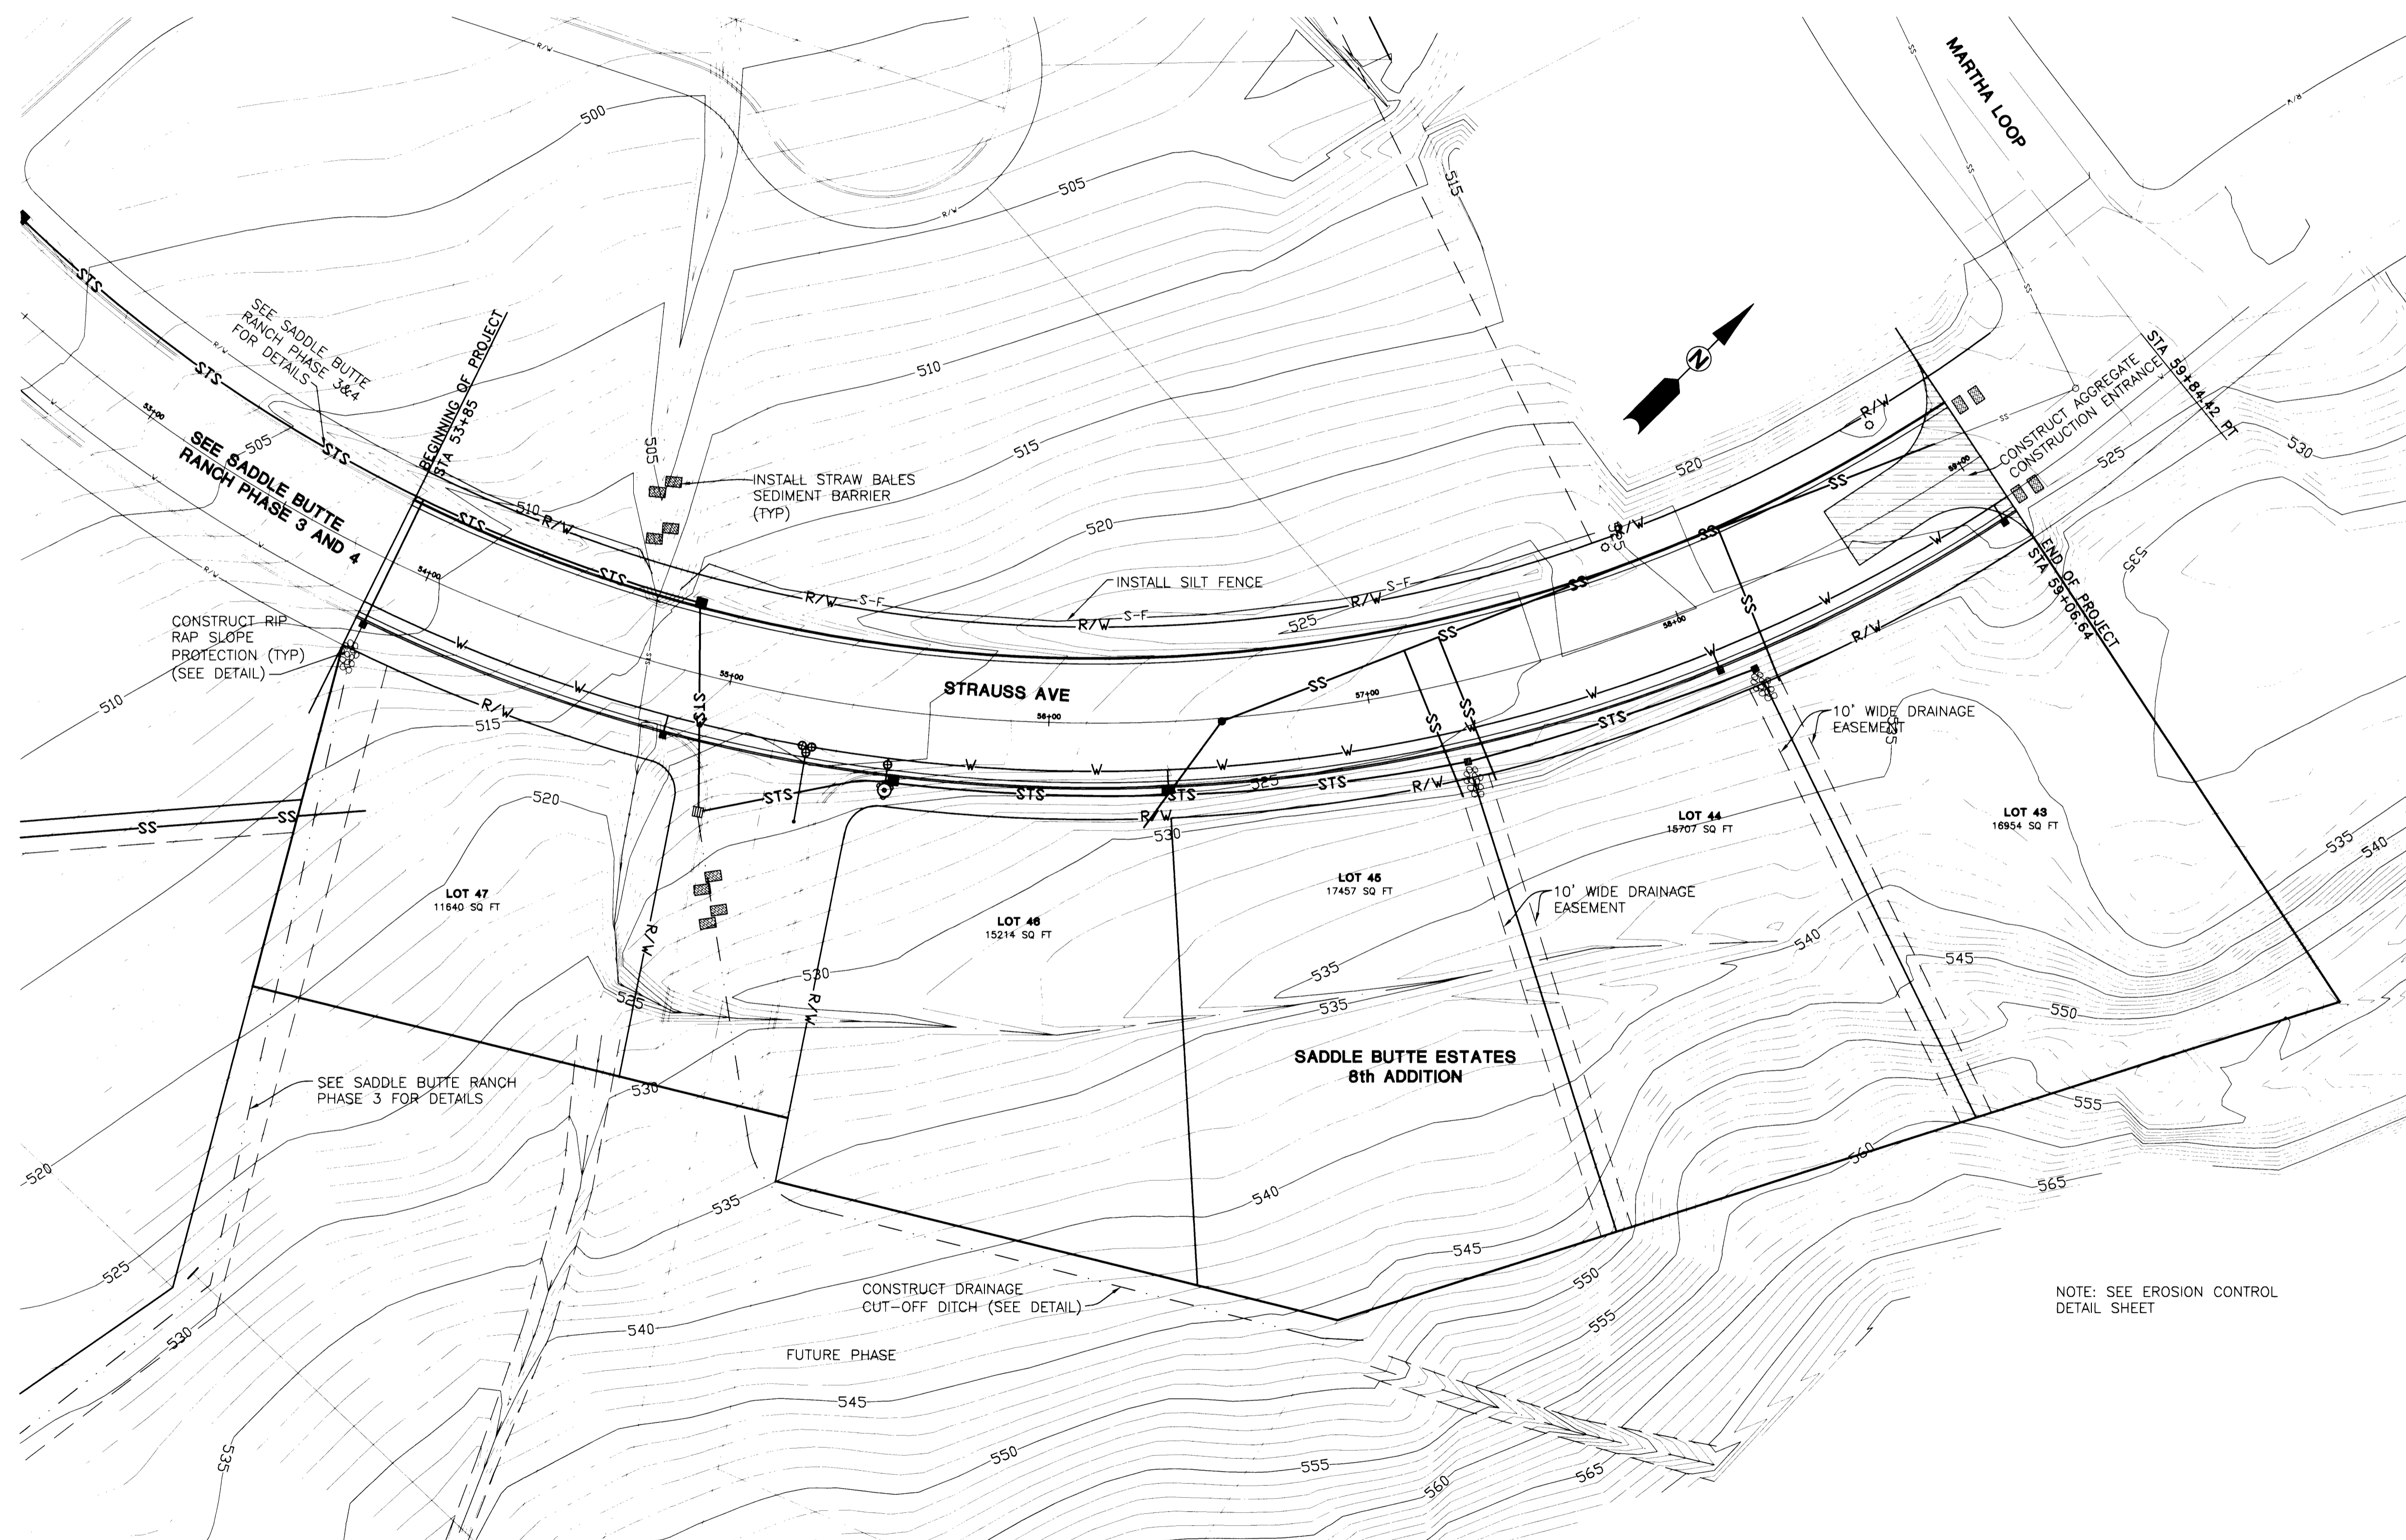


NOTE: SEE EROSION CONTROL
 DETAIL SHEET

CALL BEFORE YOU DIG I
ONE CALL: (800) 332-2344
 OAR 952-001-0010 THROUGH
 OAR 952-001-0090

i.e.
 ENGINEERING
 741 SE Jackson Street
 Roseburg, Oregon 97470
 PHONE (541) 673-0166
 FAX (541) 440-9392

Project Name:		8th ADDITION SADDLE BUTTE ESTATES	
Title:		OVERALL & EROSION CONTROL	
DES DTB	PROJECT NO.	140-76	
DWG BWC	DATE:	NOVEMBER 15, 2001	
CHK SNL	SCALE:	1"=30'	
APP SNL	SHEET:	2 OF 6	

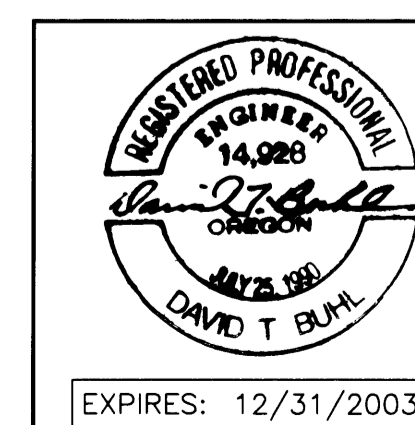

Rev.	Date	Dwg	Description
1	1/09/02	BWC	AGENCY REVIEWS
2	12/12/02	MLJ	AS-BUILTS

Co. Rd. #901A DO NOT DUPLICATE

CO. RD. #901A OVERALL & EROSION CONTROL

901A EPO3 901AEROS