


FILED
 Date: 1/2/2003 By: J.P.
 This survey consists of:
 Map:
 Name:
 Corner Pkt:
 DOUGLAS COUNTY
 SURVEYOR

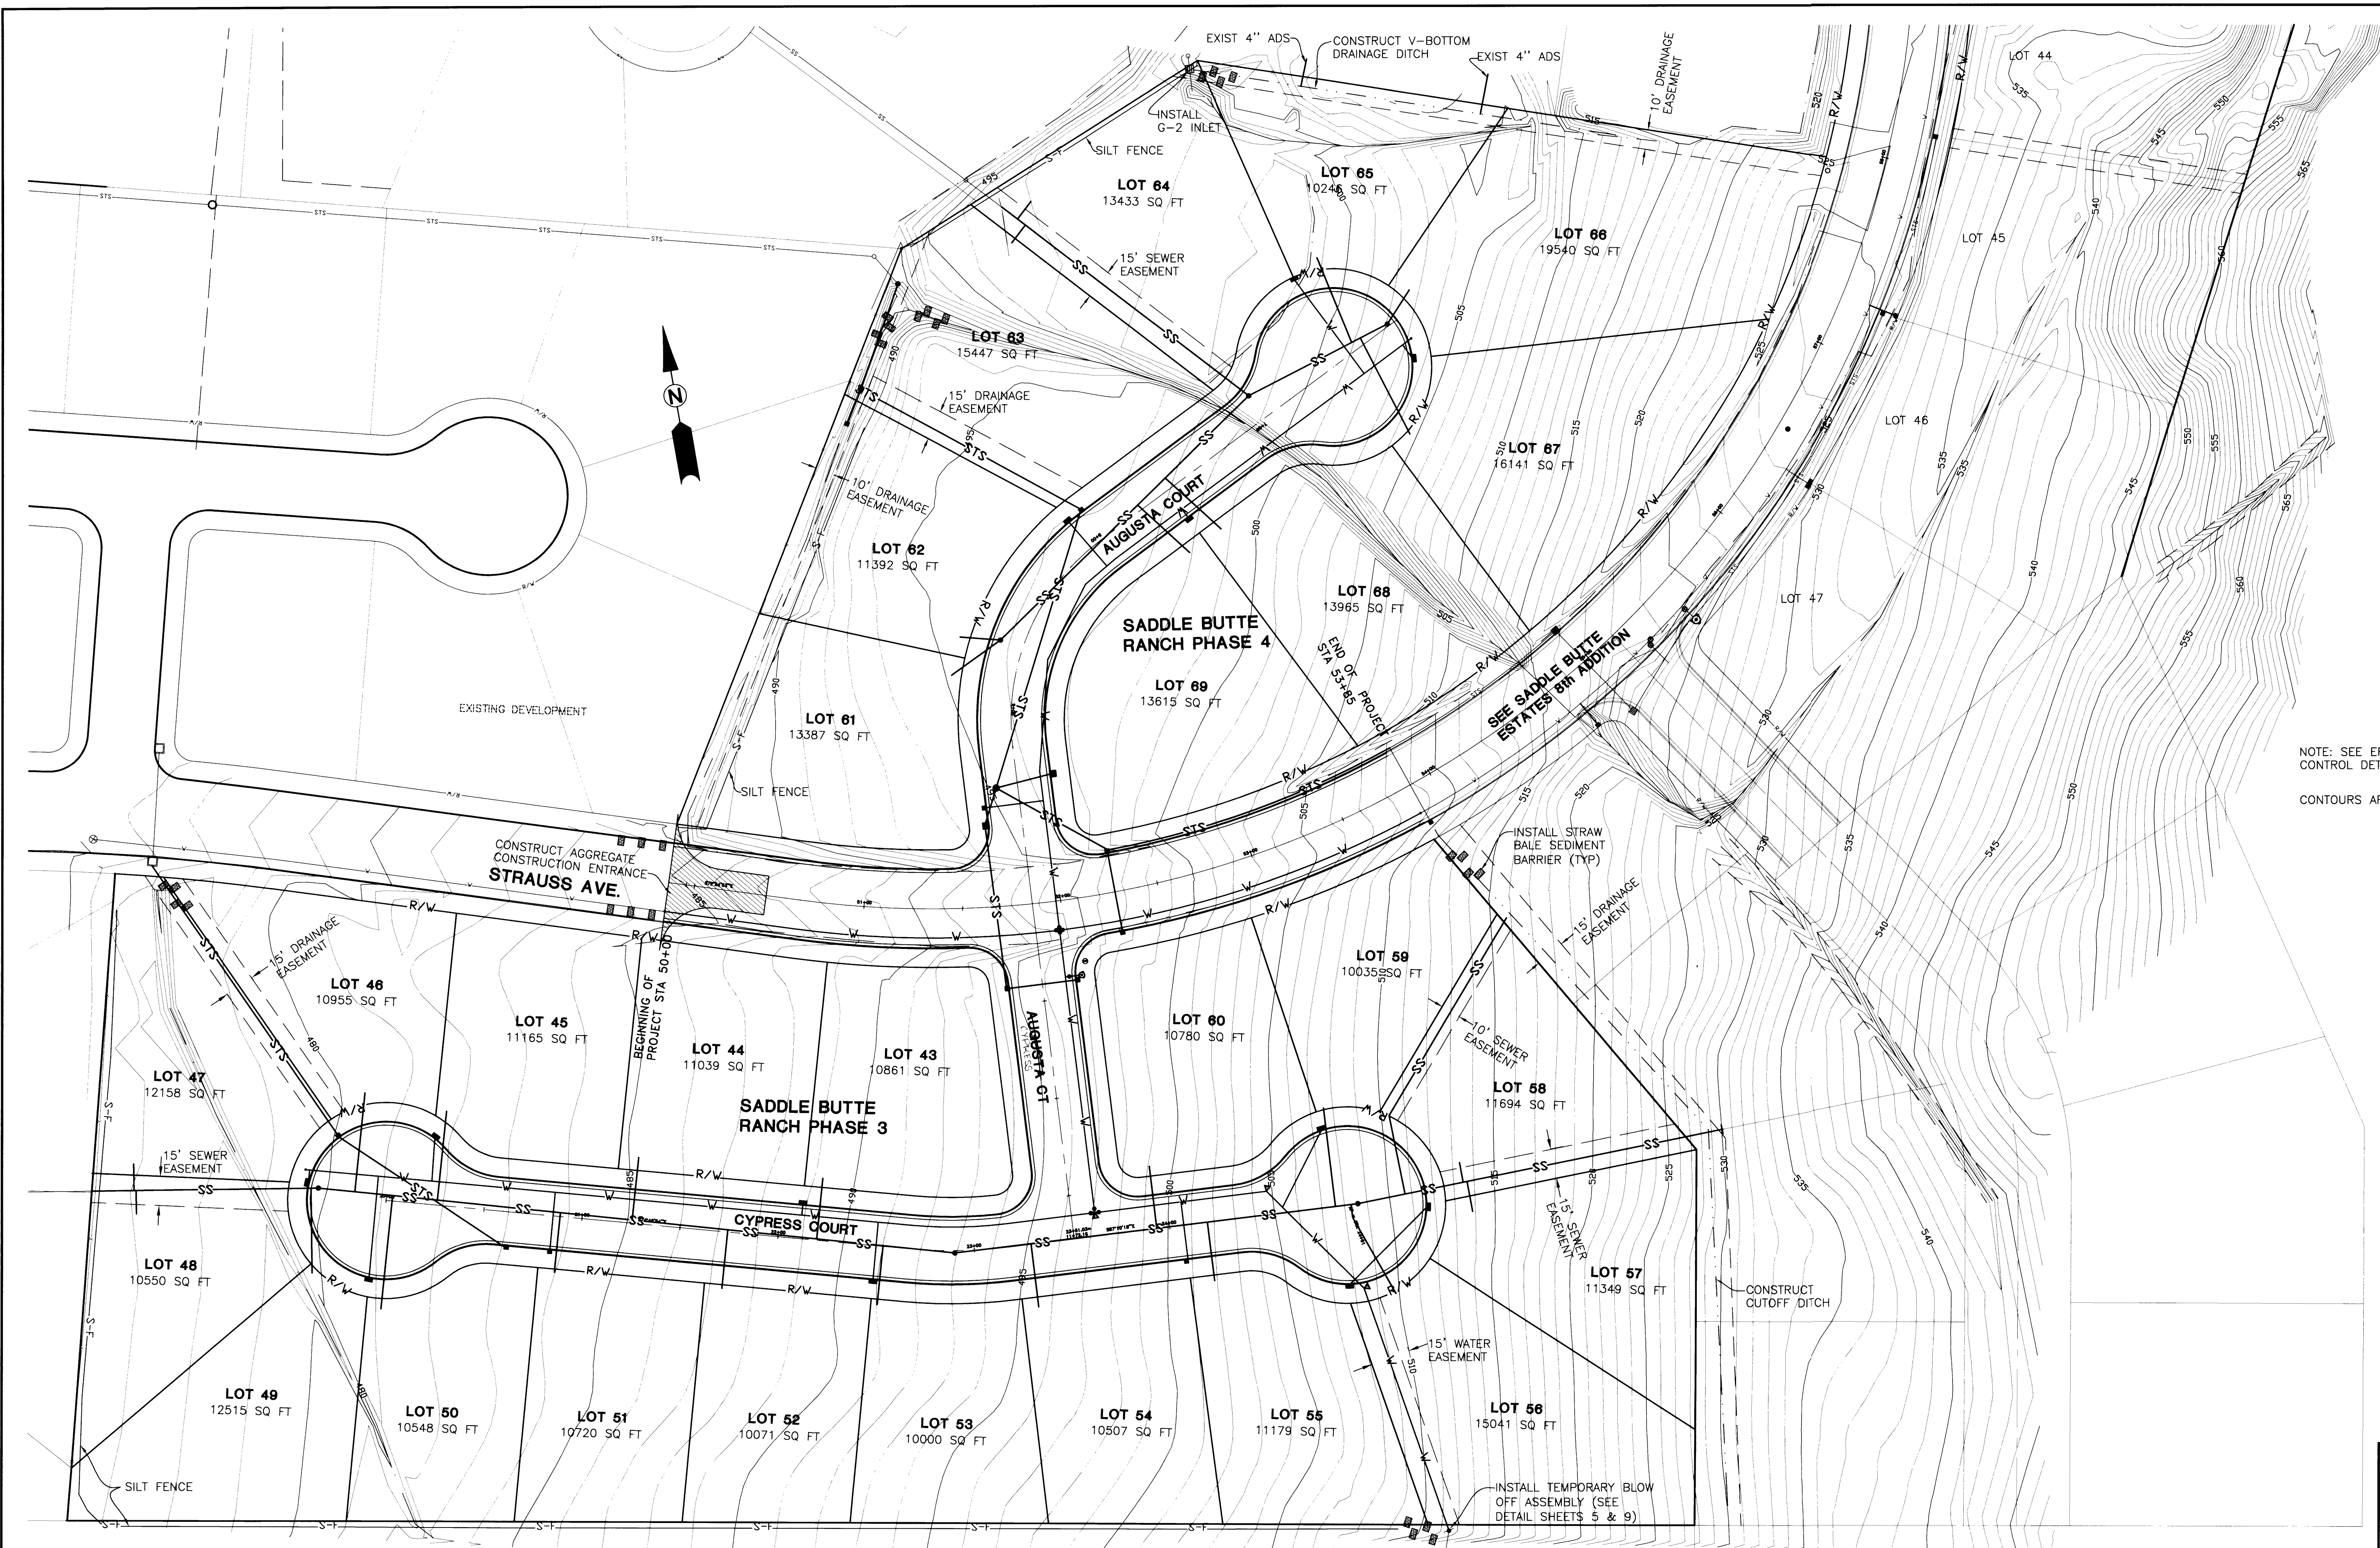

NOTE: SEE EROSION CONTROL DETAIL SHEET 10
 CONTOURS ARE OF ORIGINAL GROUND


CALL BEFORE YOU DIG I
 ONE CALL: (800) 332-2344
 OAR 952-001-0010 THROUGH
 OAR 952-001-0090

i.e.
 ENGINEERING
 741 SE Jackson Street
 Roseburg, Oregon 97470
 PHONE (541) 673-0166
 FAX (541) 440-9392

Project Name:
**PHASE 3 AND 4
 SADDLE BUTTE RANCH**

Title:
OVERALL AND EROSION CONTROL

DES DTB	PROJECT NO. 140-74
DWG BWC	DATE: NOVEMBER 19, 2001
CHK SNL	SCALE: 1"=40'
APP SNL	SHEET: 2 OF 10

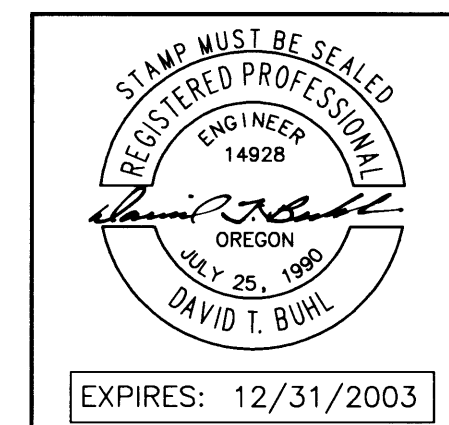

Rev.	Date	Dwg	Description
1	1/08/02	BWC	AGENCY REVIEWS
2	8/28/02	MLJ	AS-BUILTS PH. 3

Co. Rd. # 901A, # 901J & # 901K M.P. 0.00 - 0.12 DO NOT DUPLICATE
**CO. RD. # 901A, # 901J & # 901K
 OVERALL & EROSION CONTROL**

901J0000