



SCALE 1" = 20'

NOTE: SAW CUT ALONG EXISTING AC WHERE NEW PAVEMENT IS GOING TO MATCH IN.

NOTE: REMOVE CULVERTS UNDER EXISTING ACCESS DRIVEWAYS AND BACKFILL W/ APPROVED MATERIAL. GRADE DITCH ALONG NEW ROAD BED SO WATER CAN DRAIN TO CREEK.

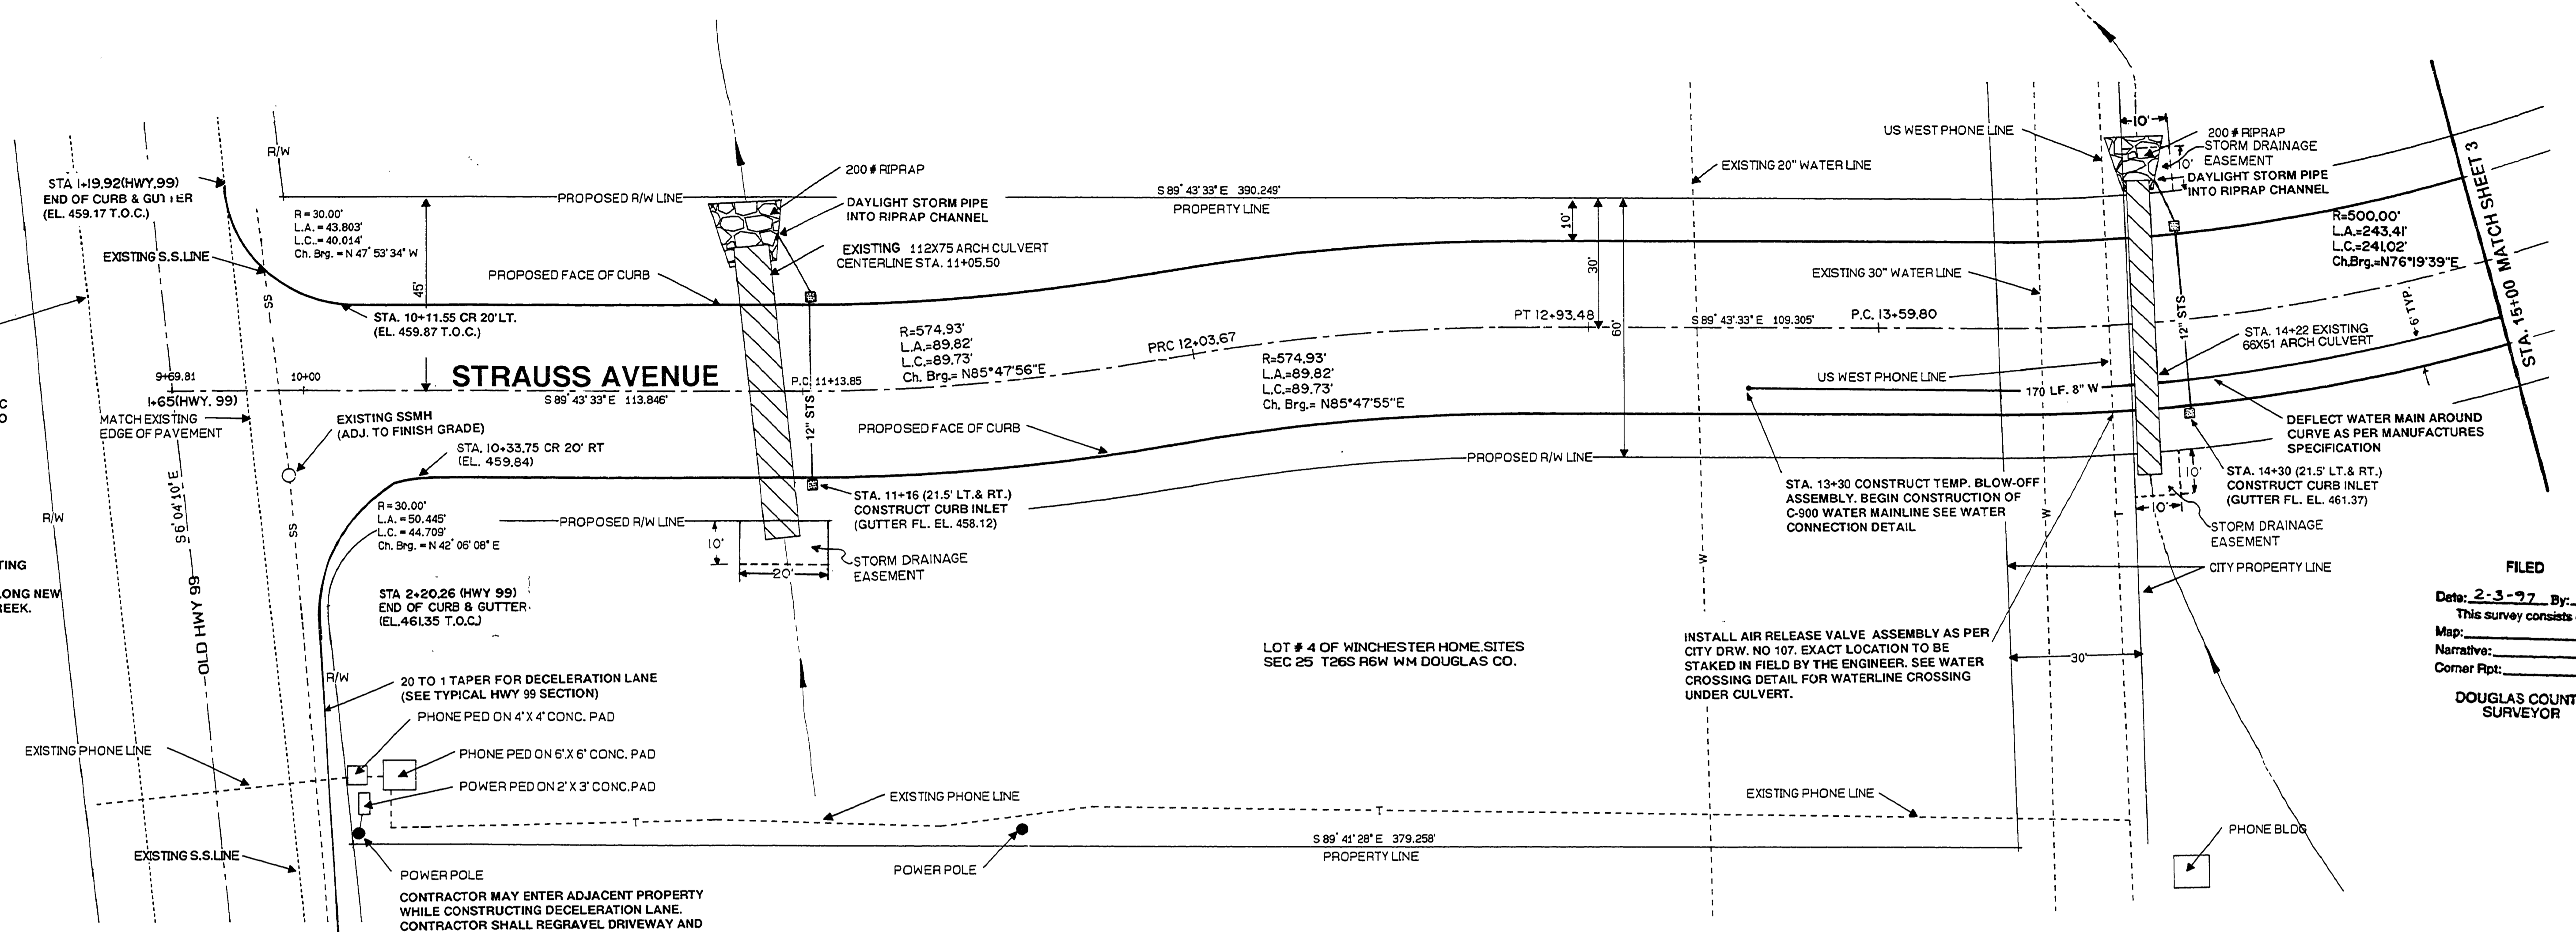

FILED  
 Date: 2-3-97 By: JP  
 This survey consists of:  
 Map:  
 Narrative:  
 Corner Rpt:  
 DOUGLAS COUNTY SURVEYOR

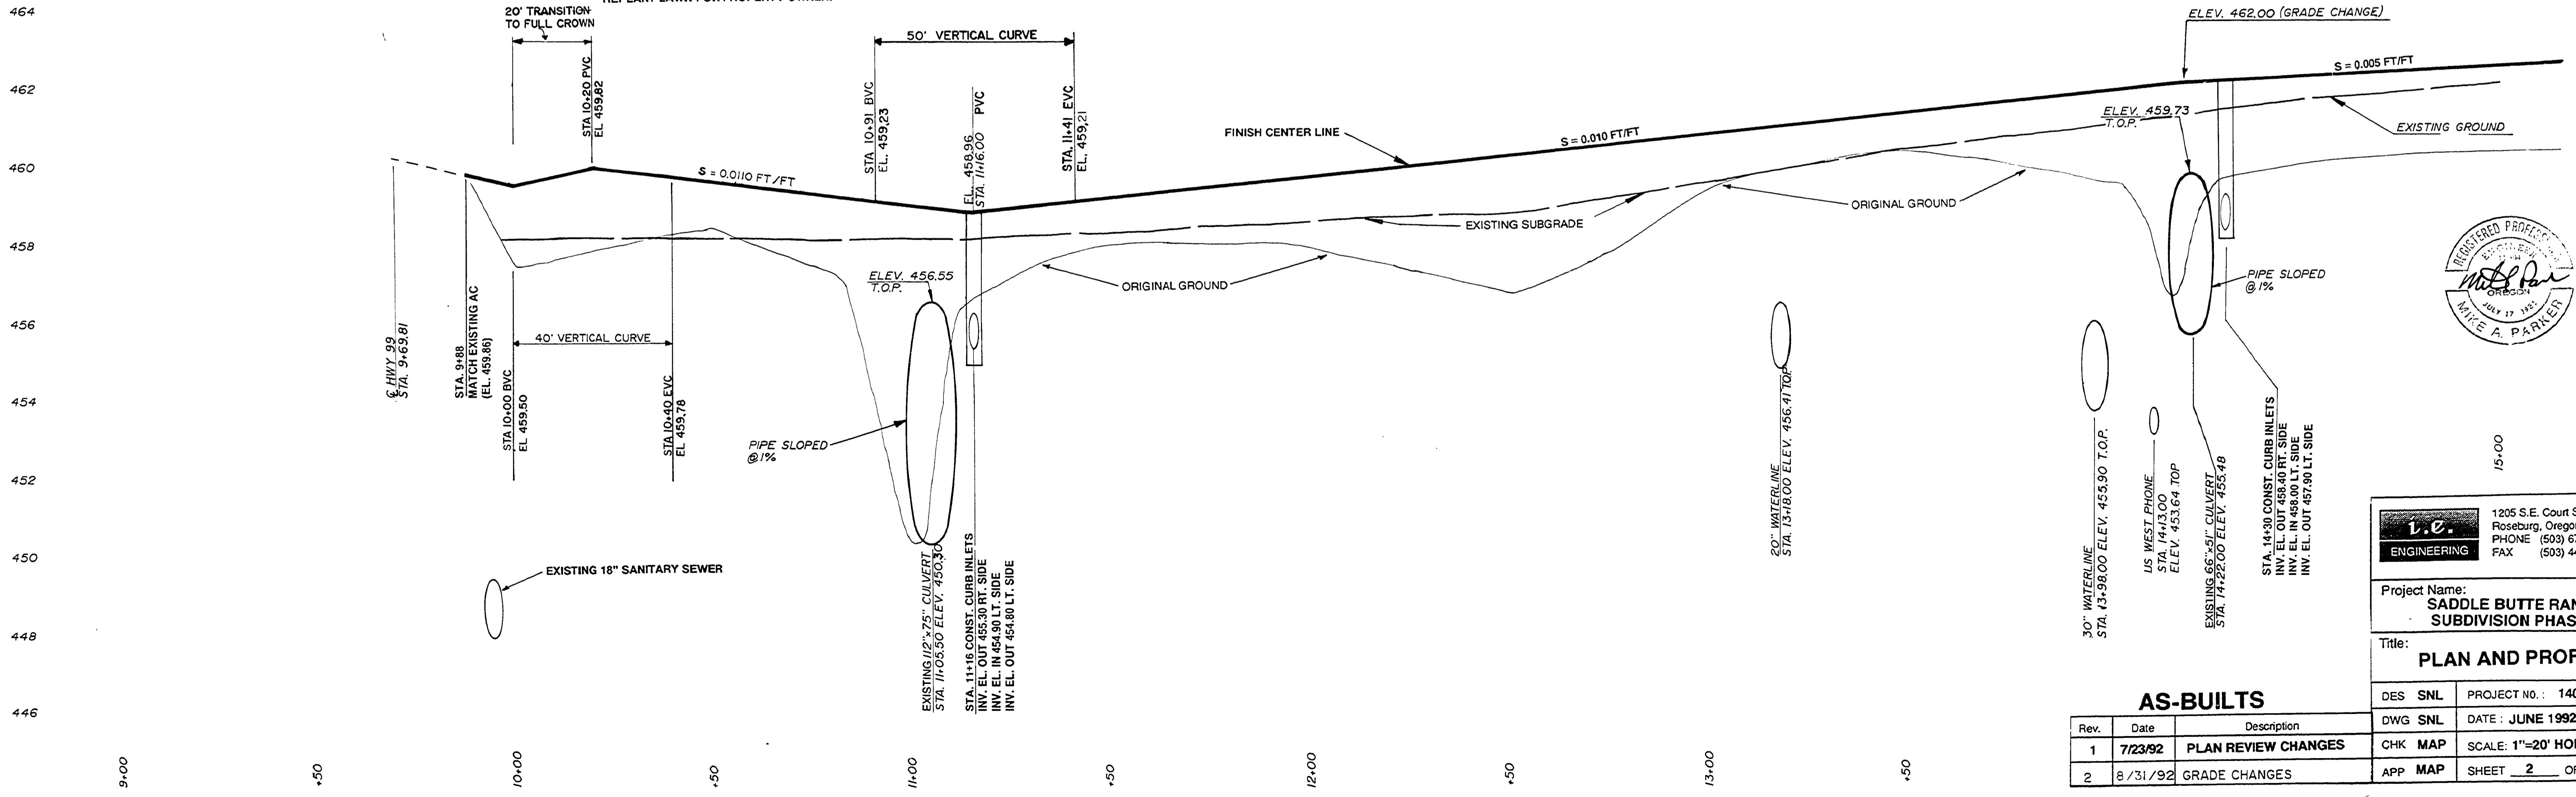

**i.e. ENGINEERING**  
 1205 S.E. Court Street  
 Roseburg, Oregon 97470  
 PHONE (503) 673-0166  
 FAX (503) 440-9392

Project Name:  
**SADDLE BUTTE RANCH  
 SUBDIVISION PHASE 1**

Title:  
**PLAN AND PROFILE**

DES	SNL	PROJECT NO. : 140 - 03
DWG	SNL	DATE : JUNE 1992
CHK	MAP	SCALE: 1"=20' HORZ. 1"=2' V
APP	MAP	SHEET 2 OF 6

**AS-BUILTS**

Rev.	Date	Description
1	7/23/92	PLAN REVIEW CHANGES
2	8/31/92	GRADE CHANGES

CO. RD. #901-A

RD901A01