
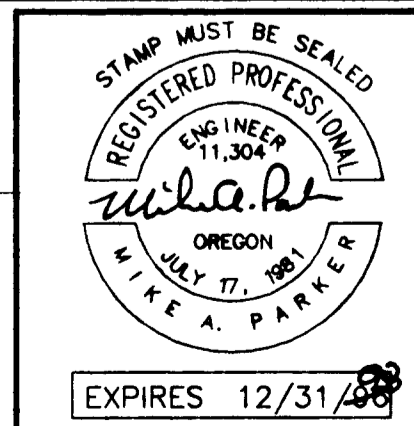
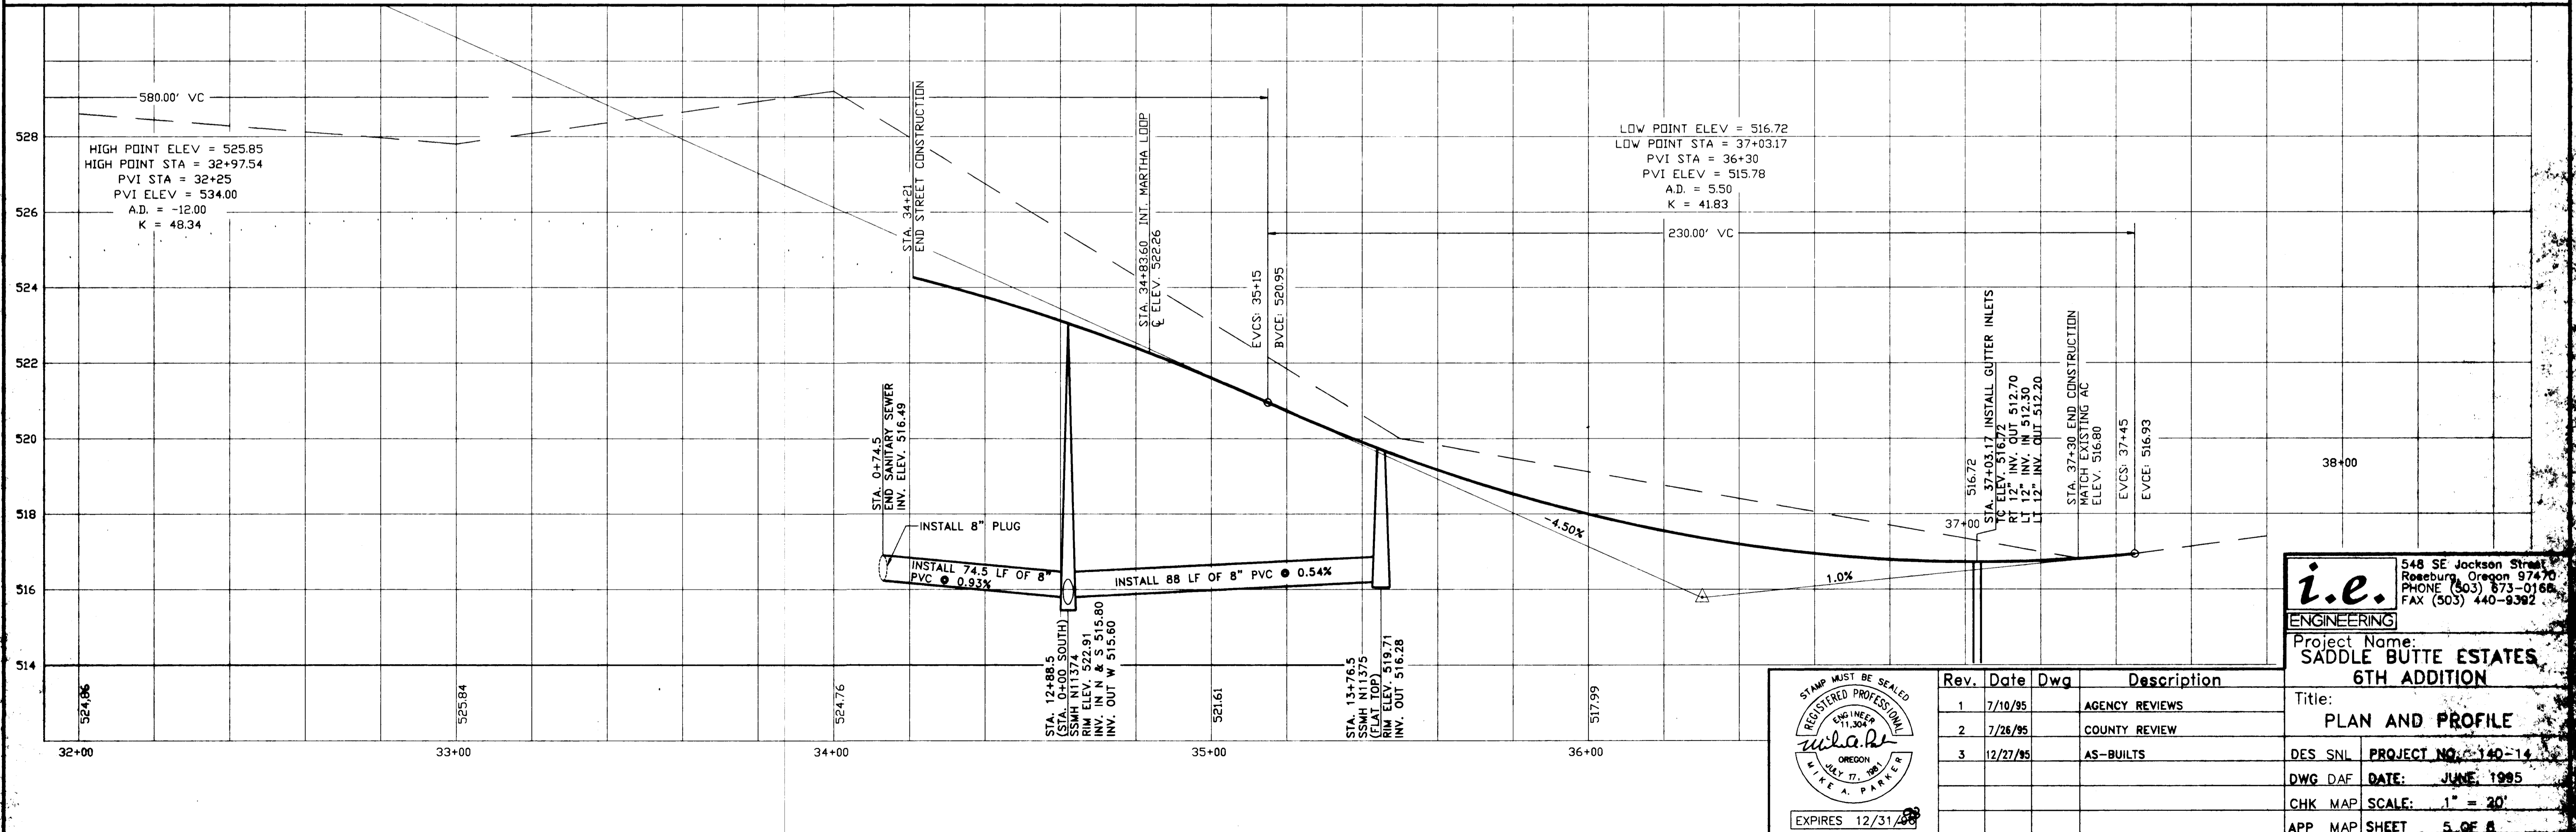


FILED
 Date: 8-24-1999 By: J.P.
 This survey consists of:
 Map:
 Narrative:
 Corner Rpt:
 DOUGLAS COUNTY
 SURVEYOR

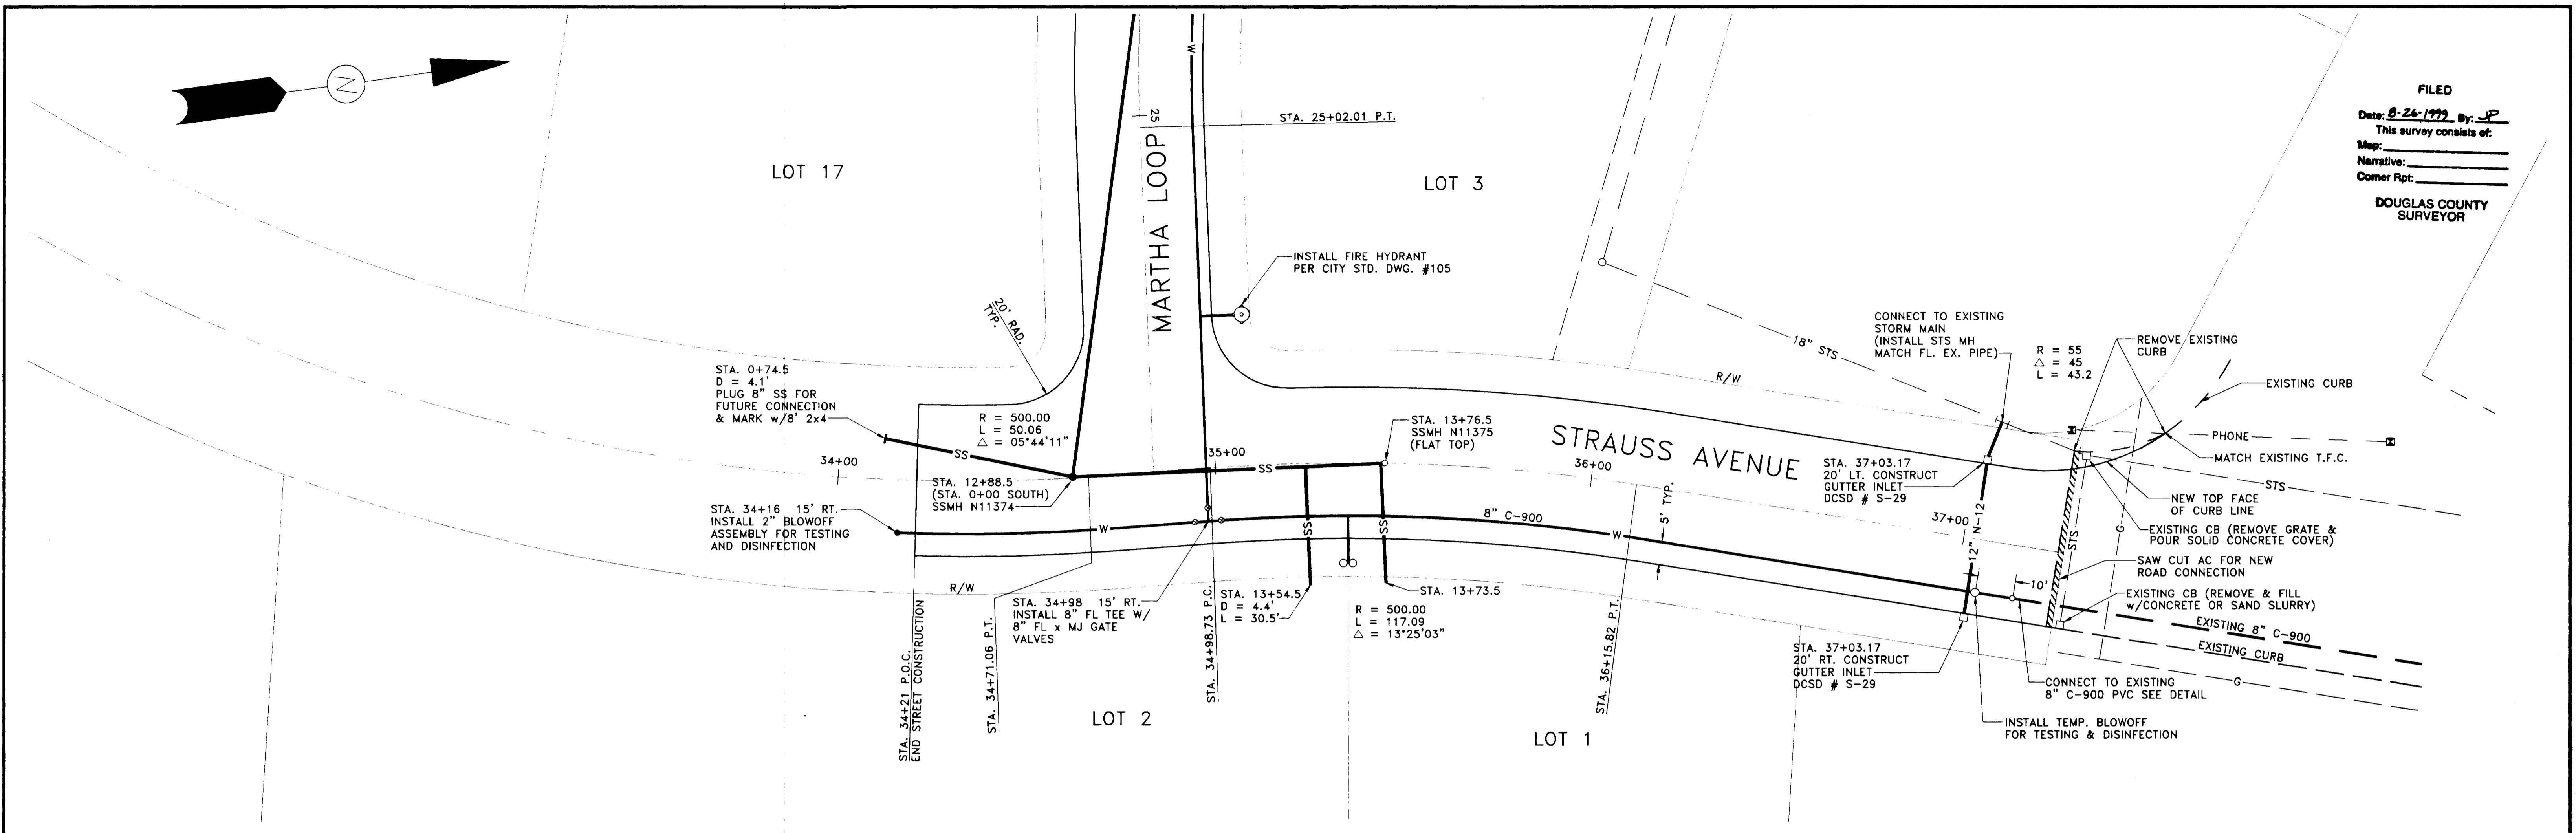

Rev.	Date	Dwg	Description
1	7/10/95		AGENCY REVIEWS
2	7/28/95		COUNTY REVIEW
3	12/27/95		AS-BUILTS

i.e. ENGINEERING
 548 SE Jackson Street
 Roseburg, Oregon 97470
 PHONE (503) 673-0168
 FAX (503) 440-9392

Project Name:
**SADDLE BUTTE ESTATES
 6TH ADDITION**

Title:
PLAN AND PROFILE

DES SNL PROJECT NO. 140-14
 DWG DAF DATE: JUNE, 1995
 CHK MAP SCALE: 1" = 30'
 APP MAP SHEET 5 OF 8

CO. PLAN 2010