
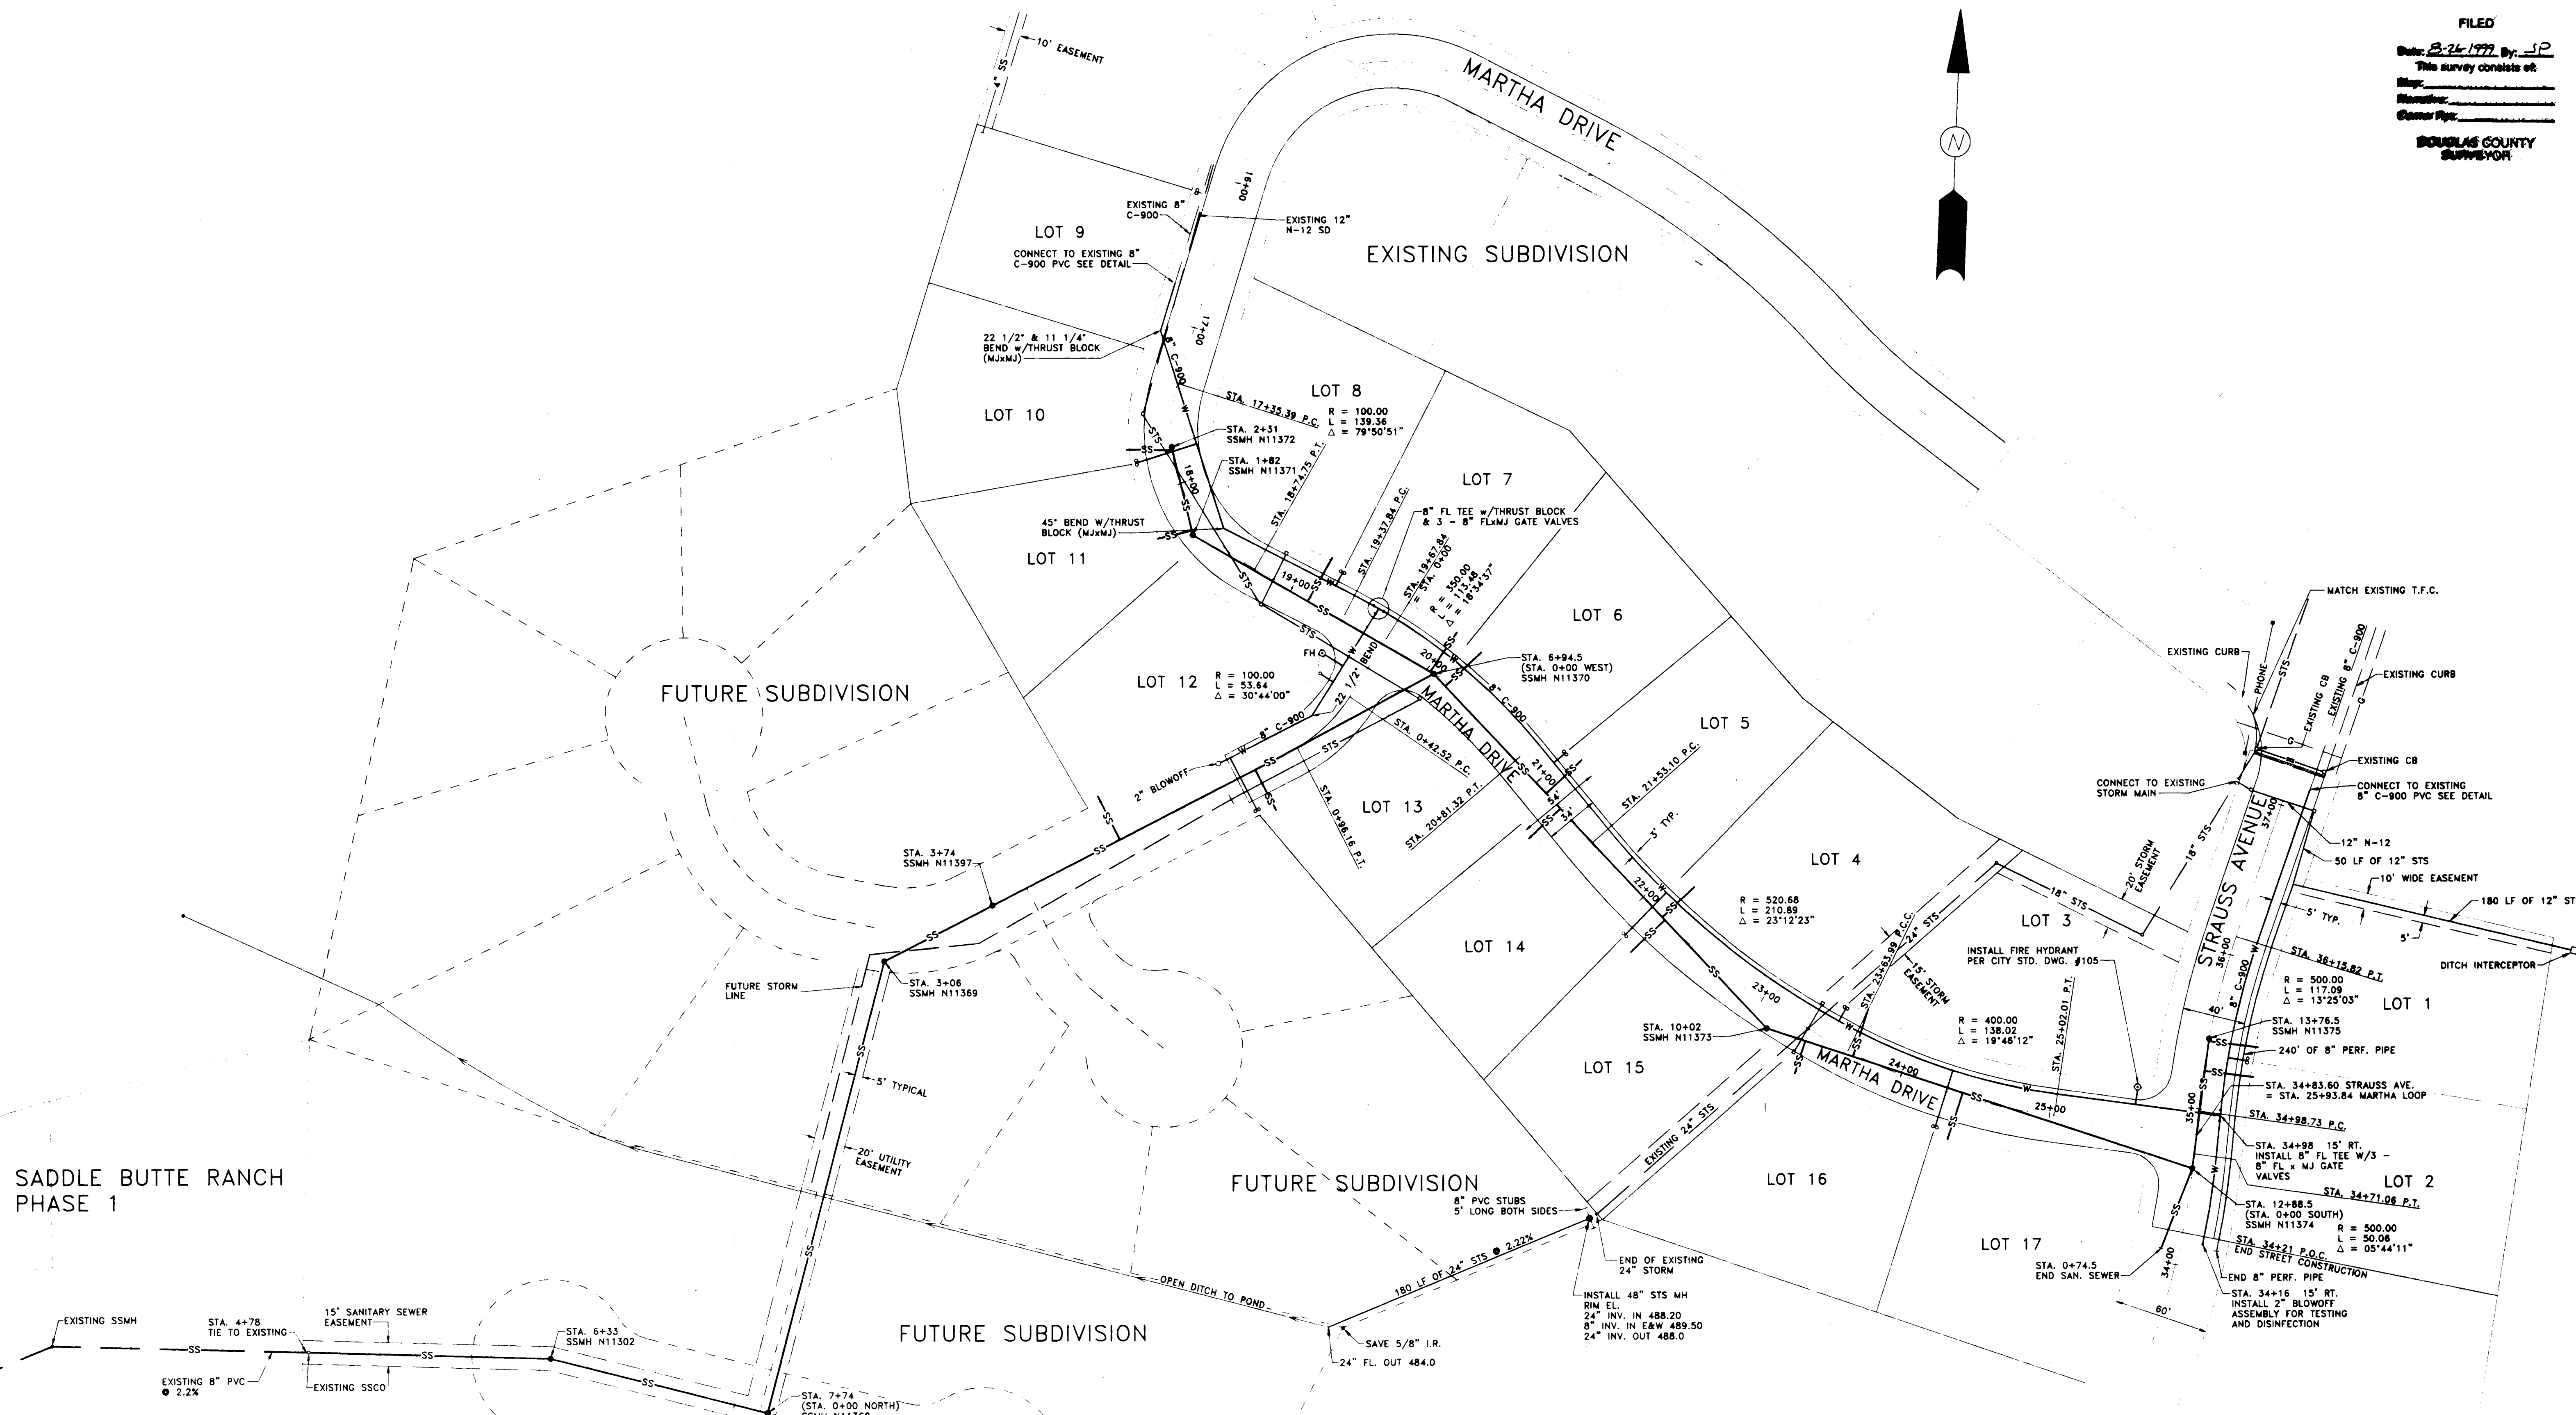



FILED  
 Date: 8-24-1999 By: J.P.  
 This survey consists of:  
 Map:  
 Name:  
 Corner Pts:  
 DOUGLAS COUNTY  
 SURVEYOR

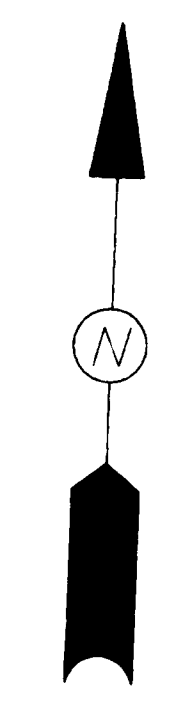

SADDLE BUTTE RANCH  
 PHASE 1

**i.e.**  
 ENGINEERING  
 548 SE Jackson Street  
 Roseburg, Oregon 97470  
 PHONE (503) 673-0166  
 FAX (503) 440-9392

Project Name:  
**SADDLE BUTTE ESTATES  
 6TH ADDITION**  
 Title:  
**OVERALL PLAN**  
 DES SNL PROJECT NO. 140-14  
 DWG DAF DATE: JUNE, 1995  
 CHK MAP SCALE: 1" = 50'  
 APP MAP SHEET 2 OF 8

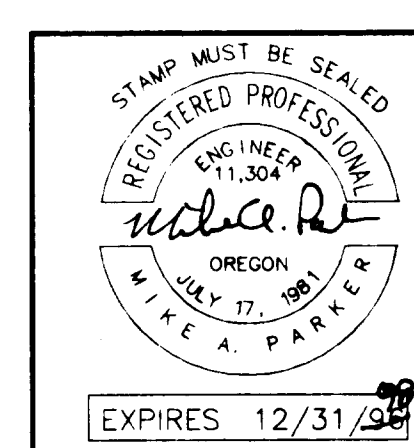

Rev.	Date	Dwg	Description
1	7/10/95	DAF	AGENCY REVIEWS
2	7/18/95	DAF	WATER DEPT. FINAL REVIEW
3	7/26/95	DAF	COUNTY REVIEW
4	12/27/95	DAF	AS-BUILTS

RD91C  
 CO. RD. # 901 C #  
 901 A

901A901C