
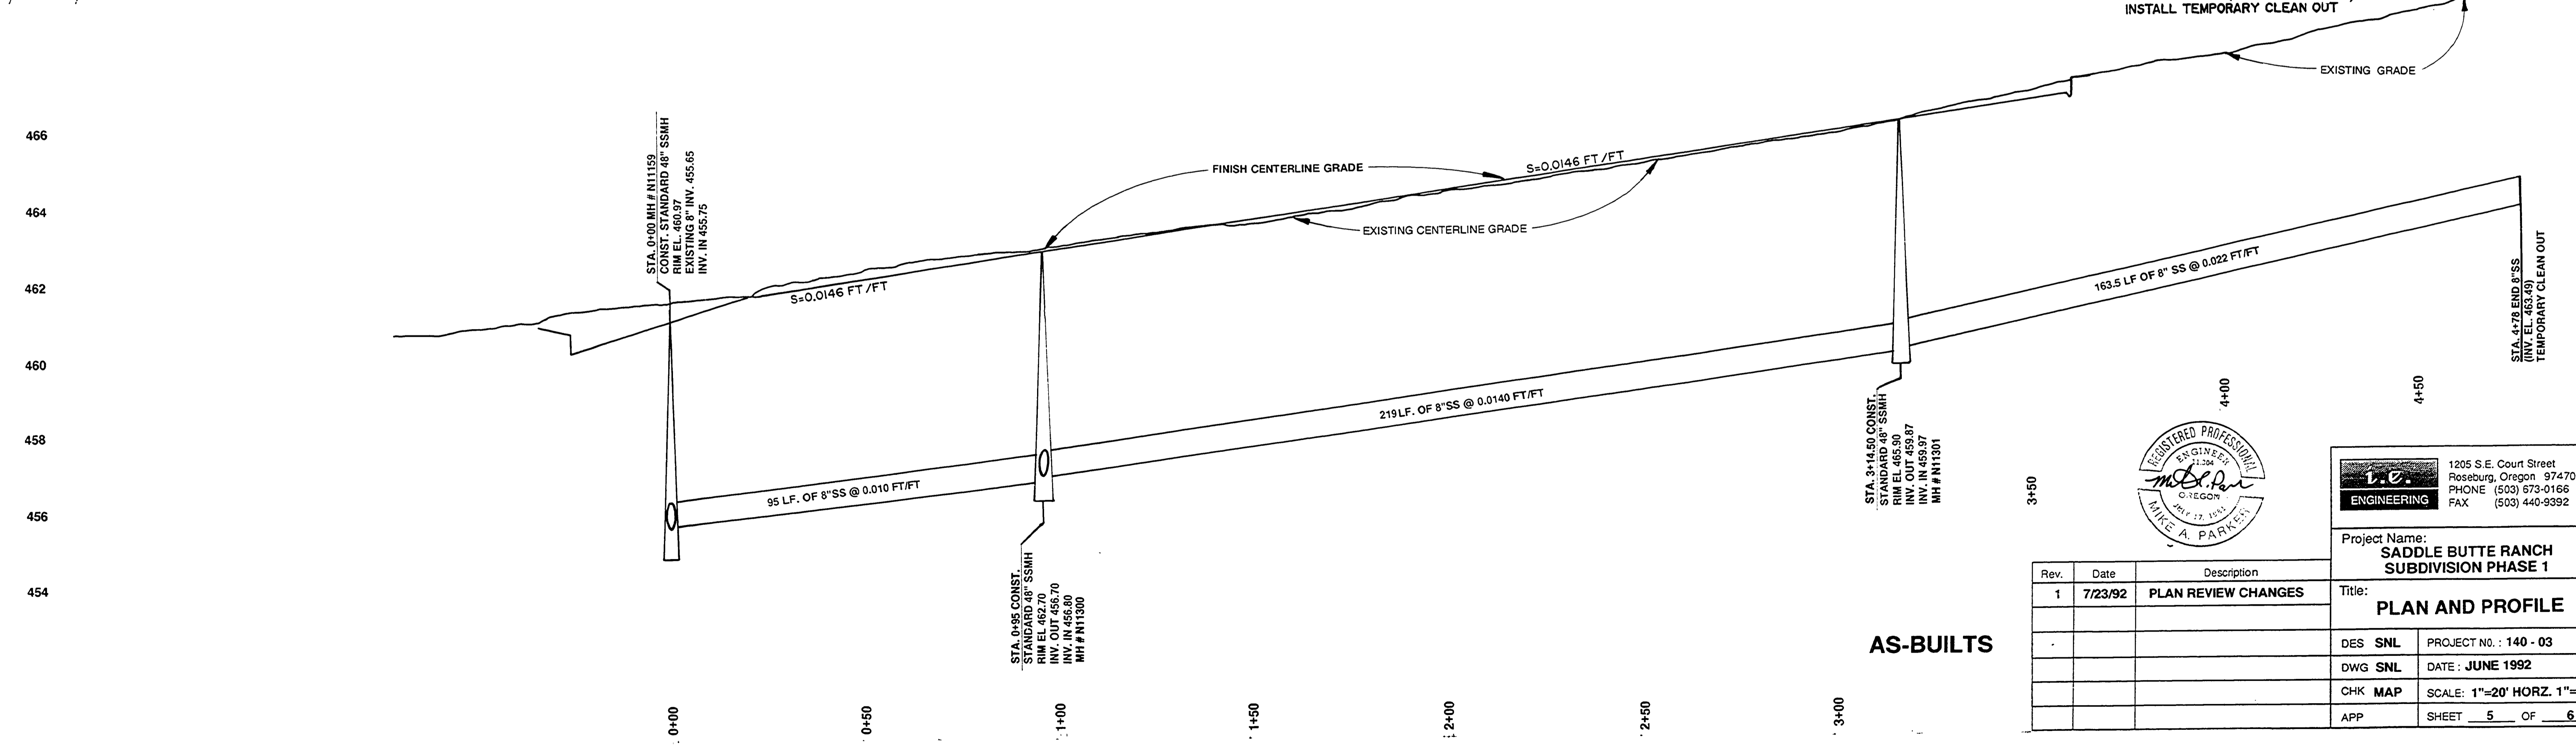


FILED  
 Date: 2-3-97 By: J.P.  
 This survey consists of:  
 Map:  
 Narrative:  
 Corner Rpt:  
 DOUGLAS COUNTY  
 SURVEYOR

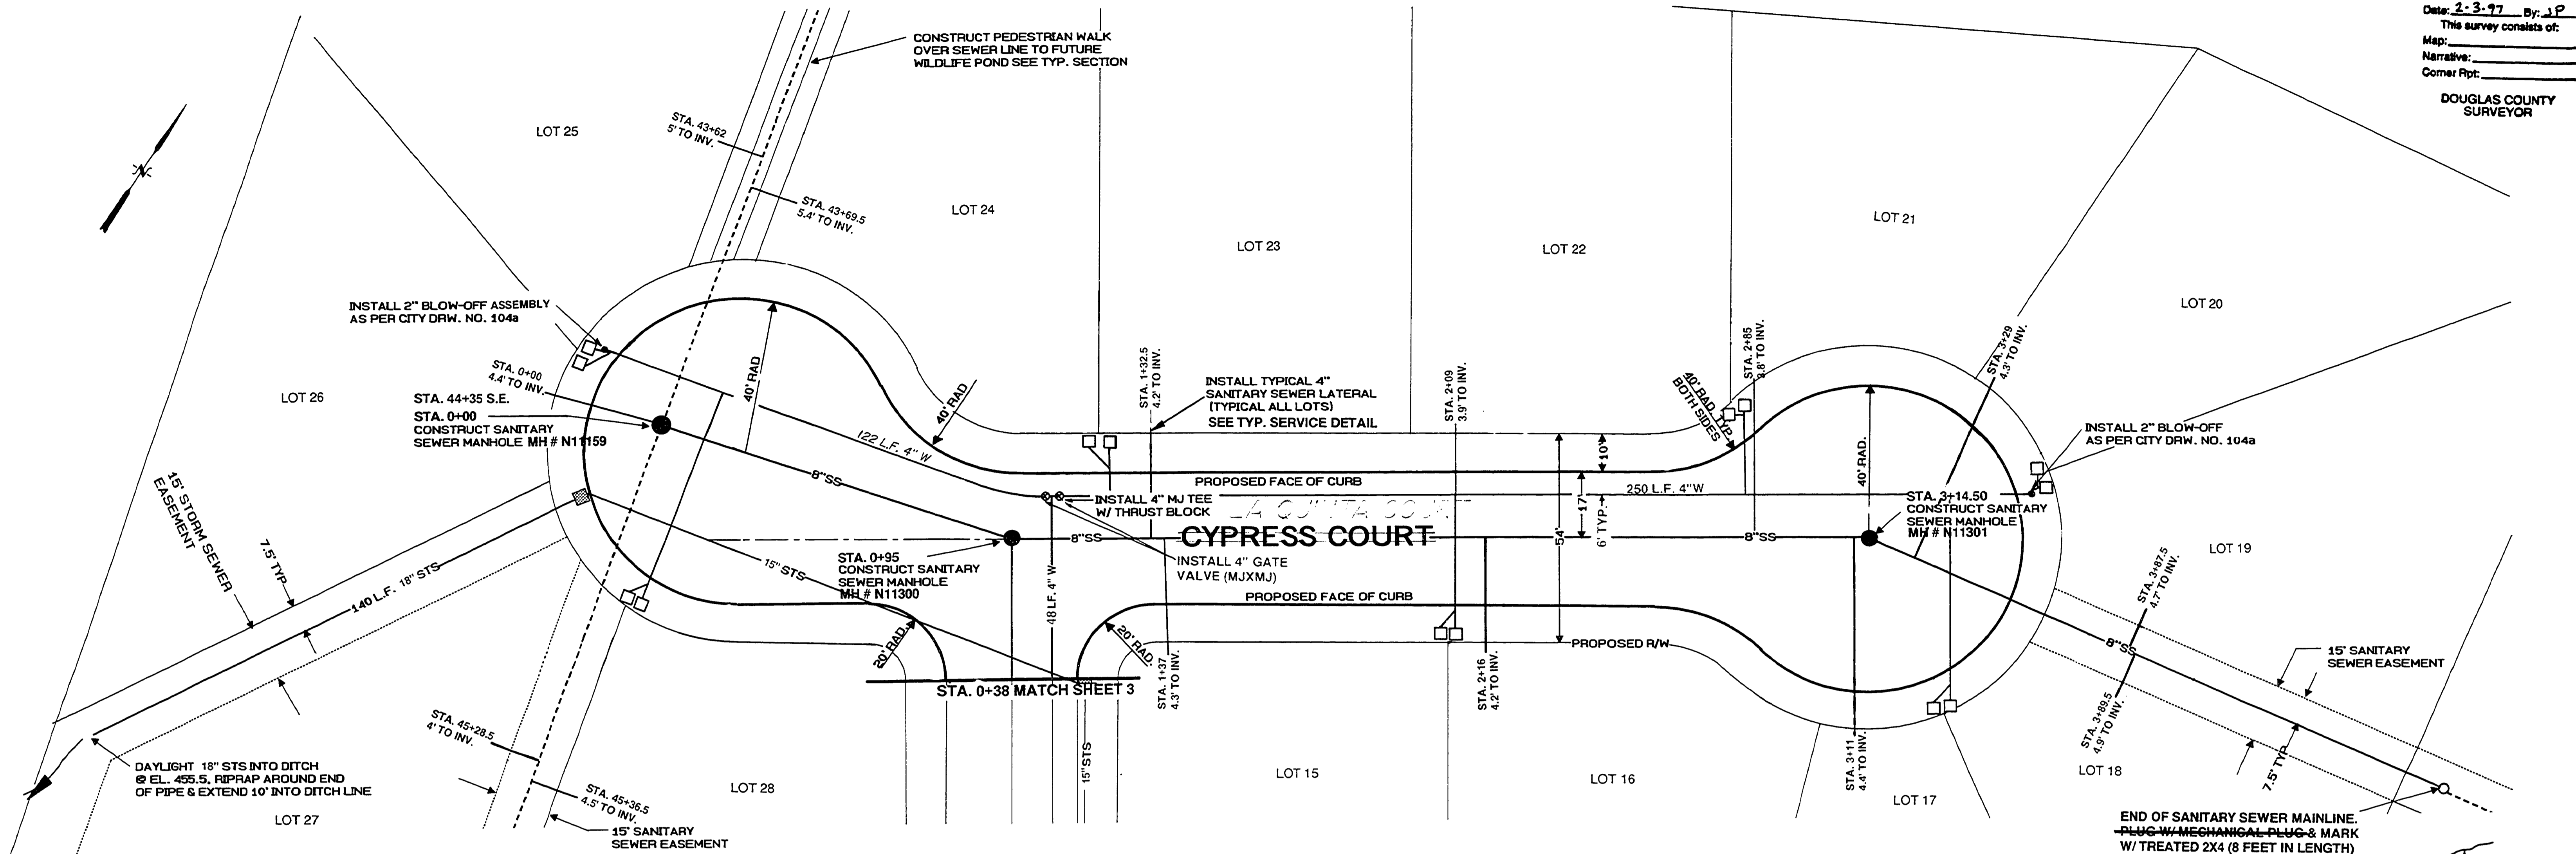

**L.E. ENGINEERING**  
 1205 S.E. Court Street  
 Roseburg, Oregon 97470  
 PHONE (503) 673-0166  
 FAX (503) 440-9392

Rev.	Date	Description
1	7/23/92	PLAN REVIEW CHANGES

Project Name: SADDLE BUTTE RANCH SUBDIVISION PHASE 1  
 Title: **PLAN AND PROFILE**  
 DES SNL PROJECT NO.: 140-03  
 DWG SNL DATE: JUNE 1992  
 CHK MAP SCALE: 1"=20' HORZ. 1"=2' V  
 APP SHEET 5 OF 6

AS-BUILTS

CO. RD. #901-D

5

RD901D00