
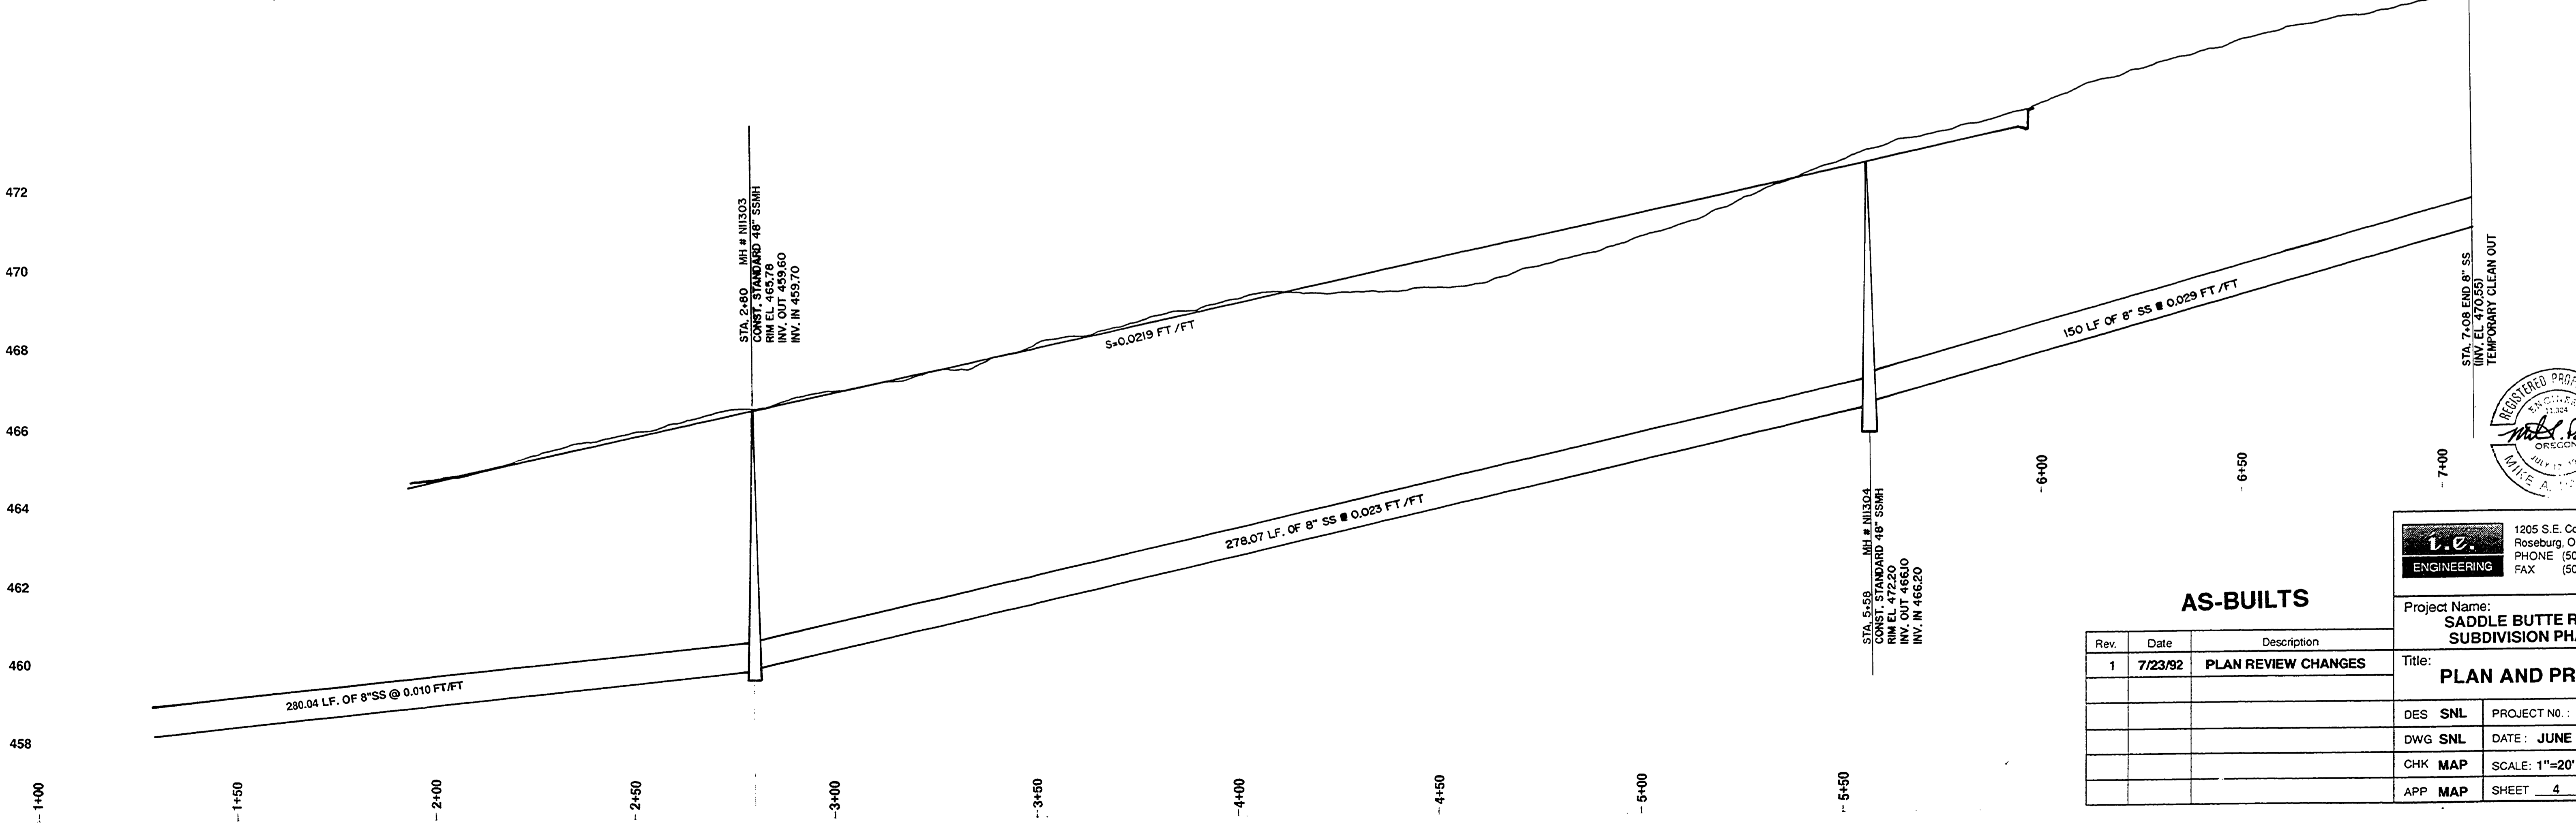


FILED
 Date: 2-3-92 By: J.P.
 This survey consists of:
 Map:
 Narrative:
 Corner Rpt:
 DOUGLAS COUNTY
 SURVEYOR

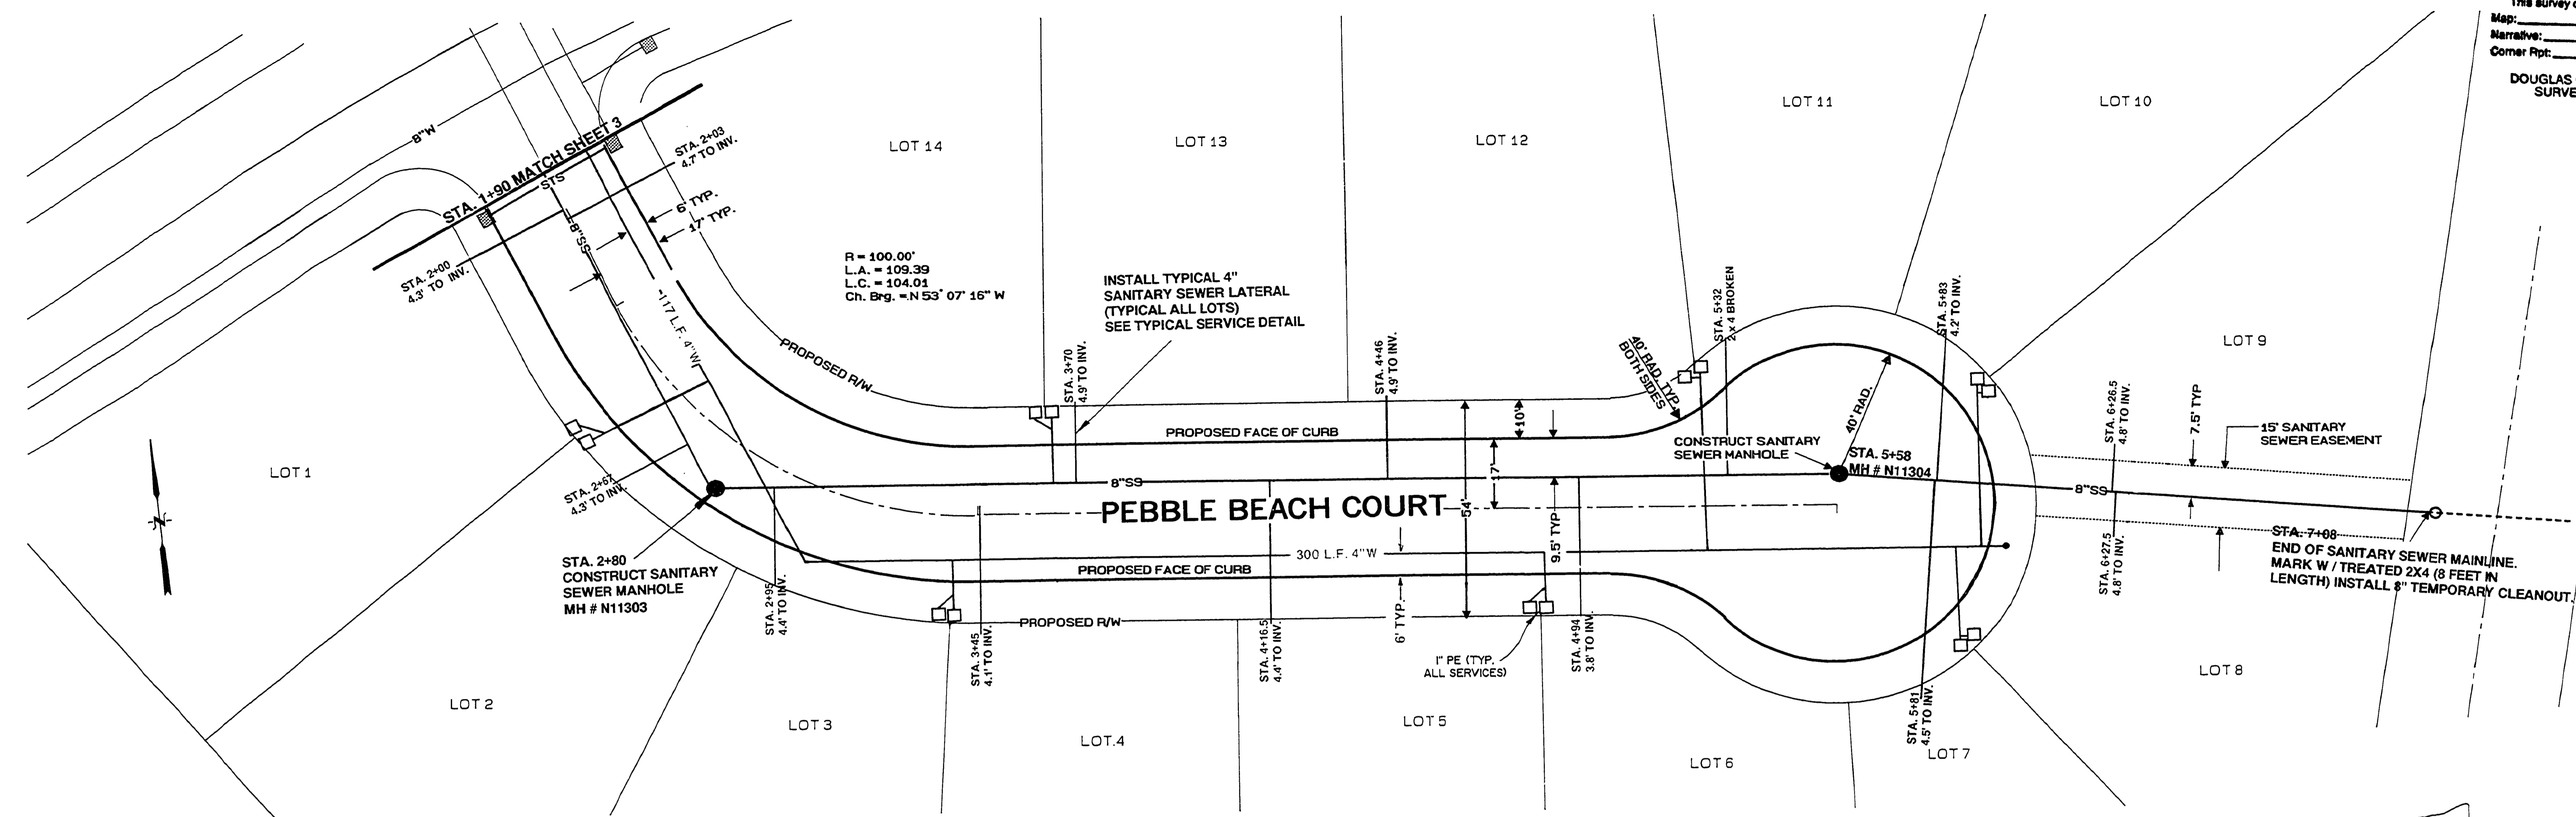

AS-BUILTS			Project Name: SADDLE BUTTE RANCH SUBDIVISION PHASE 1	
Rev.	Date	Description	Title: PLAN AND PROFILE	
1	7/23/92	PLAN REVIEW CHANGES	DES	SNL PROJECT NO.: 140 - 03
			DWG	SNL DATE: JUNE 1992
			CHK	MAP SCALE: 1"=20' HORZ. 1"=2' V
			APP	MAP SHEET 4 OF 6

CO. RD. #901-E

RD901E00

