



FILED
 Date: 5/15/2002 By: JP
 This survey consists of:
 Map:
 Narrative:
 Corner Rpt:
 DOUGLAS COUNTY SURVEYOR



SURVEYING SERVICE, INC.
 3076 NE DIAMOND LAKE BLVD.
 ROSEBURG, OREGON 97470
 TEL (541)672-2096
 FAX (541)672-0611

Revision	12/96
Date	
Revision	
Date	

Drawn	RDM
Design	
Checked	
Reviewed	

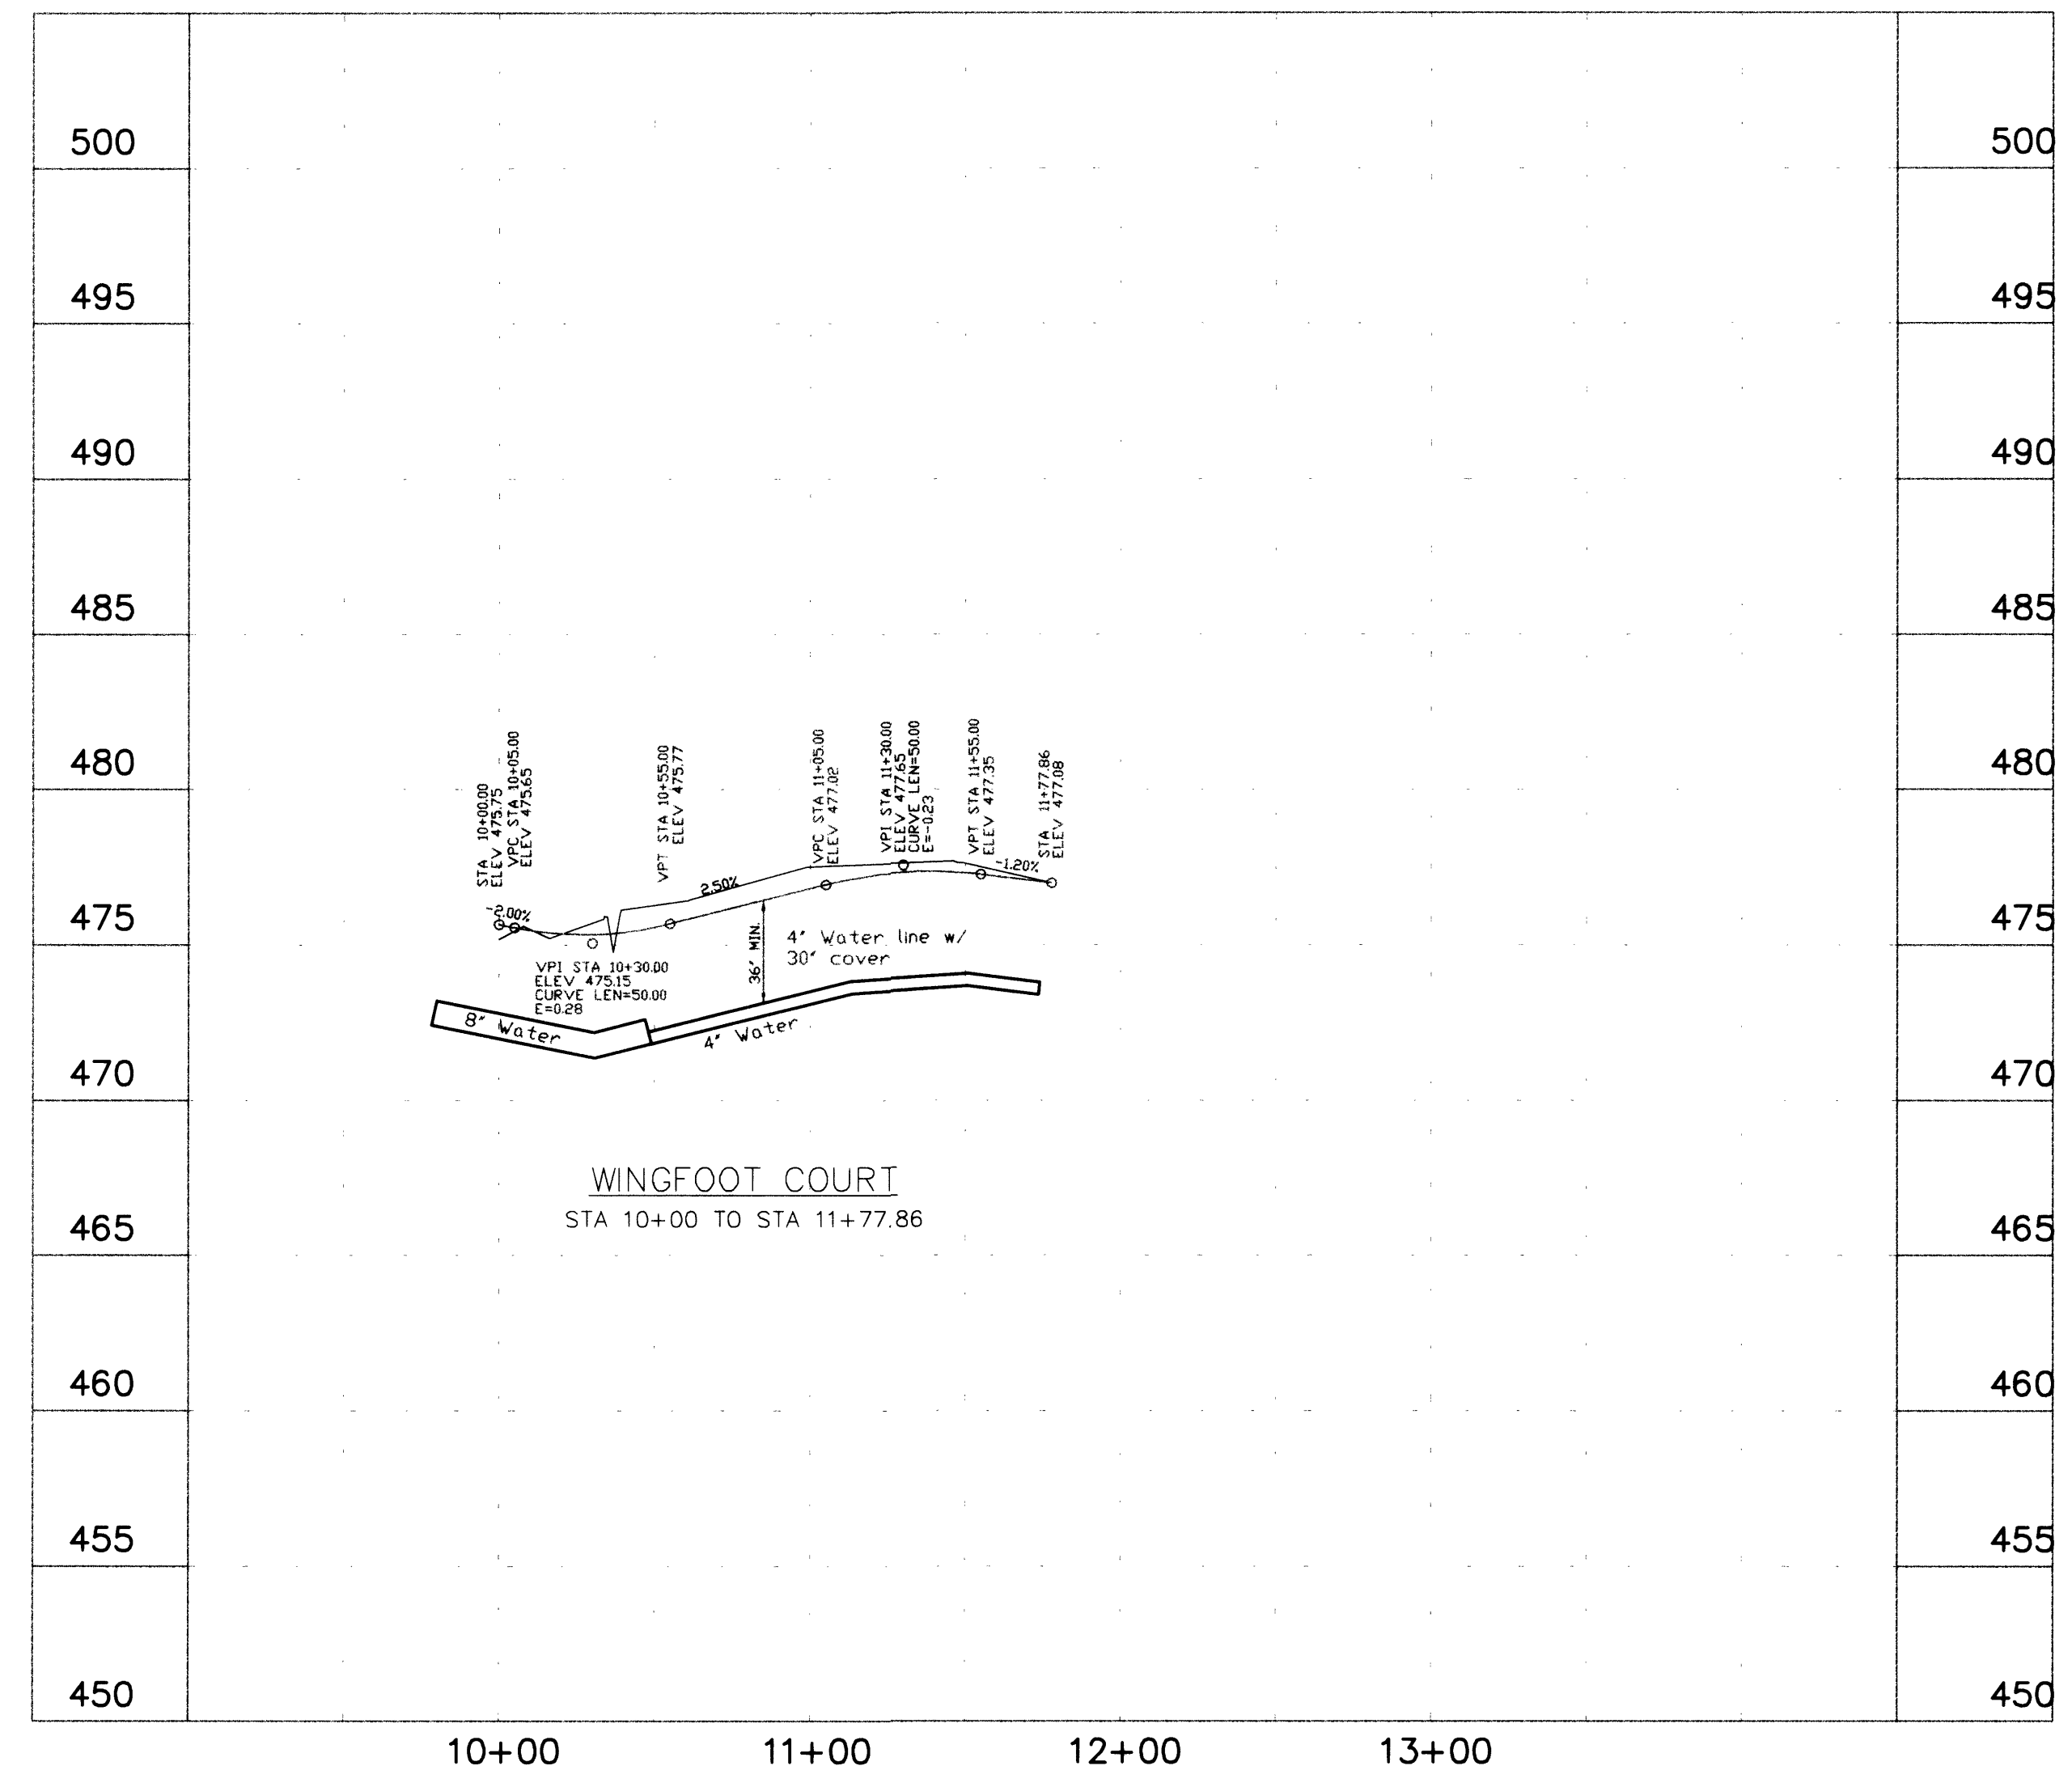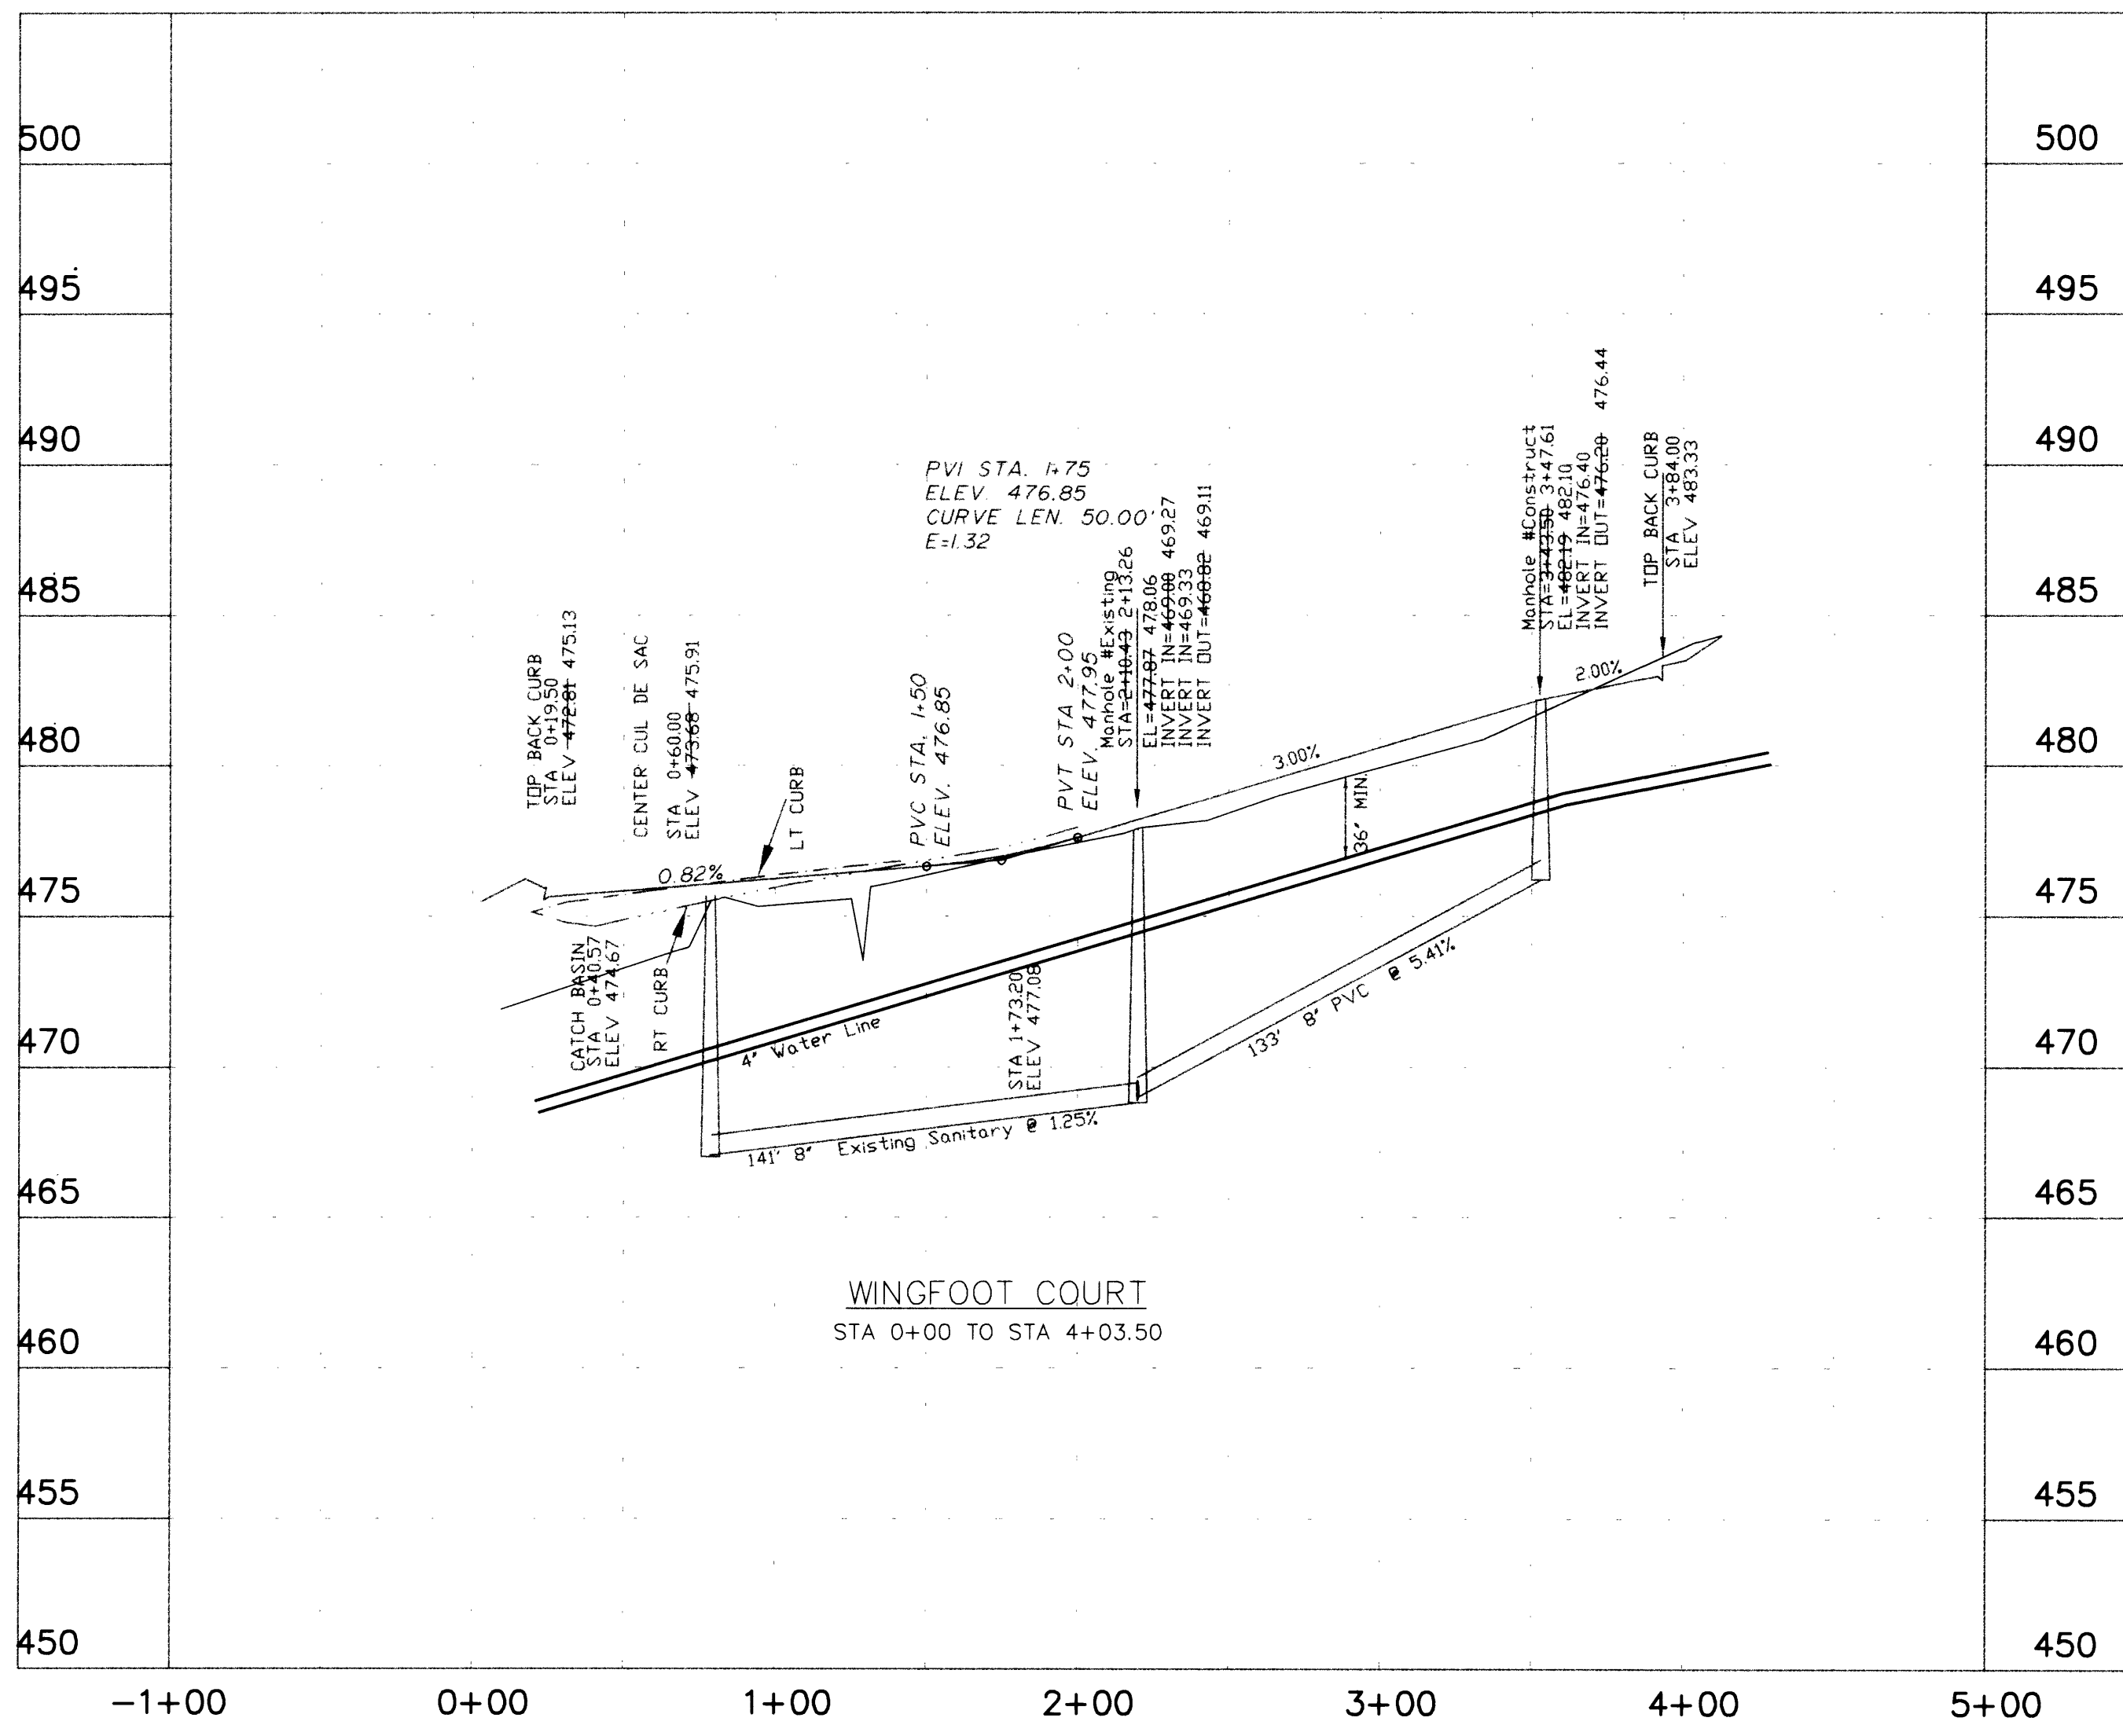

TITLE: **PLAN AND PROFILE**
WINGFOOT COURT
 PROJECT NAME:
SADDLE BUTTE RANCH PHASE II
AS-BUILTS

SHT.	4
OF	7

1822-962 V822-964.DWG

R901GPRO