


FILED
 Date: 8-27-1999
 This survey consists of:
 Map:
 Narrative:
 Corner Ppt:
 DOUGLAS COUNTY
 SURVEYOR

CALL BEFORE YOU DIG I
 ONE CALL (800) 332-2344
 ORS 757.541 TO 757.571

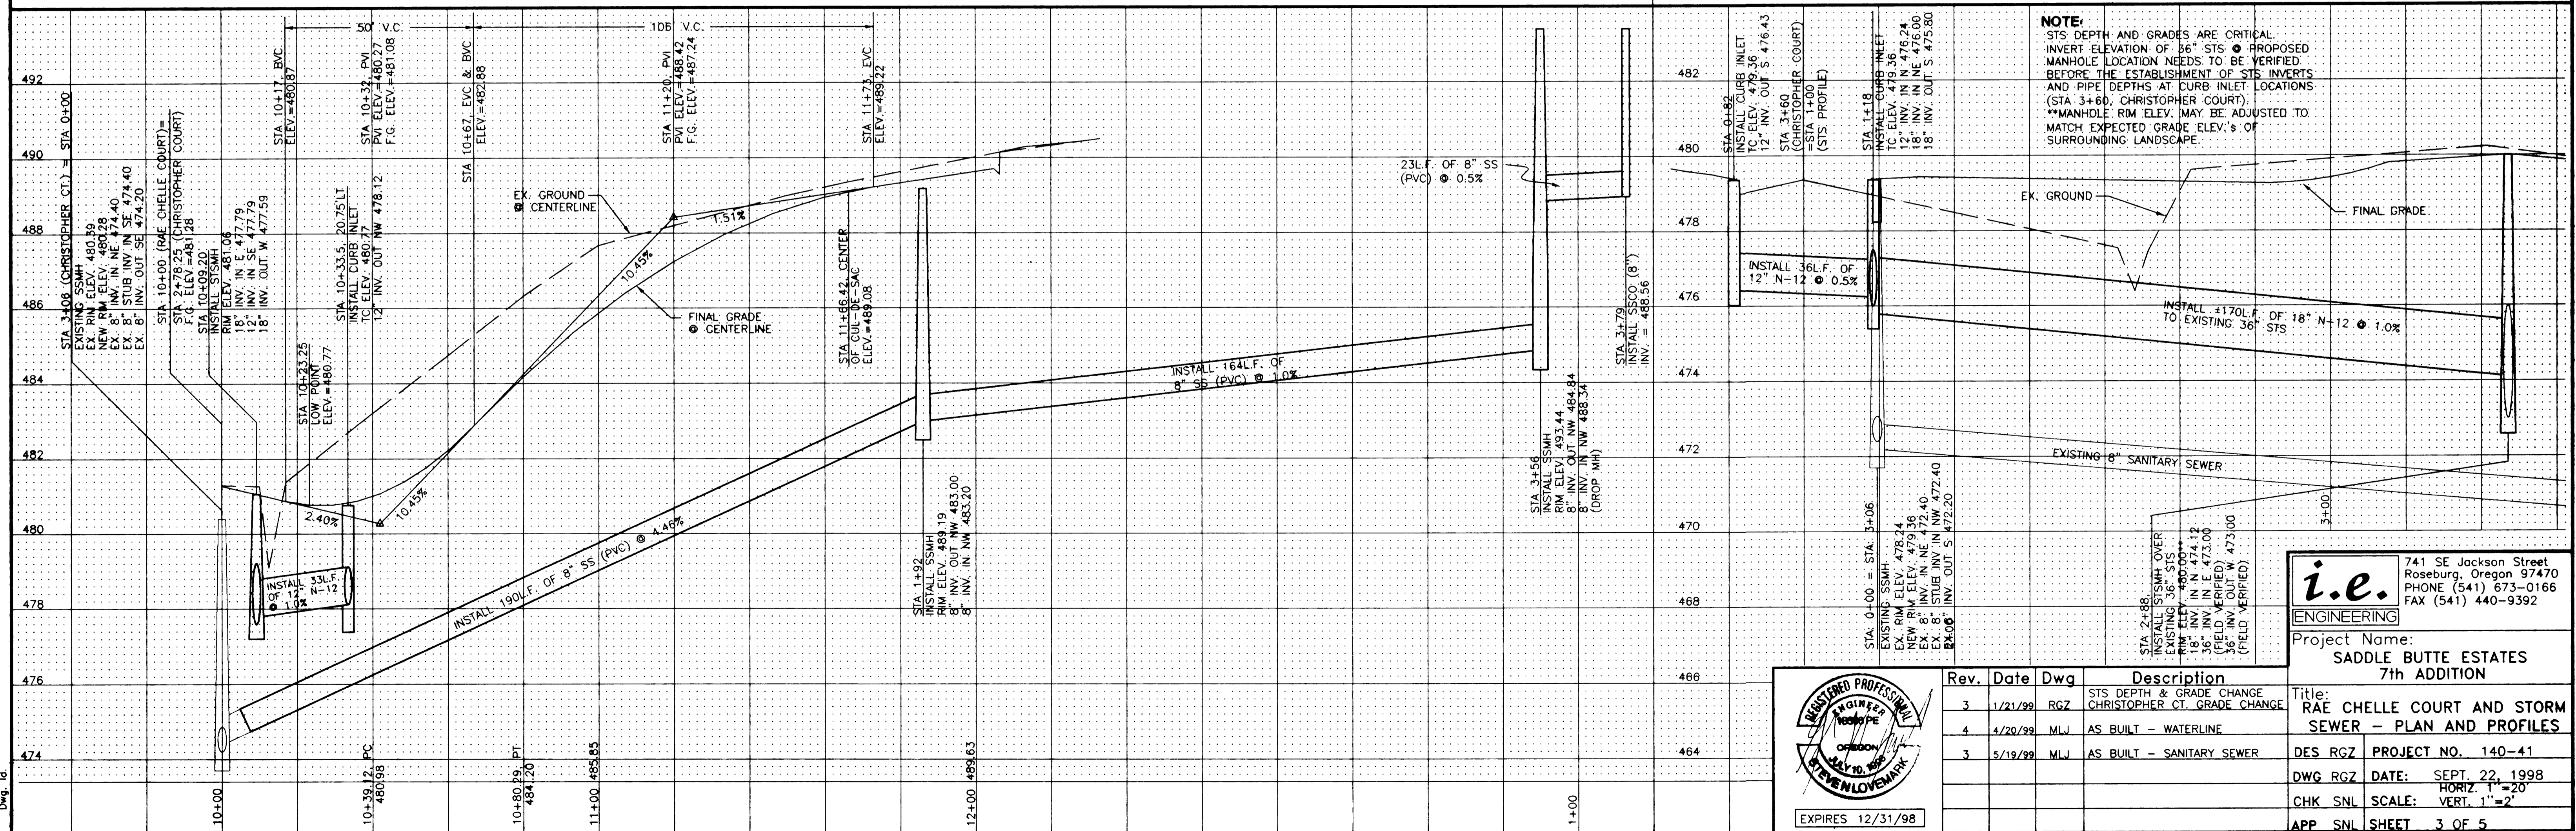


NOTE:
 STS DEPTH AND GRADES ARE CRITICAL.
 INVERT ELEVATION OF 36\"/>

i.e.
 ENGINEERING
 741 SE Jackson Street
 Roseburg, Oregon 97470
 PHONE (541) 673-0166
 FAX (541) 440-9392

Project Name:
 SADDLE BUTTE ESTATES
 7th ADDITION

Title:
 RAE CHELLE COURT AND STORM
 SEWER - PLAN AND PROFILES

DES RGZ PROJECT NO. 140-41
 DWG RGZ DATE: SEPT. 22, 1998
 CHK SNL SCALE: VERT. 1"=20'
 APP SNL SHEET 3 OF 5

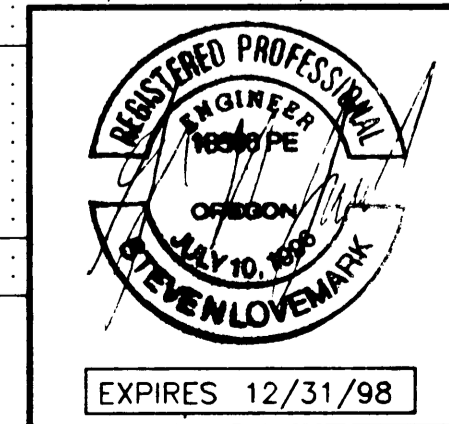

Rev.	Date	Dwg	Description
3	1/21/99	RGZ	STS DEPTH & GRADE CHANGE CHRISTOPHER CT. GRADE CHANGE
4	4/20/99	MLJ	AS BUILT - WATERLINE
3	5/19/99	MLJ	AS BUILT - SANITARY SEWER

0000004