



FILED
 Date: 1/2/2003 By: J.P.
 This survey consists of:
 Map:
 Corner Post:
 DOUGLAS COUNTY
 SURVEYOR

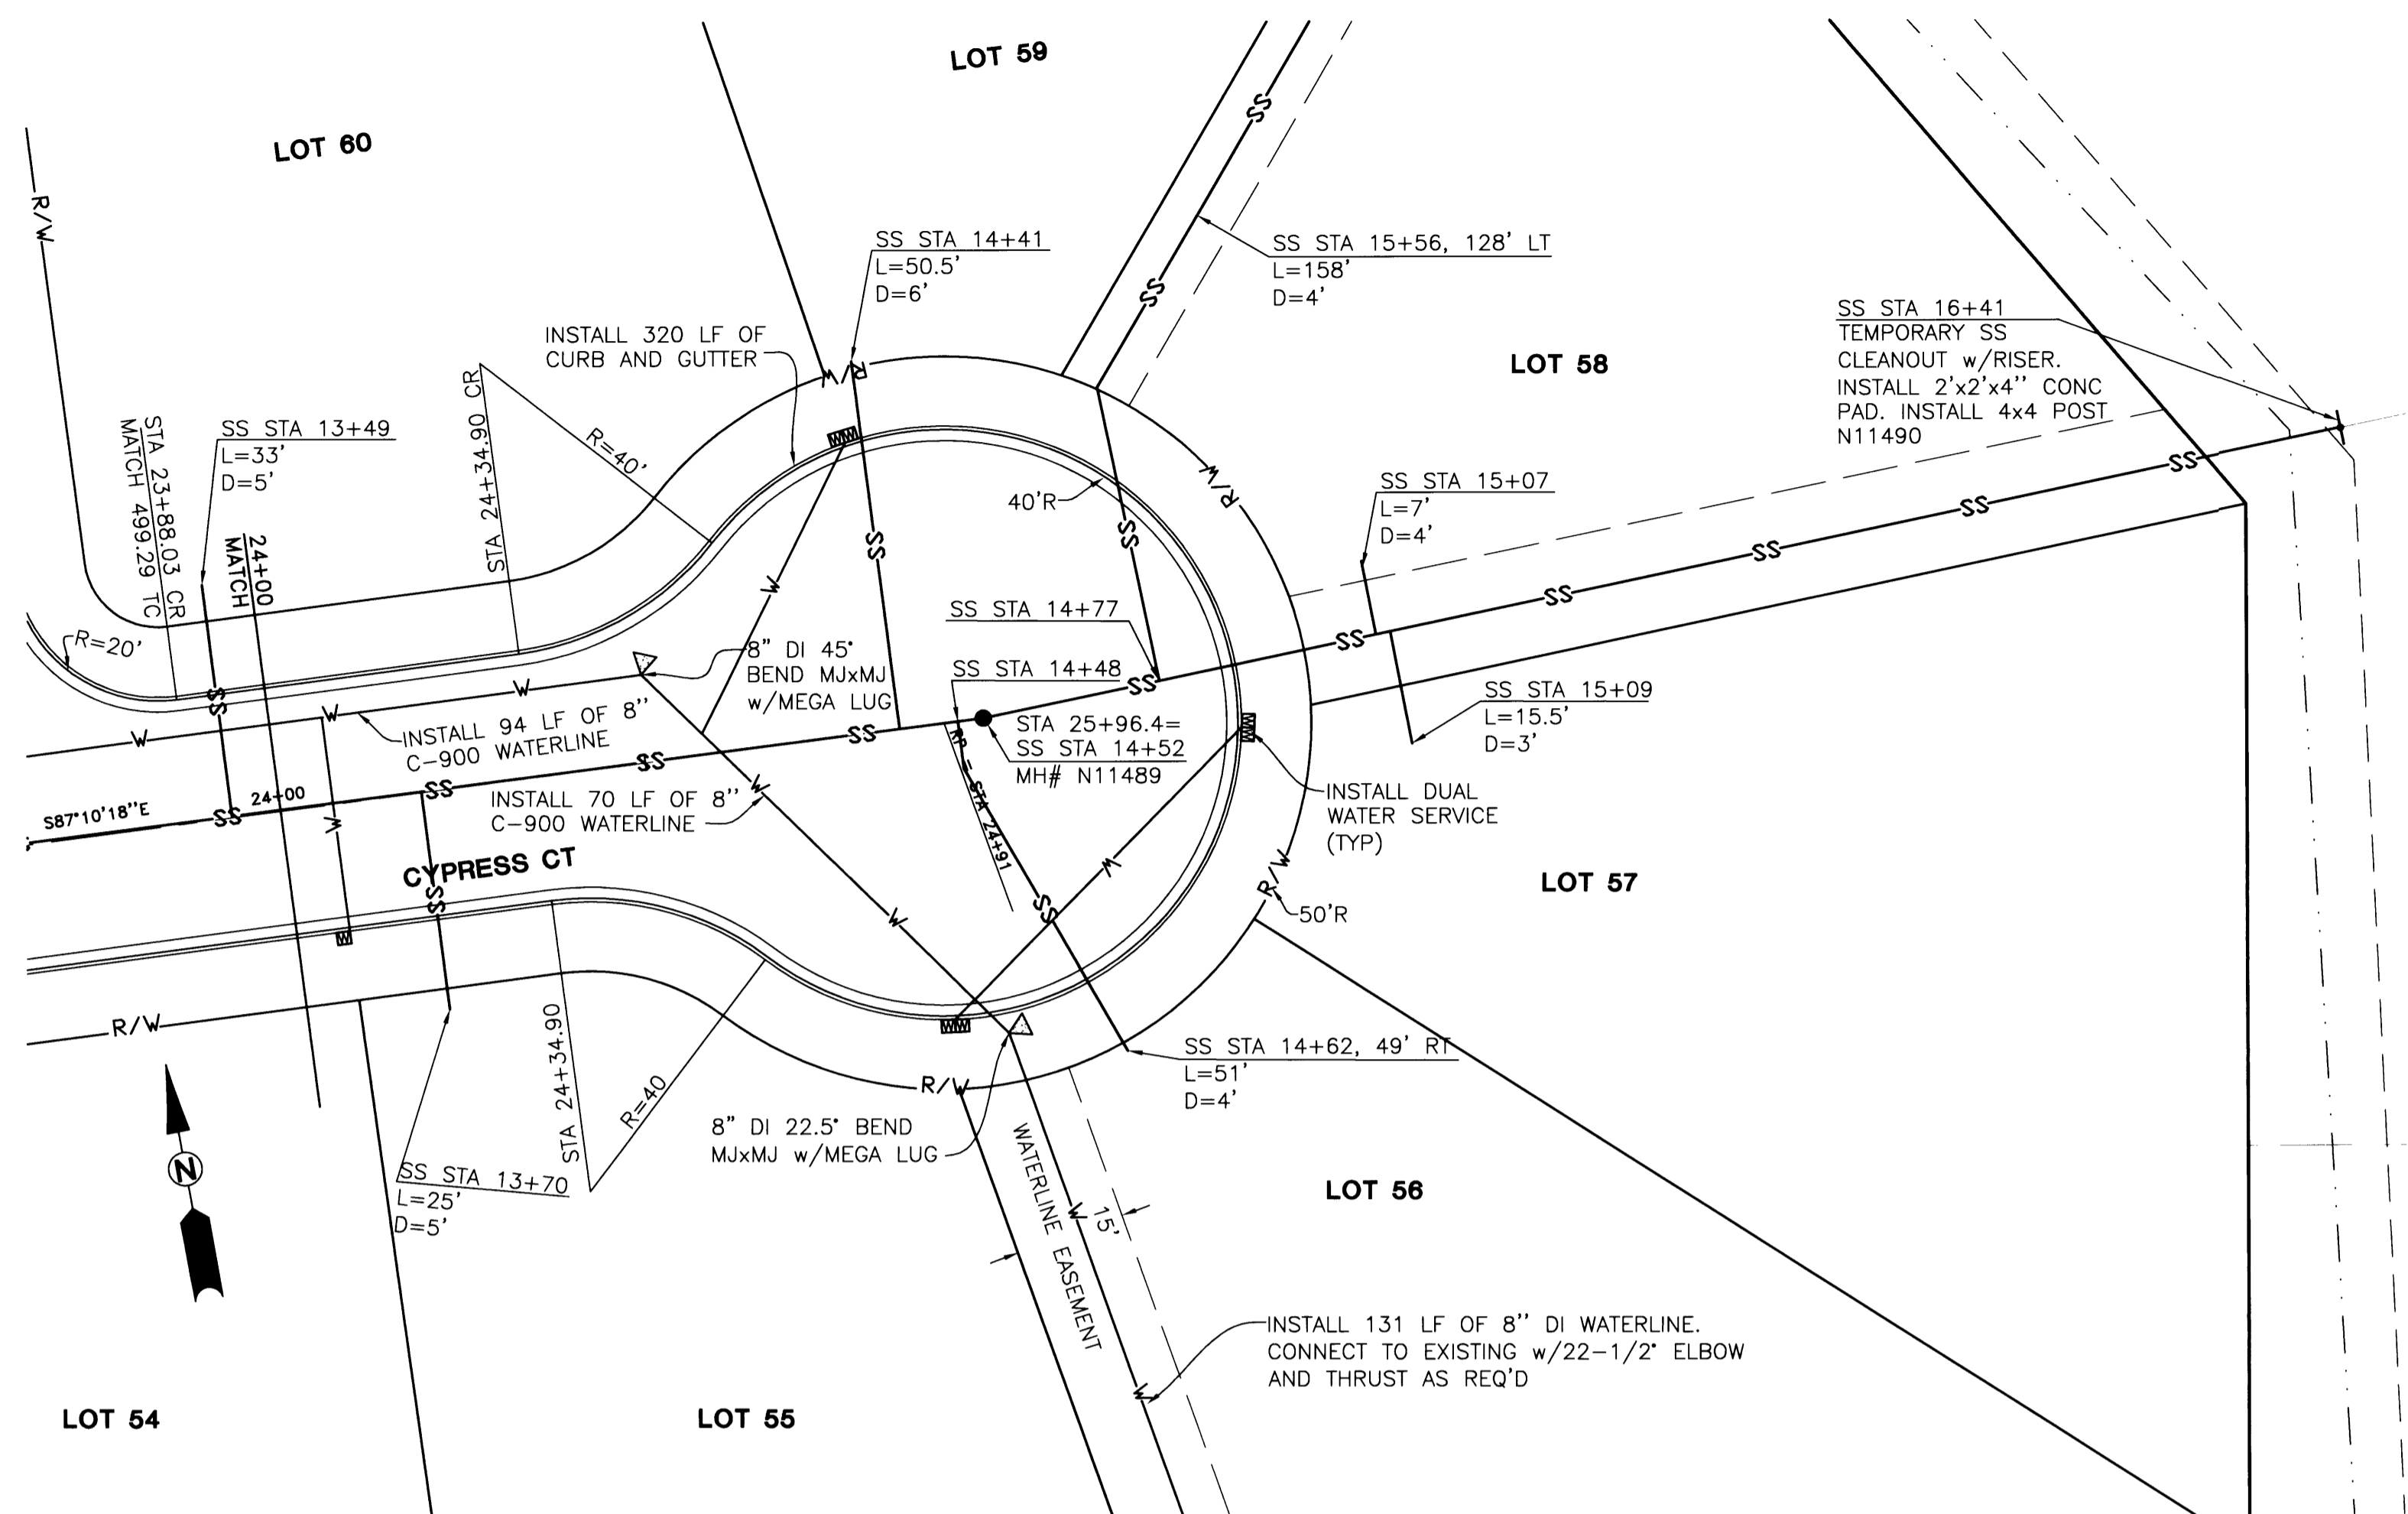

CALL BEFORE YOU DIG I
 ONE CALL (800) 332-2344
 OAR 952-001-0010 THROUGH
 OAR 952-001-0090

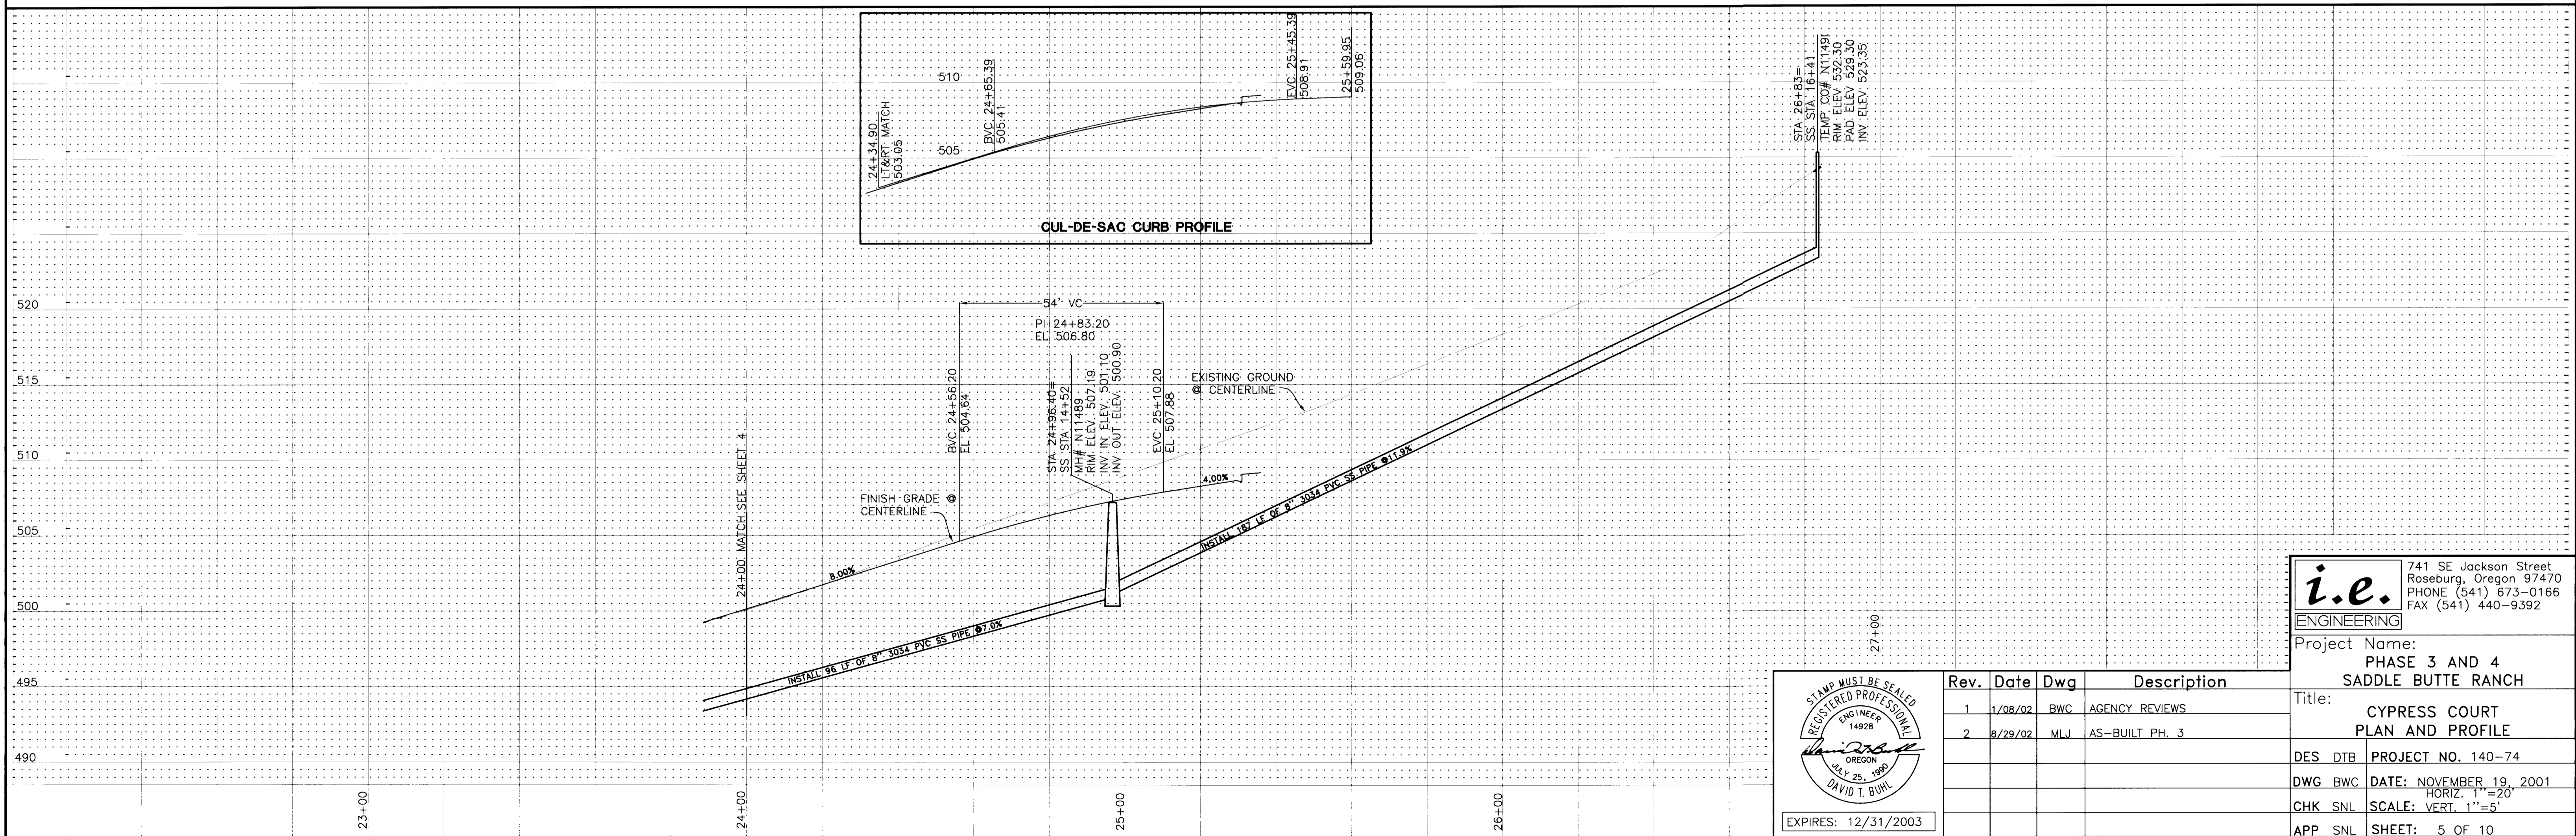


i.e.
 ENGINEERING
 741 SE Jackson Street
 Roseburg, Oregon 97470
 PHONE (541) 673-0166
 FAX (541) 440-9392

Project Name:
 PHASE 3 AND 4
 SADDLE BUTTE RANCH

Title:
 CYPRESS COURT
 PLAN AND PROFILE

DES	DTR	PROJECT NO. 140-74
DWG	BWC	DATE: NOVEMBER 19, 2001
CHK	SNL	HORIZ. 1"=20'
APP	SNL	SCALE: VERT. 1"=5'
		SHEET: 5 OF 10

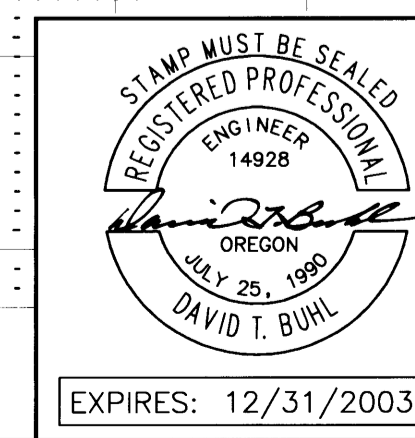

Rev.	Date	Dwg	Description
1	1/08/02	BWC	AGENCY REVIEWS
2	8/29/02	MLJ	AS-BUILT PH. 3

901J0011