


Storm Drain 'B' Profile

NOTE:
 1. SEE SHEET NO. 2 FOR PLAN VIEW.
 2. ALL STORM PIPE TO BE ADS N-12 OR ENGINEER APPROVED EQUAL.

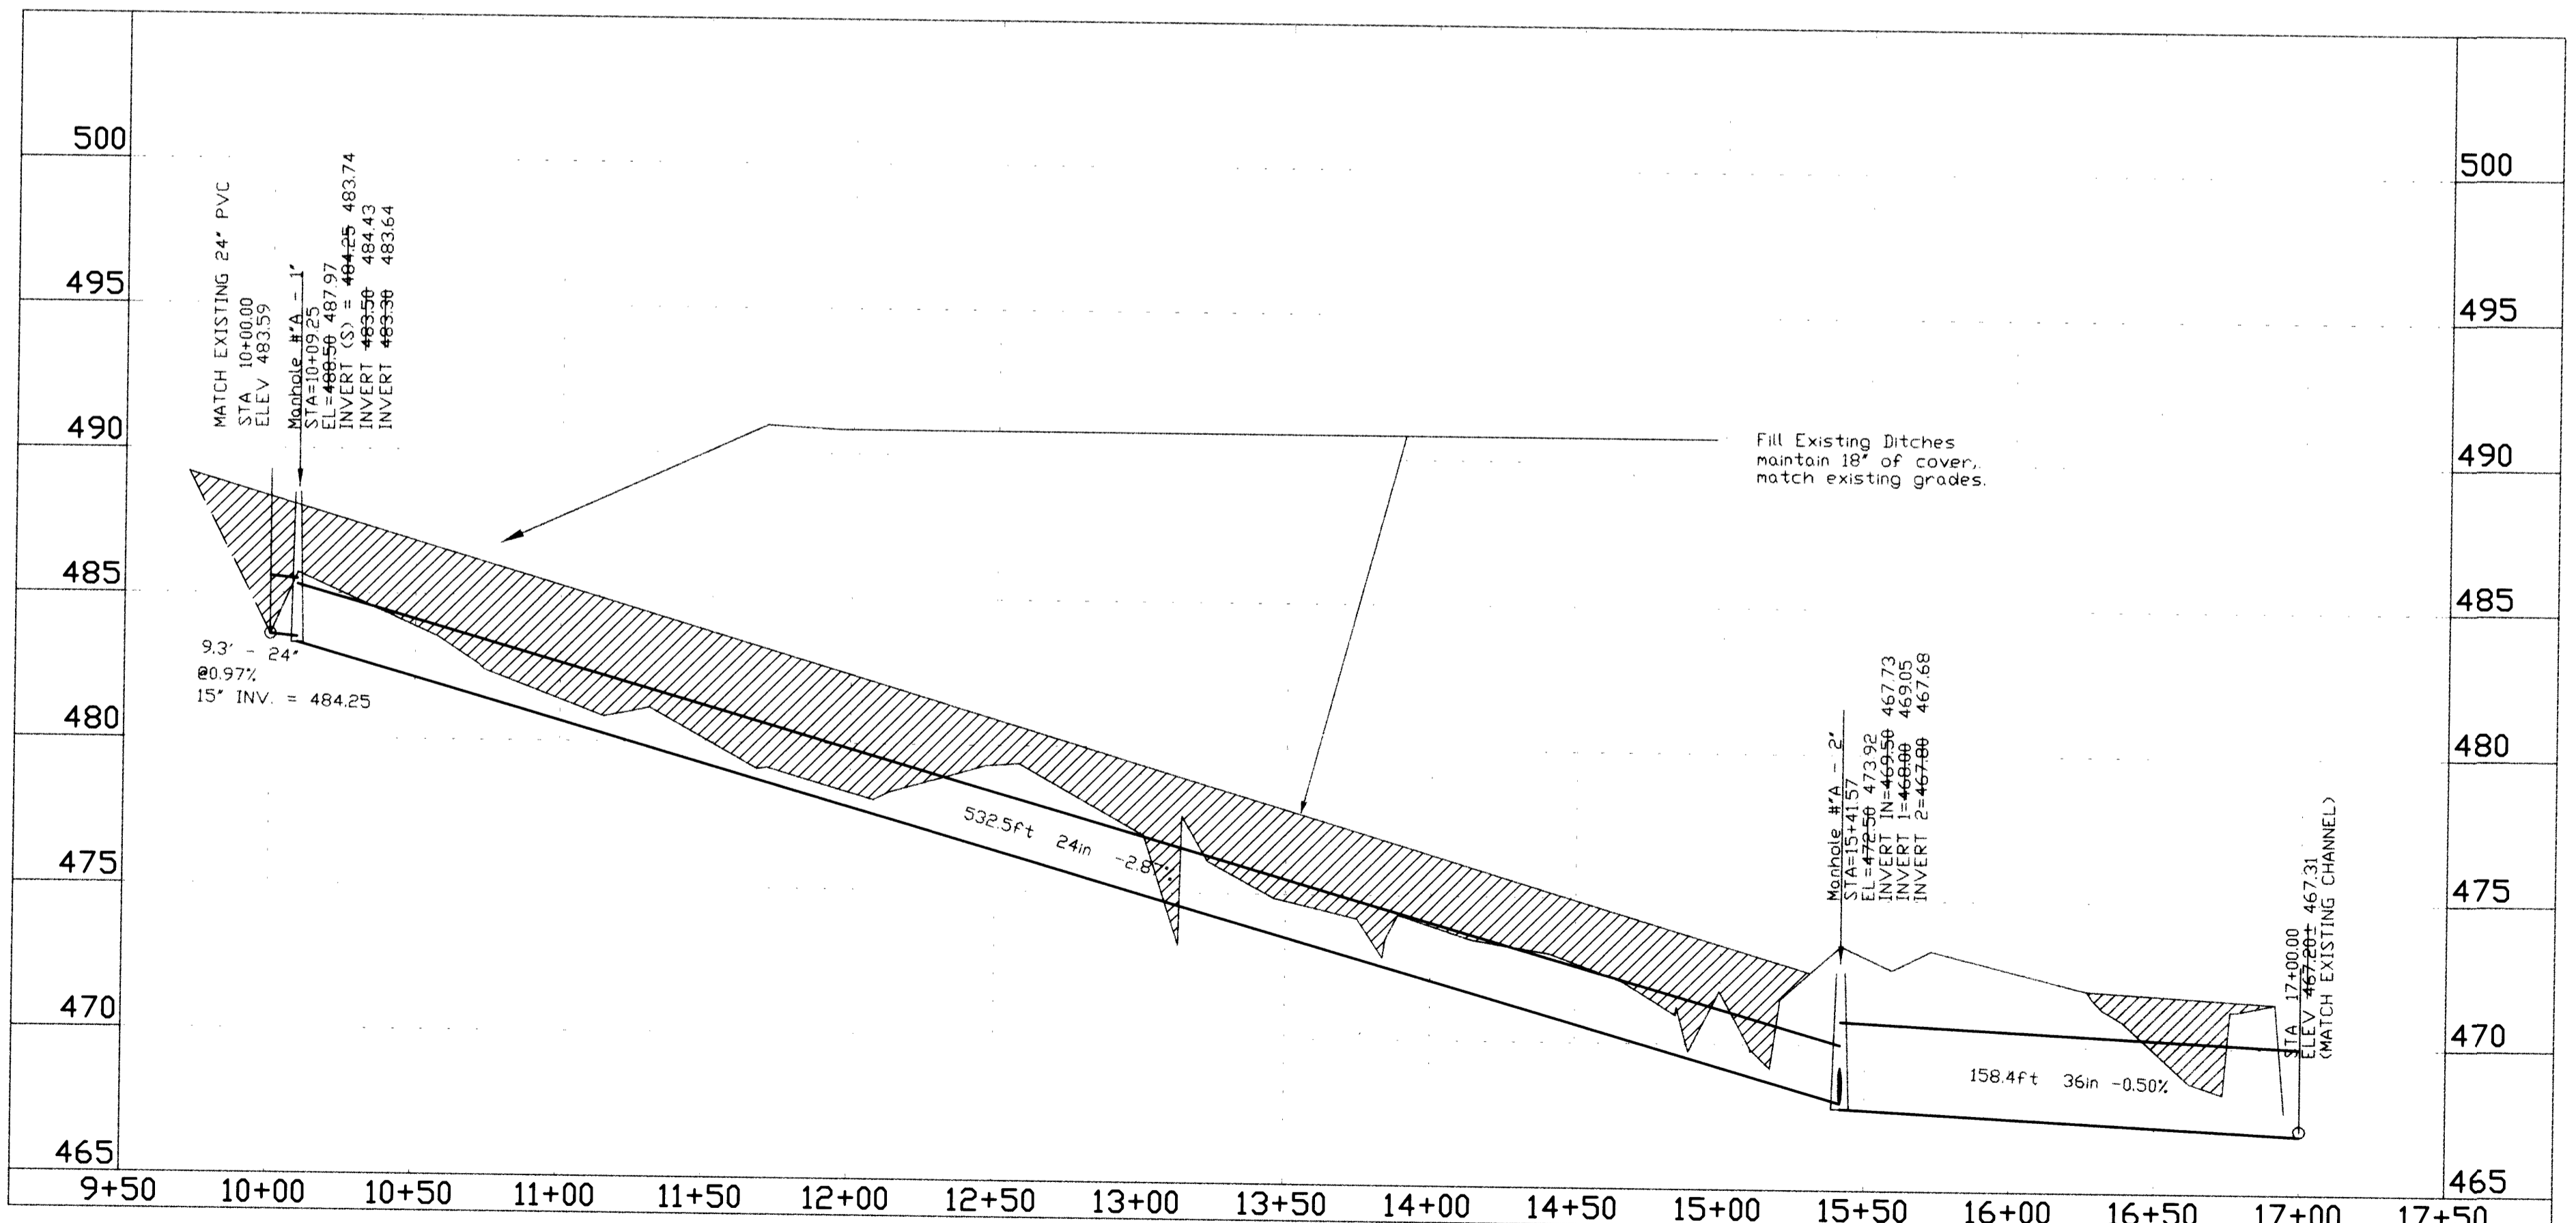

Storm Drain "A" Profile

FILED
 Date: 5/15/2002 By: JP
 This survey consists of:
 Map:
 Narrative:
 Corner Rpt:
 DOUGLAS COUNTY
 SURVEYOR



SURVEYING SERVICE, INC.
 3076 NE DIAMOND LAKE BLVD.
 ROSEBURG, OREGON 97470
 TEL (541)672-2096
 FAX (541)672-0611

Revision	12/96
Date	
Revision	
Date	

Drawn	RDM
Design	
Checked	
Reviewed	

TITLE: STORM LINE "A" & "B"
 PROFILE - Sta. A10+00 to Sta. A17+00,
 Sta. B10+00 to Sta. B14+19.70
 PROJECT NAME:
 SADDLE BUTTE RANCH PHASE II
 AS-BUILTS

SHT.	5
OF	7

901ASTRM