
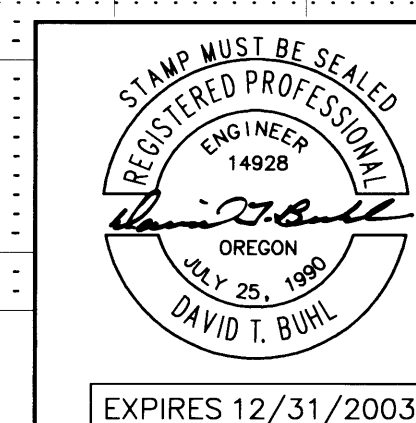
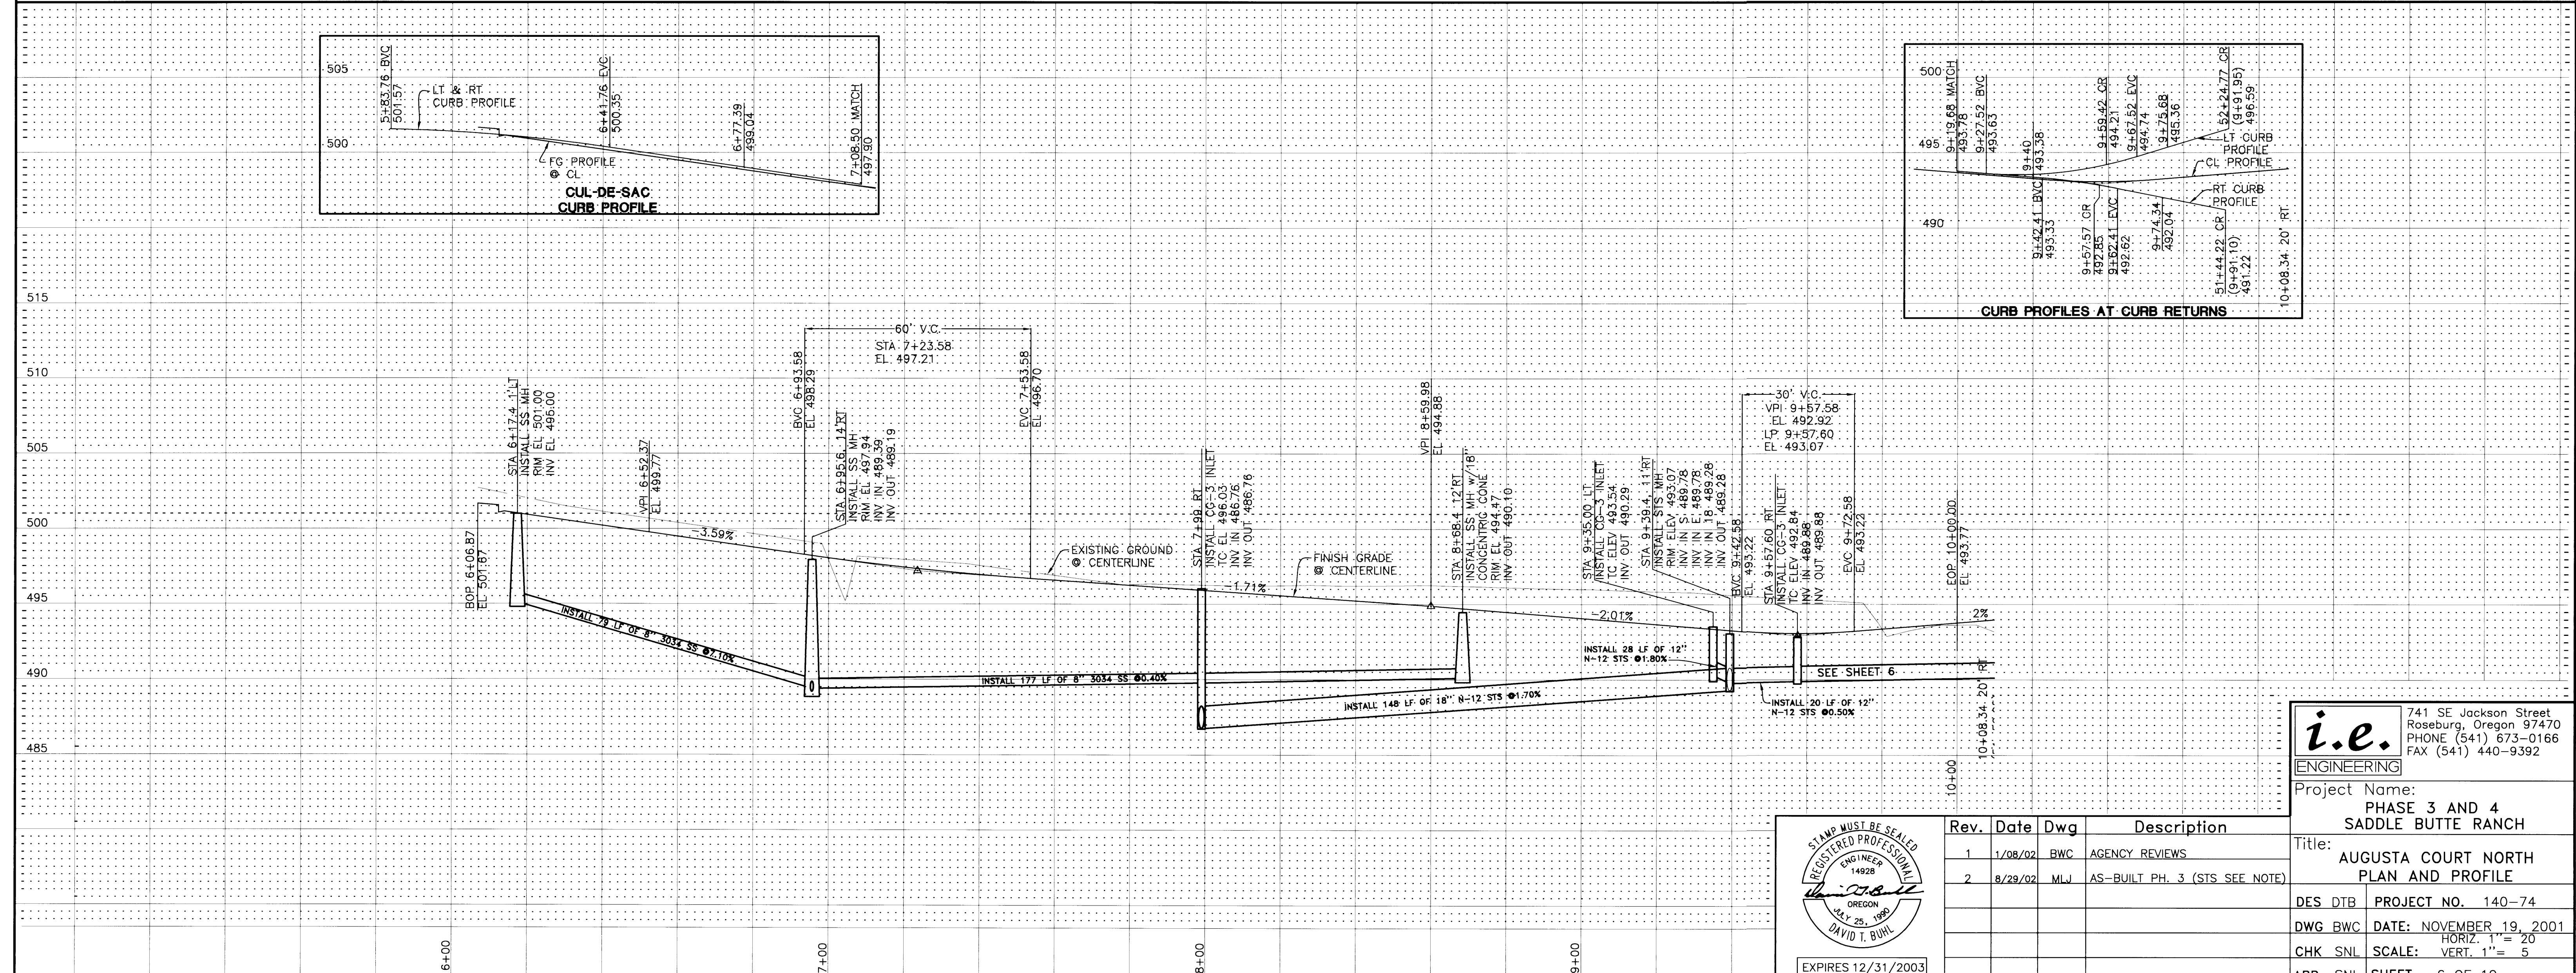
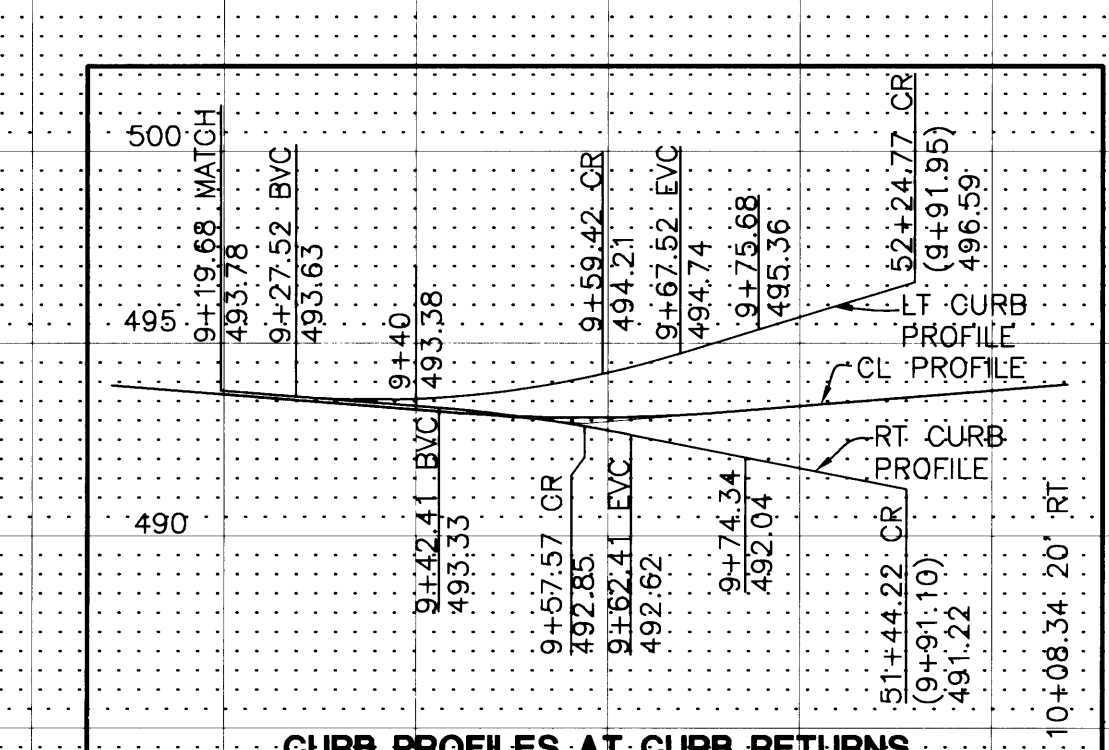
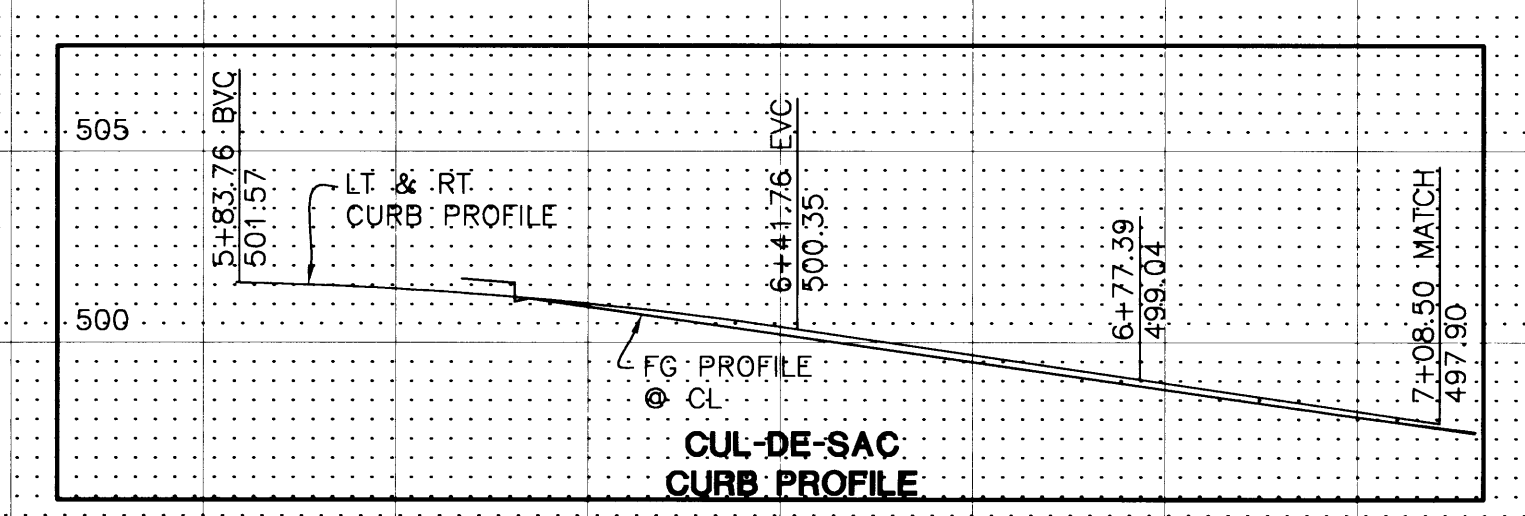


FILED
 Date: 1/6/2003 By: J.P.
 This survey consists of:
 Narration:
 Corner Rpt:
 DOUGLAS COUNTY
 SURVEYOR

CALL BEFORE YOU DIG I
 ONE CALL (800) 332-2344
 OAR 952-001-0010 THROUGH
 OAR 952-001-0090

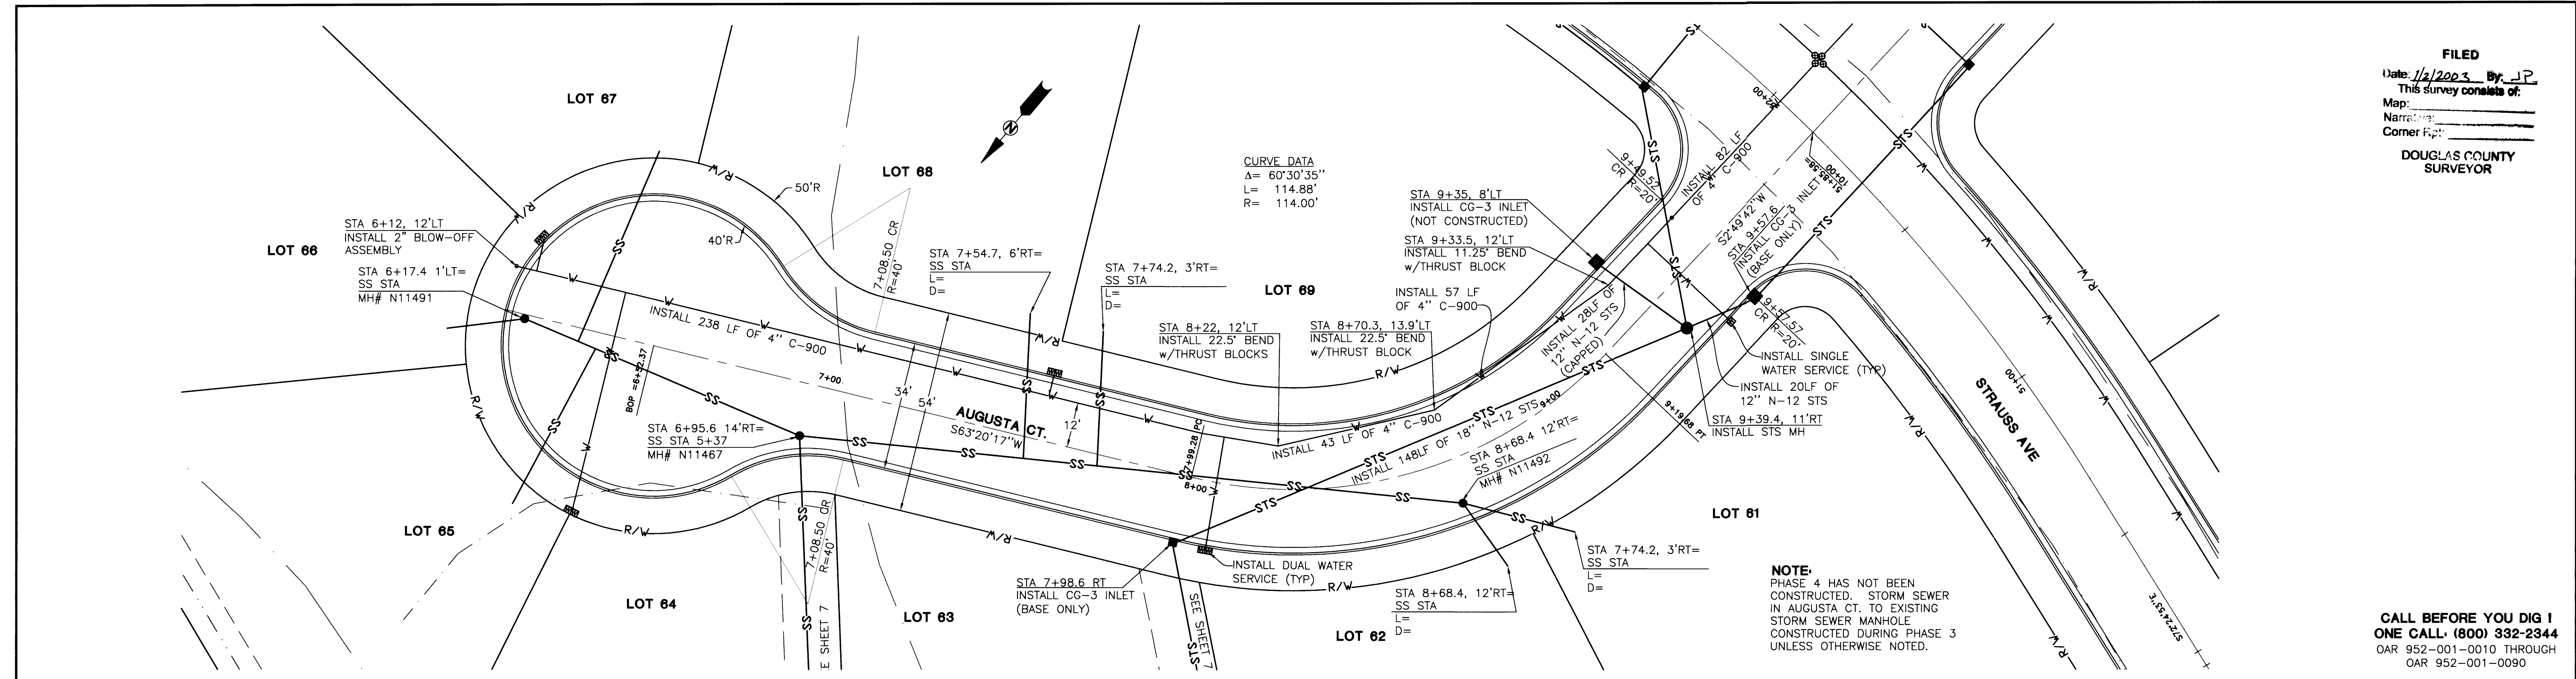

Rev.	Date	Dwg	Description
1	1/08/02	BWC	AGENCY REVIEWS
2	8/29/02	MLJ	AS-BUILT PH. 3 (STS SEE NOTE)

i.e.
 ENGINEERING
 741 SE Jackson Street
 Roseburg, Oregon 97470
 PHONE (541) 673-0166
 FAX (541) 440-9392

Project Name:
 PHASE 3 AND 4
 SADDLE BUTTE RANCH

Title:
 AUGUSTA COURT NORTH
 PLAN AND PROFILE

DES DTB PROJECT NO. 140-74
 DWG BWC DATE: NOVEMBER 19, 2001
 CHK SNL SCALE: HORIZ. 1" = 20'
 VERT. 1" = 5'
 APP SNL SHEET 6 OF 10

901K0070