
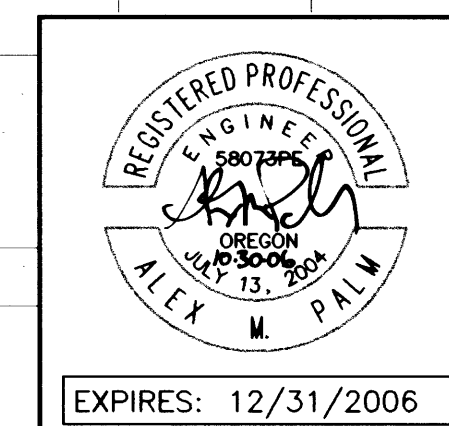


**FILED**  
 Date: 9-5-2007 By: J.D.  
 This survey consists of: 11 P.  
 Map: Co. Rd. #901 A & L  
 Narrative:  
 Corner Rpt:  
 DOUGLAS COUNTY SURVEYOR

0' 10' 20' 40'  
 SCALE: 1"=20'

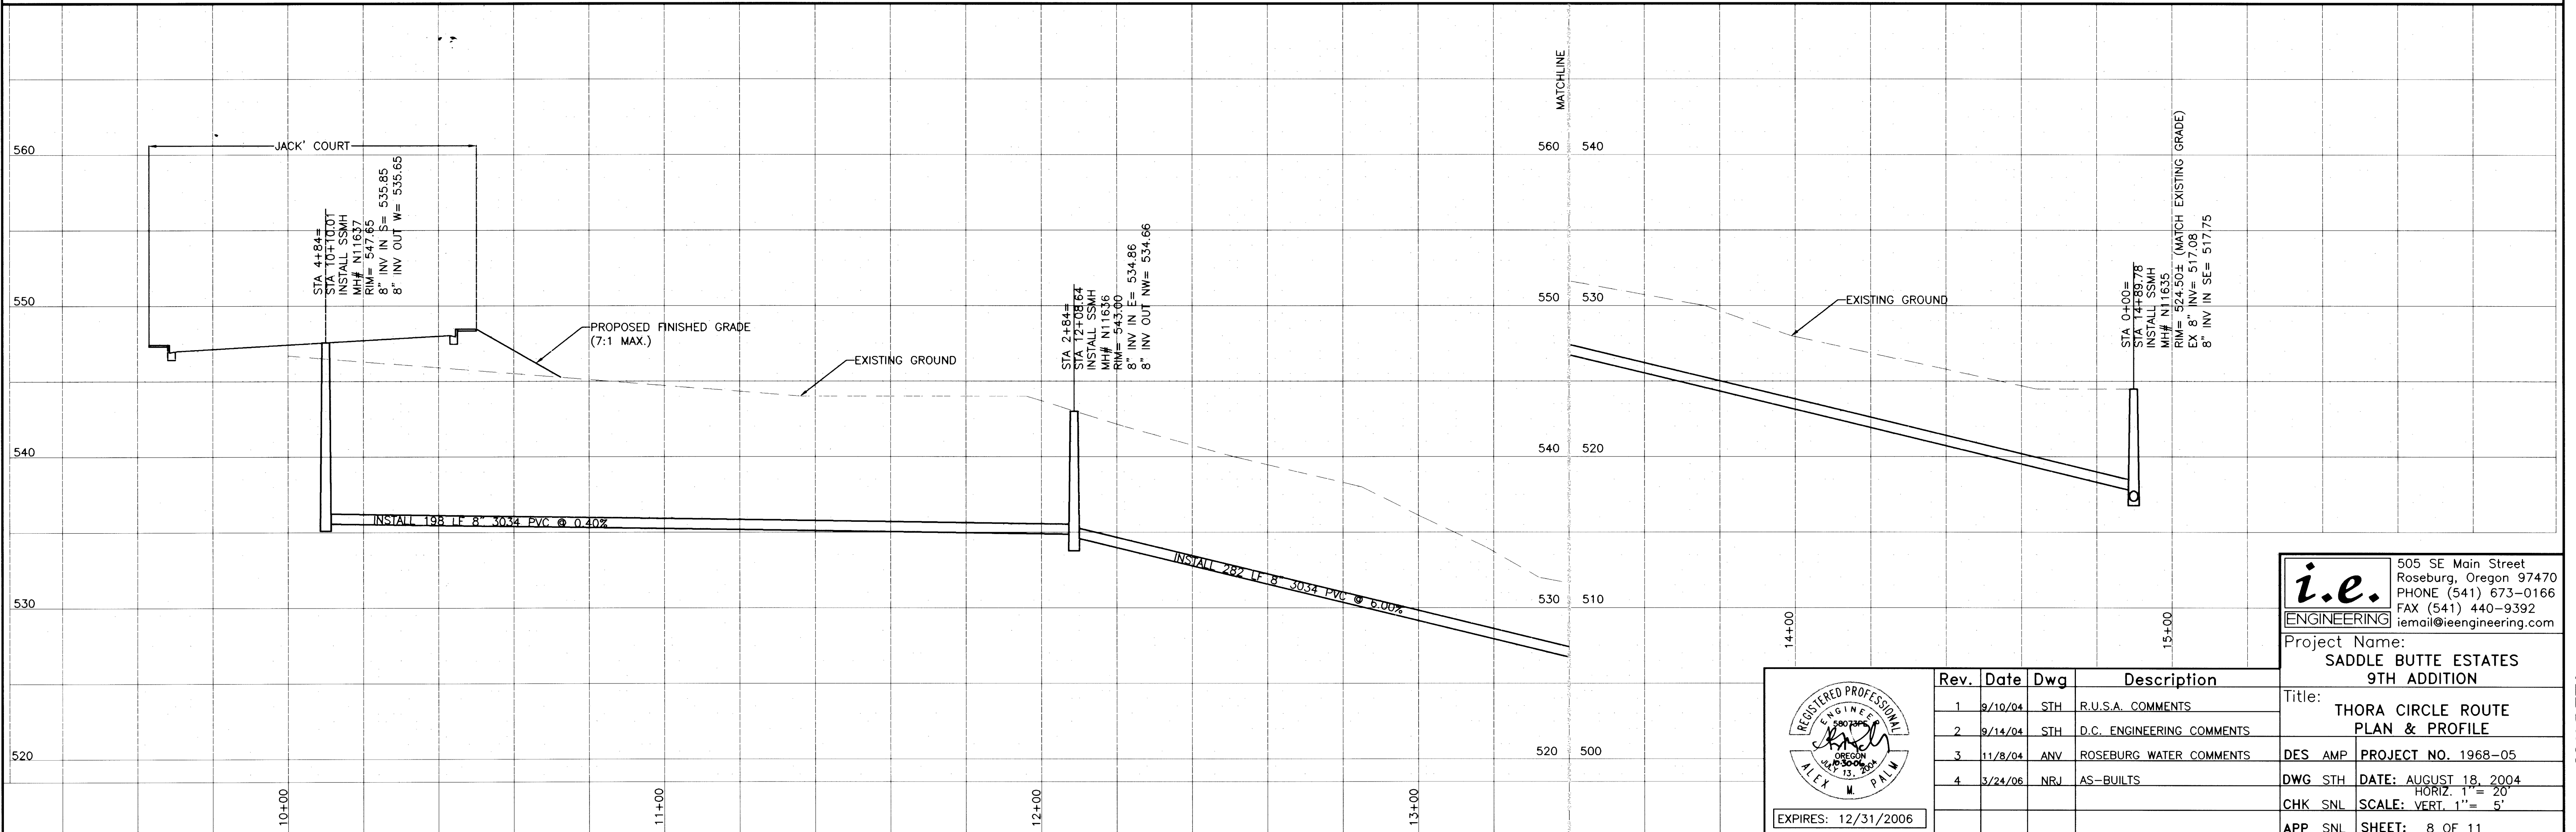

Rev.	Date	Dwg	Description
1	9/10/04	STH	R.U.S.A. COMMENTS
2	9/14/04	STH	D.C. ENGINEERING COMMENTS
3	11/8/04	ANV	ROSEBURG WATER COMMENTS
4	3/24/06	NRJ	AS-BUILTS

**i.e. ENGINEERING**  
 505 SE Main Street  
 Roseburg, Oregon 97470  
 PHONE (541) 673-0166  
 FAX (541) 440-9392  
 iemail@ieengineering.com

Project Name:  
**SADDLE BUTTE ESTATES  
 9TH ADDITION**

Title:  
**THORA CIRCLE ROUTE  
 PLAN & PROFILE**

DES AMP PROJECT NO. 1968-05  
 DWG STH DATE: AUGUST 18, 2004  
 CHK SNL HORIZ. 1"= 20'  
 APP SNL SCALE: VERT. 1"= 5'  
 SHEET: 8 OF 11

DO NOT DUPLICATE