


NOTE:
 STS DEPTH AND GRADES ARE CRITICAL. INVERT ELEVATION OF 36\"/>

i.e. ENGINEERING
 741 SE Jackson Street
 Roseburg, Oregon 97470
 PHONE (541) 673-0166
 FAX (541) 440-9392

Project Name:
**SADDLE BUTTE ESTATES
 7th ADDITION**
 Title:
**RAE CHELLE COURT AND STORM
 SEWER - PLAN AND PROFILES**
 DES RGZ PROJECT NO. 140-41
 DWG RGZ DATE: SEPT. 22, 1998
 CHK SNL SCALE: HORIZ. 1"=20'
 APP SNL SHEET 3 OF 5

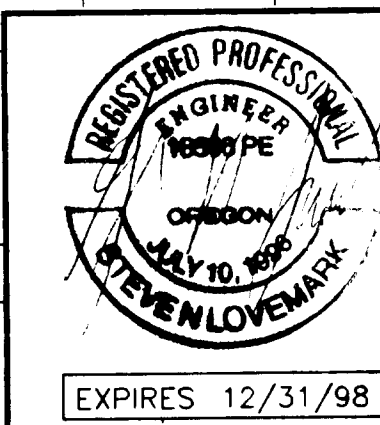

Rev.	Date	Dwg	Description
3	1/21/99	RGZ	STS DEPTH & GRADE CHANGE CHRISTOPHER CT. GRADE CHANGE
4	4/20/99	MLJ	AS BUILT - WATERLINE
3	5/19/99	MLJ	AS BUILT - SANITARY SEWER

00000004