


FILED
 Date: 8-26-1995 By: J.P.
 This survey consists of:
 Map:
 Narrative:
 Corner Plat:
 DOUGLAS COUNTY
 SURVEYOR

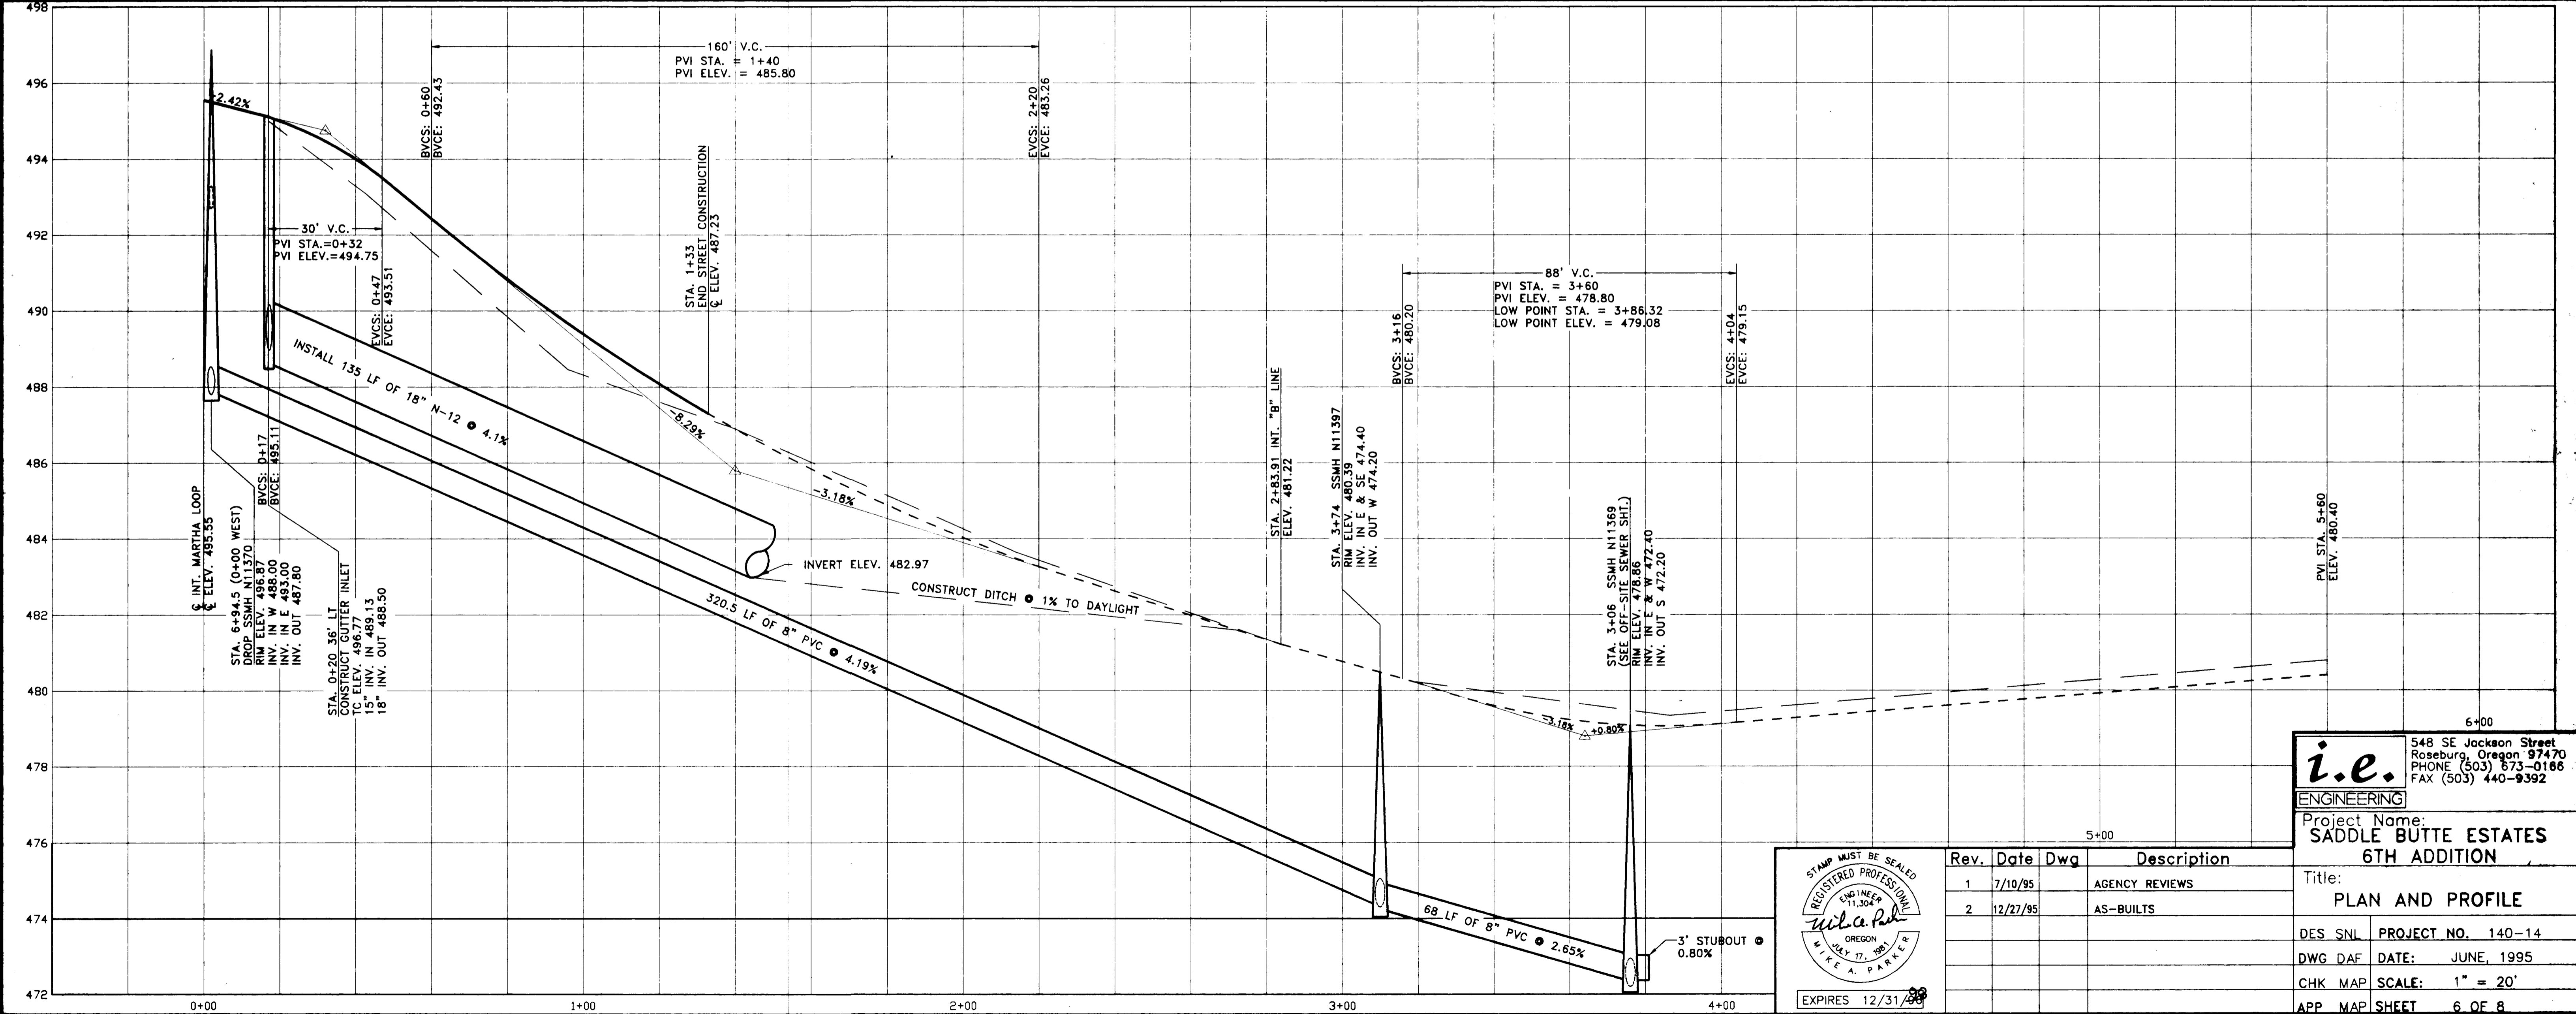


i.e.
 ENGINEERING
 548 SE Jackson Street
 Roseburg, Oregon 97470
 PHONE (503) 673-0168
 FAX (503) 440-9392

Project Name:
**SADDLE BUTTE ESTATES
 6TH ADDITION**

Title:
PLAN AND PROFILE

Rev.	Date	Dwg	Description
1	7/10/95		AGENCY REVIEWS
2	12/27/95		AS-BUILTS

DES. SNL PROJECT NO. 140-14
 DWG. DAF DATE: JUNE, 1995
 CHK. MAP SCALE: 1" = 20'
 APP. MAP SHEET 6 OF 8

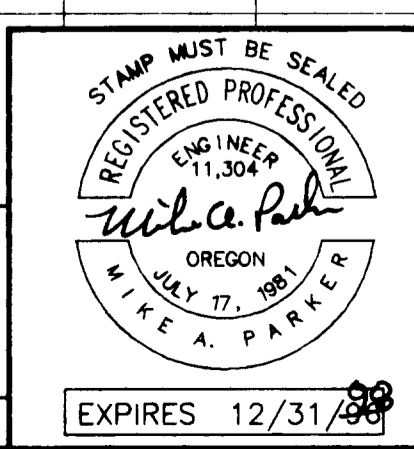

901F
 CO. RD. # 901 F