



DATE	
BY	
REVISIONS	
NO.	
DESCRIPTION	
DATE	
BY	
REVISIONS	
NO.	
DESCRIPTION	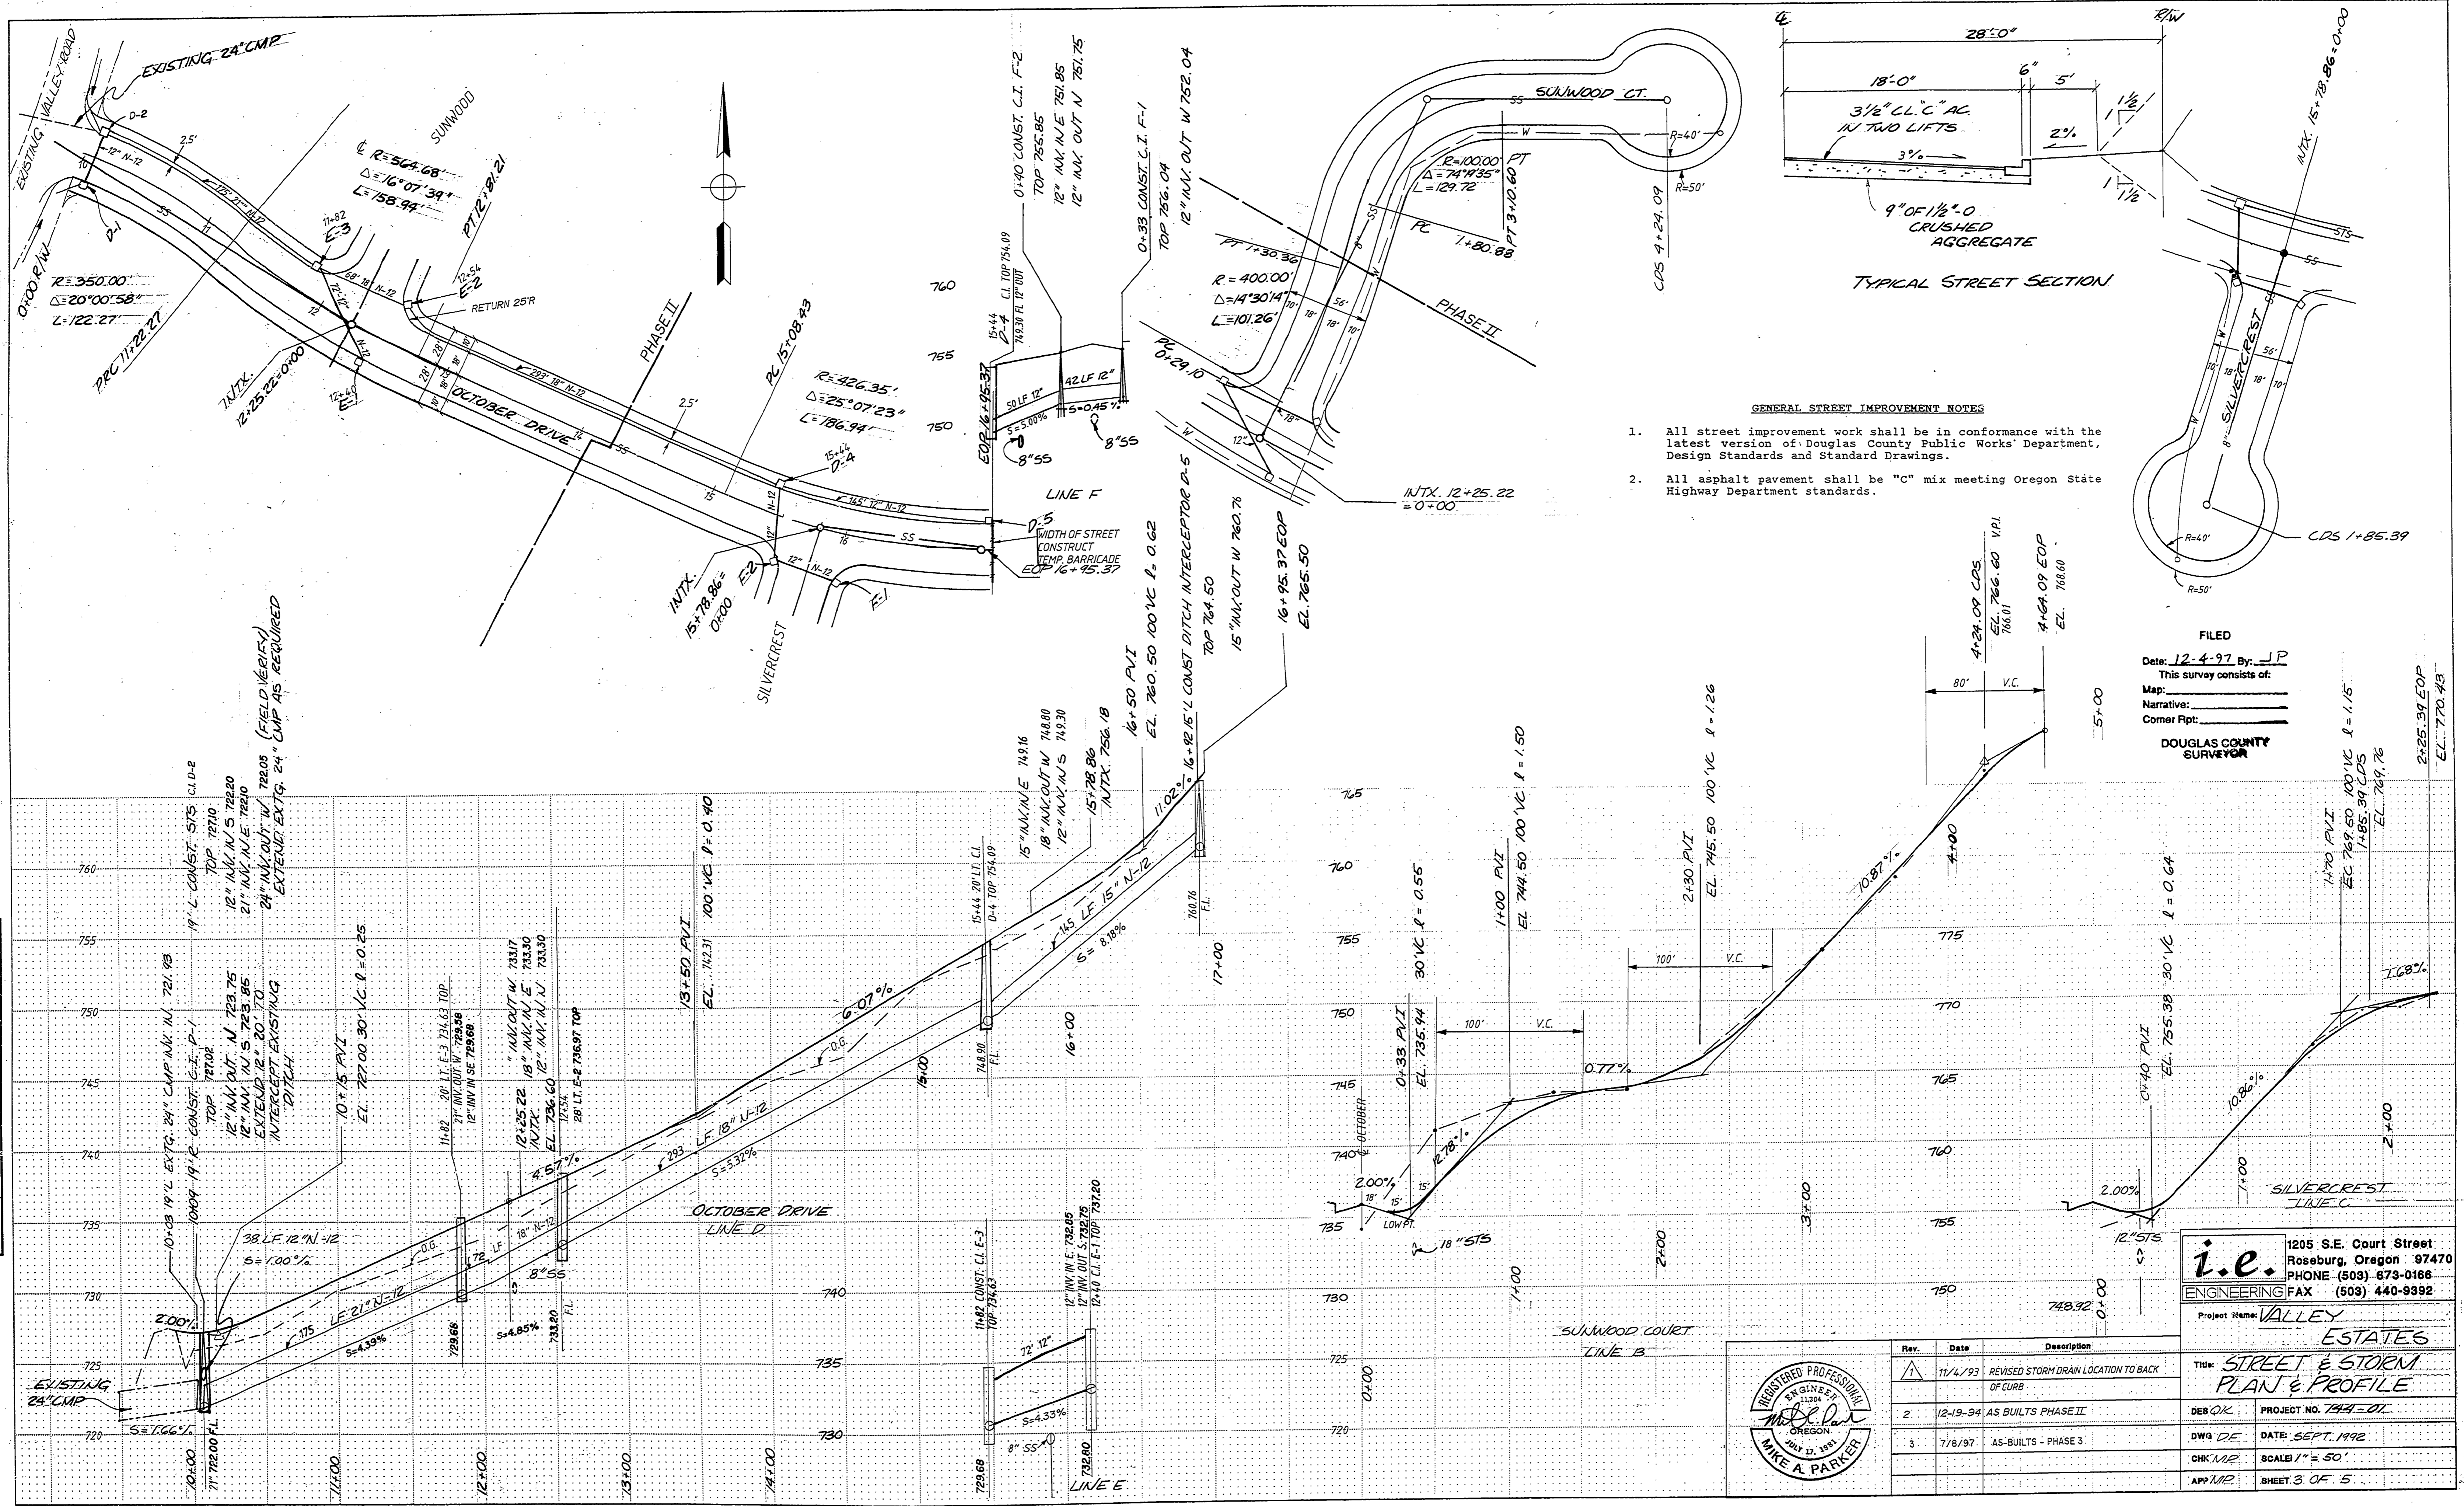
FILED
 Date: 12-4-97 By: J.P.
 This survey consists of:
 Map:
 Narrative:
 Corner Rpt:
 DOUGLAS COUNTY SURVEYOR

i.e. 1205 S.E. Court Street
 Roseburg, Oregon 97470
 PHONE (503) 673-0166
 ENGINEERING FAX (503) 440-9392
 Project Name: VALLEY ESTATES

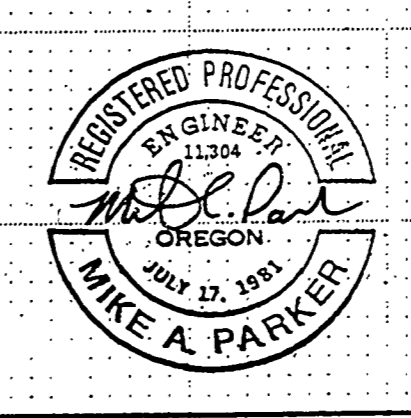

Rev.	Date	Description
1	11/4/93	REVISED STORM DRAIN LOCATION TO BACK OF CURB
2	12-19-94	AS-BUILTS PHASE II
3	7/8/97	AS-BUILTS - PHASE 3

TITLE: STREET & STORM PLAN & PROFILE	PROJECT NO. 144-01
DESIGNER: DATE: SEPT. 1992	DATE: SEPT. 1992
CHECKED: SCALE: 1" = 50'	SCALE: 1" = 50'
APPROVED: SHEET 3 OF 5	SHEET 3 OF 5

PLATE 4-SINGLE PLAN AND CROSS SECTION-FULL DOT
 PRINTED IN U.S.A.

00000032
 OCTOBER DR. - CO. RD. #905
 SUNWOOD CT. - CO. RD. #905A
 SILVERCREST CT. - CO. RD. #905B (13)