
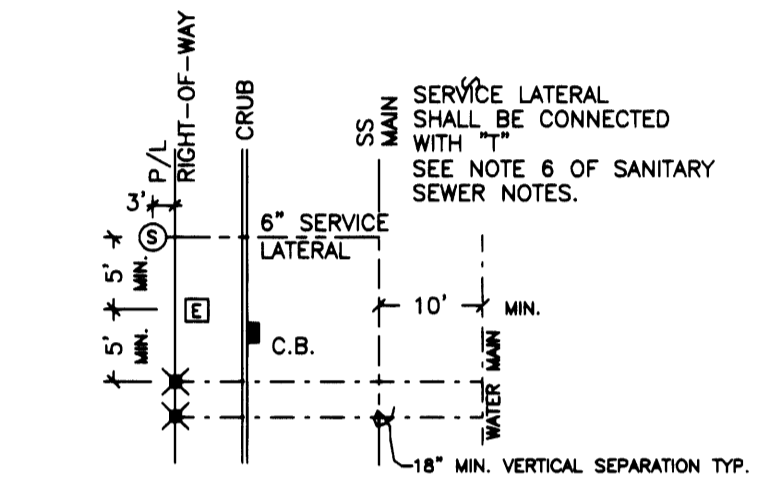


SOUTH 1/2 SECTION 33, T29S, R5W, WM

FILED  
 Date: 1-15-2007 By: JC  
 This survey consists of:  
 Map: Co. 907-907B  
 Narrative: 2-28-6  
 Corner Rpt:

DOUGLAS COUNTY  
 SURVEYOR

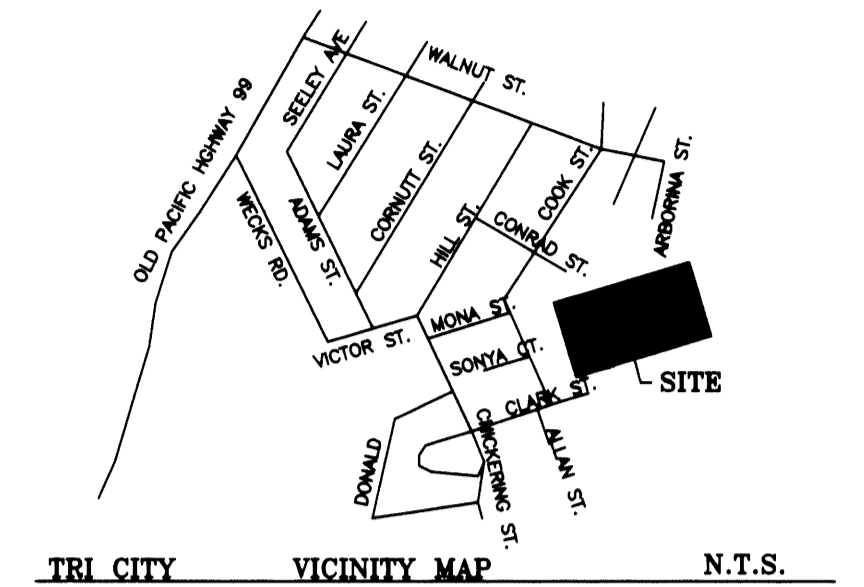

- LEGEND:**
- ⑥ 6" LATERAL SERVICE, SEE DETAIL S-300 AND GENERAL UTILITY LOCATION DETAIL, TYP. SHOWN ON PLANS AS GENERAL LOCATION.
  - MH ② MANHOLE, SEE DESIGN NO. S-200, S-210, S-250, S-260, S-205
  - CO ② CLEANOUT, SEE DESIGN PAGE 4
  - STUB OUT END

SIDEWALKS NOT REQUIRED




**AS-BUILT**

**JORDAN ENGINEERING**

460 JORDAN LANE  
 ROSEBURG, OREGON 97470  
 (541) 673-1931

SCALE: 1"=40'	SEWER AS-BUILT PHASE 2	DRAWN BY: K.C.J.
DATE: 4-12-99		ASSEMBLY: 4-23-08
ROLAND THEISS P.O. BOX 824 MYRTLE CREEK, OR 97457	(541) 863-3134	
VILLAGE VIEW SUBDIVISION ZONE: R-1 PHASE 2	20 LOTS PHASE 2	DRAWING NUMBER: 2 OF 2

R907SEW

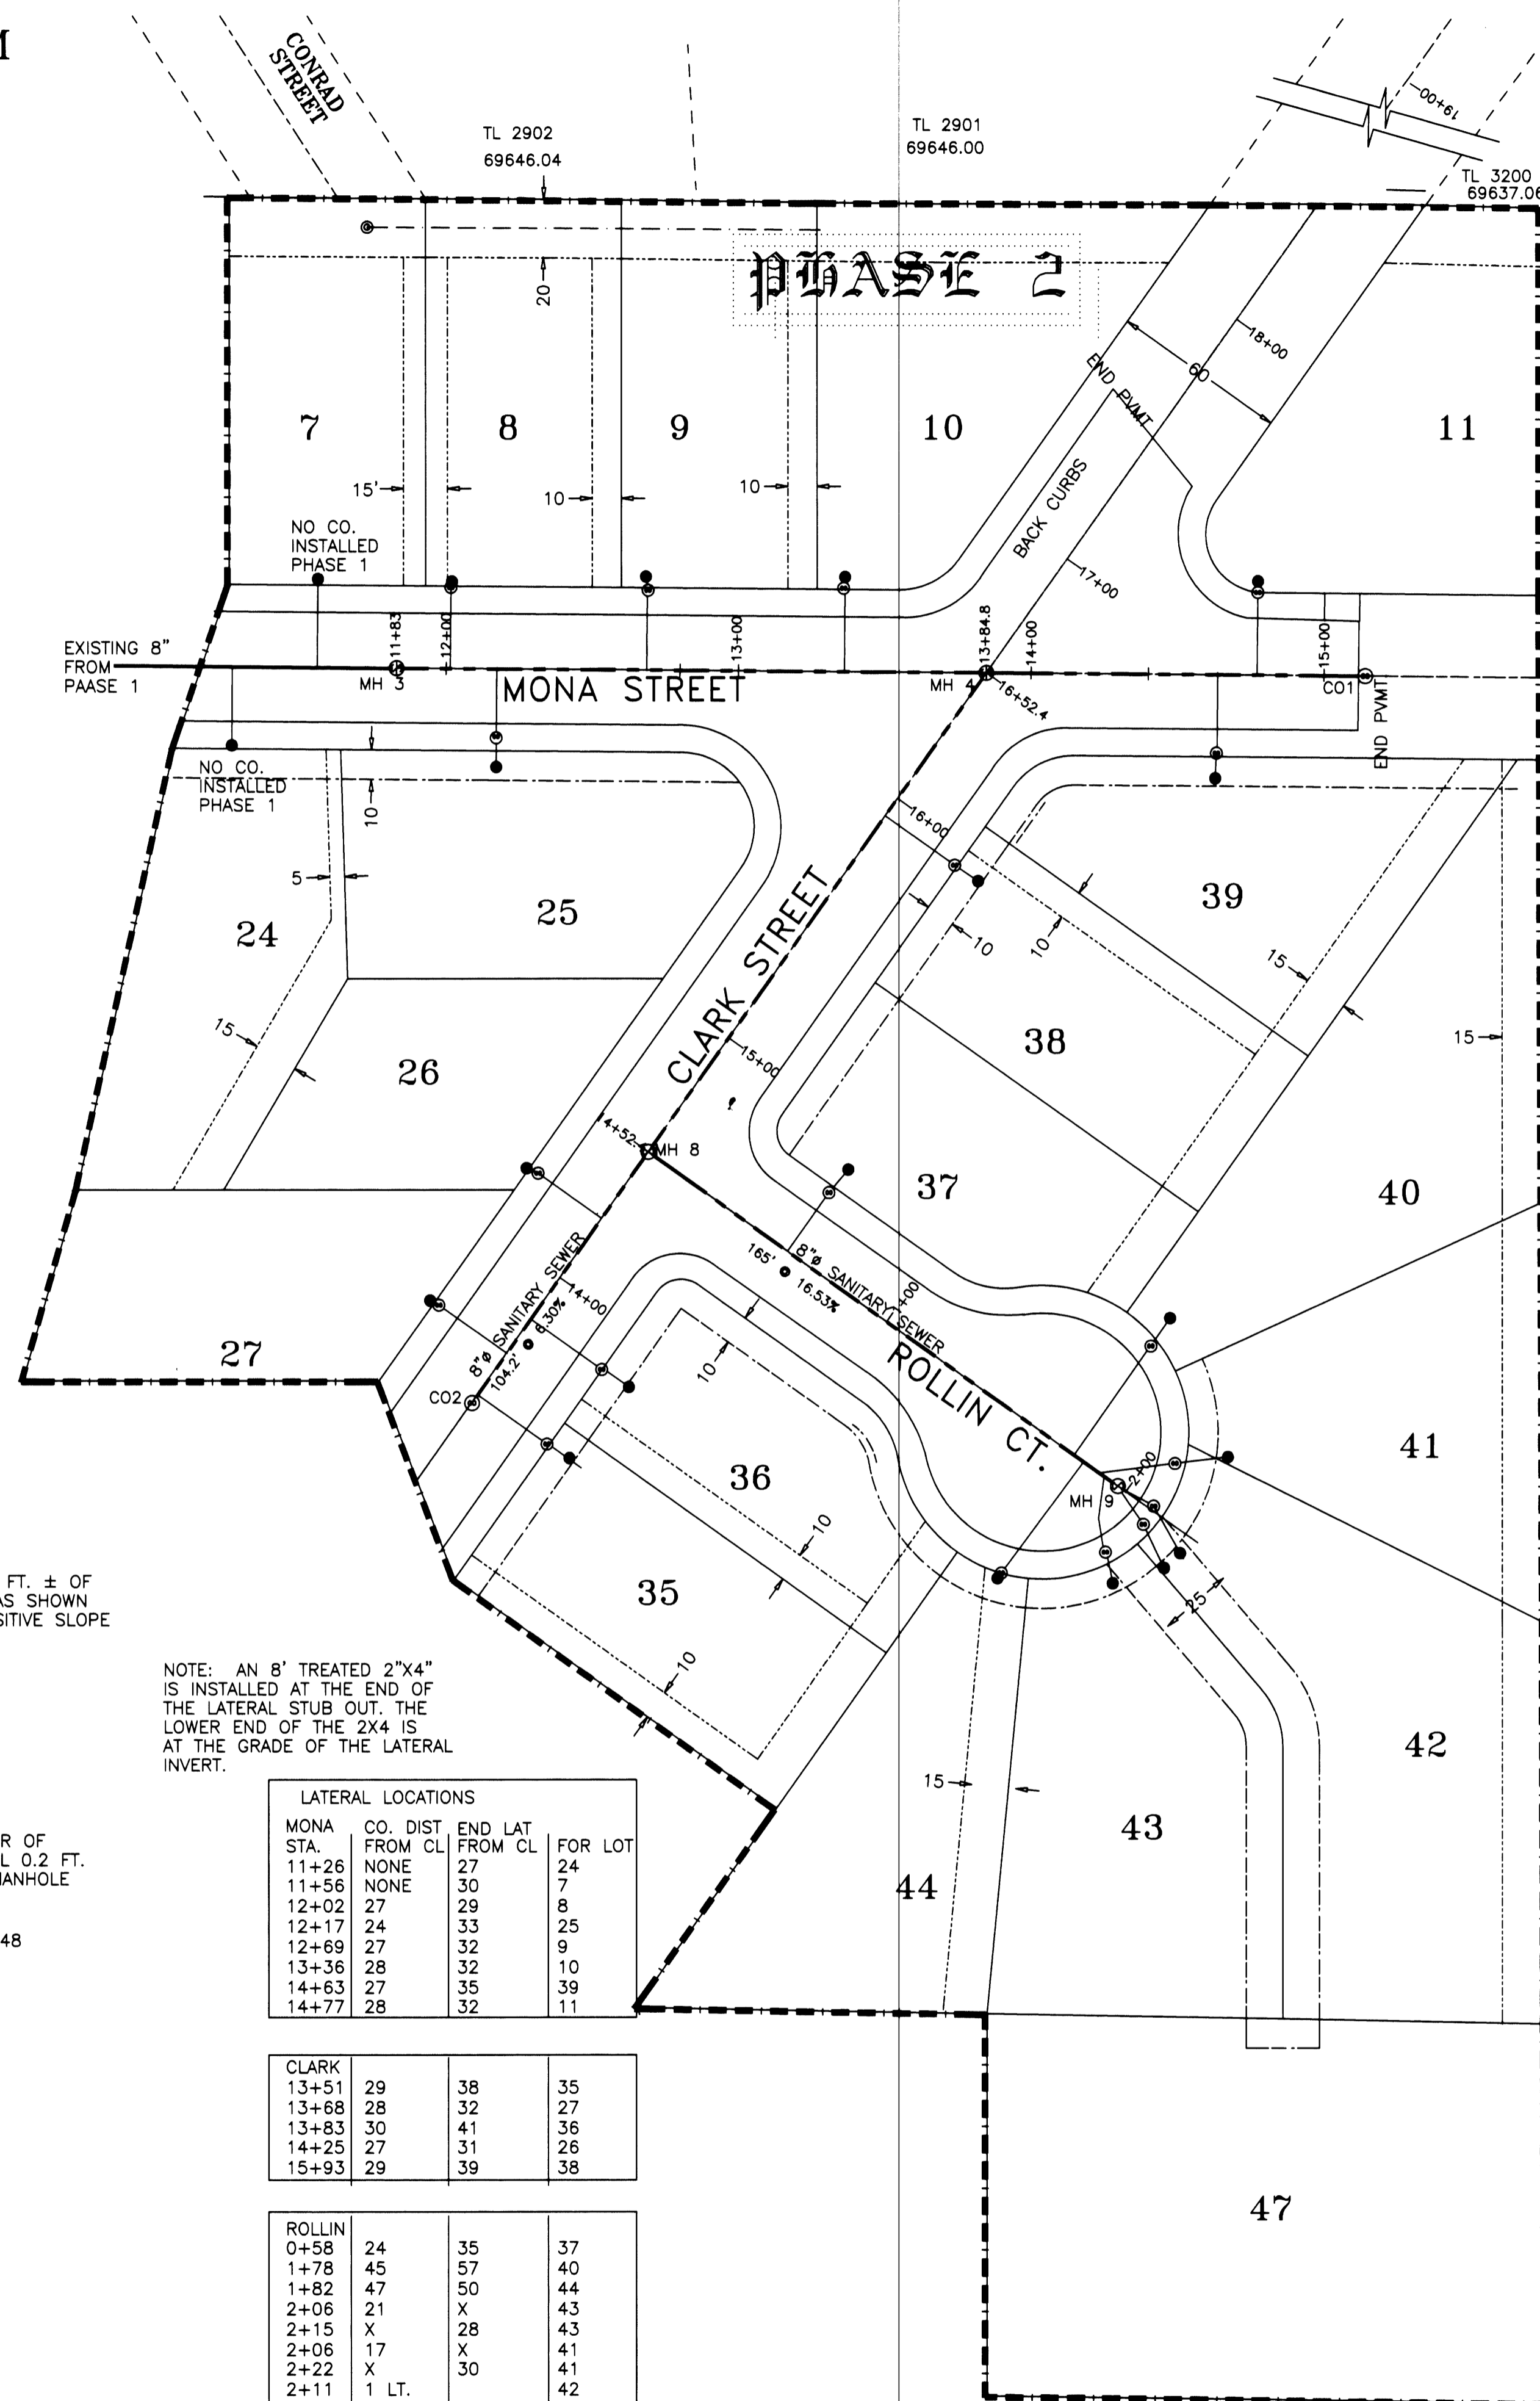

NOTE:  
 WATER MAIN 2.5 FT. ± OF COVER EXCEPT AS SHOWN TO MAINTAIN POSITIVE SLOPE

NOTE: AN 8" TREATED 2"x4" IS INSTALLED AT THE END OF THE LATERAL STUB OUT. THE LOWER END OF THE 2X4 IS AT THE GRADE OF THE LATERAL INVERT.

LATERAL LOCATIONS

MONA STA.	CO. DIST. FROM CL.	END LAT. FROM CL.	FOR LOT
11+26	NONE	27	24
11+56	NONE	30	7
12+02	27	29	8
12+17	24	33	25
12+69	27	32	9
13+36	28	32	10
14+63	27	35	39
14+77	28	32	11

CLARK			
13+51	29	38	35
13+68	28	32	27
13+83	30	41	36
14+25	27	31	26
15+93	29	39	38

ROLLIN			
0+58	24	35	37
1+78	45	57	40
1+82	47	50	44
2+06	21	X	43
2+15	X	28	43
2+06	17	X	41
2+22	X	30	41
2+11	1 LT.		42
2+27	X	6 RT.	42
2+11	6 RT.		47
2+26	X	14	47

INVERT AT CENTER OF MANHOLE, TYPICAL 0.2 FT. FALL THROUGH MANHOLE

MH #3  
 RIM= 725.27  
 INVERT IN= 717.48




MH #4  
 RIM= 742.98  
 INVERT 733.28

MH #8  
 RIM= 748.74  
 INVERT 738.83

MH #9  
 RIM= 772.56  
 INVERT 770.90

CO #1  
 RIM= 755.60  
 INVERT 748.4

CO #2  
 RIM= 749.54  
 INVERT 741.97

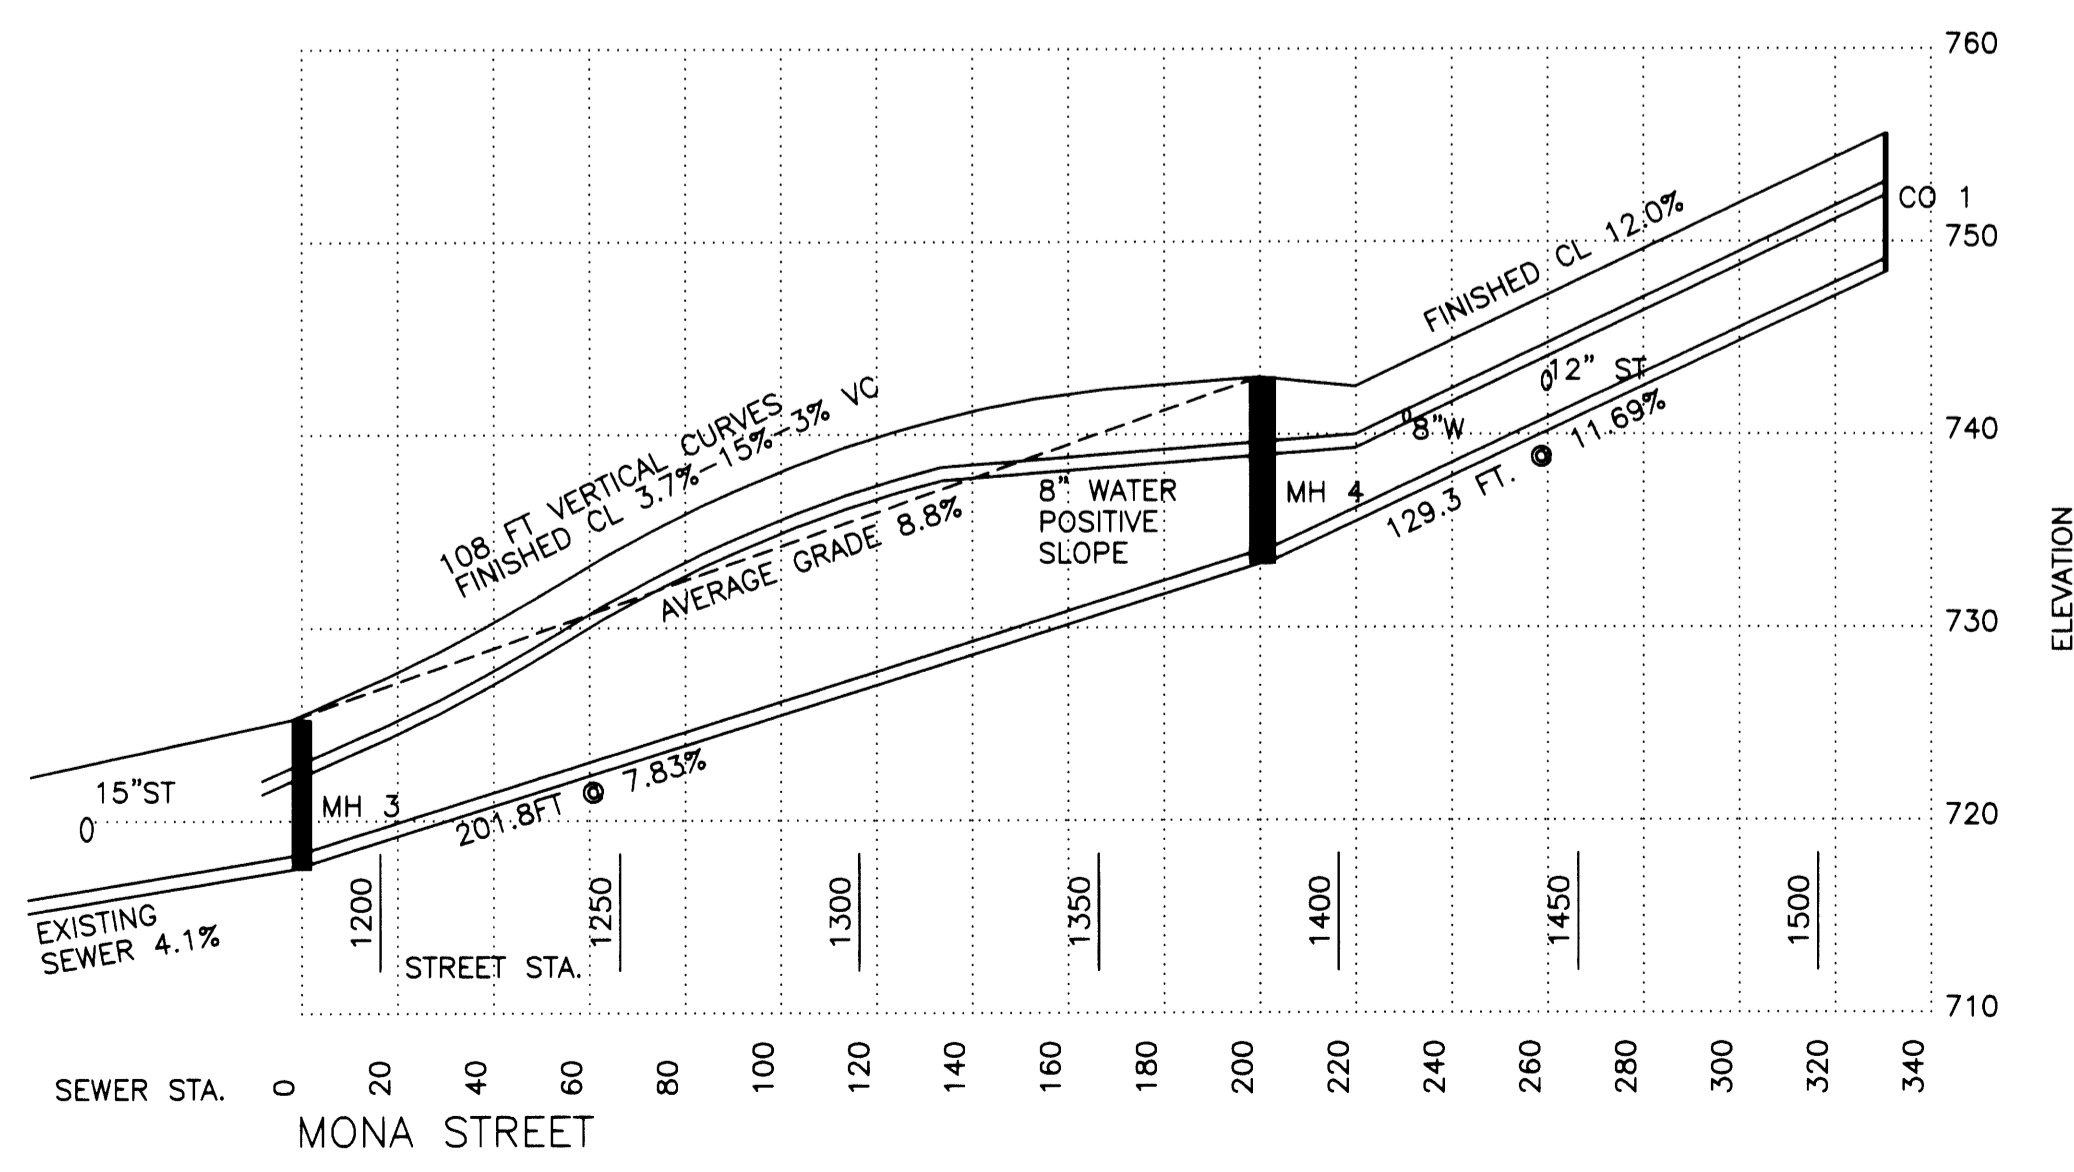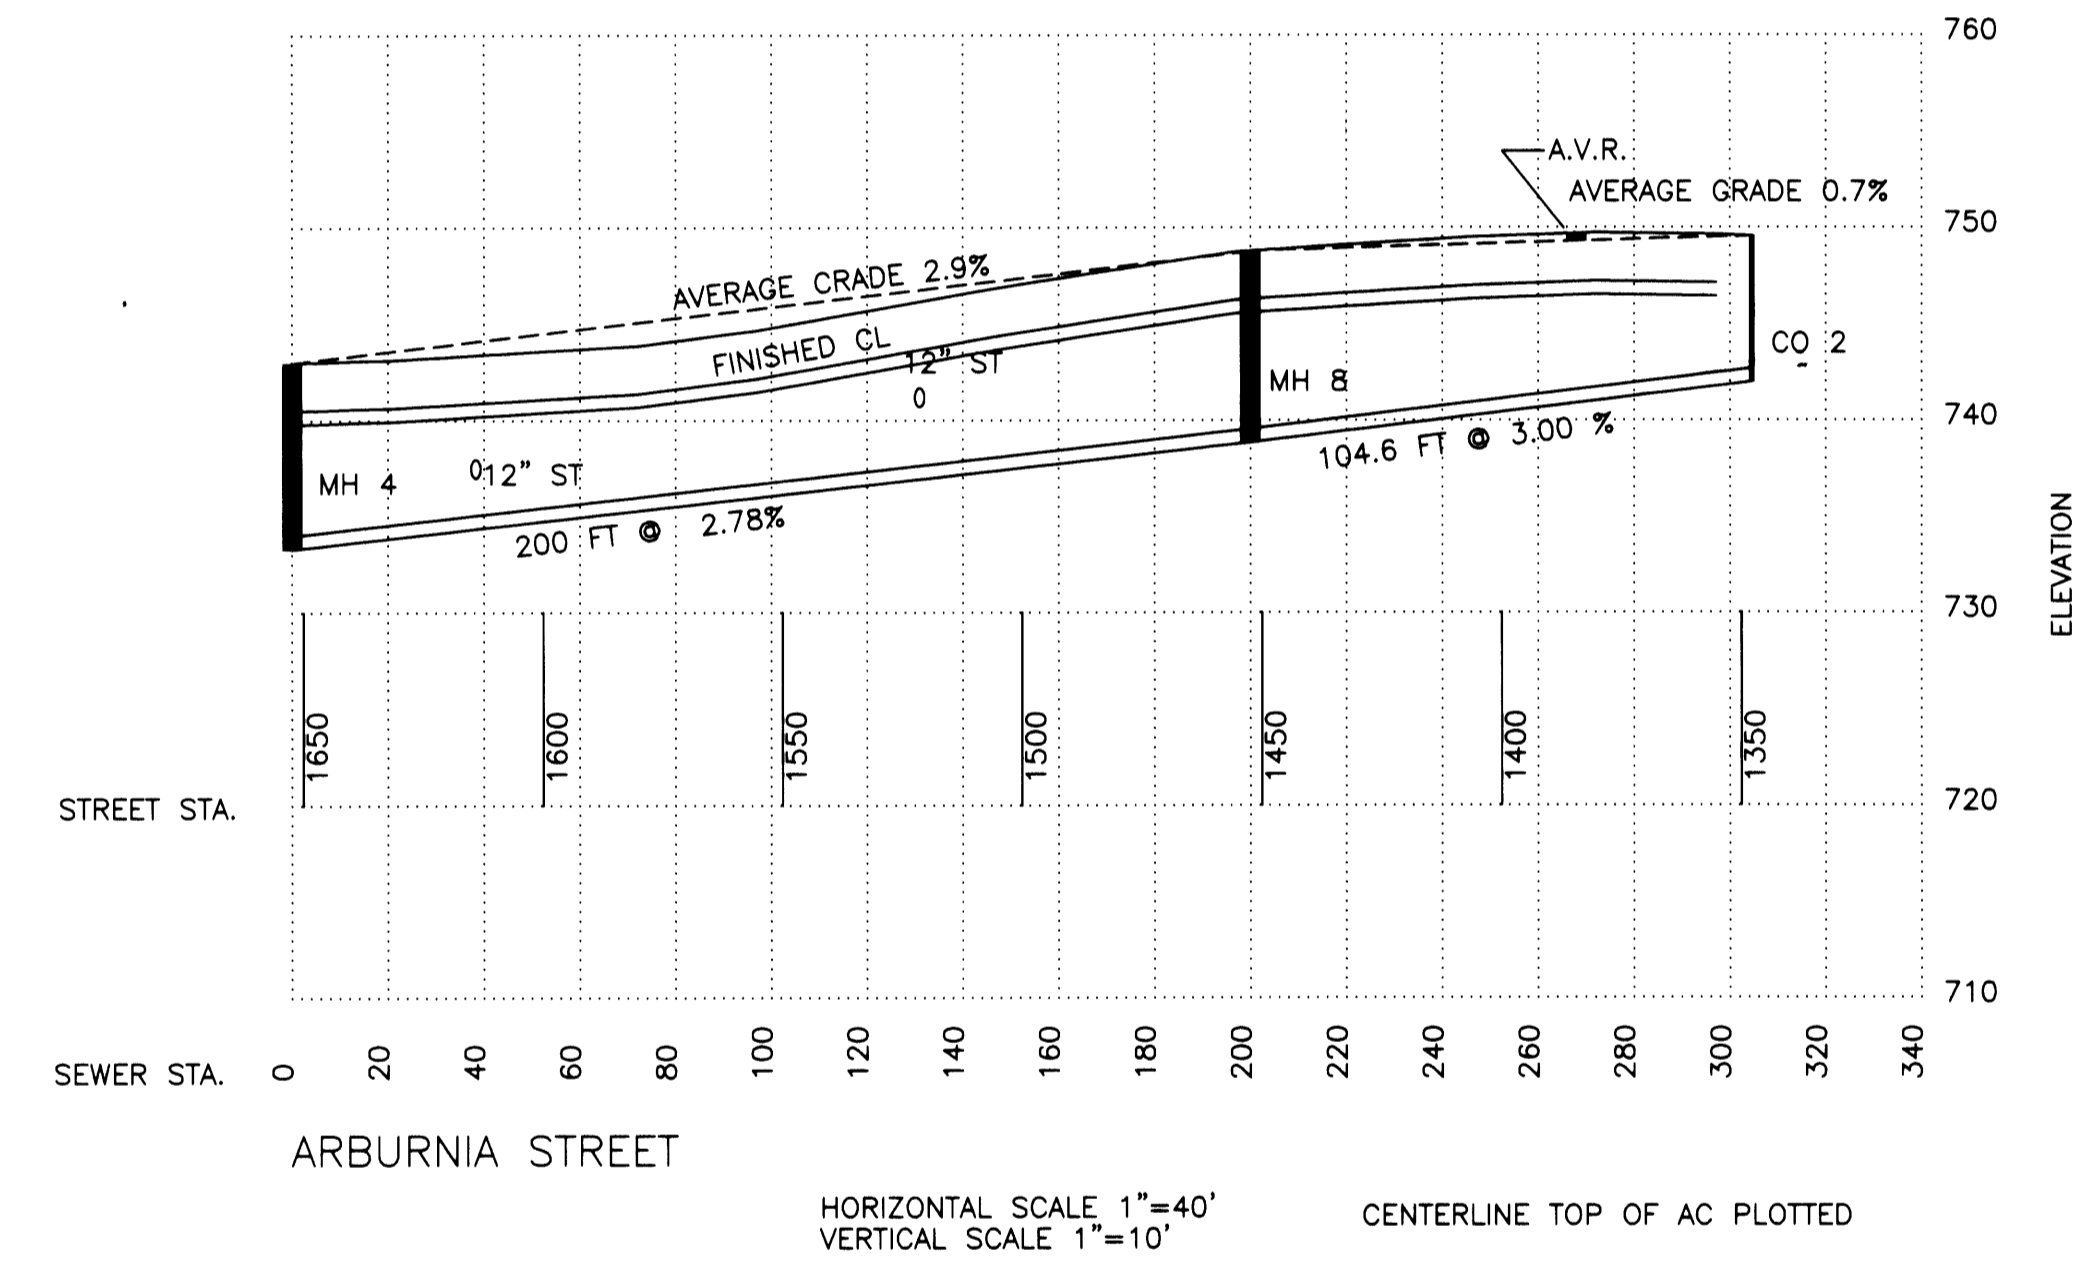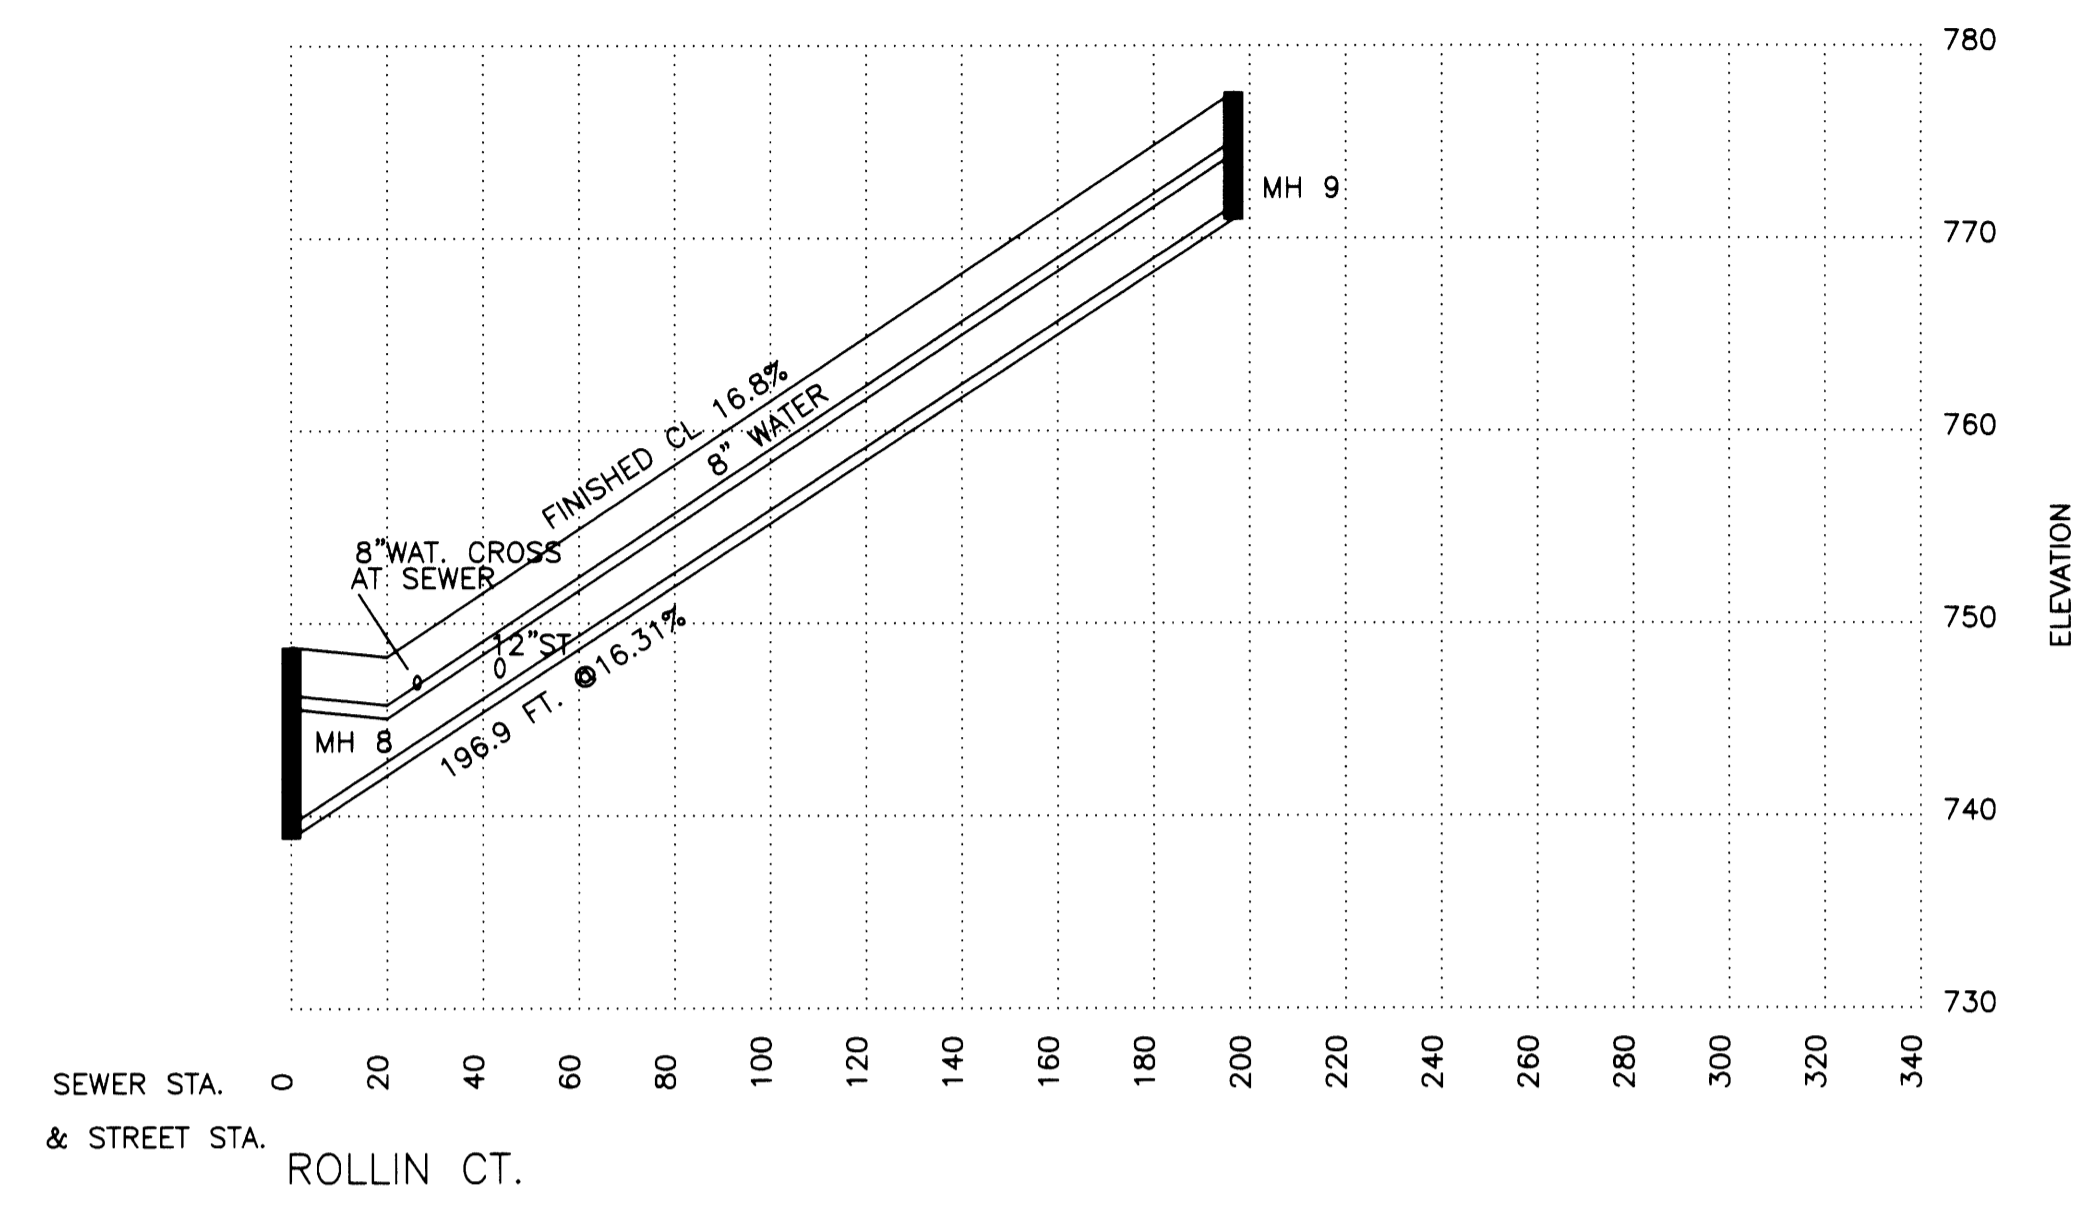

Co. Rd. # 907, 258G, 907B MP 0.22-0.31, 0.25-0.34, 0.00-0.03

**CO. RD. 907, 258G, & 907B SEWER**