

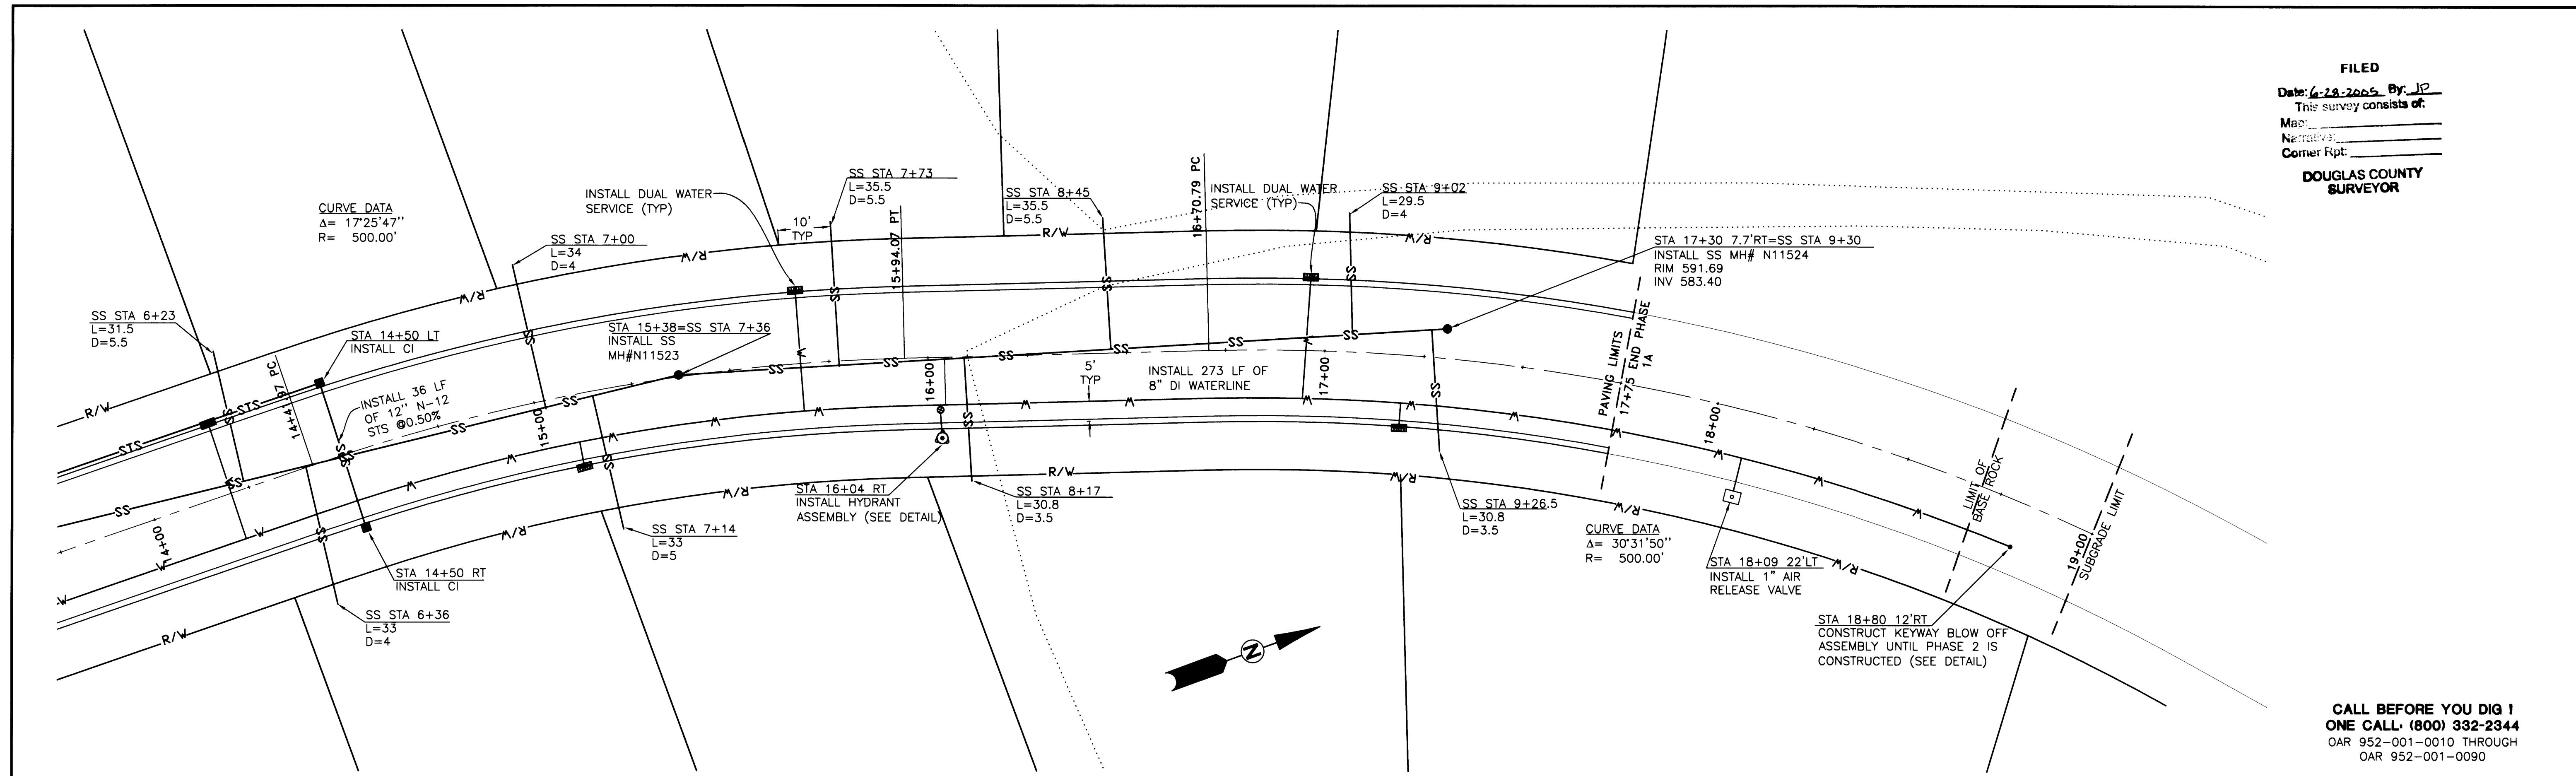


FILED  
 Date: 6-23-2005 By: J2  
 This survey consists of:  
 Map:  
 Narrative:  
 Corner Rpt:  
**DOUGLAS COUNTY SURVEYOR**

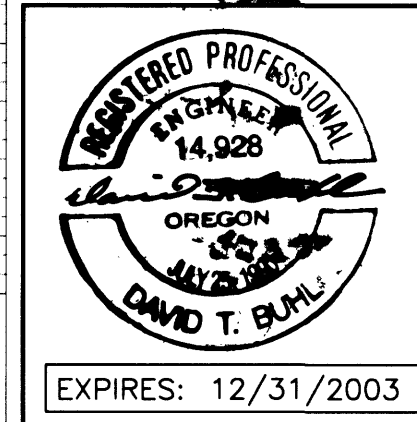

**CALL BEFORE YOU DIG !**  
 ONE CALL (800) 332-2344  
 OAR 952-001-0010 THROUGH  
 OAR 952-001-0090

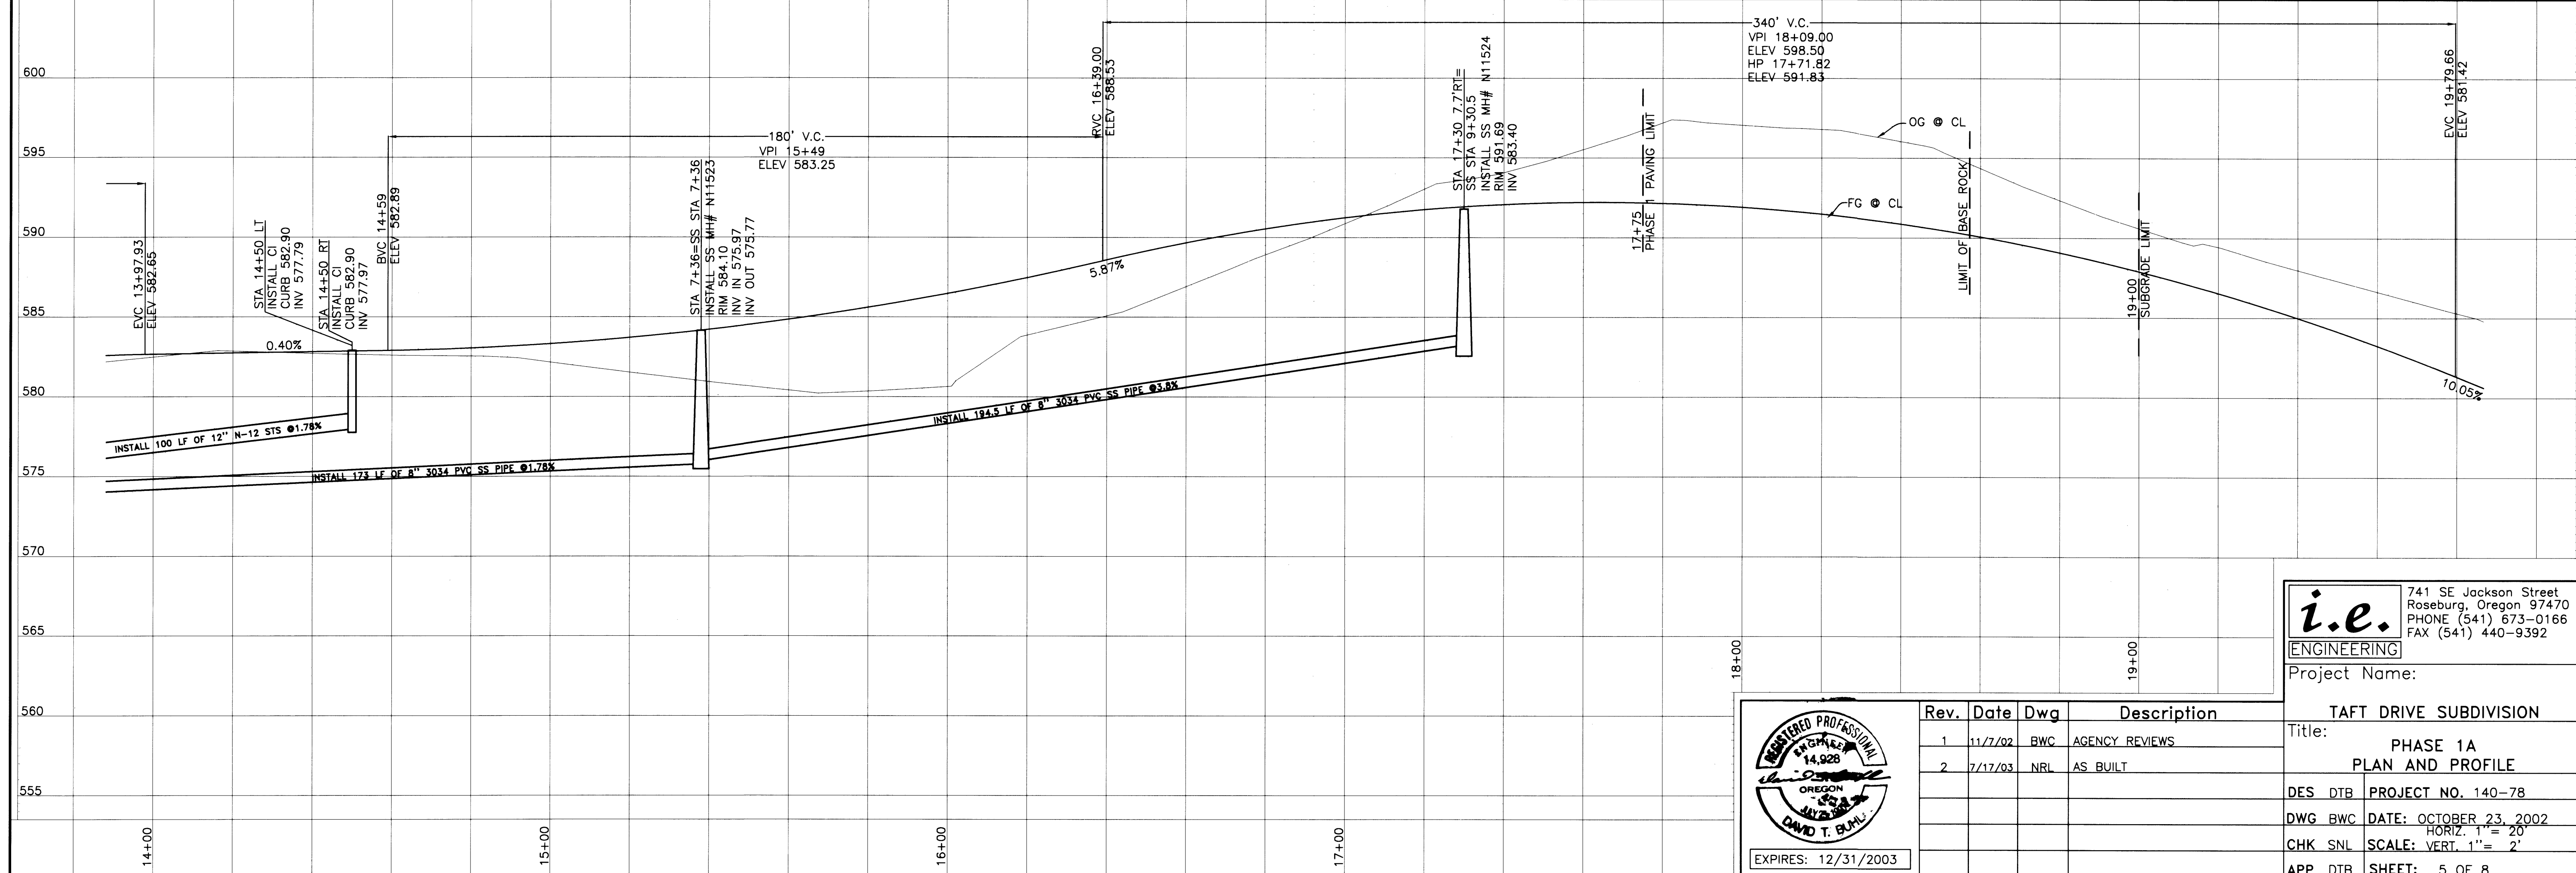

Rev.	Date	Dwg	Description
1	11/7/02	BWC	AGENCY REVIEWS
2	7/17/03	NRL	AS BUILT

**i.e.** ENGINEERING  
 741 SE Jackson Street  
 Roseburg, Oregon 97470  
 PHONE (541) 673-0166  
 FAX (541) 440-9392

Project Name: TAFT DRIVE SUBDIVISION  
 Title: PHASE 1A PLAN AND PROFILE  
 DES DTB PROJECT NO. 140-78  
 DWG BWC DATE: OCTOBER 23, 2002  
 CHK SNL SCALE: HORIZ. 1" = 20'  
 APP DTB SHEET: 5 OF 8

Co. Rd. # 908 M.P. 0.08 - 0.17

**CO. RD. #908 PLAN & PROFILE**

00080017

DO NOT DUPLICATE