
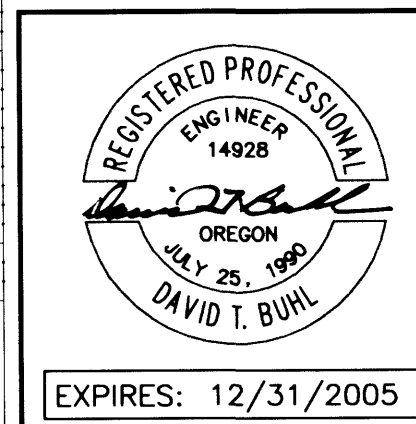


FILED
 Date: 6-28-2005 By: JP
 This survey consists of:
 Map:
 Narrative:
 Corner Rpt:
DOUGLAS COUNTY SURVEYOR

CALL BEFORE YOU DIG 1
 ONE CALL (800) 332-2344
 OAR 952-001-0010 THROUGH
 OAR 952-001-0090

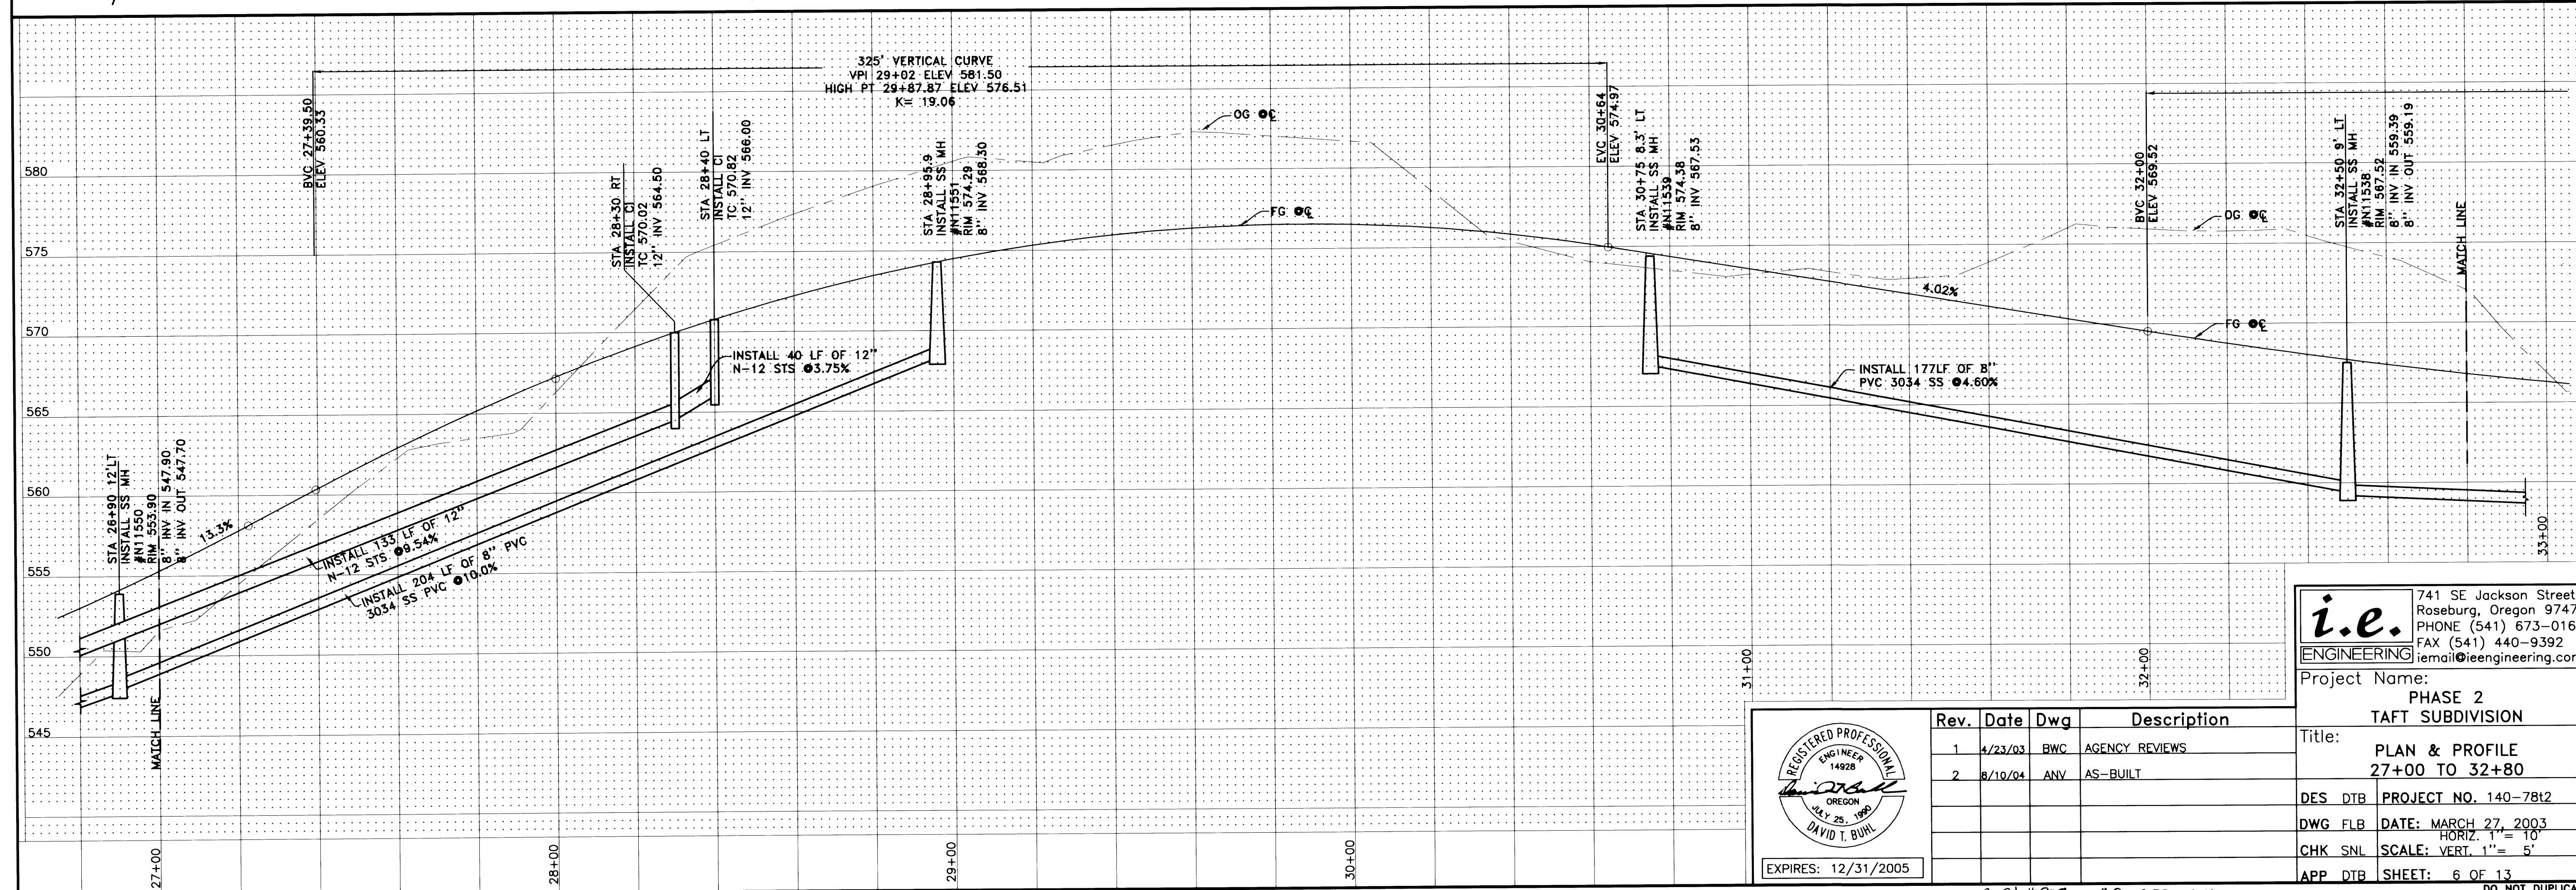

Rev.	Date	Dwg	Description
1	4/23/03	BWC	AGENCY REVIEWS
2	8/10/04	ANY	AS-BUILT

i.e. ENGINEERING
 741 SE Jackson Street
 Roseburg, Oregon 97470
 PHONE (541) 673-0166
 FAX (541) 440-9392
 iemail@ieengineering.com

Project Name: PHASE 2 TAFT SUBDIVISION
 Title: PLAN & PROFILE 27+00 TO 32+80
 DES DTB: PROJECT NO. 140-7812
 DWG FLB: DATE: MARCH 27, 2003
 CHK SNL: SCALE: HORIZ. 1" = 10'
 APP DTB: SHEET: 6 OF 13

Co. Rd. # 908 M.P. 0.32 - 0.40

CO. RD. #908 PLAN & PROFILE

00320040

DO NOT DUPLICATE