
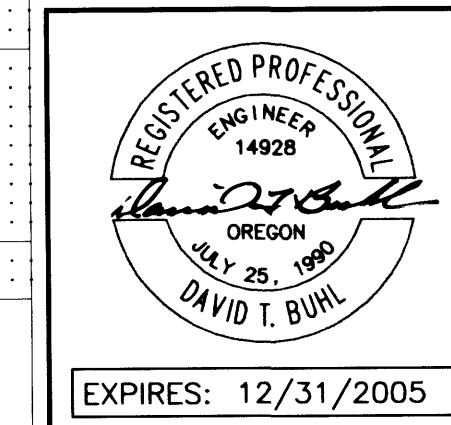
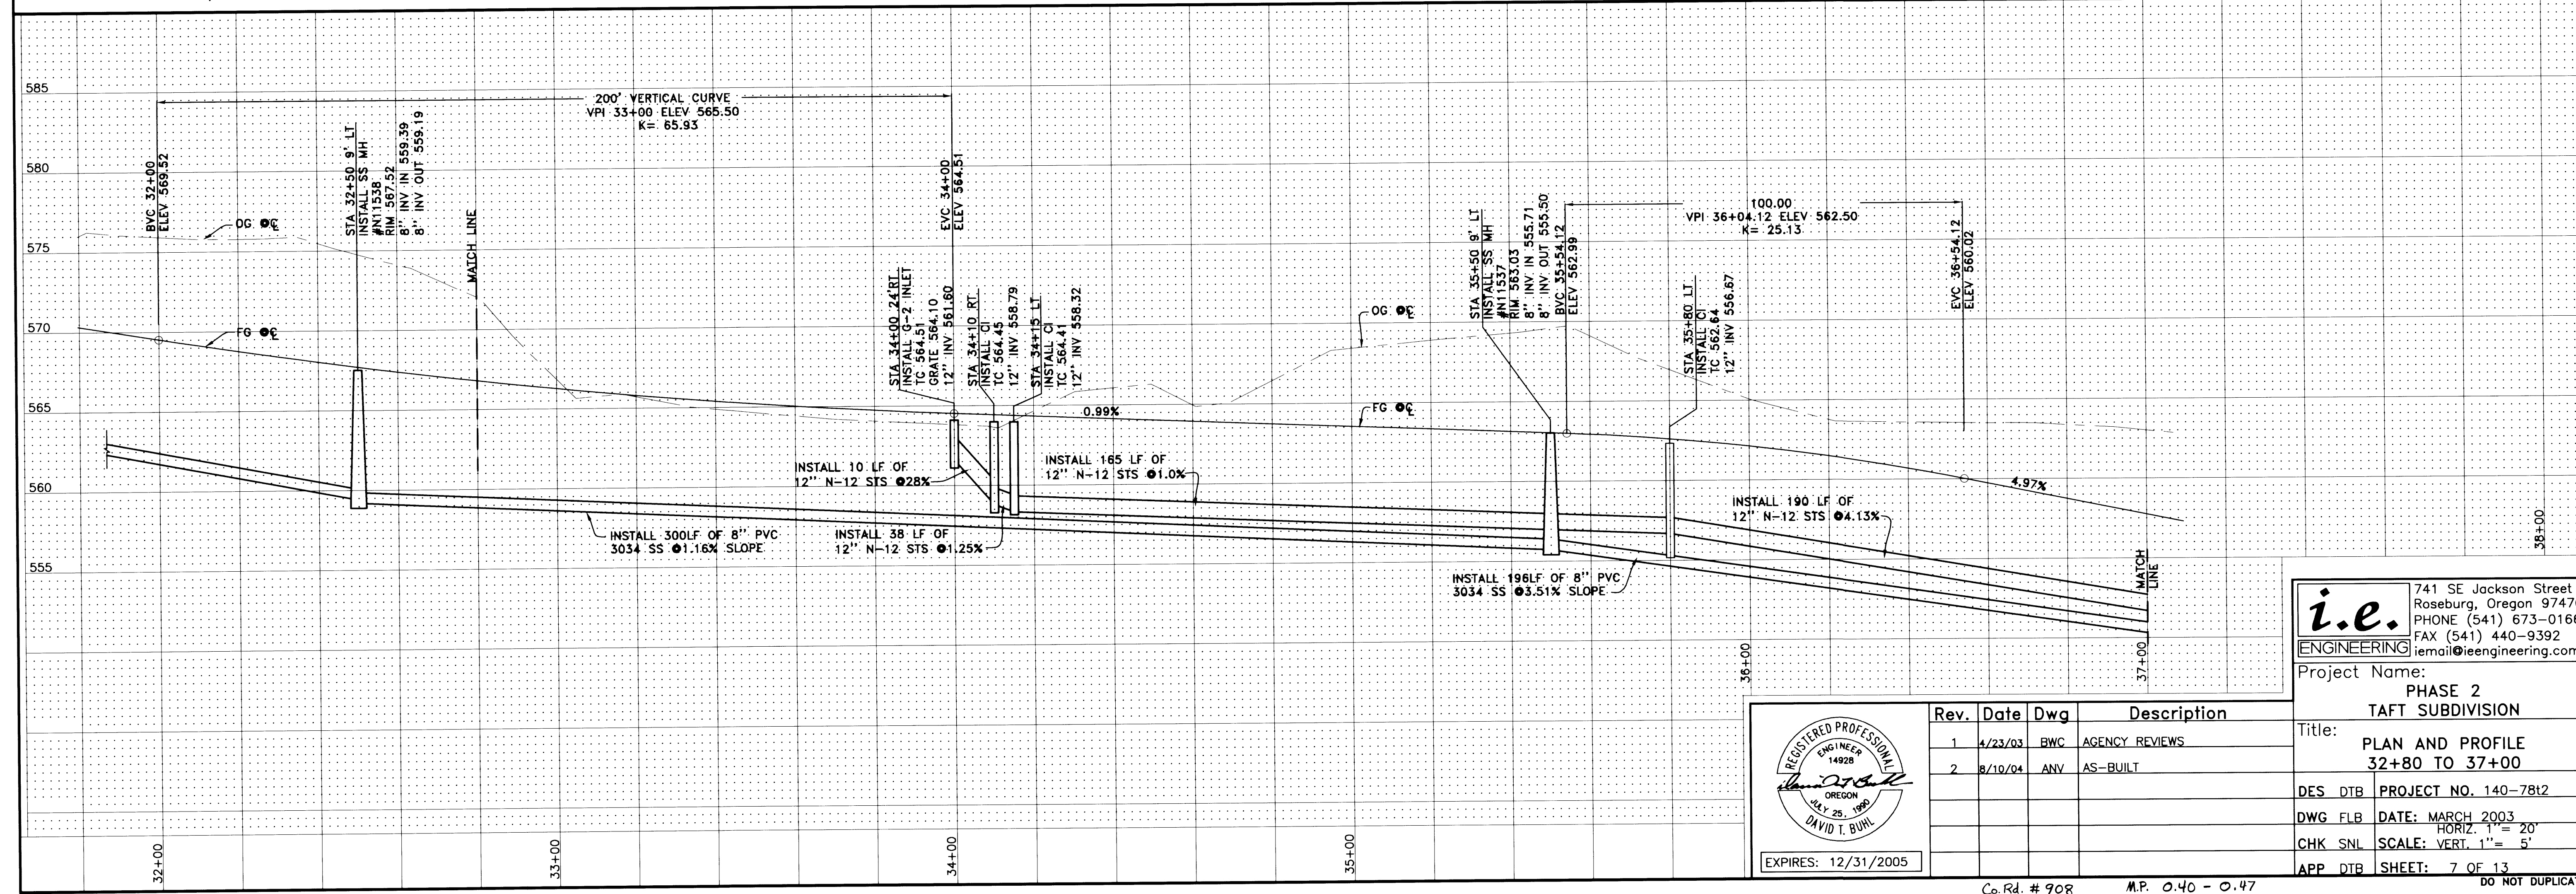


FILED
 Date: 6-28-2005
 This survey is based on:
 Map:
 No. and Date:
 Corrected by:
DOUGLAS COUNTY SURVEYOR

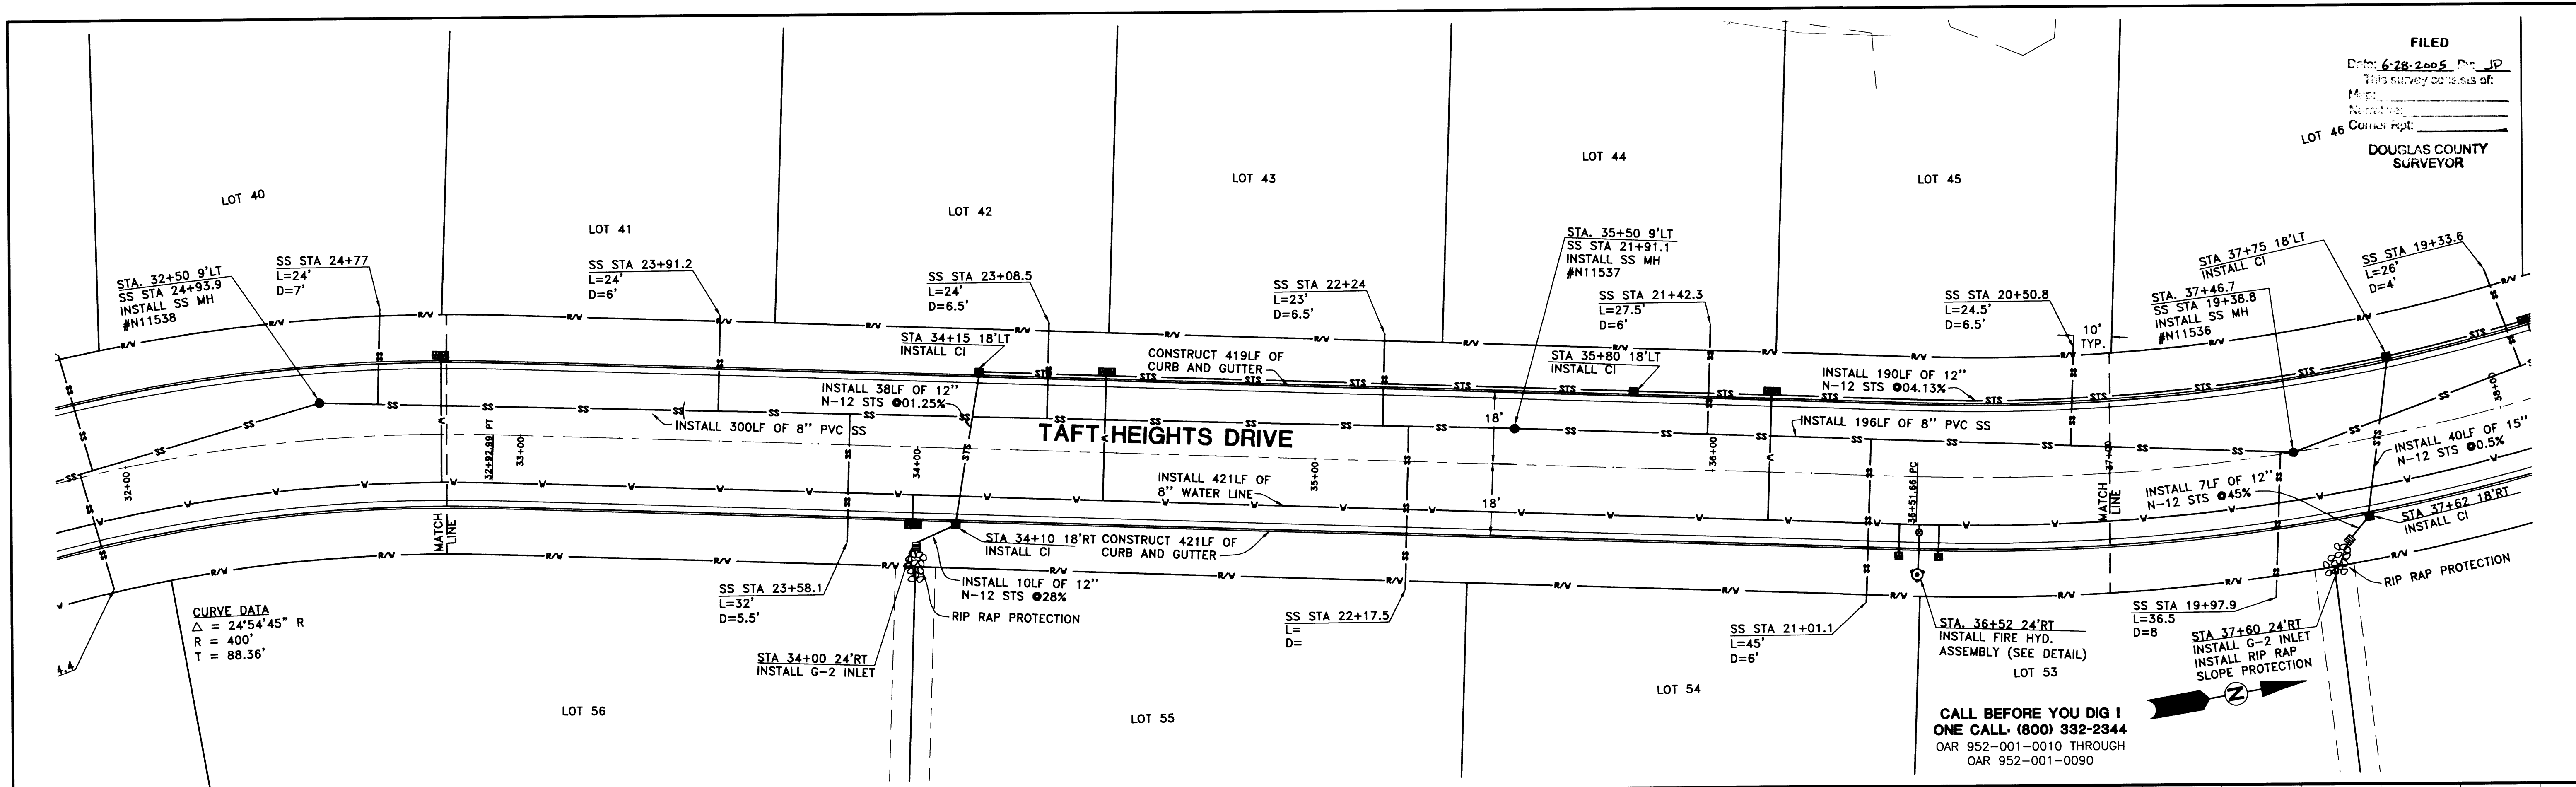

Rev.	Date	Dwg	Description
1	4/23/03	BWC	AGENCY REVIEWS
2	8/10/04	ANV	AS-BUILT

i.e. ENGINEERING
 741 SE Jackson Street
 Roseburg, Oregon 97470
 PHONE (541) 673-0166
 FAX (541) 440-9392
 Email: iemail@ieengineering.com

Project Name: PHASE 2 TAFT SUBDIVISION
 Title: PLAN AND PROFILE 32+80 TO 37+00
 DES DTB PROJECT NO. 140-7812
 DWG FLB DATE: MARCH 2003
 HORIZ. 1" = 20'
 CHK SNL SCALE: VERT. 1" = 5'
 APP DTB SHEET: 7 OF 13

Co. Rd. # 908 M.P. 0.40 - 0.47

CO. RD. #908 PLAN & PROFILE

00400047

DO NOT DUPLICATE