
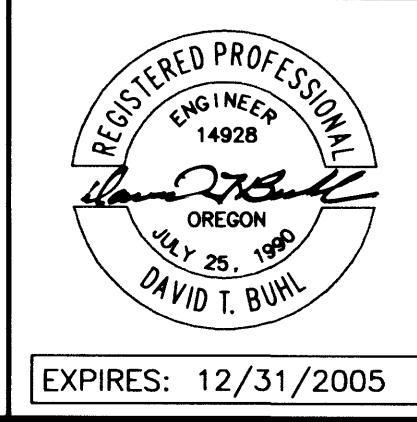


FILED
 Date: 4-24-2004 Pr. JP
 This project consists of:
 Map:
 No. of Sheets:
 Corner E.P.:
 DOUGLAS COUNTY
 SURVEYOR

CALL BEFORE YOU DIG I
 ONE CALL (800) 332-2344
 OAR 952-001-0010 THROUGH
 OAR 952-001-0090

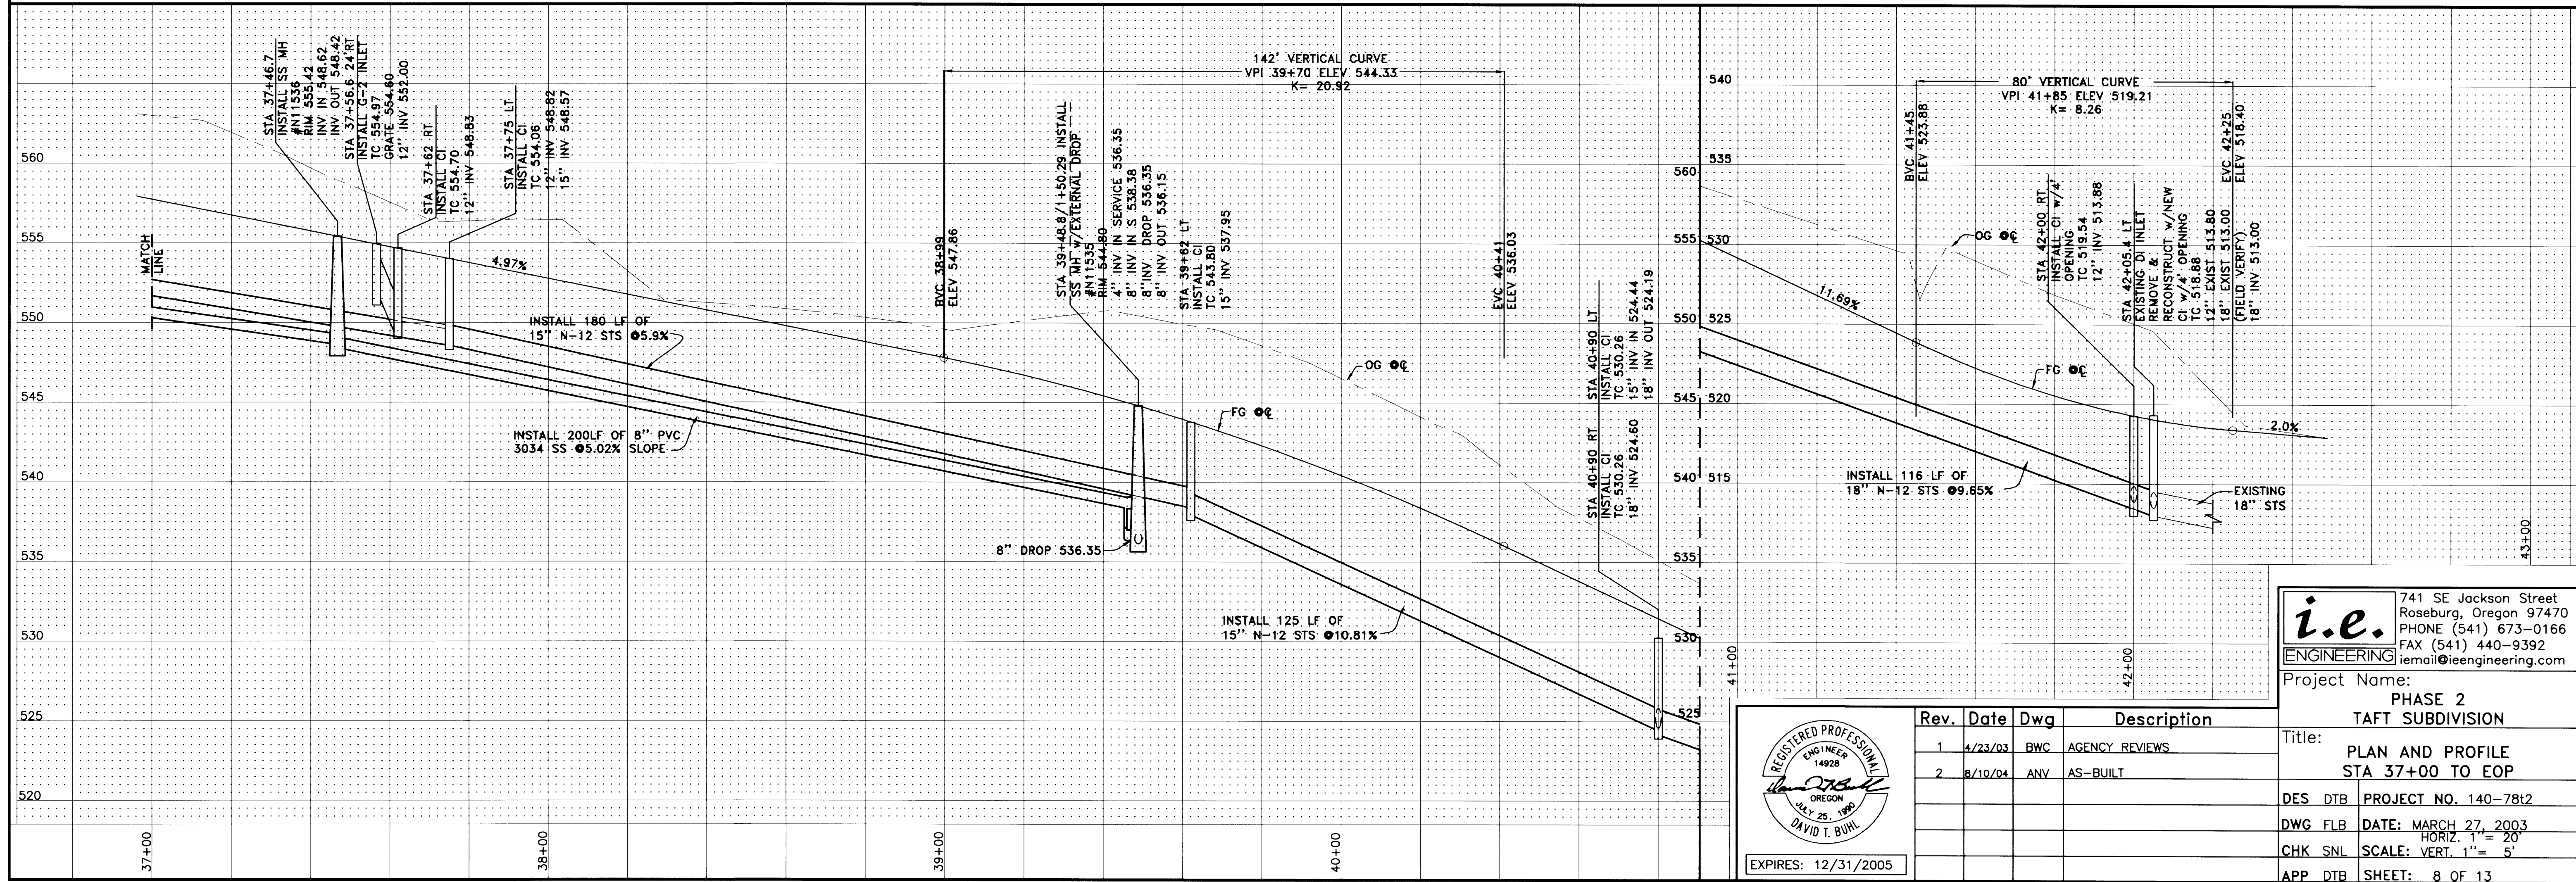

Rev.	Date	Dwg	Description
1	4/23/03	BWC	AGENCY REVIEWS
2	8/10/04	ANV	AS-BUILT

i.e. ENGINEERING
 741 SE Jackson Street
 Roseburg, Oregon 97470
 PHONE (541) 673-0166
 FAX (541) 440-9392
 email@ieengineering.com

Project Name:
**PHASE 2
 TAFT SUBDIVISION**

Title:
**PLAN AND PROFILE
 STA 37+00 TO EOP**

DES DTB PROJECT NO. 140-78t2
 DWG FLB DATE: MARCH 27, 2003
 CHK SNL HORIZ. 1" = 20'
 APP DTB SCALE: VERT. 1" = 5'
 SHEET: 8 OF 13

Co. Rd. #908 M.P. 0.47 - 0.58 DO NOT DUPLICATE

CO. RD. #908 PLAN & PROFILE

00470058