

FILED
 Date: 6-28-2005 By: JP
 This survey consists of:
 Map:
 Name:
 Corner Rpt:
 DOUGLAS COUNTY
 SURVEYOR

NOTE: SEE EROSION CONTROL DETAILS
 (SHEET #8)

NOTE: CITY OF ROSEBURG WATER
 DISTRICT MAXIMUM SERVICE ELEVATION
 610: FINISH FLOOR ELEVATIONS SHALL
 NOT EXCEED ELEVATION OF 605'.


— SILT FENCE
 ■ STRAW BALE

CALL BEFORE YOU DIG 1
 ONE CALL (800) 332-2344
 OAR 952-001-0010 THROUGH
 OAR 952-001-0090

i.e. ENGINEERING
 741 SE Jackson Street
 Roseburg, Oregon 97470
 PHONE (541) 673-0166
 FAX (541) 440-9392
 email@ieengineering.com

Project Name: TAFT DRIVE SUBDIVISION

Title:	PHASE 1A SITE & EROSION CONTROL
DES DTB	PROJECT NO. 140-78
DWG BWC	DATE: OCTOBER 23, 2002
CHK SNL	SCALE: 1" = 40'
APP DTB	SHEET: 3 OF 8

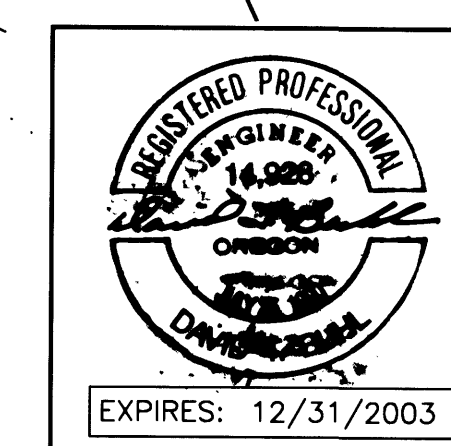



Rev.	Date	Dwg	Description
1	11/7/02	BWC	AGENCY REVIEWS
2	8/12/03	NRL	AS-BUILTS

Co. Rd. #908 M.P. 0.00 - 0.17

DO NOT DUPLICATE

CO. RD. #908 SITE & EROSION CONTROL

R908EROS

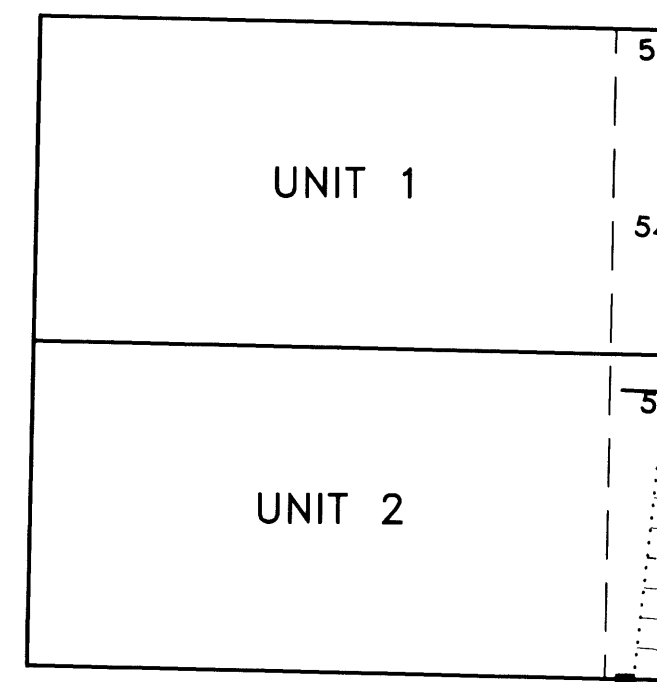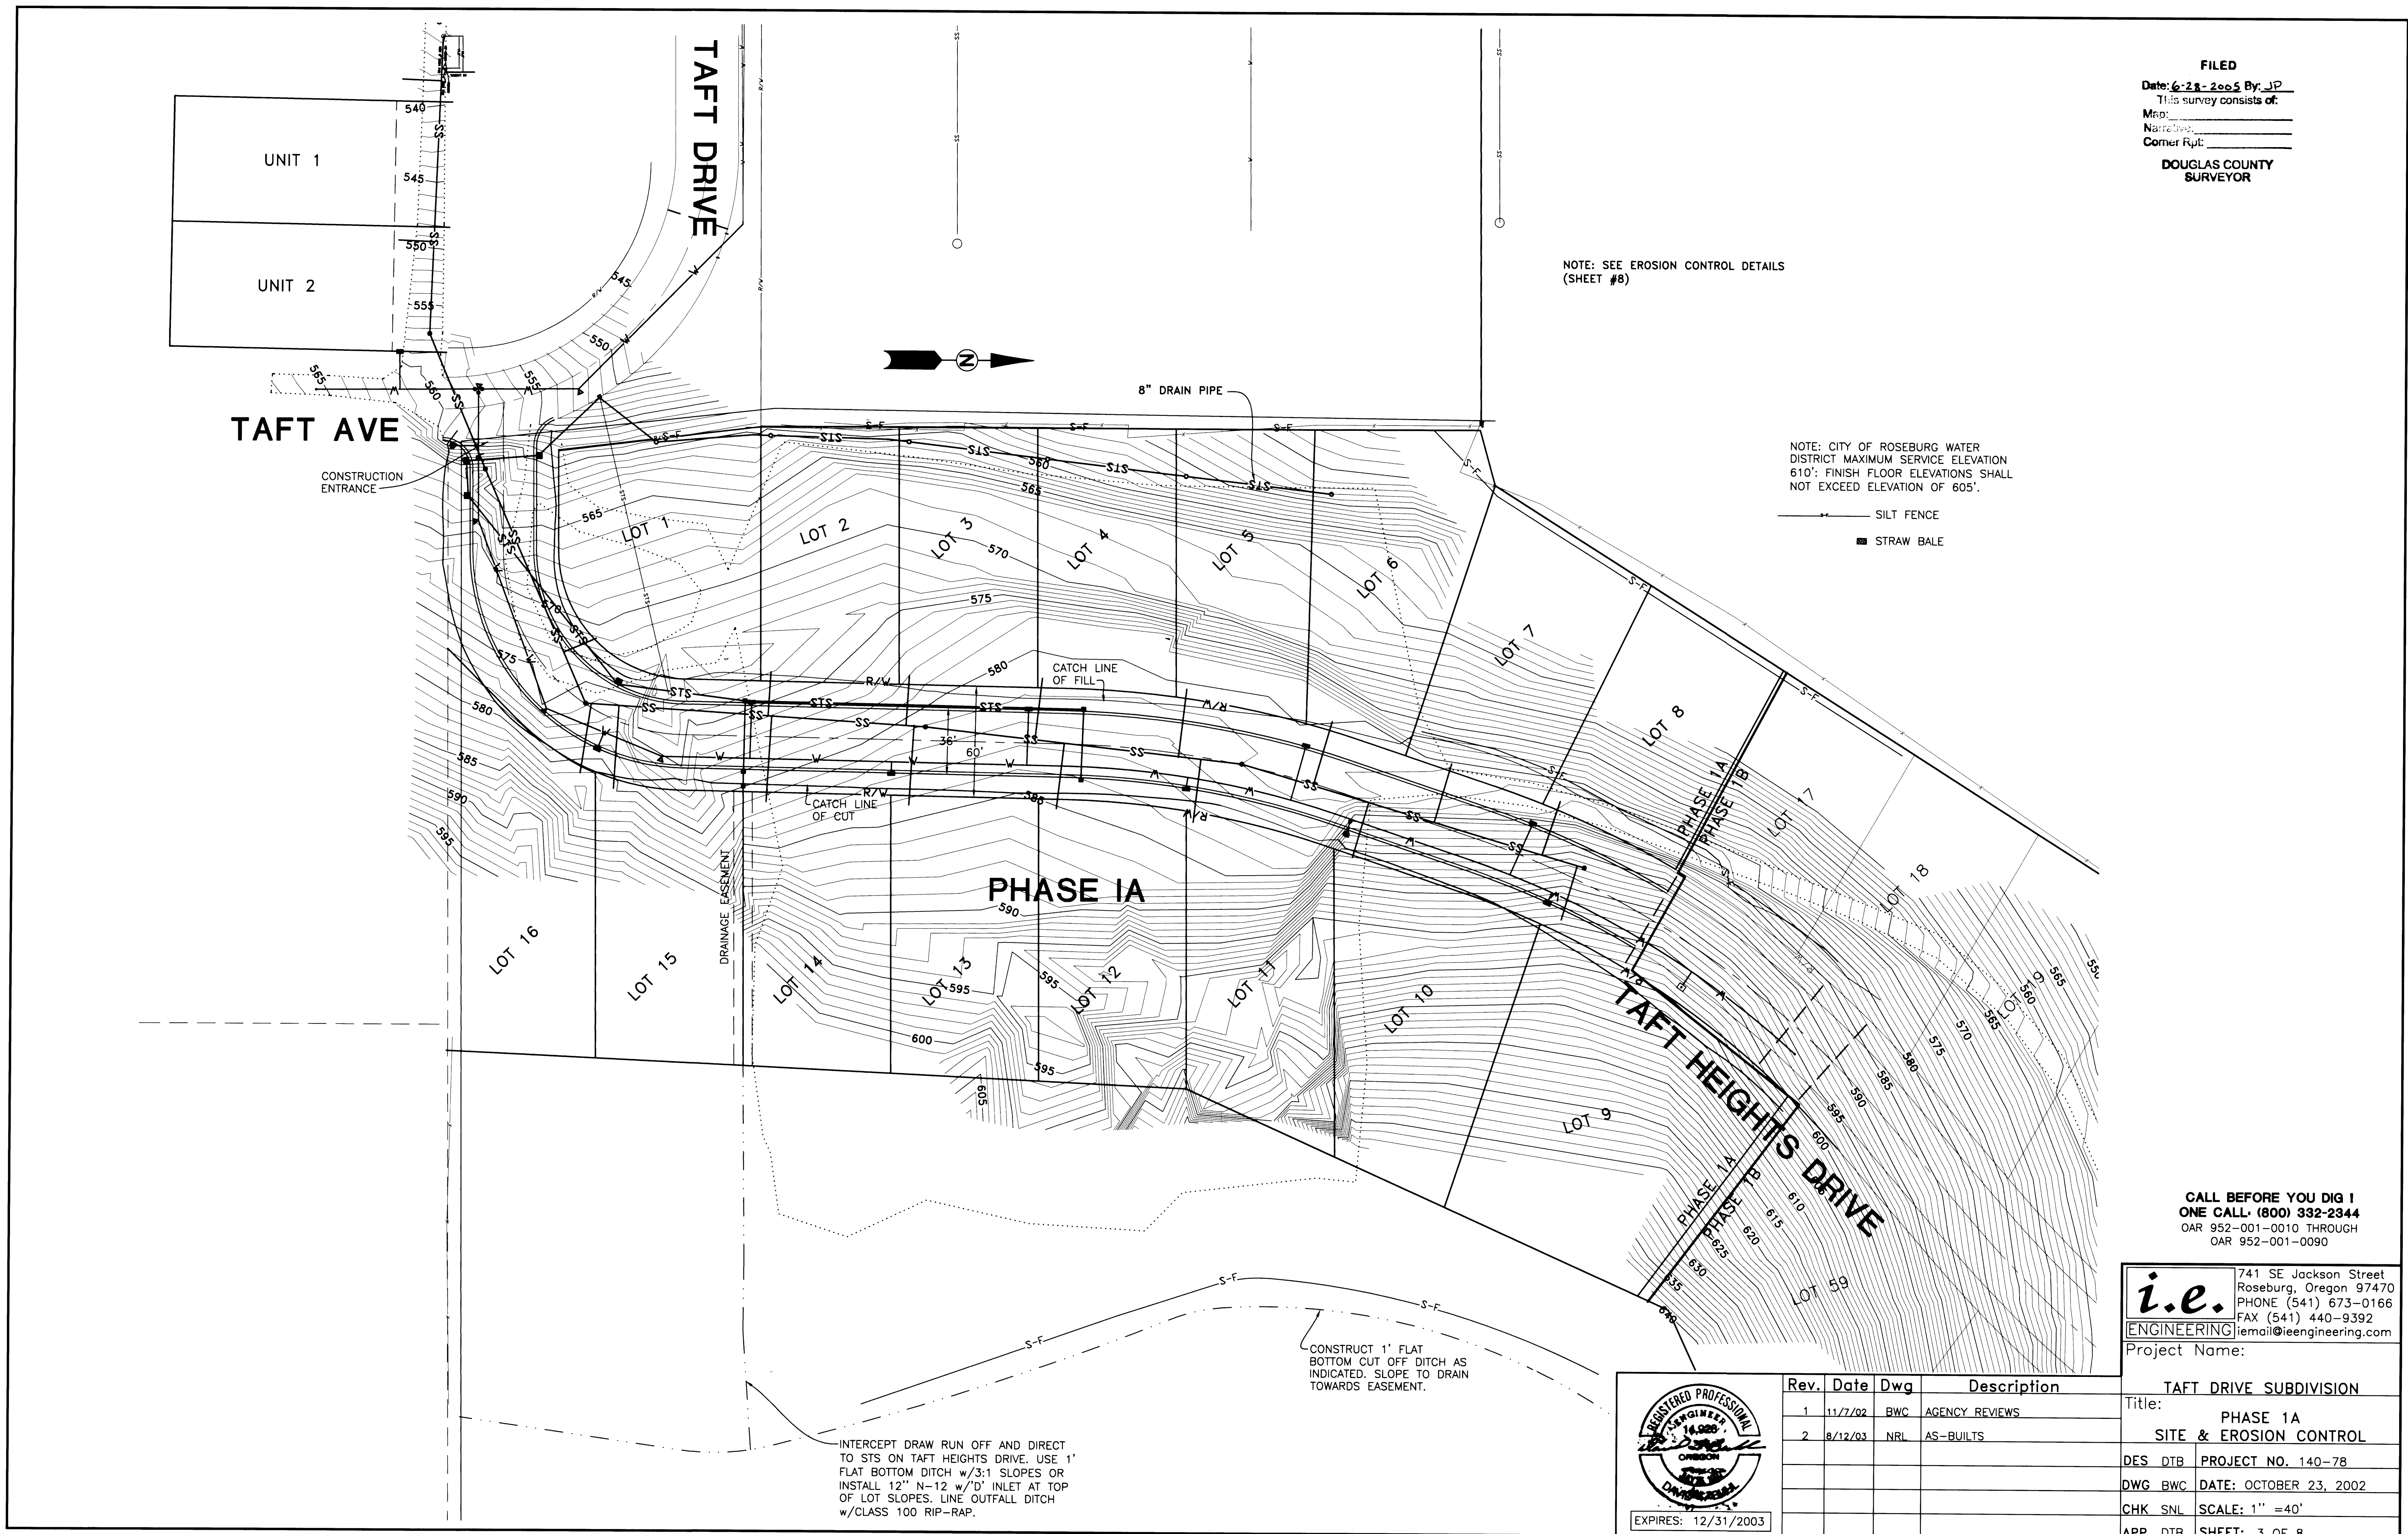

TAFT AVE

TAFT DRIVE

PHASE IA

TAFT HEIGHTS DRIVE

CONSTRUCTION ENTRANCE

8" DRAIN PIPE

CATCH LINE OF FILL

CATCH LINE OF CUT

CONSTRUCT 1' FLAT BOTTOM CUT OFF DITCH AS INDICATED. SLOPE TO DRAIN TOWARDS EASEMENT.

INTERCEPT DRAW RUN OFF AND DIRECT TO STS ON TAFT HEIGHTS DRIVE. USE 1' FLAT BOTTOM DITCH w/3:1 SLOPES OR INSTALL 12" N-12 w/D' INLET AT TOP OF LOT SLOPES. LINE OUTFALL DITCH w/CLASS 100 RIP-RAP.