
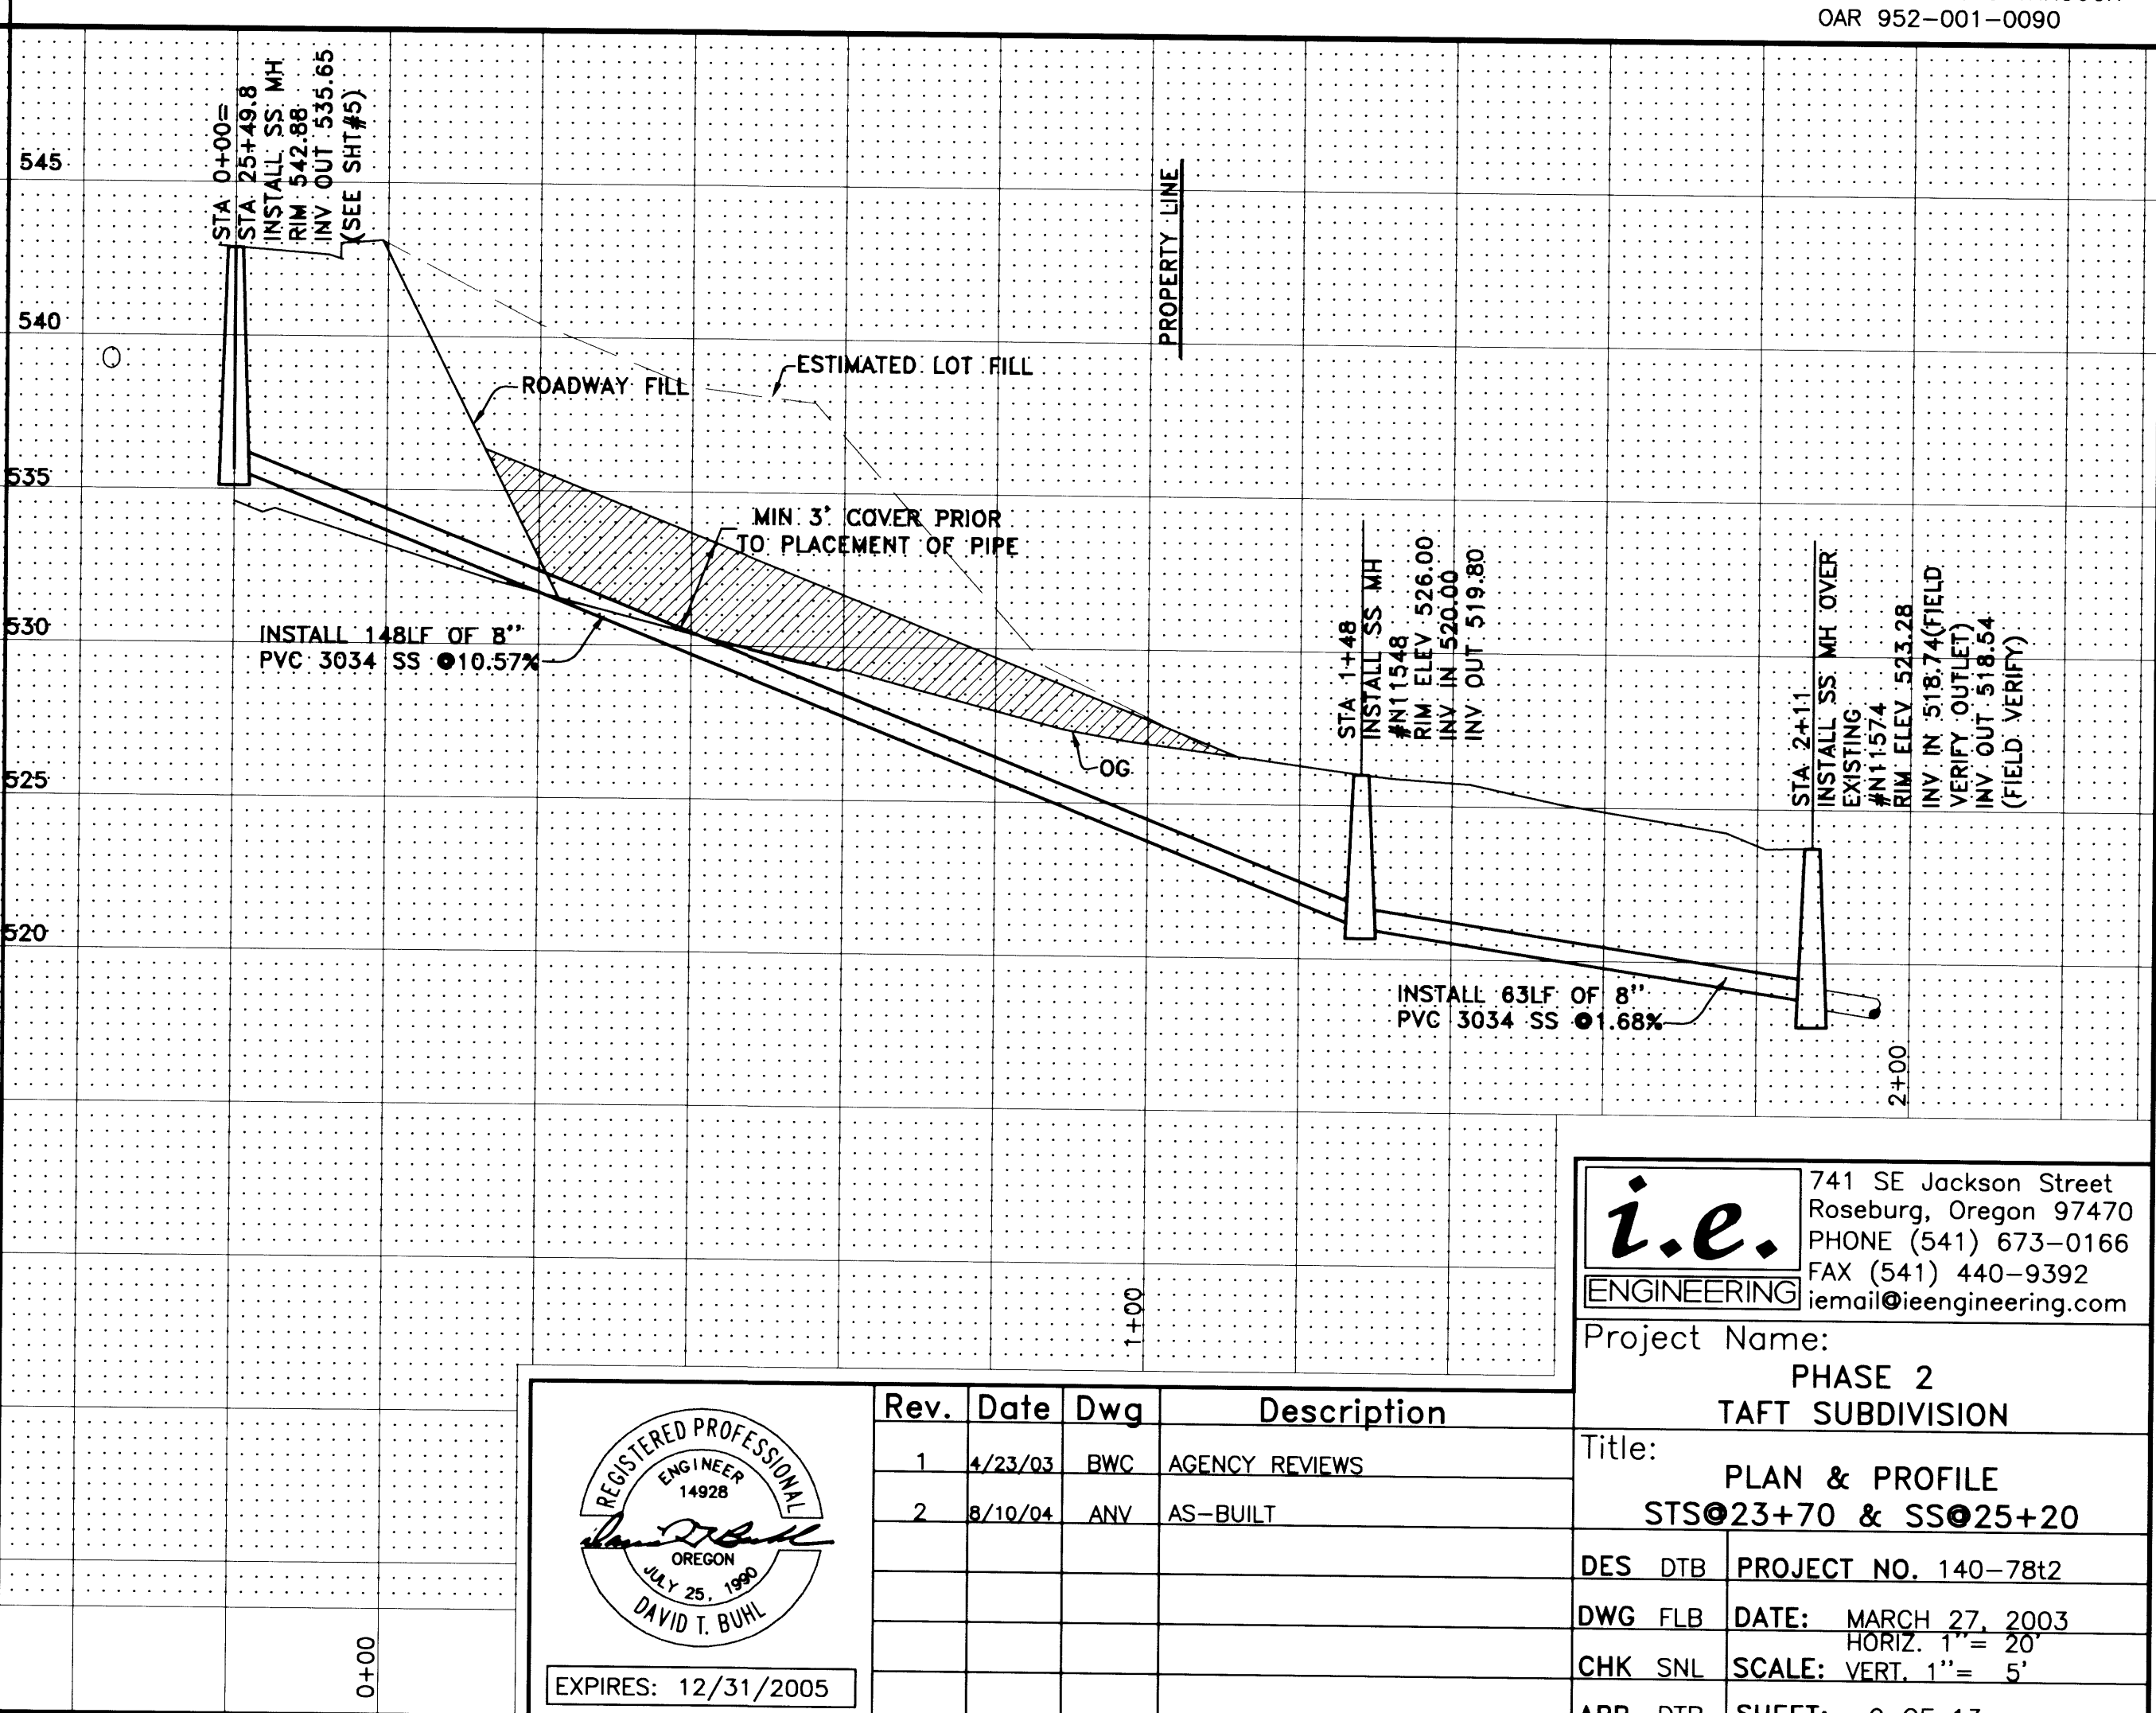


FILED
 Date: 6-28-2005, P. 3P
 This survey consists of:
 Map:
 Narrative:
 Corner Rpt:
 DOUGLAS COUNTY
 SURVEYOR

CALL BEFORE YOU DIG 1
 ONE CALL (800) 332-2344
 OAR 952-001-0010 THROUGH
 OAR 952-001-0090

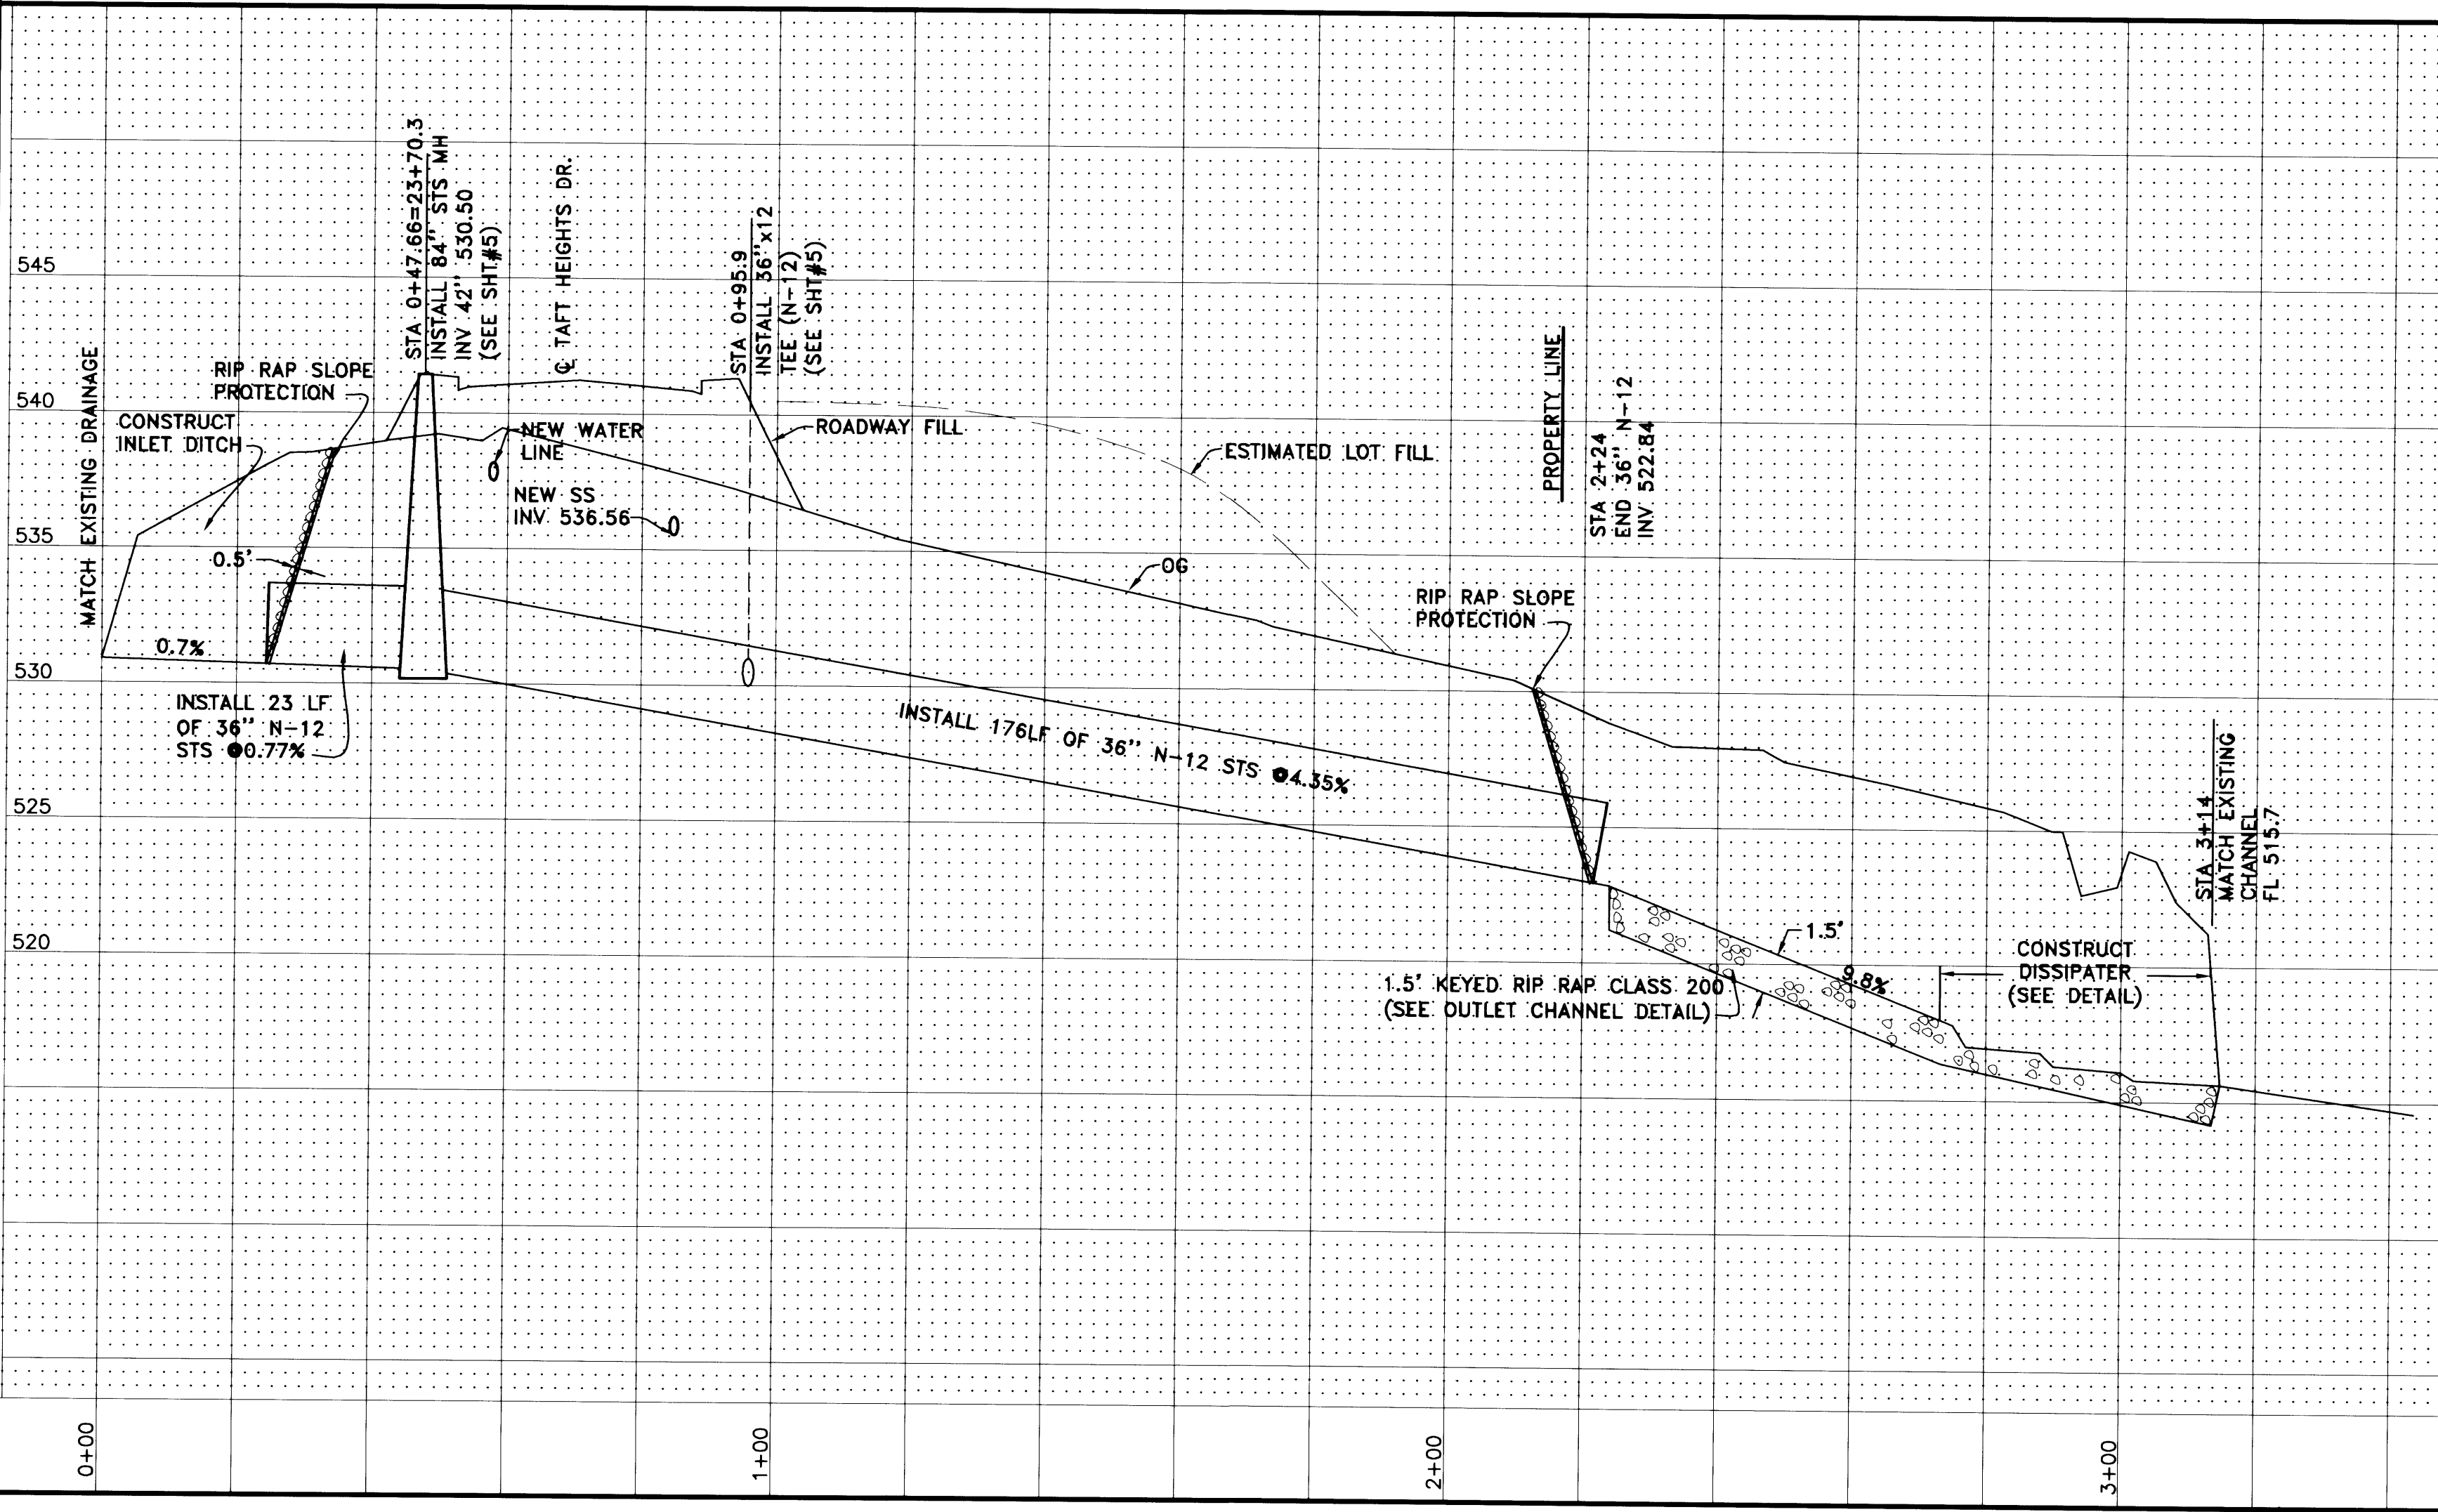


i.e.
 ENGINEERING
 741 SE Jackson Street
 Roseburg, Oregon 97470
 PHONE (541) 673-0166
 FAX (541) 440-9392
 email@ieengineering.com

Project Name:
 PHASE 2
 TAFT SUBDIVISION

Title:
 PLAN & PROFILE
 STS@23+70 & SS@25+20

DES DTB	PROJECT NO. 140-7812
DWG FLB	DATE: MARCH 27, 2003
CHK SNL	HORIZ. 1" = 20'
APP DTB	SCALE: VERT. 1" = 5'
	SHEET: 9 OF 13

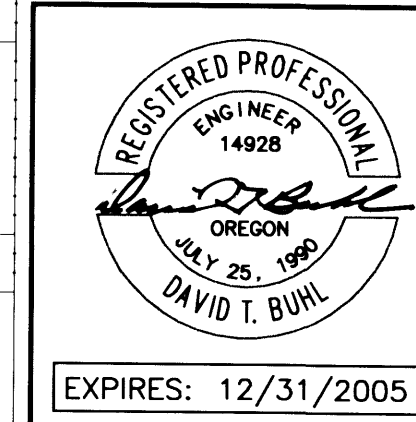

Rev.	Date	Dwg	Description
1	4/23/03	BWC	AGENCY REVIEWS
2	8/10/04	ANY	AS-BUILT

Co. Rd. # 908 M.P. 0.17 - 0.58

CO. RD. #908 PLAN & PROFILE ST. SEWER & SEWER

R908PROF