

FILED  
 Date: 6-28-2005 By: JJ  
 This survey consists of:  
 Map: \_\_\_\_\_  
 Narrative: \_\_\_\_\_  
 Corner Rpt: \_\_\_\_\_  
**DOUGLAS COUNTY**  
**SURVEYOR**

PHASE IA - LOTS 1 - 16  
 PHASE IB - LOTS 17-33  
 PHASE II - LOTS 34 - 59  
 PHASE III - LOTS 60 - 116


**CALL BEFORE YOU DIG !**  
**ONE CALL: (800) 332-2344**  
 OAR 952-001-0010 THROUGH  
 OAR 952-001-0090

**i.e.** ENGINEERING  
 741 SE Jackson Street  
 Roseburg, Oregon 97470  
 PHONE (541) 673-0166  
 FAX (541) 440-9392  
 Email: iemail@ieengineering.com

Project Name: **PHASE 2 TAFT SUBDIVISION**

Title: **OVERALL SITE PLAN**

DES	DTB	PROJECT NO. 140-7812
DWG	FLB	DATE: MARCH 27, 2003
CHK	SNL	SCALE: 1" = 100'
APP	DTB	SHEET: 2 OF 13

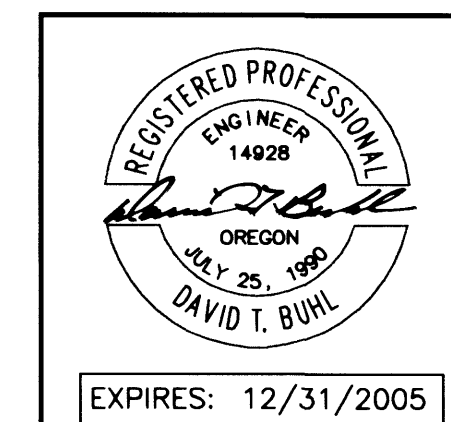

Rev.	Date	Dwg	Description
1	4/23/03	BWC	AGENCY REVIEWS
2	8/10/04	ANV	AS-BUILT

Cs. Rd. # 908 M.P. 0.17 - 0.58

**CO. RD. #908 OVERALL SITE PLAN**

R908SIT2

DO NOT DUPLICATE