


**CALL BEFORE YOU DIG!**  
 ONE CALL: (800) 332-2344  
 OAR 952-001-0010 THROUGH  
 OAR 952-001-0090

CITY OF ROSEBURG  
 Public Works Dept.  
 Development Plan Review

Approved for Development     Approved with Conditions

By: \_\_\_\_\_  
 Date: \_\_\_\_\_

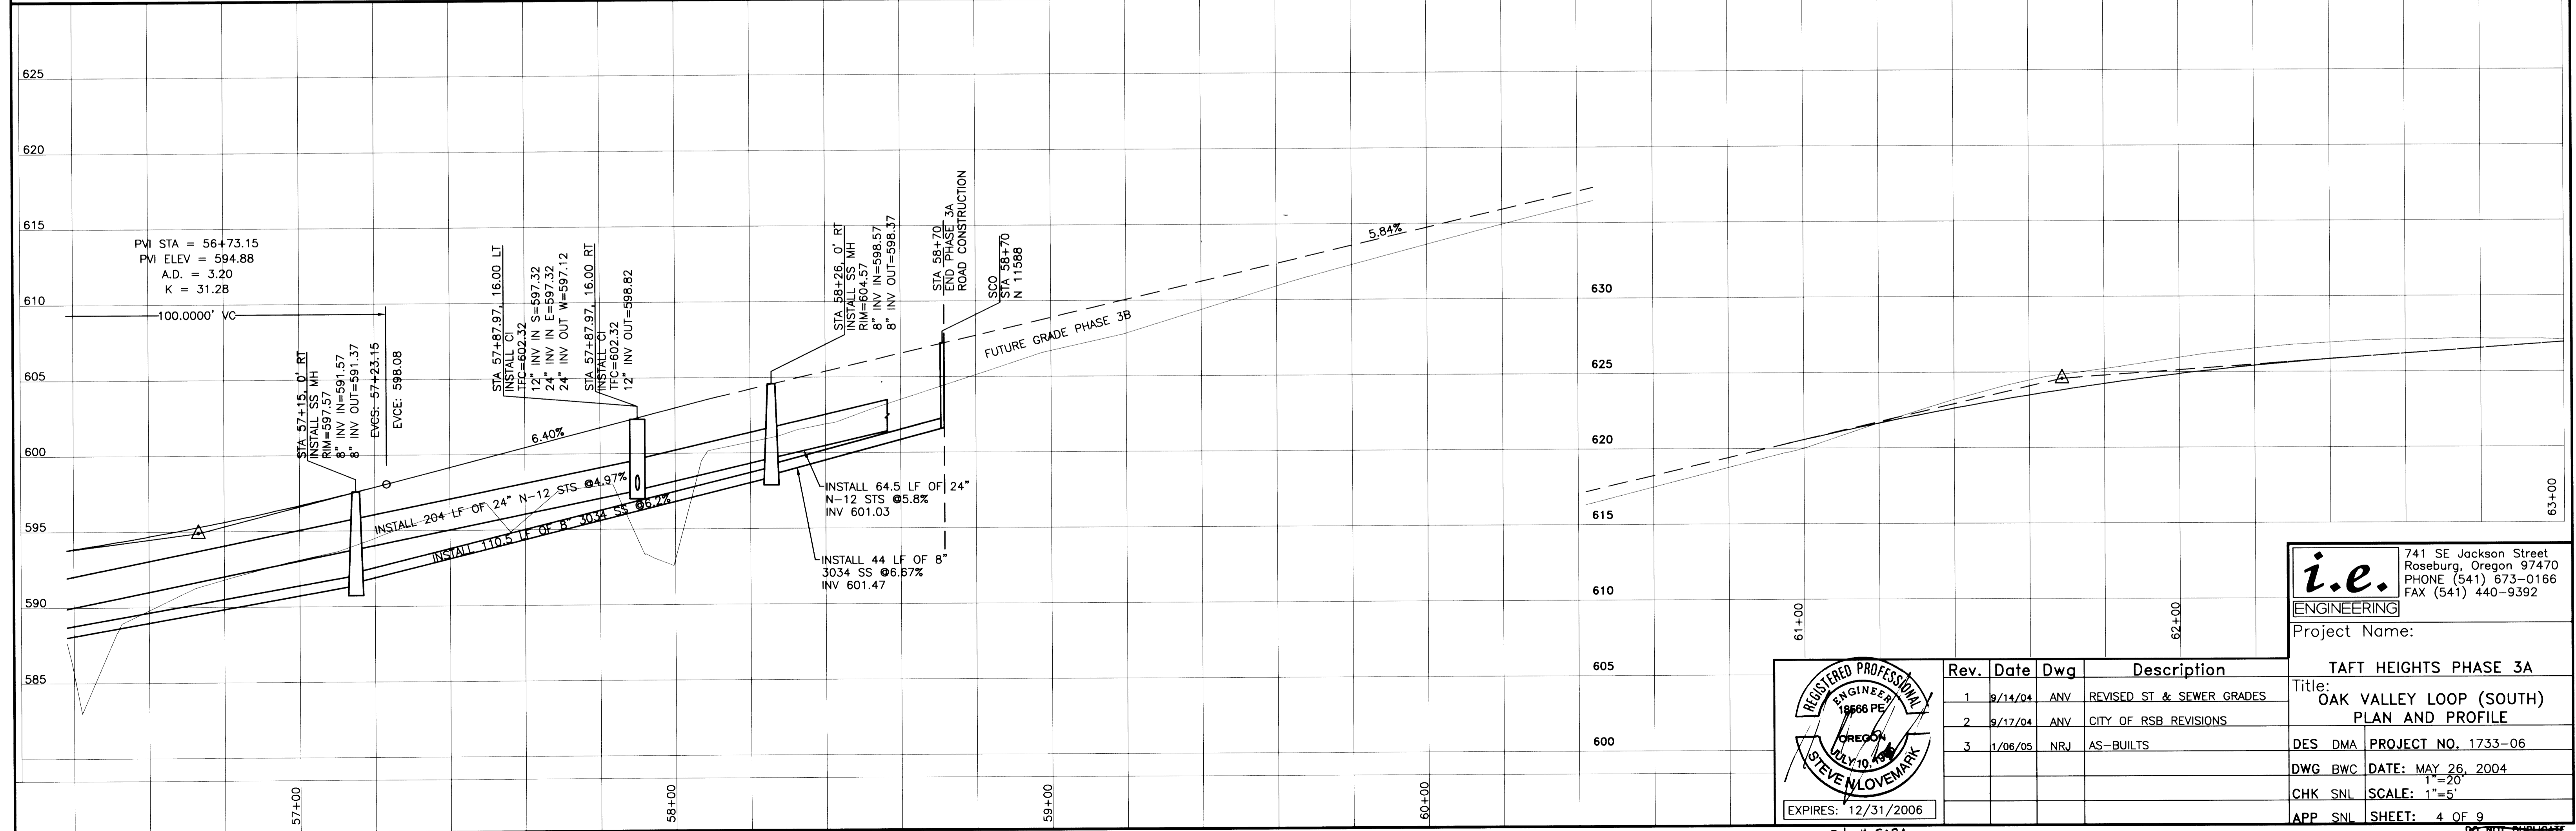


**i.e.**  
 ENGINEERING  
 741 SE Jackson Street  
 Roseburg, Oregon 97470  
 PHONE (541) 673-0166  
 FAX (541) 440-9392

Project Name: TAFT HEIGHTS PHASE 3A  
 Title: OAK VALLEY LOOP (SOUTH) PLAN AND PROFILE

Rev.	Date	Dwg	Description
1	9/14/04	ANV	REVISED ST & SEWER GRADES
2	9/17/04	ANV	CITY OF RSB REVISIONS
3	1/08/05	NRJ	AS-BUILTS

DES DMA PROJECT NO. 1733-06  
 DWG BWC DATE: MAY 26, 2004  
 CHK SNL SCALE: 1"=5'  
 APP SNL SHEET: 4 OF 9

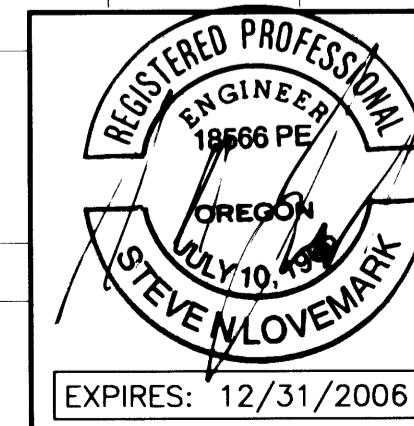

EXPIRES: 12/31/2006

Co. Rd. # 908A

MP 0.13 - 0.17

CO RD #908A

00130017

75