


CALL BEFORE YOU DIG 1
ONE CALL: (800) 332-2344
 OAR 952-001-0010 THROUGH
 OAR 952-001-0090

CITY OF ROSEBURG
 Public Works Dept.
 Development Plan Review

Approved for Development Approved with Conditions

By: _____
 Date: _____

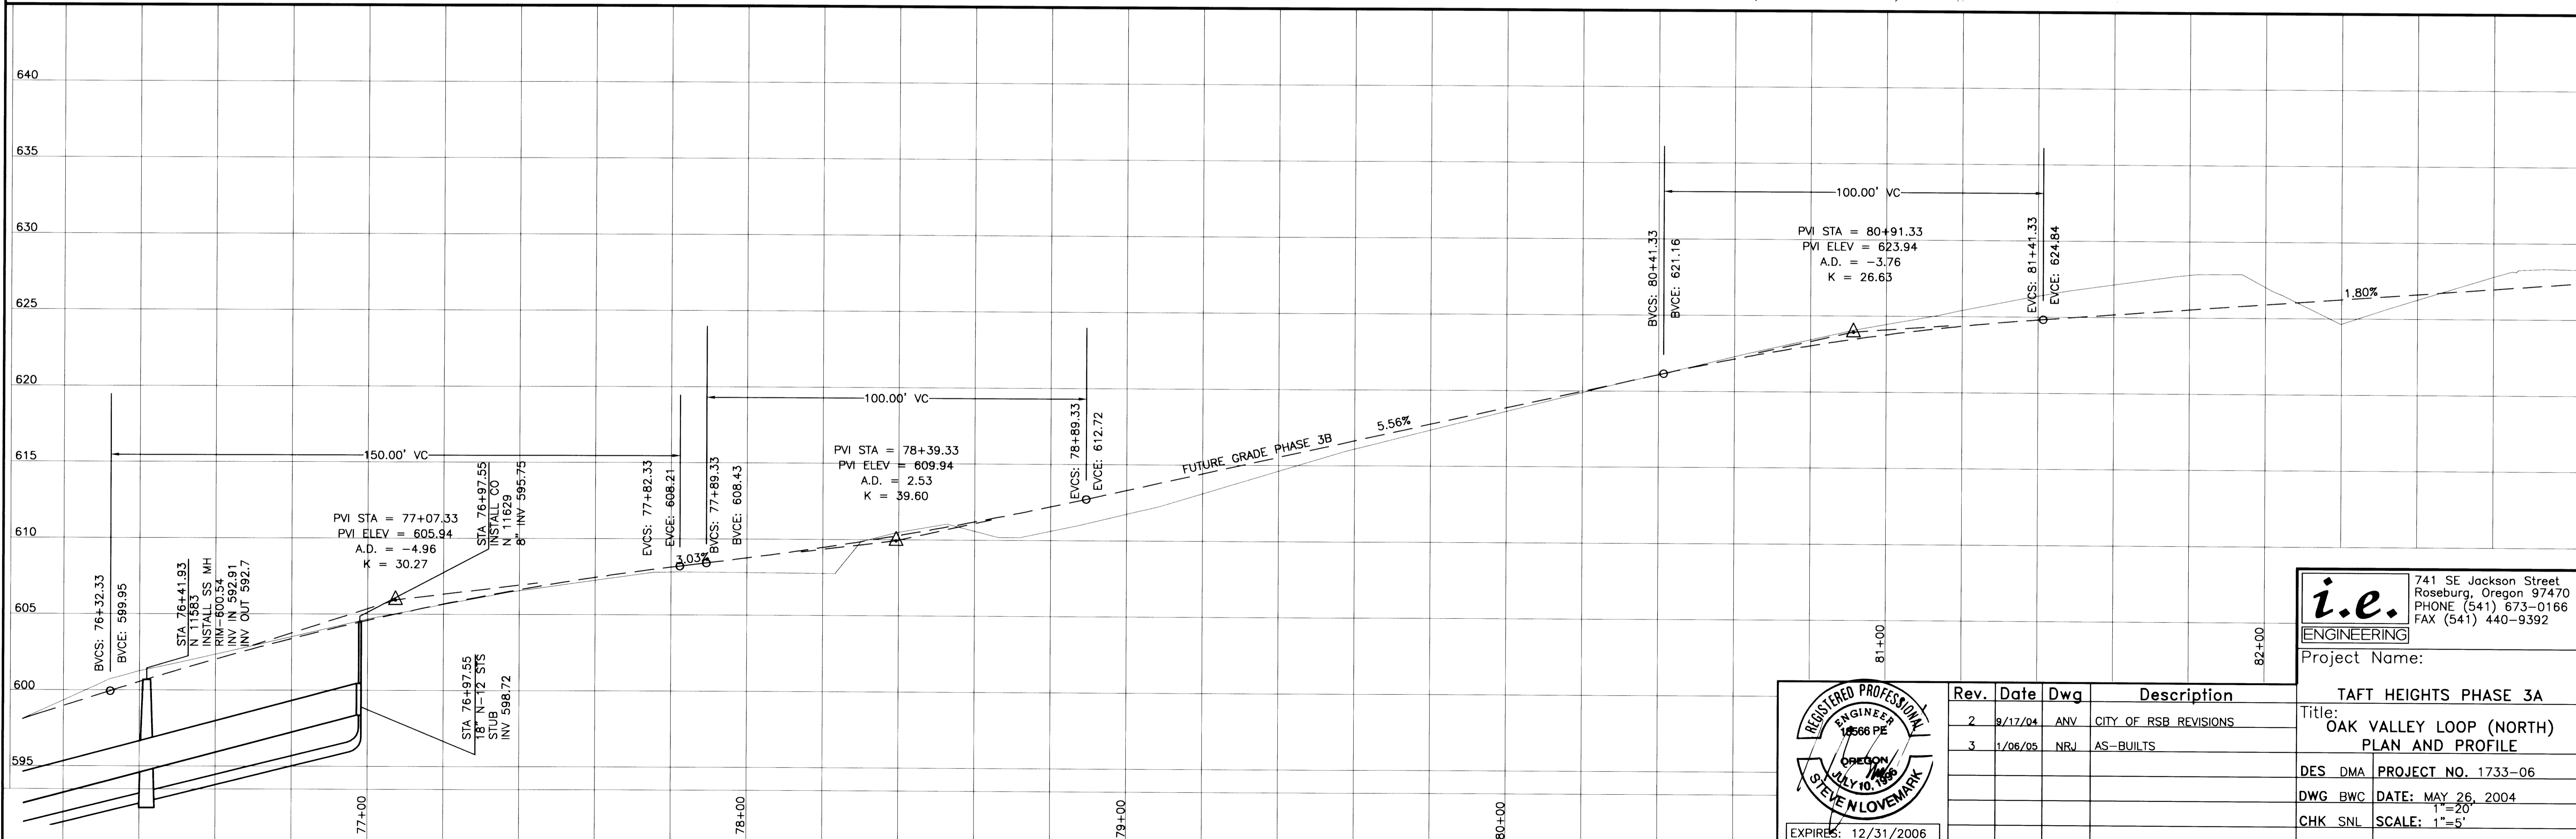


i.e.
 ENGINEERING
 741 SE Jackson Street
 Roseburg, Oregon 97470
 PHONE (541) 673-0166
 FAX (541) 440-9392

Project Name: TAFT HEIGHTS PHASE 3A
 Title: OAK VALLEY LOOP (NORTH) PLAN AND PROFILE

Rev.	Date	Dwg	Description
2	9/17/04	ANY	CITY OF RSB REVISIONS
3	1/06/05	NRJ	AS-BUILTS

DES DMA PROJECT NO. 1733-06
 DWG BWC DATE: MAY 26, 2004
 CHK SNL SCALE: 1"=5'
 APP SNL SHEET: 6 OF 9

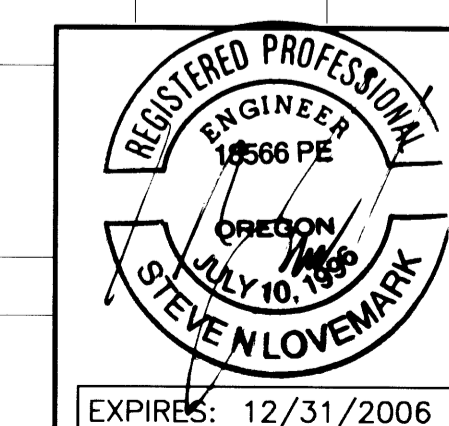

Co. Rd. # 908A

MP 0.39-0.38

00390038

DO NOT DUPLICATE