


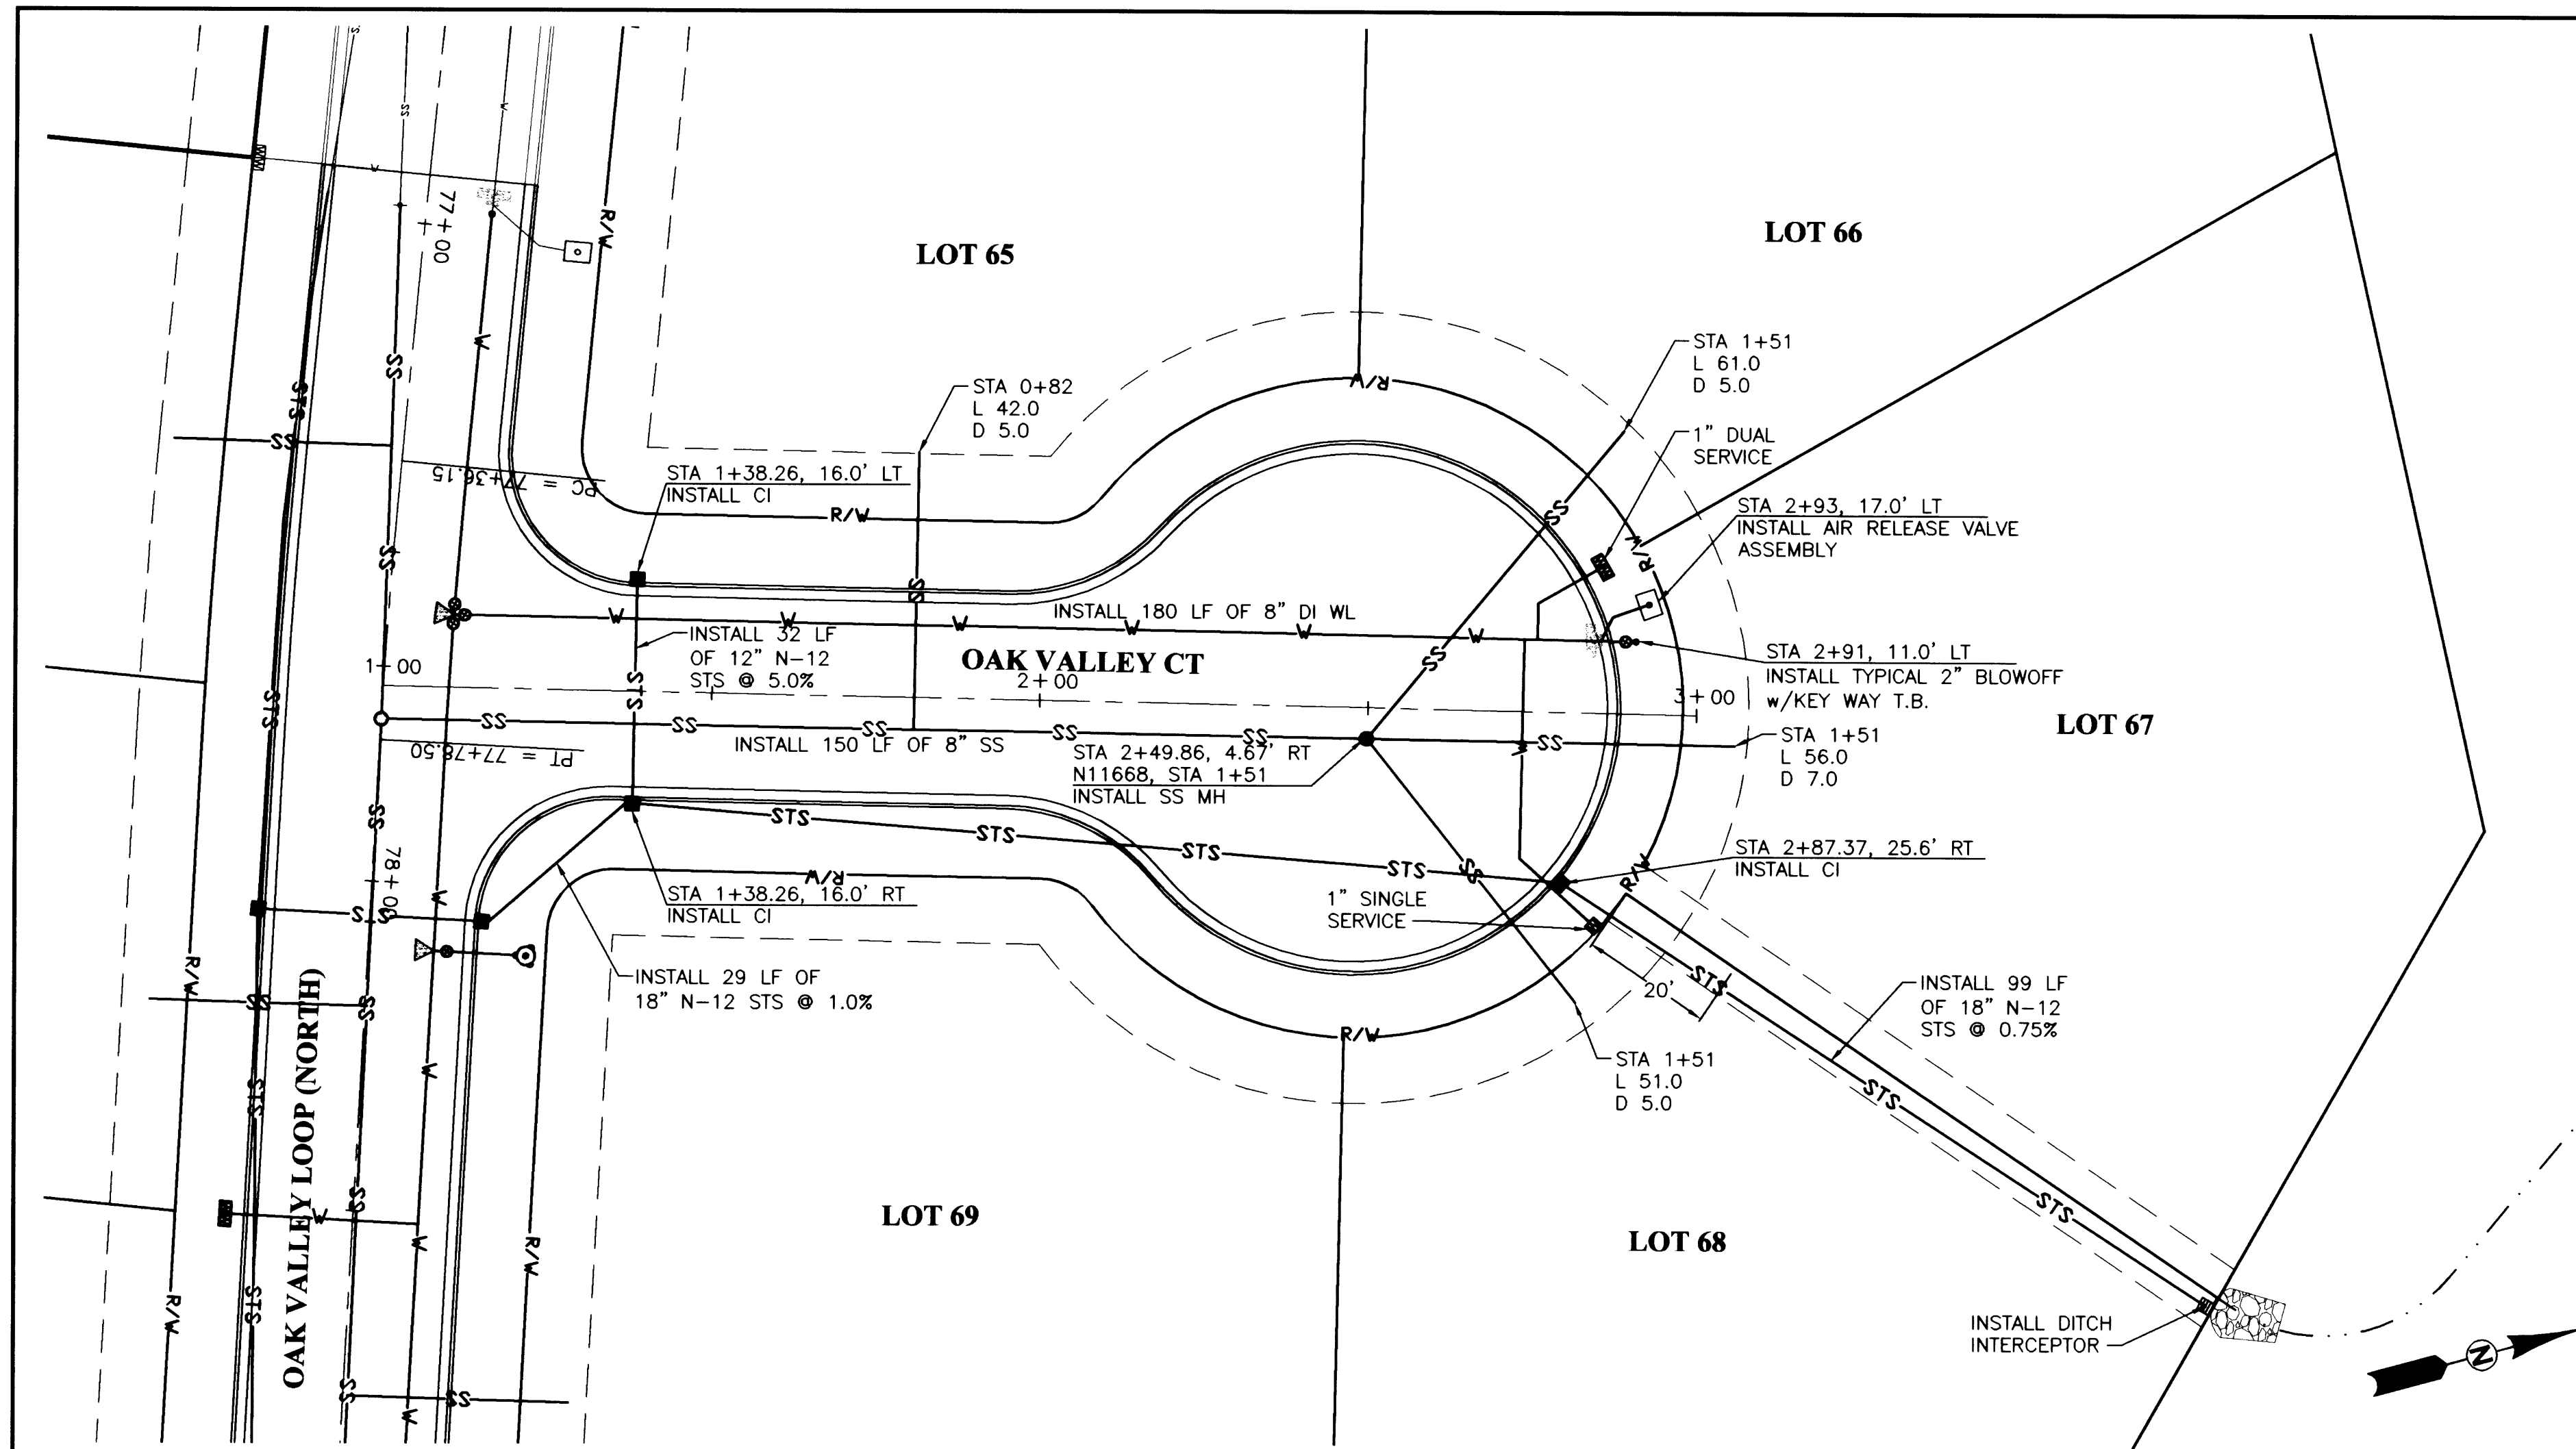


CITY OF ROSEBURG
Public Works Dept.
Development Plan Review

☐ Approved for Development ☐ Approved with Conditions

By _____

Date _____

CALL BEFORE YOU DIG I
ONE CALL: (800) 332-2344
OAR 952-001-0010 THROUGH
OAR 952-001-0090


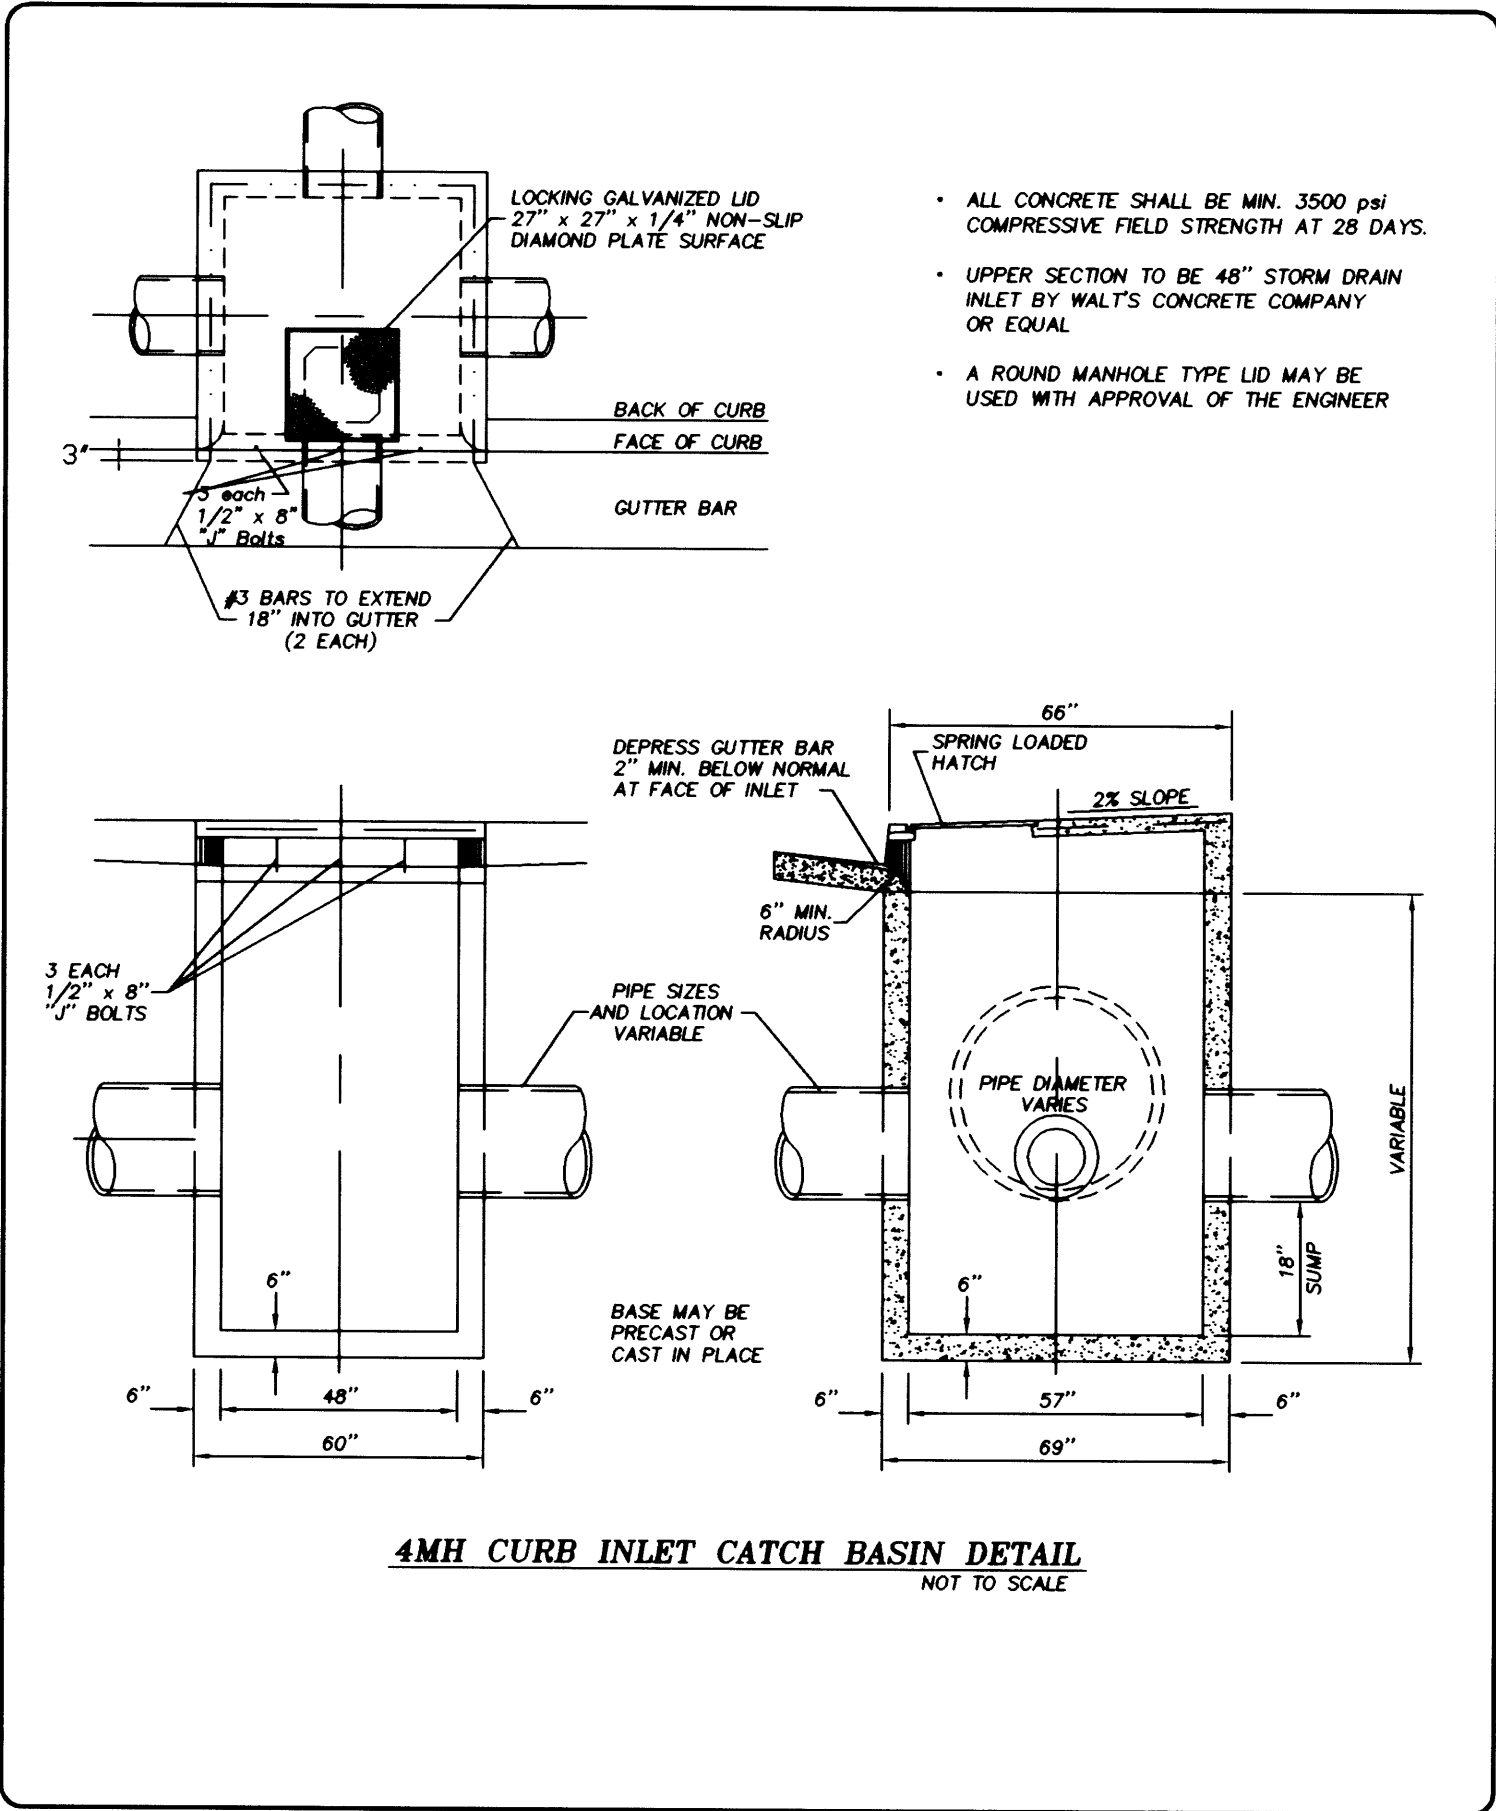


NO.	REVISION	DATE	BY	APPROVED

CITY OF SPRINGFIELD
DEPT. OF PUBLIC WORKS
325 FIFTH STREET
SPRINGFIELD, OR 97477

CURB INLET CATCH BASIN
4MH

STANDARD DRAWING
4-10

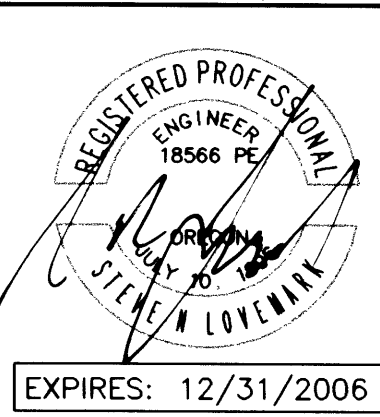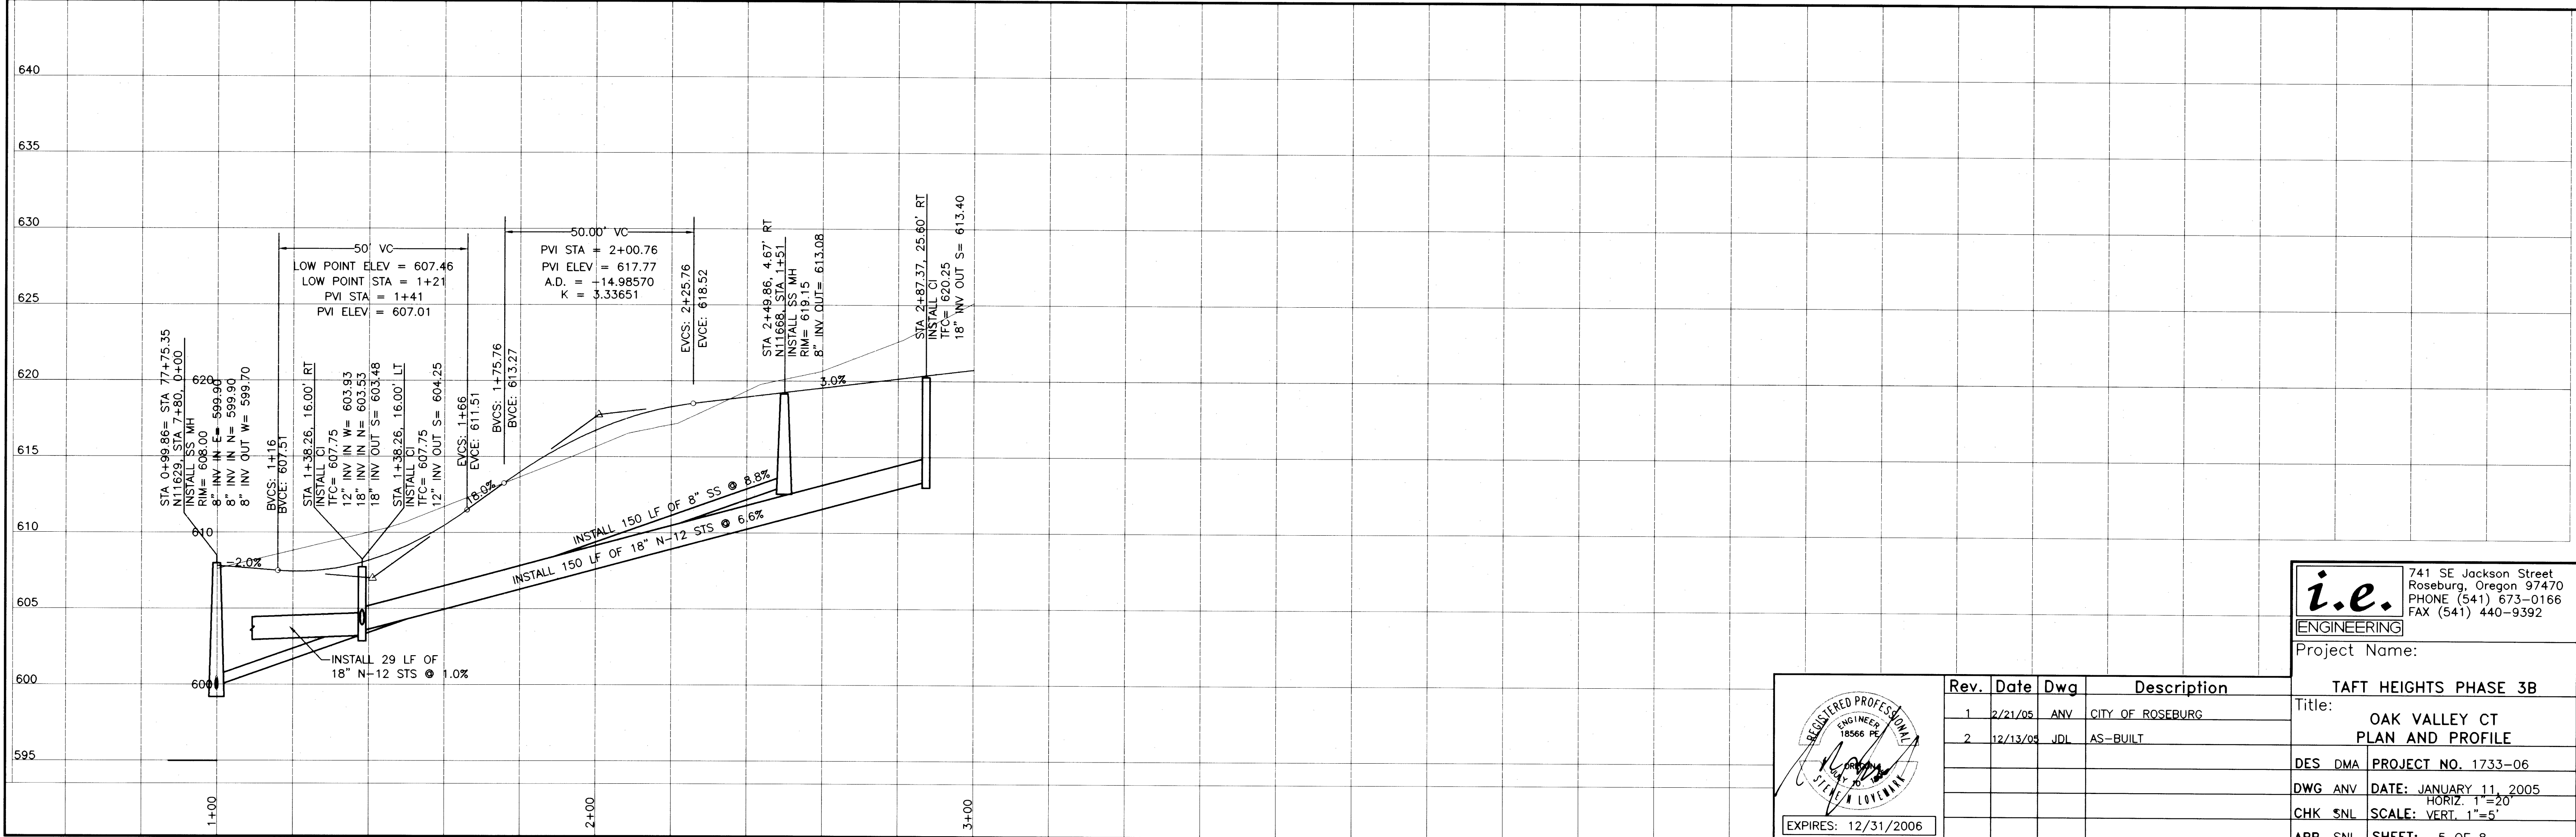

Rev.	Date	Dwg	Description
1	2/21/05	ANY	CITY OF ROSEBURG
2	12/13/05	JDL	AS-BUILT

i.e. 741 SE Jackson Street
Roseburg, Oregon 97470
PHONE (541) 673-0166
FAX (541) 440-9392

ENGINEERING

Project Name: **TAFT HEIGHTS PHASE 3B**

Title: **OAK VALLEY CT
PLAN AND PROFILE**

DES DMA: **PROJECT NO. 1733-06**

DWG ANV: **DATE: JANUARY 11, 2005**

CHK SNL: **HORIZ. 1"=20'**

APP SNL: **SCALE: VERT. 1"=5'**

SHEET: **5 OF 8**

Co.Rd.# 908A & 908B

CO RD #908A & 908B

R908PROF

85