




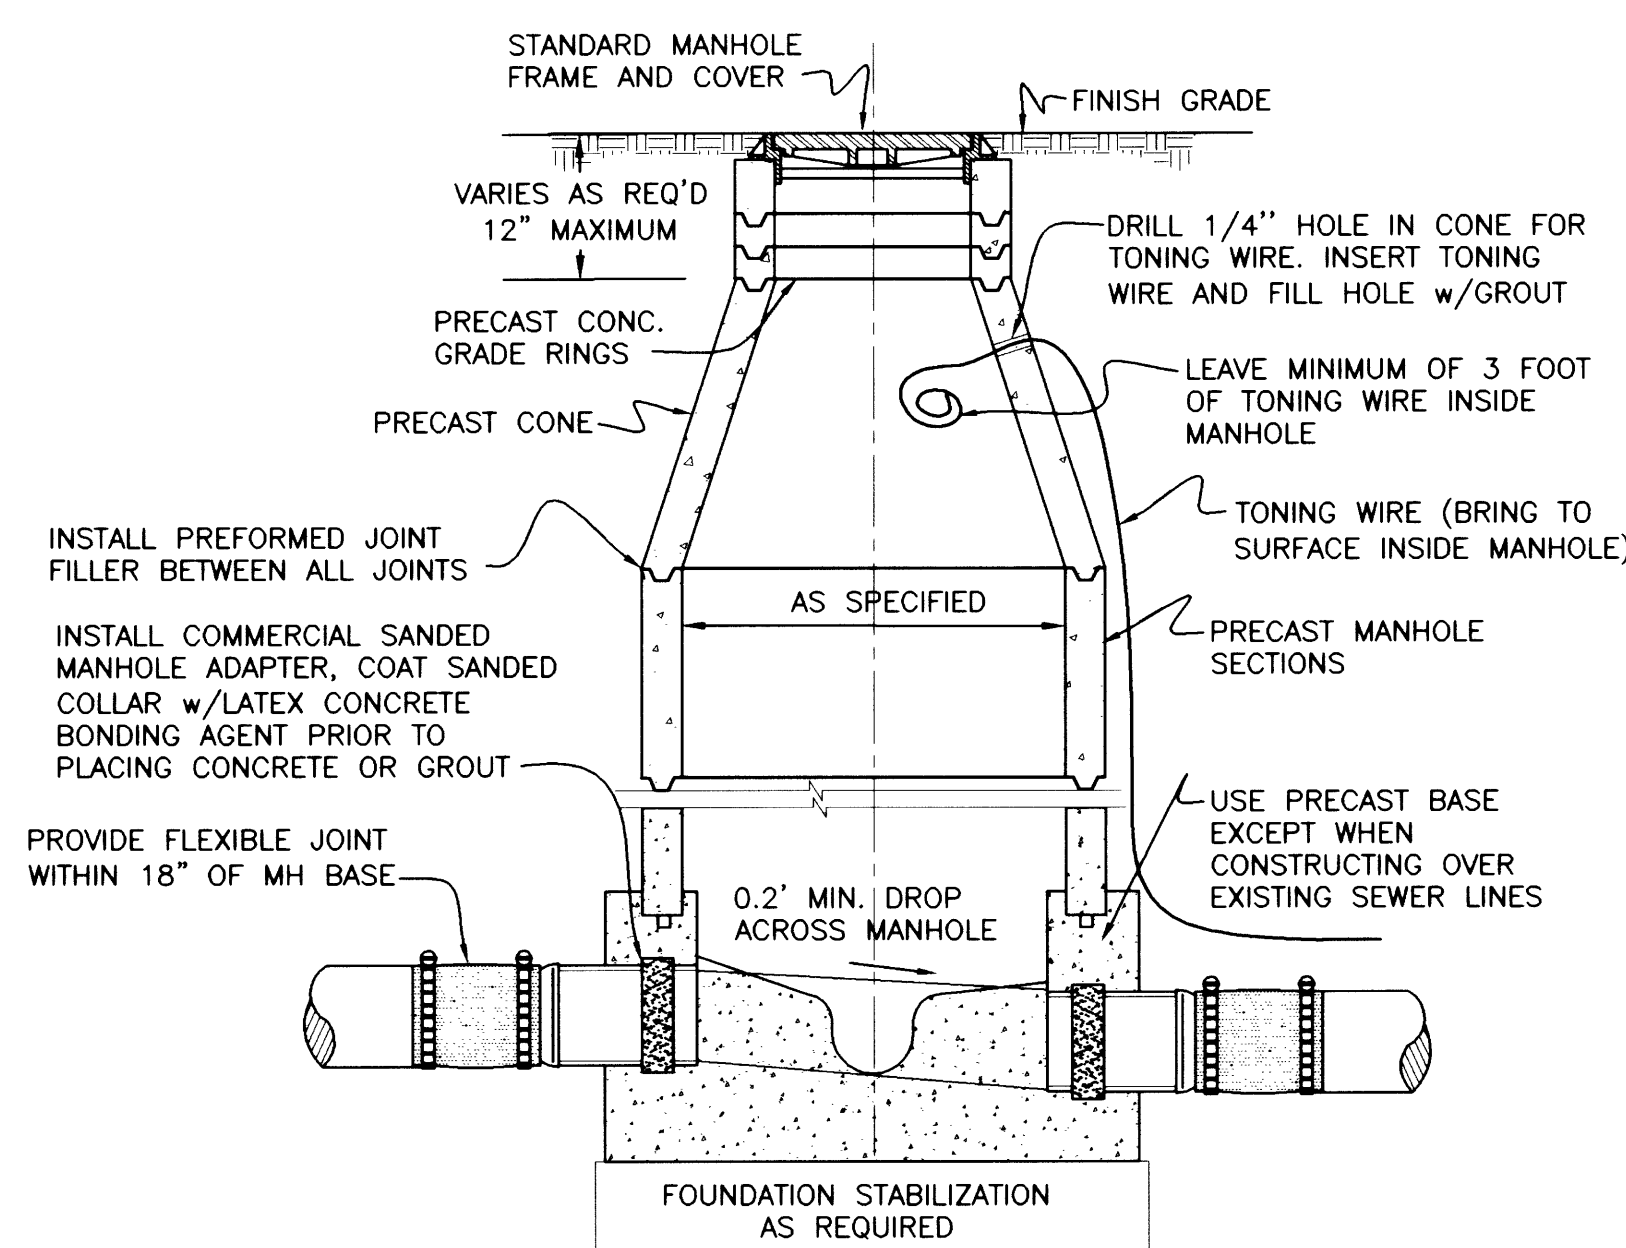


TYPICAL SANITARY MANHOLE DETAIL
(CAST IN PLACE)

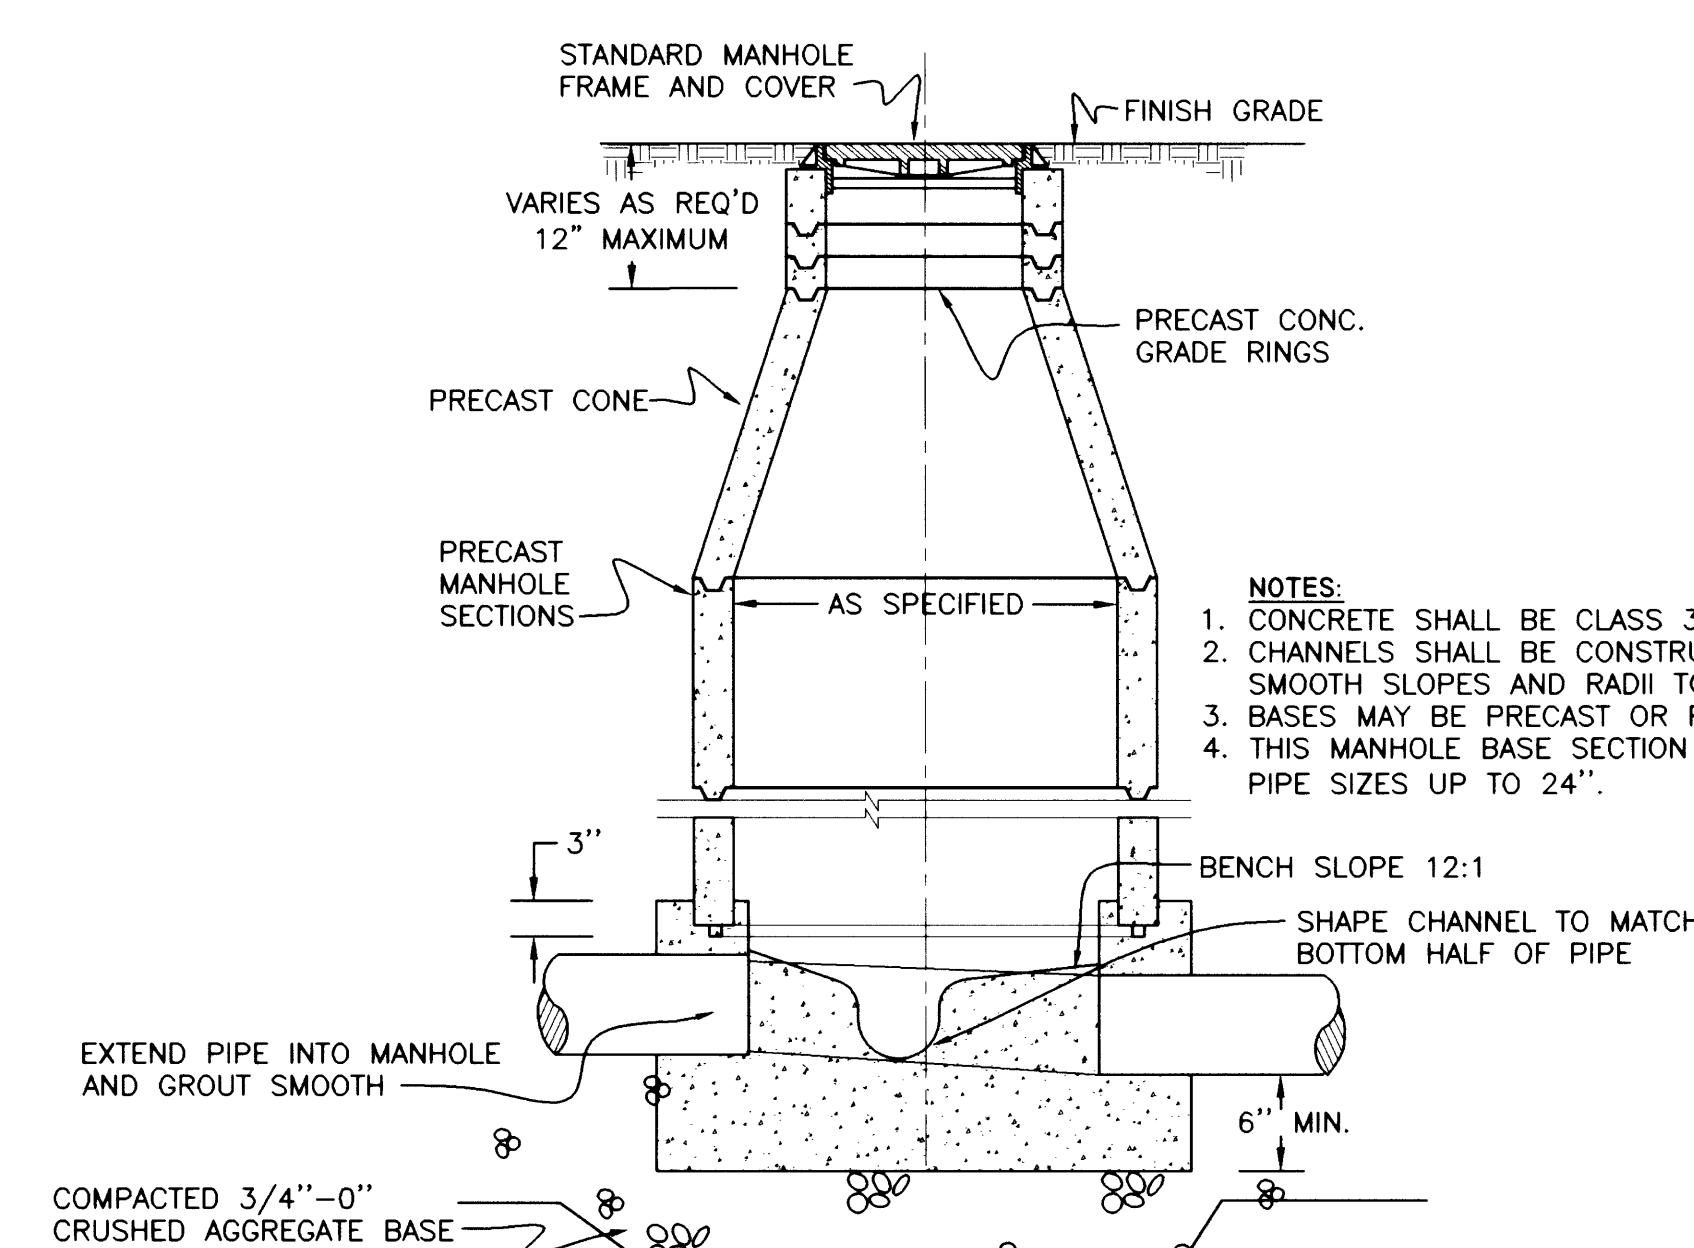


TYPICAL STORM MANHOLE DETAIL

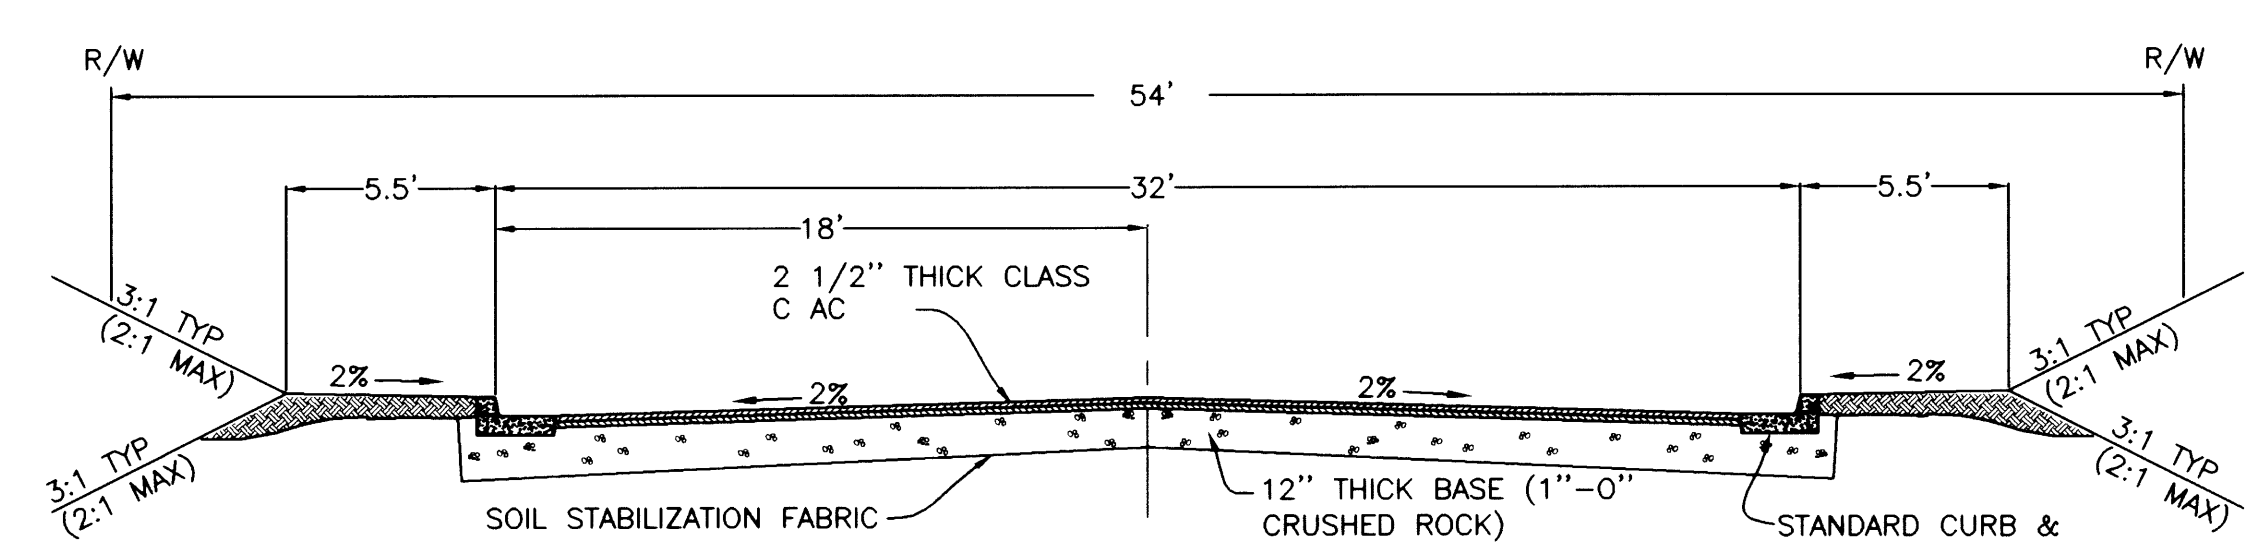

TAFT HEIGHTS DRIVE SECTION

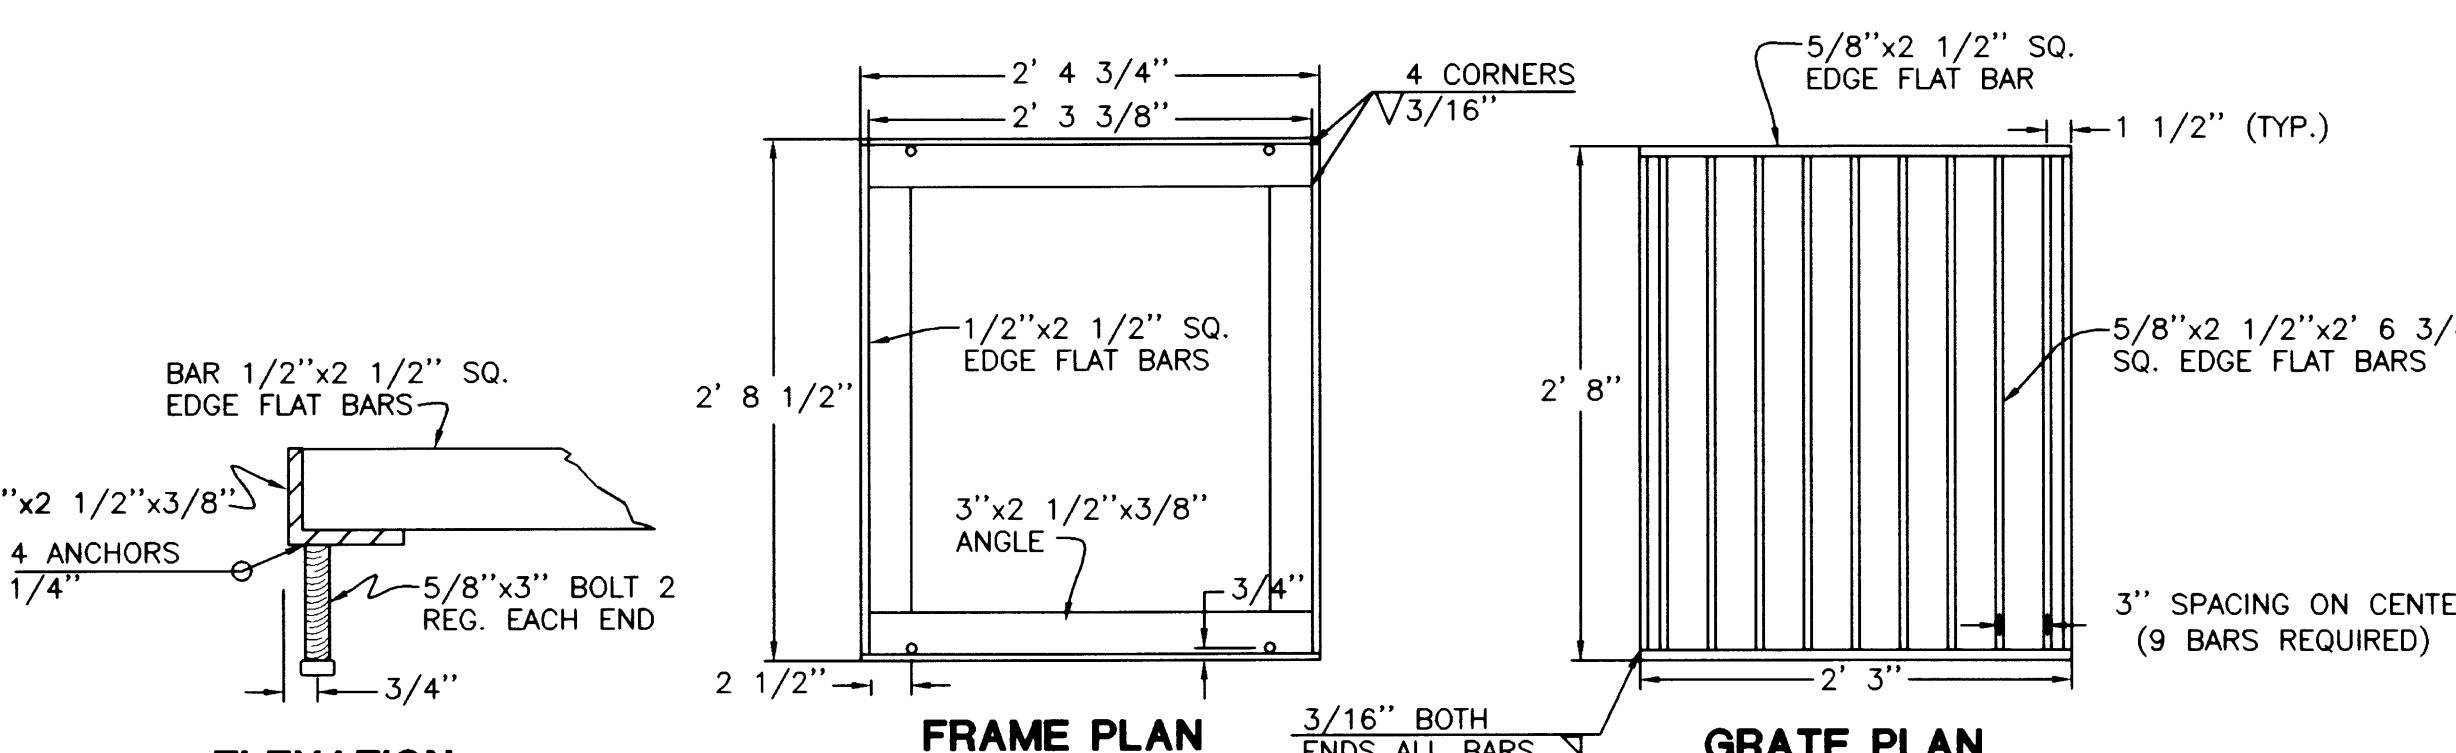


TYPICAL WATER MAINLINE TRENCH DETAIL

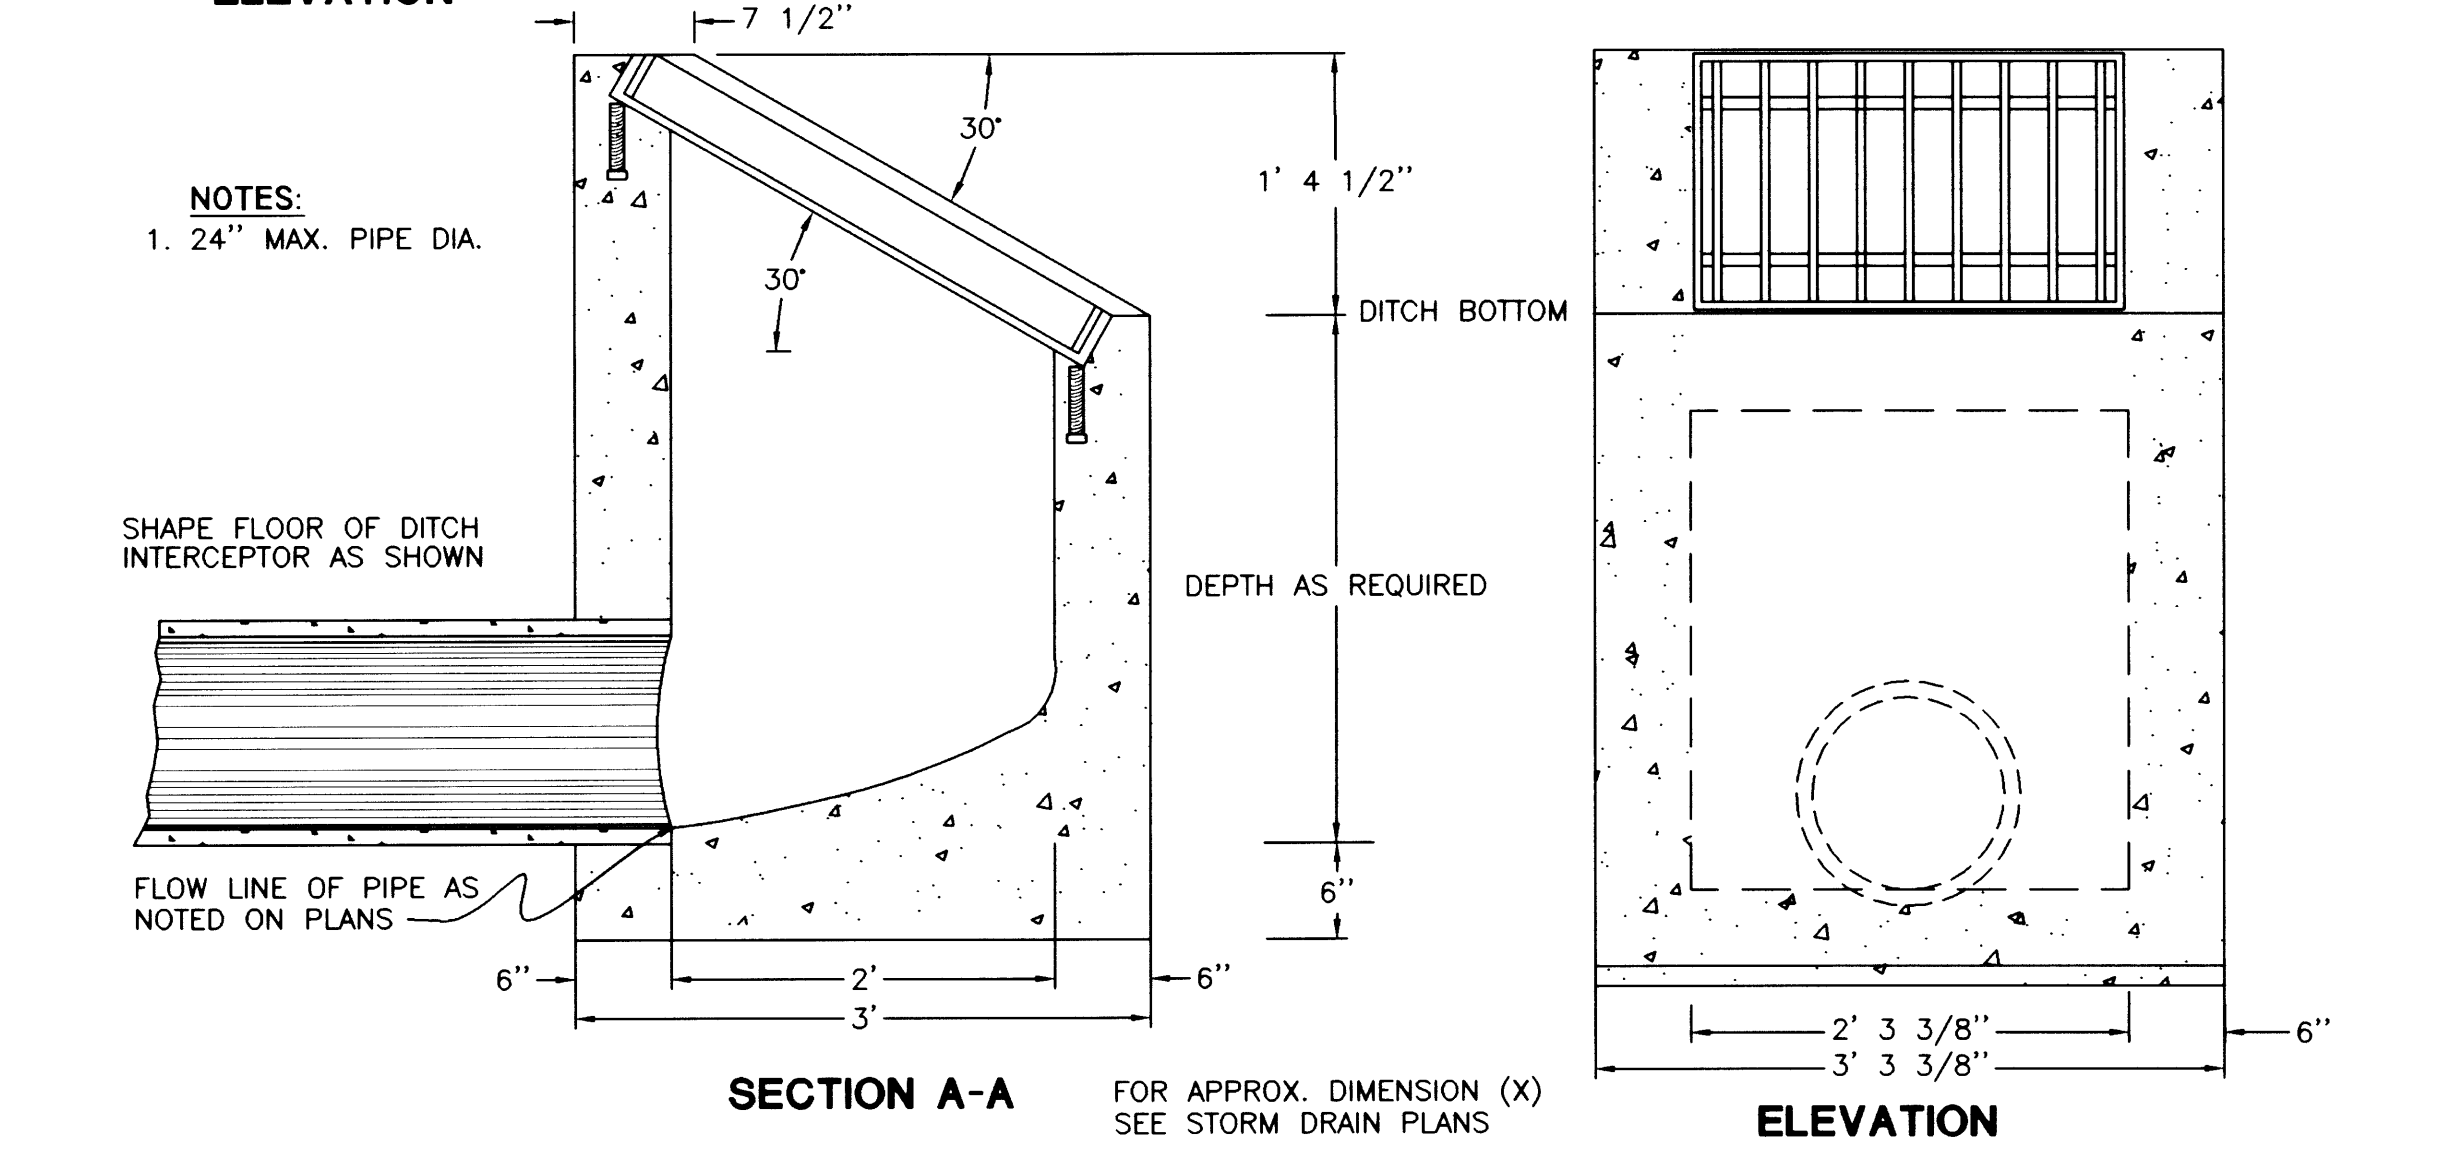


TYPICAL SEWER MAINLINE TRENCH DETAIL



TYPICAL SEWER SERVICE LINE TRENCH DETAIL

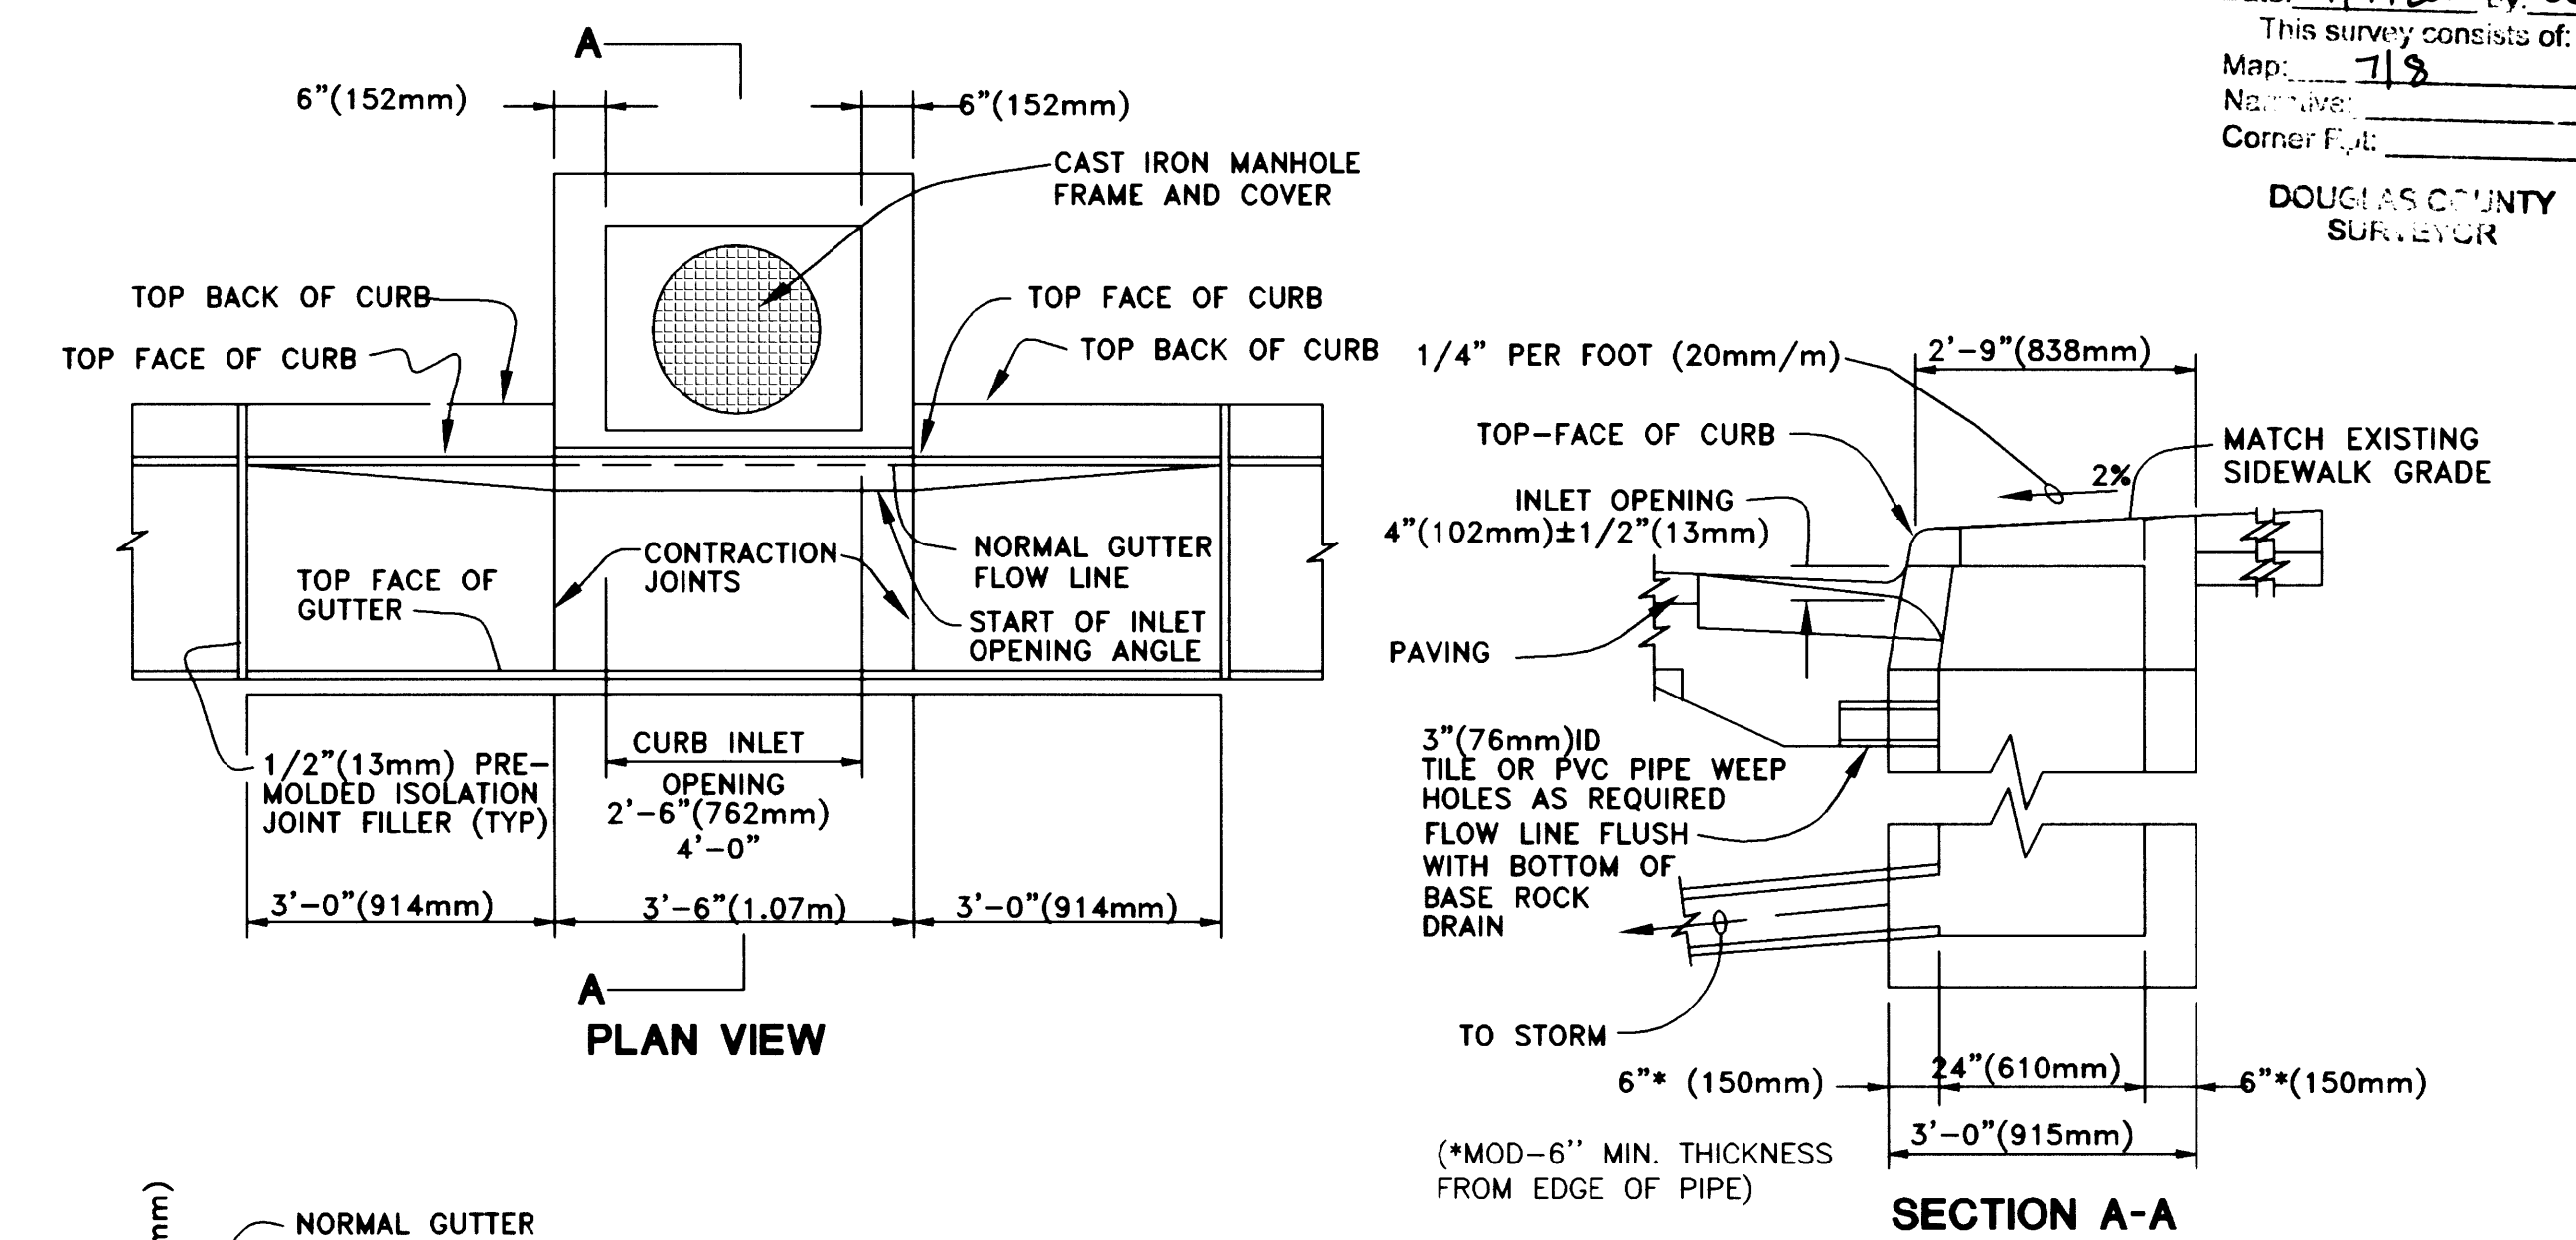

TYPICAL CG-3 INLET DETAIL

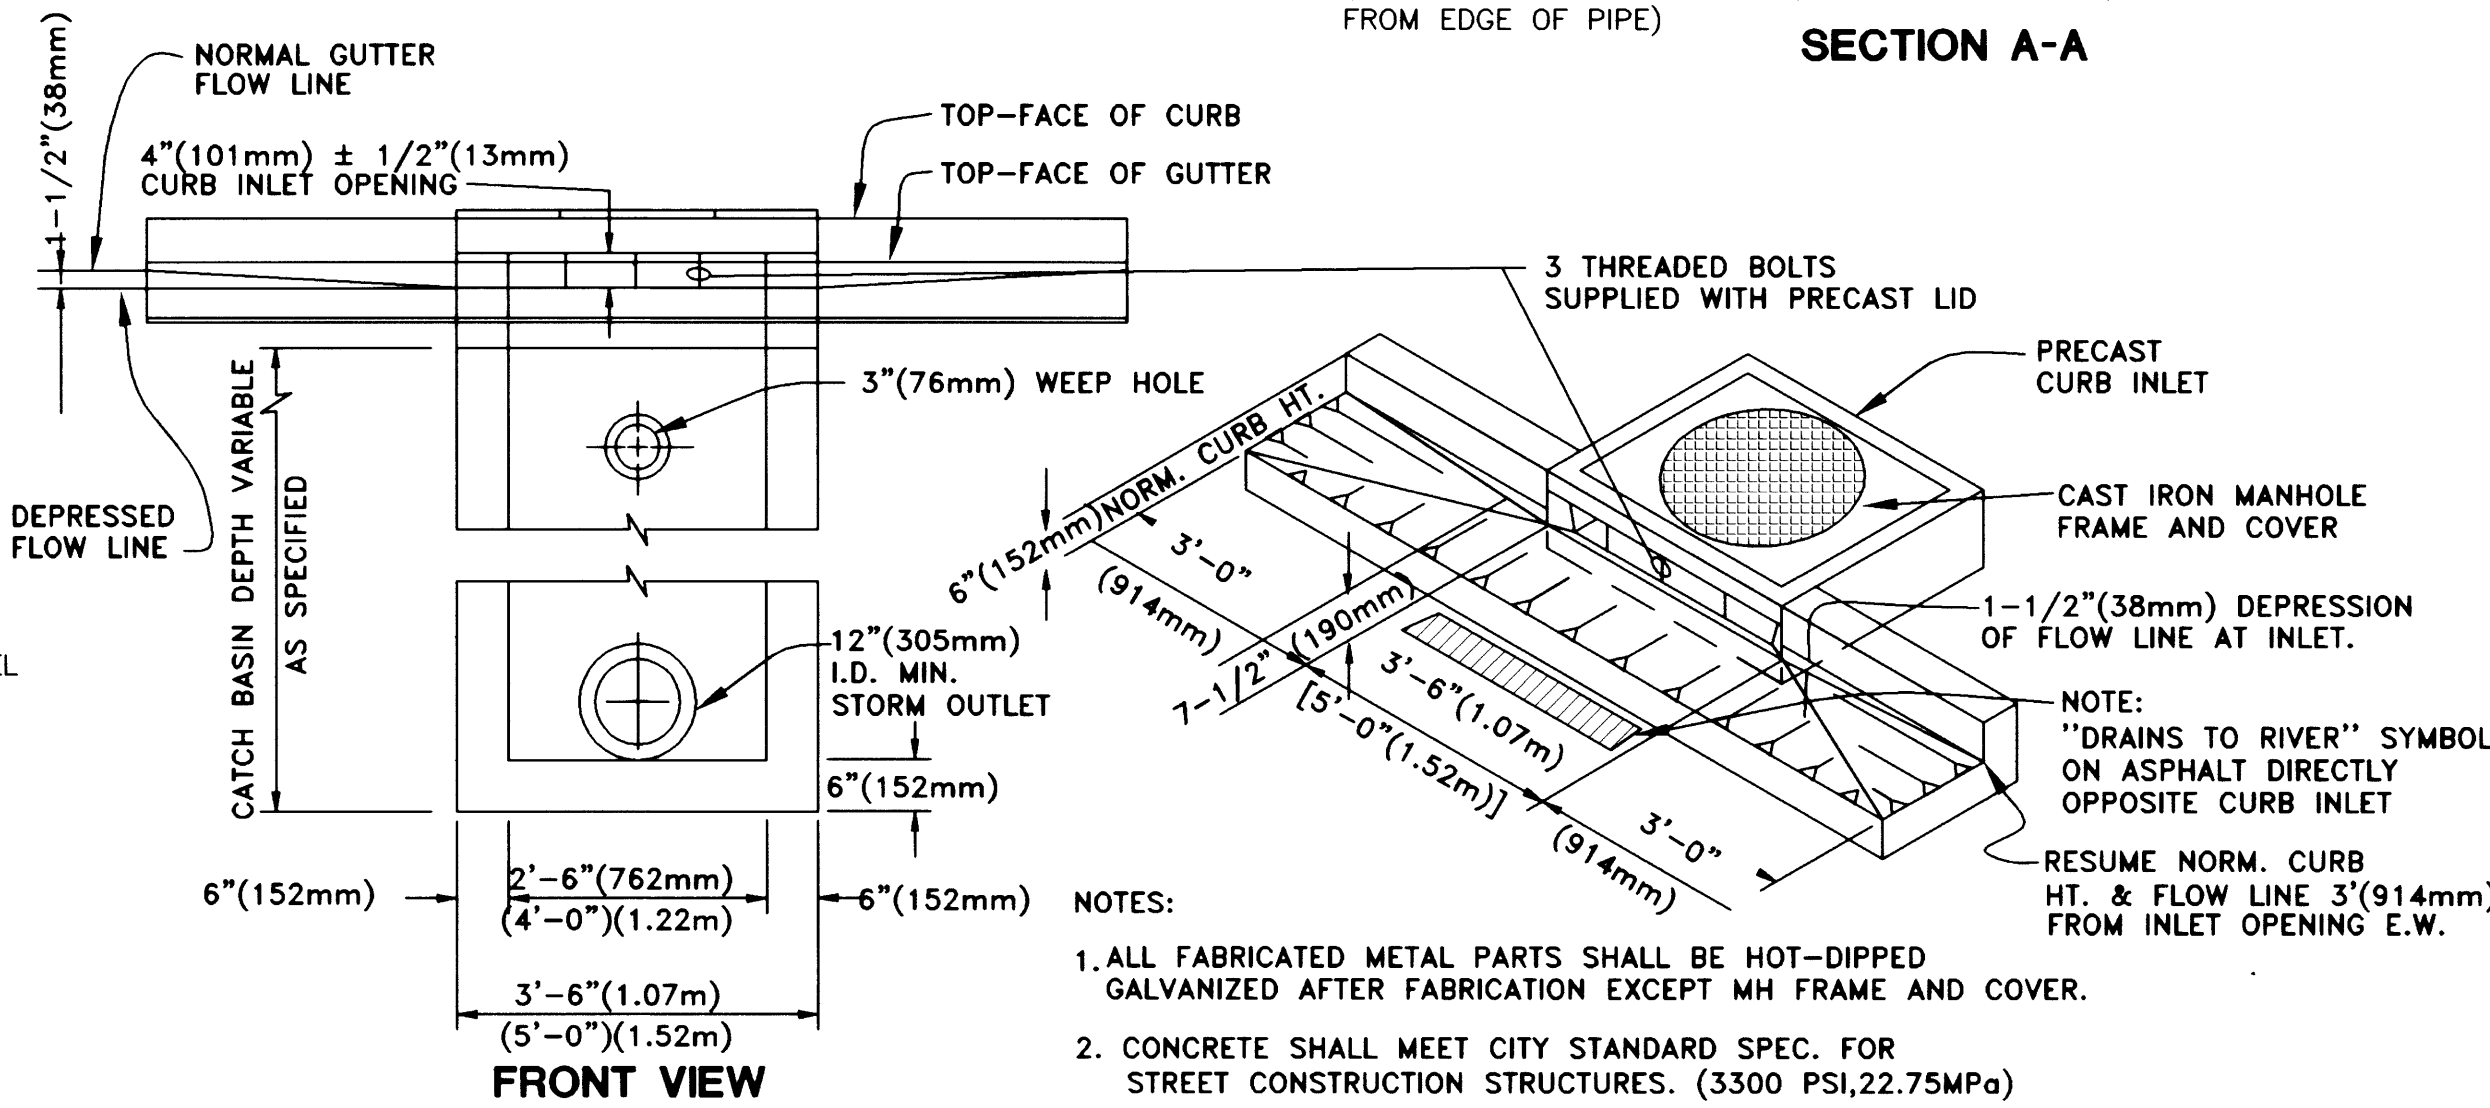

TYPICAL 4" SEWER SERVICE CONNECTION DETAIL

NOTES:
1. 24" MAX. PIPE DIA.

SHAPE FLOOR OF DITCH INTERCEPTOR AS SHOWN

SECTION A-A
FOR APPROX. DIMENSION (X) SEE STORM DRAIN PLANS


DITCH INTERCEPTOR (TYPE A)

*NOTE:
36" MIN. COVER IN TRAFFIC AREAS AND CRUSHED ROCK BEDDING FOR SANITARY SEWER SERVICES

CITY OF ROSEBURG
Public Works Dept.
Development Plan Review

☐ Approved for Development
☐ Approved with Conditions

By _____
Date _____

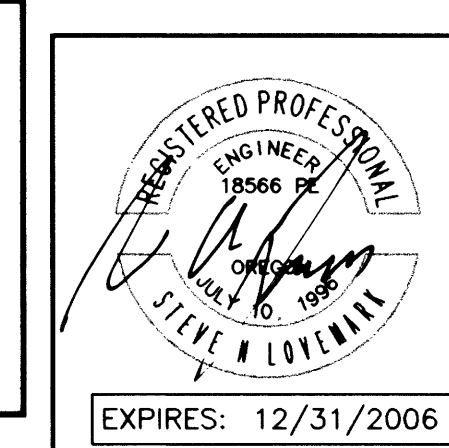

CALL BEFORE YOU DIG 1
ONE CALL: (800) 332-2344
OAR 952-001-0010 THROUGH
OAR 952-001-0090

Rev.	Date	Dwg	Description
1	2/21/05	ANV	CITY OF ROSEBURG
2	12/13/05	JDL	AS-BUILT

741 SE Jackson Street
Roseburg, Oregon 97470
PHONE (541) 673-0166
FAX (541) 440-9392
iemail@ieengineering.com

i.e.
ENGINEERING

Project Name: TAFT HEIGHTS PHASE 3B

DES	DMA	PROJECT NO. 1733-06
DWG	ANV	DATE: JANUARY 11, 2005
CHK	SNL	SCALE: AS-SHOWN
APP	SNL	SHEET: 7 OF 8

Co. Rd. # 908A & 908B